

**CONSTRUCT DRIVE**  
 STA 2+340.000 RT GRAVEL  
 STA 2+378.000 LT GRAVEL

**STONE FILL, TYPE II**  
 STA 2+170.000 TO STA 2+245.000 LT  
 STA 2+193.903 TO STA 2+235.810 RT

**STEEL BEAM GUARDRAIL**  
 STA 2+193.827 TO STA 2+228.119 LT  
 STA 2+209.121 TO STA 2+220.551 RT

**REMOVING AND RESETTING FENCE**  
 STA 2+222.000 LT - 2.5M BACK

**MANUFACTURED TERMINAL SECTION (TANGENTIAL)**  
 STA 2+178.587 TO STA 2+193.827 LT  
 STA 2+228.119 TO STA 2+243.358 LT  
 STA 2+193.881 TO STA 2+209.121 RT  
 STA 2+220.551 TO STA 2+235.791 RT


**RELOCATE MAIL BOX, SINGLE SUPPORT**  
 STA 2+379.470 LT

**GRUBBING MATERIAL**  
 STA 2+170.000 TO STA 2+245.000 LT  
 STA 2+193.903 TO STA 2+235.810 RT

**SNOW FENCE**  
 STA 2+060.000 TO STA 2+120.000 RT

**CONSTRUCT SPECIAL DITCH**  
 STA 2+070.000 TO STA 2+150.000 RT  
 STA 2+280.000 TO STA 2+375.000 LT  
 STA 2+280.750 TO STA 2+380.000 RT

**EROSION MATTING (JUTE)**  
 STA 2+170.000 TO STA 2+245.000 LT  
 STA 2+193.903 TO STA 2+235.810 RT

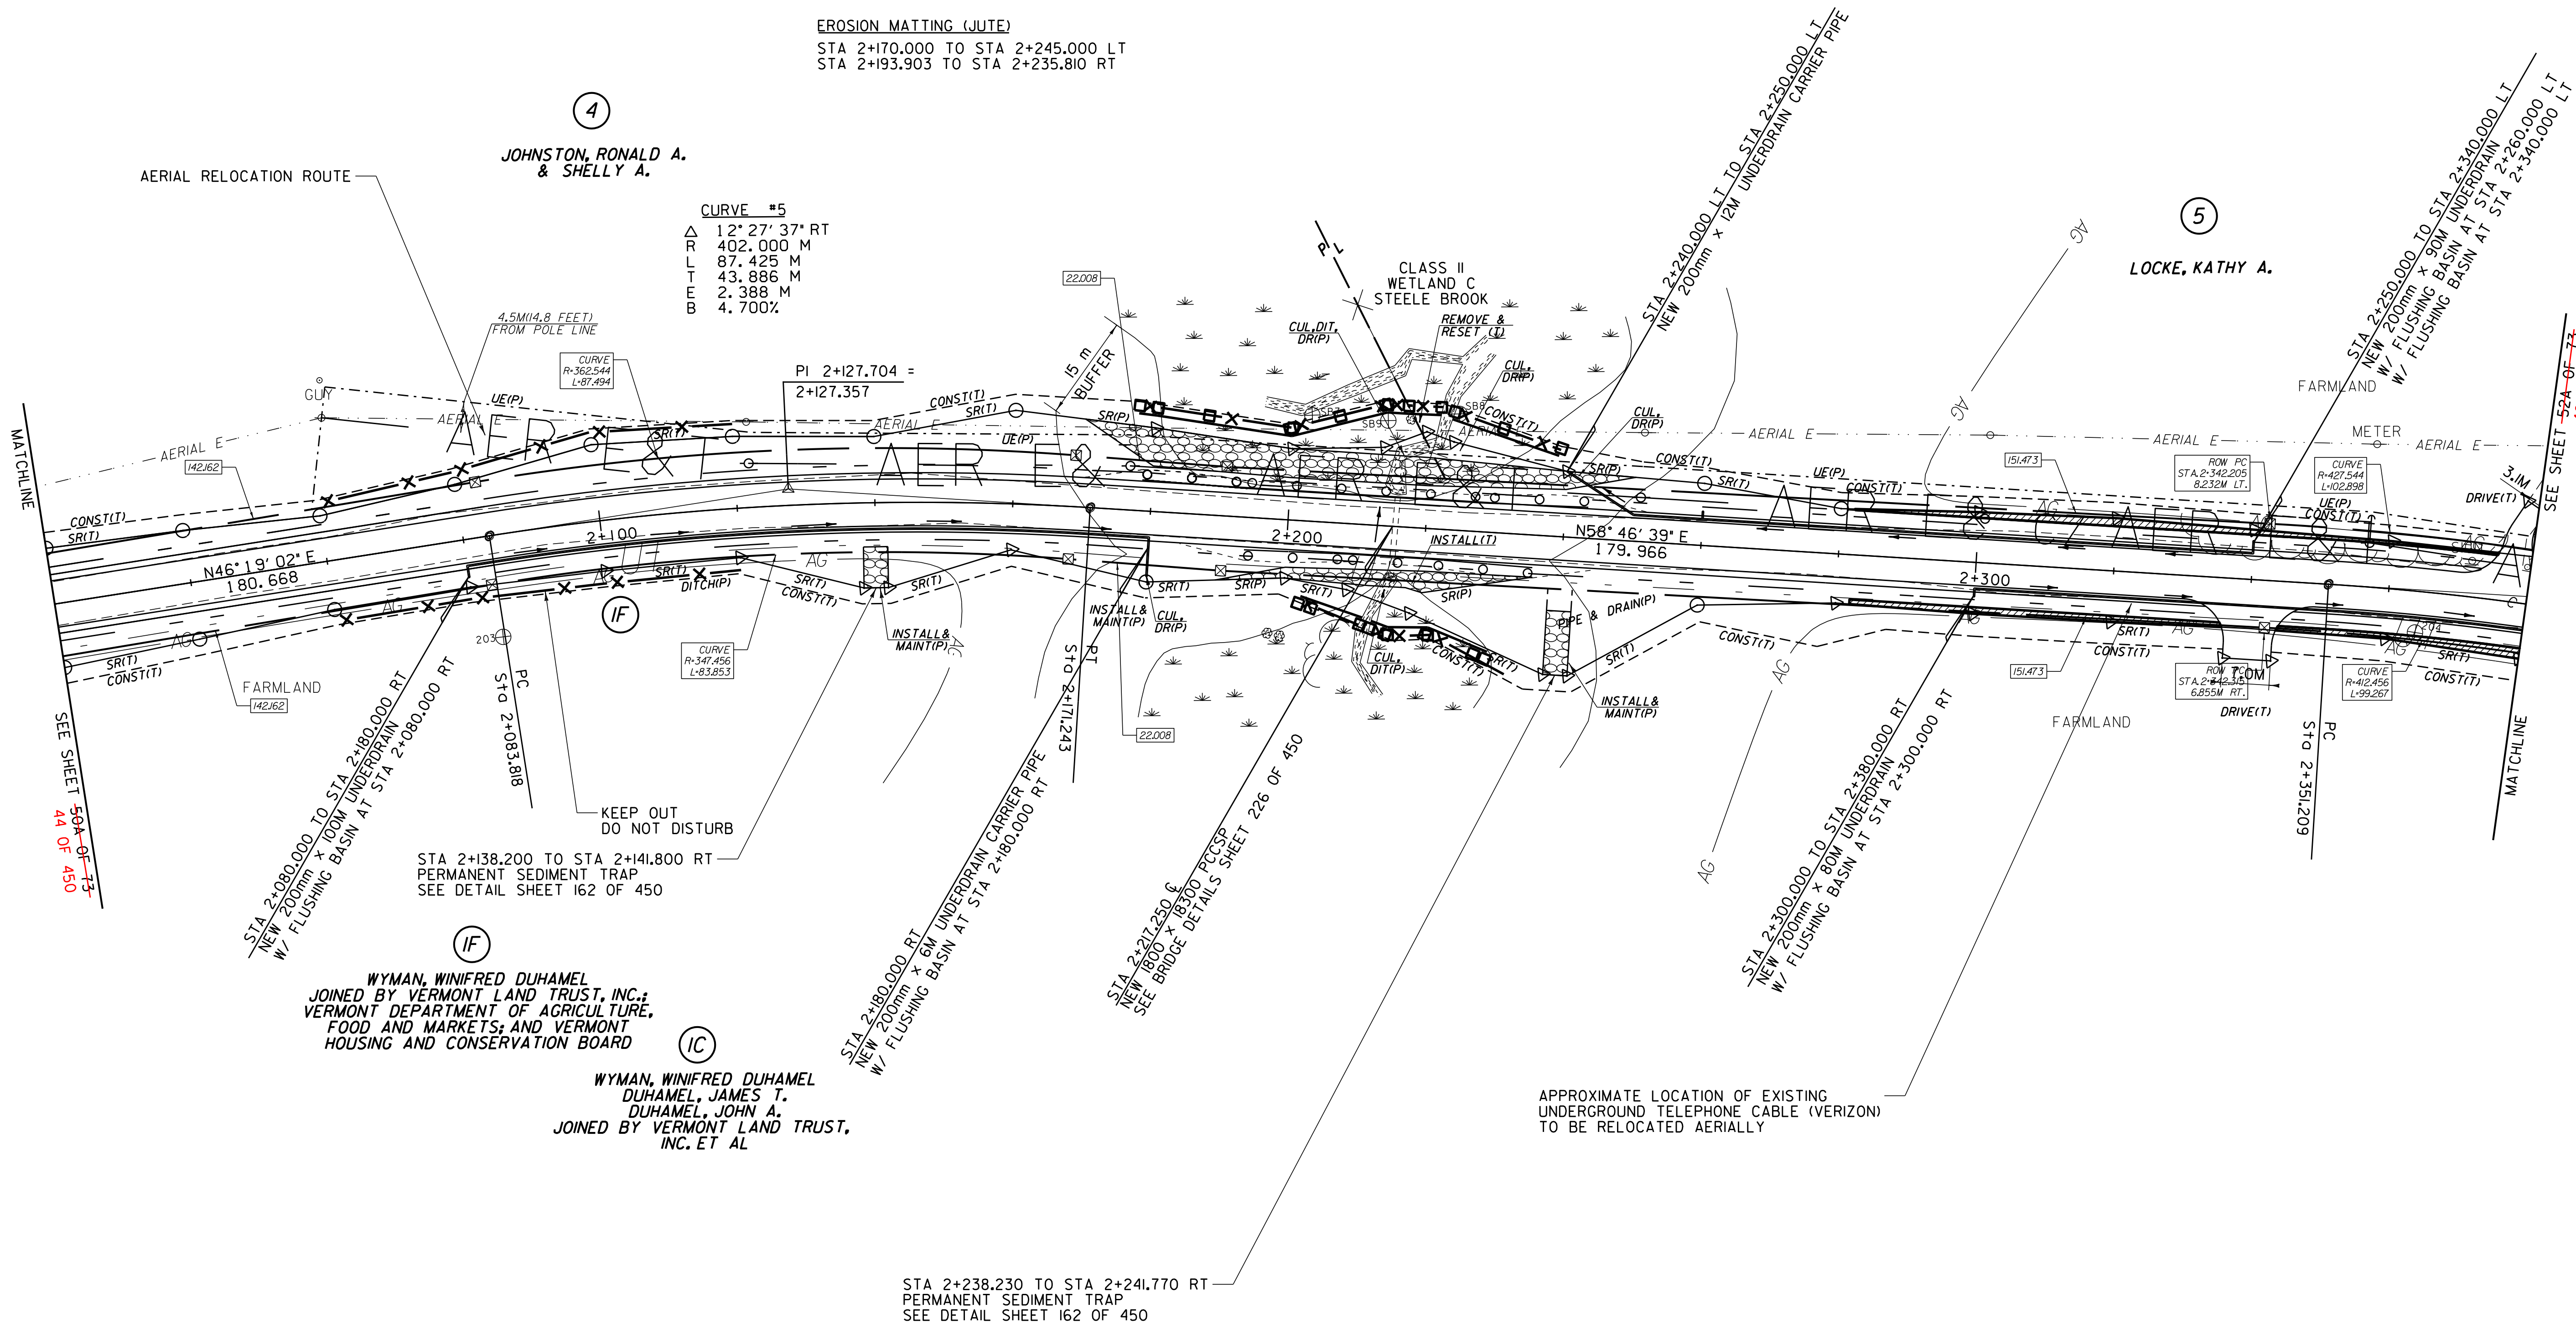

SEE SHEET 50A OF 73  
44 OF 450

SEE SHEET 52A OF 73  
46 OF 450

WYMAN, WINIFRED DUHAMEL  
 JOINED BY VERMONT LAND TRUST, INC.;  
 VERMONT DEPARTMENT OF AGRICULTURE,  
 FOOD AND MARKETS; AND VERMONT  
 HOUSING AND CONSERVATION BOARD

WYMAN, WINIFRED DUHAMEL  
 DUHAMEL, JAMES T.  
 DUHAMEL, JOHN A.  
 JOINED BY VERMONT LAND TRUST,  
 INC. ET AL


APPROXIMATE LOCATION OF EXISTING  
 UNDERGROUND TELEPHONE CABLE (VERIZON)  
 TO BE RELOCATED AERIALY

STA 2+238.230 TO STA 2+241.770 RT  
 PERMANENT SEDIMENT TRAP  
 SEE DETAIL SHEET 162 OF 450



○ DENOTES TREE OR STUMP REMOVAL

- NOTES:**
- ALL SIDE ROAD RADII SHALL BE 11M UNLESS OTHERWISE NOTED. REFER TO STD B-12M
  - ALL DRIVE RADII SHALL BE 6M UNLESS OTHERWISE NOTED. REFER TO STD B-7M

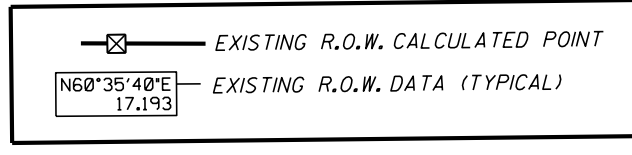

LINES SHOWN ON THIS PLAN AS EXISTING PROPERTY LINES P/L ARE BELIEVED TO BE ACCURATE BUT SHOULD NOT BE RELIED UPON FOR PURPOSES UNRELATED TO THE STATE OF VERMONT'S ACQUISITION OF LAND AND RIGHTS FOR THIS PROJECT.

**FOR R.O.W. USE ONLY**

SEE LAYOUT SHEETS FOR CONSTRUCTION CHANGES

(R.O.W. AS BUILT)

PROJECT NAME:	HIGHGATE-FRANKLIN (AS BUILT)
PROJECT NUMBER:	STP RS 0301(I) SA
FILE NAME:	NAME\$DGN
PROJECT LEADER:	DELLASANTA
DESIGNED BY:	SQUAD B
ROW LAYOUT SHEET	4A OF 26 51 OF 73
PLOT DATE:	12-FEB-2014 11:47
DRAWN BY:	N. GARBACH-ROW
CHECKED BY:	H. PETROVS
SHEET	45 51A OF 73 450