

**STEEL BEAM GUARDRAIL**  
 STA 2+831.421 TO STA 2+854.221 LT  
 STA 2+831.421 TO STA 2+854.221 RT

**MANUFACTURED TERMINAL SECTION (TANGENTIAL)**  
 STA 2+816.222 TO STA 2+831.421 RT  
 STA 2+854.221 TO STA 2+869.461 RT  
 STA 2+816.222 TO STA 2+831.421 LT  
 STA 2+854.221 TO STA 2+869.461 LT

**CONSTRUCT DRIVE**  
 STA 2+983.000 LT GRAVEL  
 STA 3+037.000 RT GRAVEL  
 STA 3+068.000 LT GRAVEL

STA 3+098.230 TO STA 3+100.000 LT  
 PERMANENT SEDIMENT TRAP  
 SEE DETAIL SHEET 162 OF 450

**GRUBBING MATERIAL**  
 STA 2+816.217 TO STA 2+869.494 LT  
 STA 2+816.217 TO STA 2+869.494 RT

**STONE FILL, TYPE II**  
 STA 2+816.217 TO STA 2+869.494 LT  
 STA 2+816.217 TO STA 2+869.494 RT

**EROSION MATTING (JUTE)**  
 STA 2+816.217 TO STA 2+869.494 LT  
 STA 2+816.217 TO STA 2+869.494 RT

**RELOCATE MAIL BOX, SINGLE SUPPORT**  
 STA 3+042.750 LT  
 STA 3+077.850 LT

**CONSTRUCT SPECIAL DITCH**  
 STA 2+890.000 TO STA 2+910.000 RT  
 STA 2+950.000 TO STA 2+979.500 LT  
 STA 2+950.000 TO STA 3+030.500 RT  
 STA 2+986.500 TO STA 3+030.000 LT  
 STA 3+045.000 TO STA 3+090.000 RT

**CURVE #9**  
 Δ 09° 37' 57" RT  
 571.000 M  
 95.996 M  
 48.111 M  
 2.023 M  
 3.700%

**CURVE #8**  
 Δ 18° 04' 38" LT  
 418.000 M  
 131.882 M  
 66.494 M  
 5.256 M  
 4.500%

**SLEEVES FOR UTILITIES (115 mm DIAMETER)(MOD)**  
 STA 2+740.000 TO STA 2+830.000 LT

END UNDERGROUND RELOCATION ROUTE BY VERIZON

APPROXIMATE LOCATION EXISTING STAND PIPES

BESSETTE, DONALD P. & FRANCES M.  
 BESSETTE, SCOTT R.  
 BESSETTE, MARC D.  
 JOINED BY VERMONT LAND TRUST, INC. ET AL

BESSETTE, DONALD P. & FRANCES M.  
 BESSETTE, SCOTT R.  
 BESSETTE, MARC D.  
 JOINED BY VERMONT LAND TRUST, INC. ET AL

DUPUIS, JACQUES A. & SUZANNE G.  
 DUPUIS, LUC & JEANNINE

REVISED PROPOSED UNDERGROUND SLEEVE FOR UTILITIES INSTALL WITHIN R.O.W. SEE DETAIL SHEET 68 OF 450

CURVE R=372.456 L=115.557

CURVE R=387.544 L=120.238

EXISTING 250mm SLEEVE TO BE REMOVED AND REPLACED WITH A NEW 250mm SLEEVE AND A NEW 150mm PIPE

STA 2+817.000 RT  
 ASKEW = 82° 04' 47" LT  
 NEW 750mm x 18m C-APP  
 STONE FILL CRADLE HEADWALL AT INLET AND OUTLET  
 STONE FILL TYPE II AT INLET (L=3.0M, D=0.6M, W=1.125M)  
 REMOVE EXISTING 380mm CMP  
 STA 2+860.000 RT  
 NEW 200mm x 5m UNDERDRAIN CARRIER PIPE W/ FLUSHING BASIN AT STA 2+860.000 RT

STA 2+860.000 LT  
 NEW 200mm x 5m UNDERDRAIN CARRIER PIPE W/ FLUSHING BASIN AT STA 2+860.000 LT


STA 2+860.000 TO STA 2+960.000 RT  
 NEW 200mm x 100m UNDERDRAIN W/ FLUSHING BASIN AT STA 2+960.000 RT

STA 2+960.000 TO STA 3+100.000 RT  
 NEW 200mm x 100m UNDERDRAIN W/ FLUSHING BASIN AT STA 2+960.000 RT

STA 3+020.000 RT  
 FLUSHING BASIN


STA 3+033.447 TO STA 3+045.965 RT  
 REMOVE EXISTING DRIVE PIPE

STA 3+048.064 RT  
 NEW 150mm x 15m CSP 1.63mm

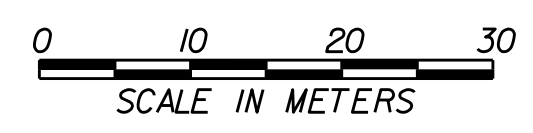

○ DENOTES TREE OR STUMP REMOVAL

- NOTES:**
- ALL SIDE ROAD RADII SHALL BE 11M UNLESS OTHERWISE NOTED. REFER TO STD B-12M
  - ALL DRIVE RADII SHALL BE 6M UNLESS OTHERWISE NOTED. REFER TO STD B-71M

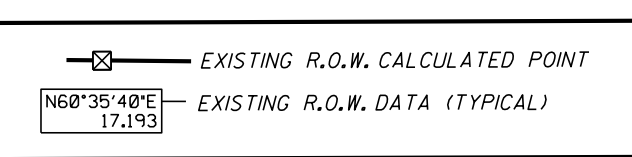

LINES SHOWN ON THIS PLAN AS EXISTING PROPERTY LINES P/L ARE BELIEVED TO BE ACCURATE BUT SHOULD NOT BE RELIED UPON FOR PURPOSES UNRELATED TO THE STATE OF VERMONT'S ACQUISITION OF LAND AND RIGHTS FOR THIS PROJECT.

**FOR R.O.W. USE ONLY**

SEE LAYOUT SHEETS FOR CONSTRUCTION CHANGES

(R.O.W. AS BUILT)

PROJECT NAME:	HIGHGATE-FRANKLIN (AS BUILT)
PROJECT NUMBER:	STP RS 0301(I) SA
FILE NAME:	NAME\$DGN
PROJECT LEADER:	DELLASANTA
DESIGNED BY:	SQUAD B
ROW LAYOUT SHEET	6A OF 26-53 OF 73
PLOT DATE:	12-FEB-2014 11:47
DRAWN BY:	N. GARBACH-ROW
CHECKED BY:	H. PETROVS
SHEET	47-53A OF 73-450