

CONSTRUCT DRIVE
 STA 3+540.000 RT GRAVEL
 STA 3+549.000 LT GRAVEL
 STA 3+560.000 RT GRAVEL

MANUFACTURED TERMINAL SECTION (TANGENTIAL)
 STA 3+597.617 TO STA 3+612.857 LT
 STA 3+647.057 TO STA 3+662.297 LT
 STA 3+600.000 TO STA 3+615.198 RT
 STA 3+683.597 TO STA 3+698.838 RT

RELOCATE MAIL BOX, SINGLE SUPPORT
 STA 3+544.880 LT

STONE FILL, TYPE II
 STA 3+597.659 TO STA 3+662.340 LT
 STA 3+600.000 TO STA 3+698.880 RT

REMOVING AND RESETTING FENCE
 STA 3+465.150 LT - 4.5M BACK
 STA 3+465.150 TO STA 3+505.630 LT
 STA 3+505.630 LT - 6M BACK
 STA 3+566.880 TO STA 3+631.920 LT
 STA 3+566.880 LT - 4M BACK
 STA 3+631.920 LT - 8M BACK

EROSION MATTING (JUTE)
 STA 3+597.659 TO STA 3+662.340 LT
 STA 3+600.000 TO STA 3+698.880 RT

GRUBBING MATERIAL
 STA 3+597.659 TO STA 3+662.340 LT
 STA 3+600.000 TO STA 3+698.880 RT

CONSTRUCT SPECIAL DITCH
 STA 3+530.000 TO STA 3+546.000 LT
 STA 3+543.000 TO STA 3+570.000 RT

SNOW FENCE
 STA 3+520.000 TO STA 3+580.000 RT

6C
 BESSETTE, DONALD P. & FRANCES M.
 BESSETTE, SCOTT R.
 BESSETTE, MARC D.
 JOINED BY VERMONT LAND TRUST, INC. ET AL

II
 DUPUIS, LUC & JEANNINE

66D
 BESSETTE, DONALD P. & FRANCES M.
 JOINED BY VERMONT LAND TRUST, INC. ET AL

6E
 BESSETTE, DONALD P. & FRANCES M.
 BESSETTE, SCOTT R.
 BESSETTE, MARC D.
 JOINED BY VERMONT LAND TRUST, INC. ET AL

66C
 BESSETTE, DONALD P. & FRANCES M.
 JOINED BY VERMONT LAND TRUST, INC. ET AL


CURVE #/I	Δ	R	L	T	B
16° 35' 50" LT	436.000 M	126.298 M	63.594 M	4.613 M	4.400%

STA 3+460.000 TO STA 3+461.770 RT
 PERMANENT SEDIMENT TRAP
 SEE DETAIL SHEET I62 OF 450

6D
 BESSETTE, DONALD P. & FRANCES M.
 BESSETTE, SCOTT R.
 BESSETTE, MARC D.
 JOINED BY VERMONT LAND TRUST, INC. ET AL


63
 BESSETTE, SCOTT R. & ELIZABETH M.

12A
 FORMERLY
 BESSETTE, DONALD P. & FRANCES M.
 BESSETTE, BRIAN H.

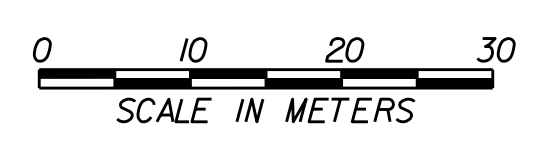

○ DENOTES TREE OR STUMP REMOVAL

- NOTES:**
1. ALL SIDE ROAD RADII SHALL BE 11M UNLESS OTHERWISE NOTED. REFER TO STD B-12M
 2. ALL DRIVE RADII SHALL BE 6M UNLESS OTHERWISE NOTED. REFER TO STD B-7M

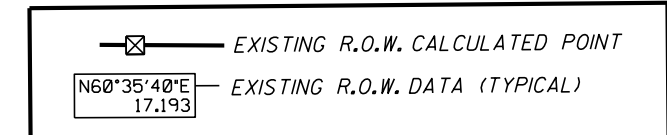

LINES SHOWN ON THIS PLAN AS EXISTING PROPERTY LINES P/L ARE BELIEVED TO BE ACCURATE BUT SHOULD NOT BE RELIED UPON FOR PURPOSES UNRELATED TO THE STATE OF VERMONT'S ACQUISITION OF LAND AND RIGHTS FOR THIS PROJECT.

FOR R.O.W. USE ONLY

SEE LAYOUT SHEETS FOR CONSTRUCTION CHANGES

(R.O.W. AS BUILT)

PROJECT NAME:	HIGHGATE-FRANKLIN (AS BUILT)
PROJECT NUMBER:	STP RS 0301(I) SA
FILE NAME:	NAME\$DGN
PROJECT LEADER:	DELLASANTA
DESIGNED BY:	SQUAD B
ROW LAYOUT SHEET	8A OF 26 55 OF 73
PLOT DATE:	12-FEB-2014 11:47
DRAWN BY:	N. GARBACH ROW
CHECKED BY:	H. PETROVS
SHEET	49 55A OF 73 450