
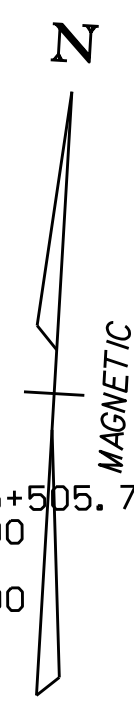
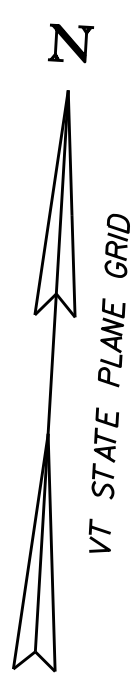


FOR R.O.W. USE ONLY

LINES SHOWN ON THIS PLAN AS EXISTING PROPERTY LINES P/L ARE BELIEVED TO BE ACCURATE BUT SHOULD NOT BE RELIED UPON FOR PURPOSES UNRELATED TO THE STATE OF VERMONT'S ACQUISITION OF LAND AND RIGHTS FOR THIS PROJECT.

- CONSTRUCT DRIVE**
 STA 5+575.000 RT GRAVEL
 STA 5+628.000 LT GRAVEL
 STA 5+735.000 LT GRAVEL
 STA 5+764.000 LT GRAVEL
- PORTLAND CEMENT CONCRETE SIDEWALK, 125MM**
 STA 5+529.000 RT (3M BACK)
- CONSTRUCT SPECIAL DITCH**
 STA 5+450.000 TO STA 5+490.000 RT
 STA 5+510.000 TO STA 5+590.000 LT
 STA 21+050.000 TO STA 21+055.000 RT
 STA 22+005.000 TO STA 22+071.000 LT
 STA 22+005.000 TO STA 22+071.000 RT
 STA 5+730.000 TO STA 5+780.000 RT
 STA 5+766.500 TO STA 5+780.000 LT
- VERTICAL GRANITE CURB**
 TH #24 STA 21+060.000 LT TO ML STA 5+540.000 RT
- REMOVING AND RESETTING FENCE**
 TH #15 STA 22+023.530 RT 2M BACK
 TH #15 STA 22+023.530 TO STA 22+077.000 RT
 STA 5+576.160 TO STA 5+600.000 LT
- SNOW FENCE**
 STA 5+580.000 TO STA 5+660.000 LT

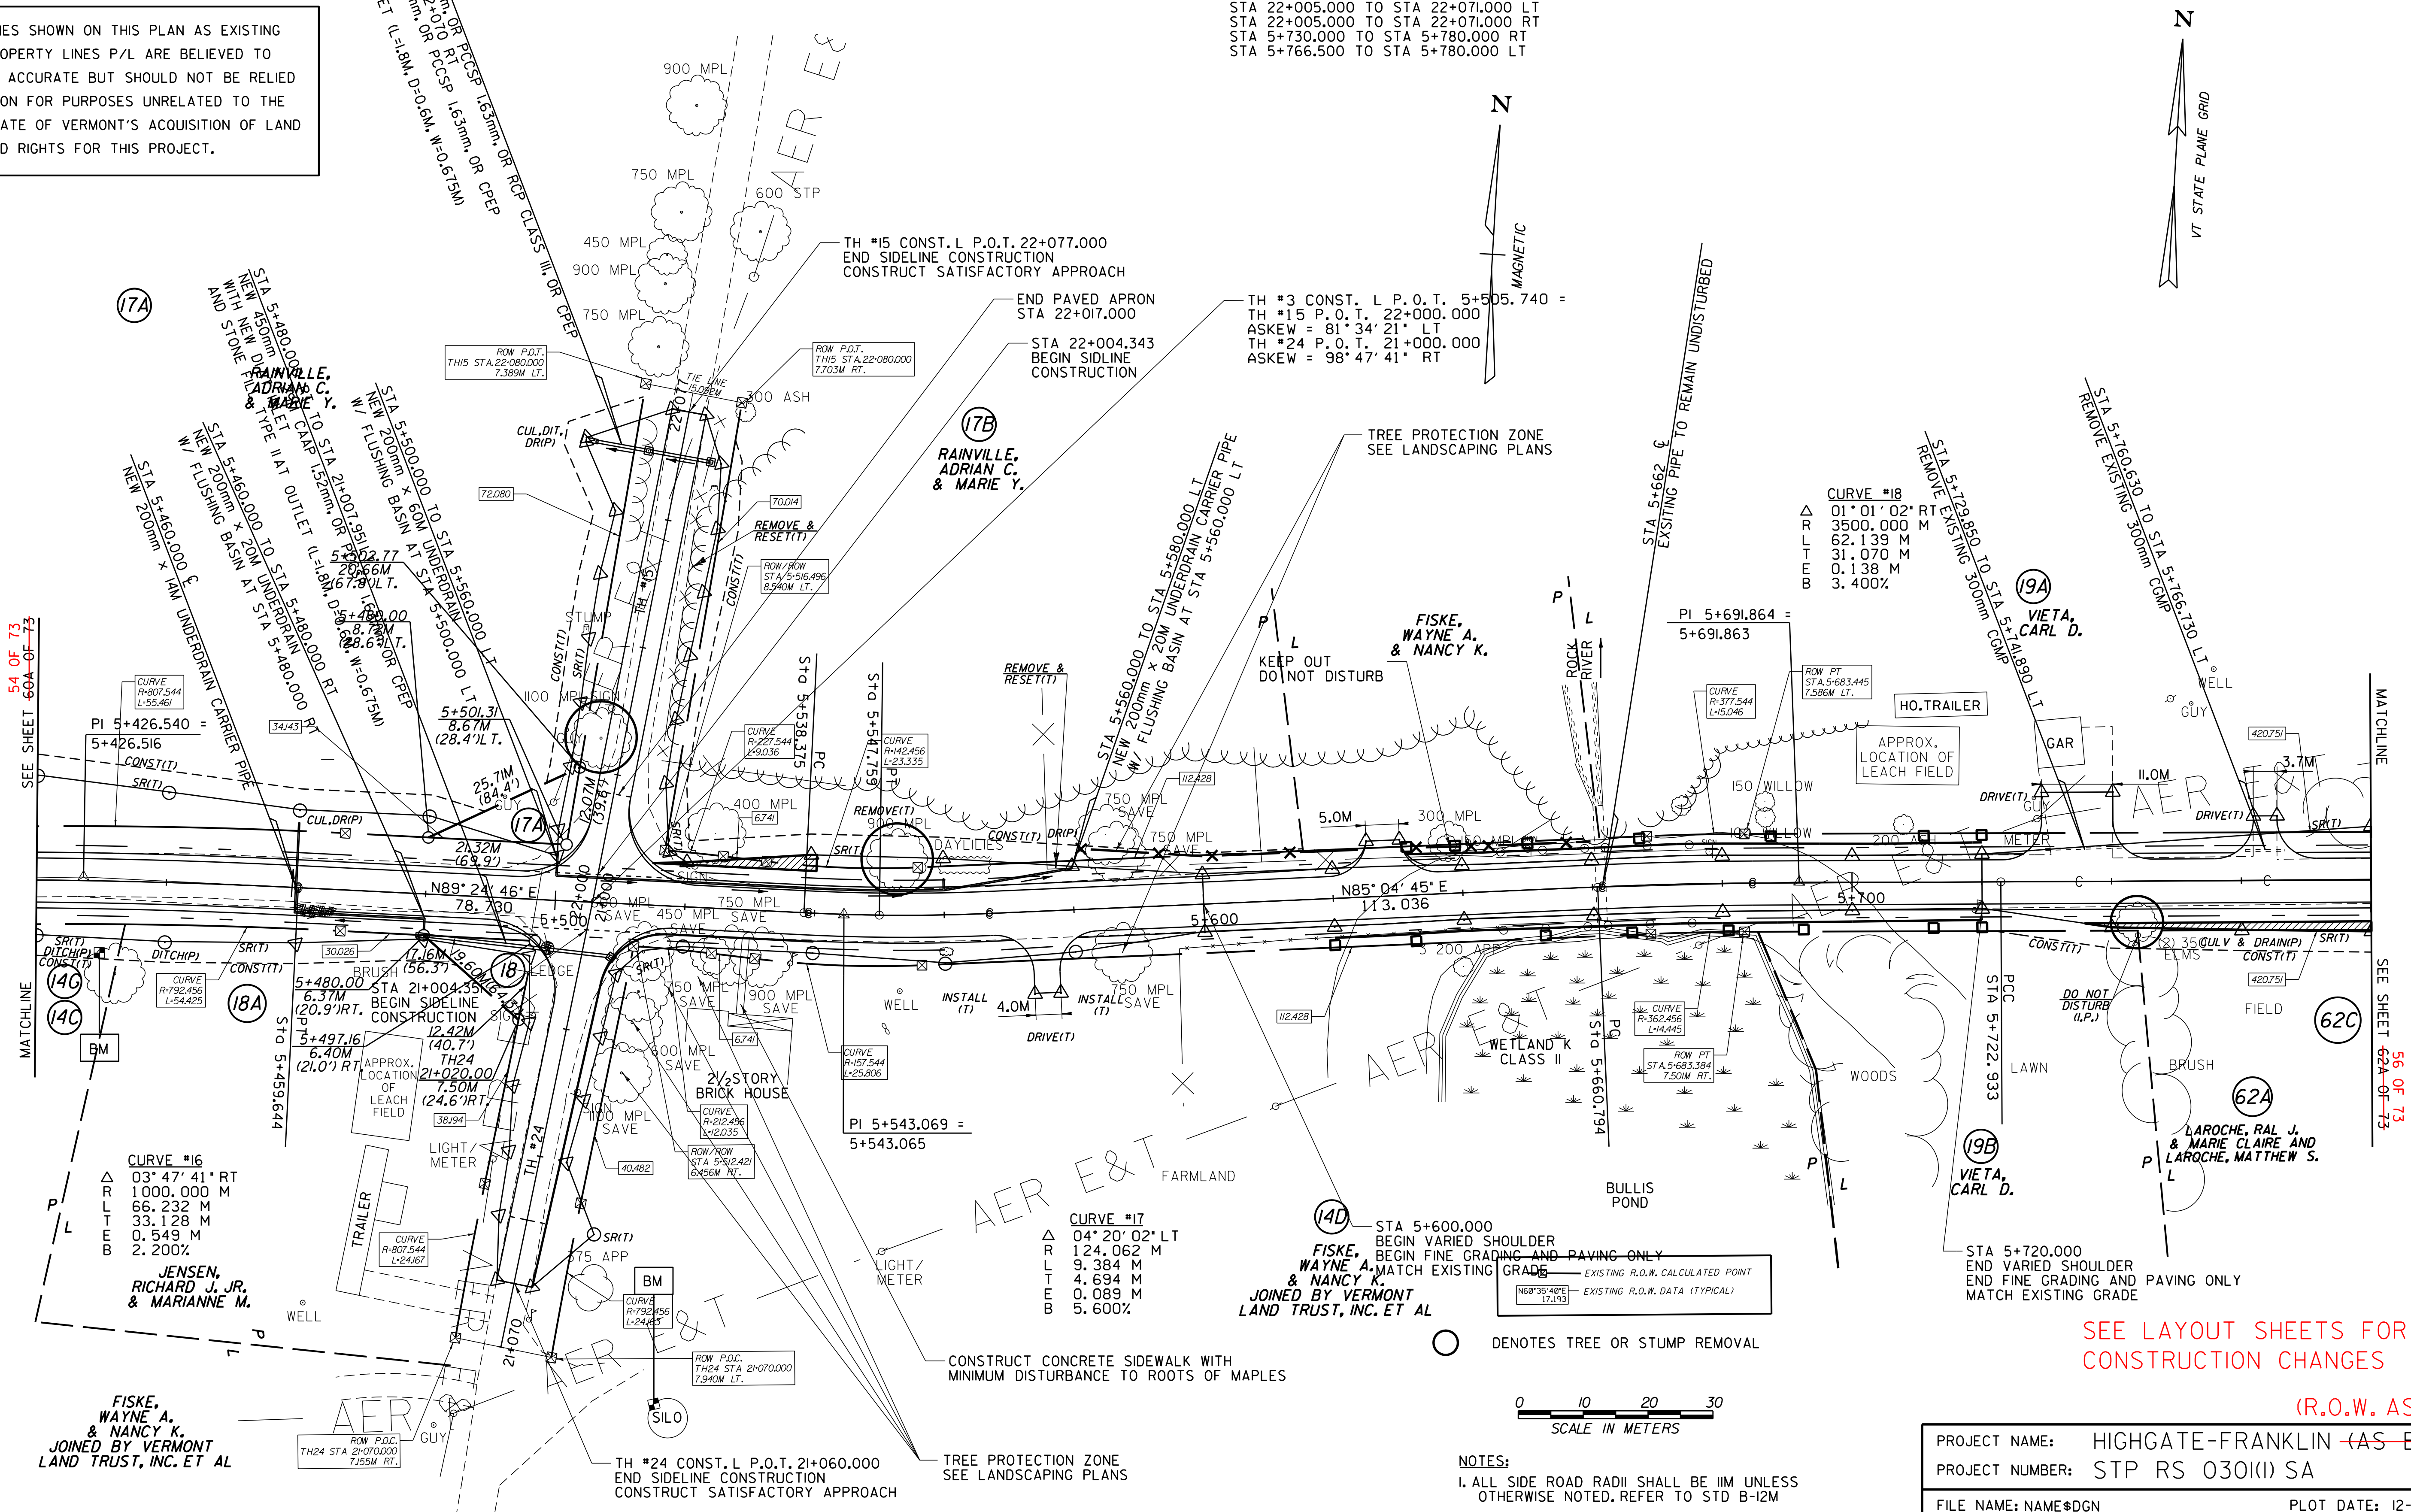


54 OF 73
SEE SHEET 60A OF 73

56 OF 73
SEE SHEET 62A OF 73

SEE LAYOUT SHEETS FOR CONSTRUCTION CHANGES

(R.O.W. AS BUILT)

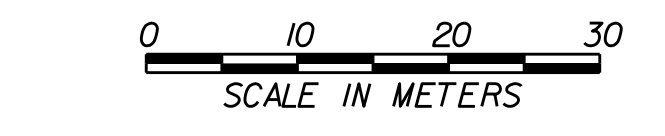

- NOTES:**
- ALL SIDE ROAD RADII SHALL BE 11M UNLESS OTHERWISE NOTED. REFER TO STD B-12M
 - ALL DRIVE RADII SHALL BE 6M UNLESS OTHERWISE NOTED. REFER TO STD B-71M

PROJECT NAME:	HIGHGATE-FRANKLIN (AS BUILT)	PLOT DATE:	12-FEB-2014 11:47
PROJECT NUMBER:	STP RS 0301(I) SA	PROJECT LEADER:	N. GARBACH-ROW
FILE NAME:	NAME\$DGN	DESIGNED BY:	SQUAD B
PROJECT LEADER:	DELLASANTA	CHECKED BY:	H. PETROVS
ROW LAYOUT SHEET 44A OF 26- 61 OF 73		SHEET 55 61A OF 73 450	