

CONSTRUCT DRIVE
 REV STA 8+352.570 LT GRAVEL
 STA 8+412.000 LT GRAVEL
 STA 8+585.000 RT GRAVEL
 STA 8+587.000 LT GRAVEL
 STA 8+626.000 RT GRAVEL

STEEL BEAM GUARDRAIL
 REV STA 8+339.720 RT TO STA 8+460.696 RT

RELOCATE MAIL BOX, SINGLE SUPPORT
 REV STA 8+346.340 RT TO REV STA 8+359.630 LT
 STA 8+589.827 RT
 STA 8+591.922 RT

MANUFACTURED TERMINAL SECTION (TANGENTIAL)
 STA 8+460.696 TO STA 8+475.936 RT



REMOVING AND RESETTING FENCE
 STA 8+479.000 LT - 2.5M BACK
 STA 8+479.000 TO STA 8+578.640 LT
 STA 8+578.640 LT - IM BACK

STONE FILL, TYPE II
 REV STA 8+360.000 TO STA 8+470.000 RT

GRUBBING MATERIAL
 REV STA 8+360.000 TO STA 8+470.000 RT

EROSION MATTING (JUTE)
 REV STA 8+360.000 TO STA 8+470.000 RT

CONSTRUCT SPECIAL DITCH
 REV STA 8+340.000 TO REV STA 8+357.000 LT
 REV STA 8+375.000 TO REV STA 8+408.000 LT
 STA 8+510.000 TO STA 8+584.250 LT
 STA 8+510.000 TO STA 8+582.500 RT

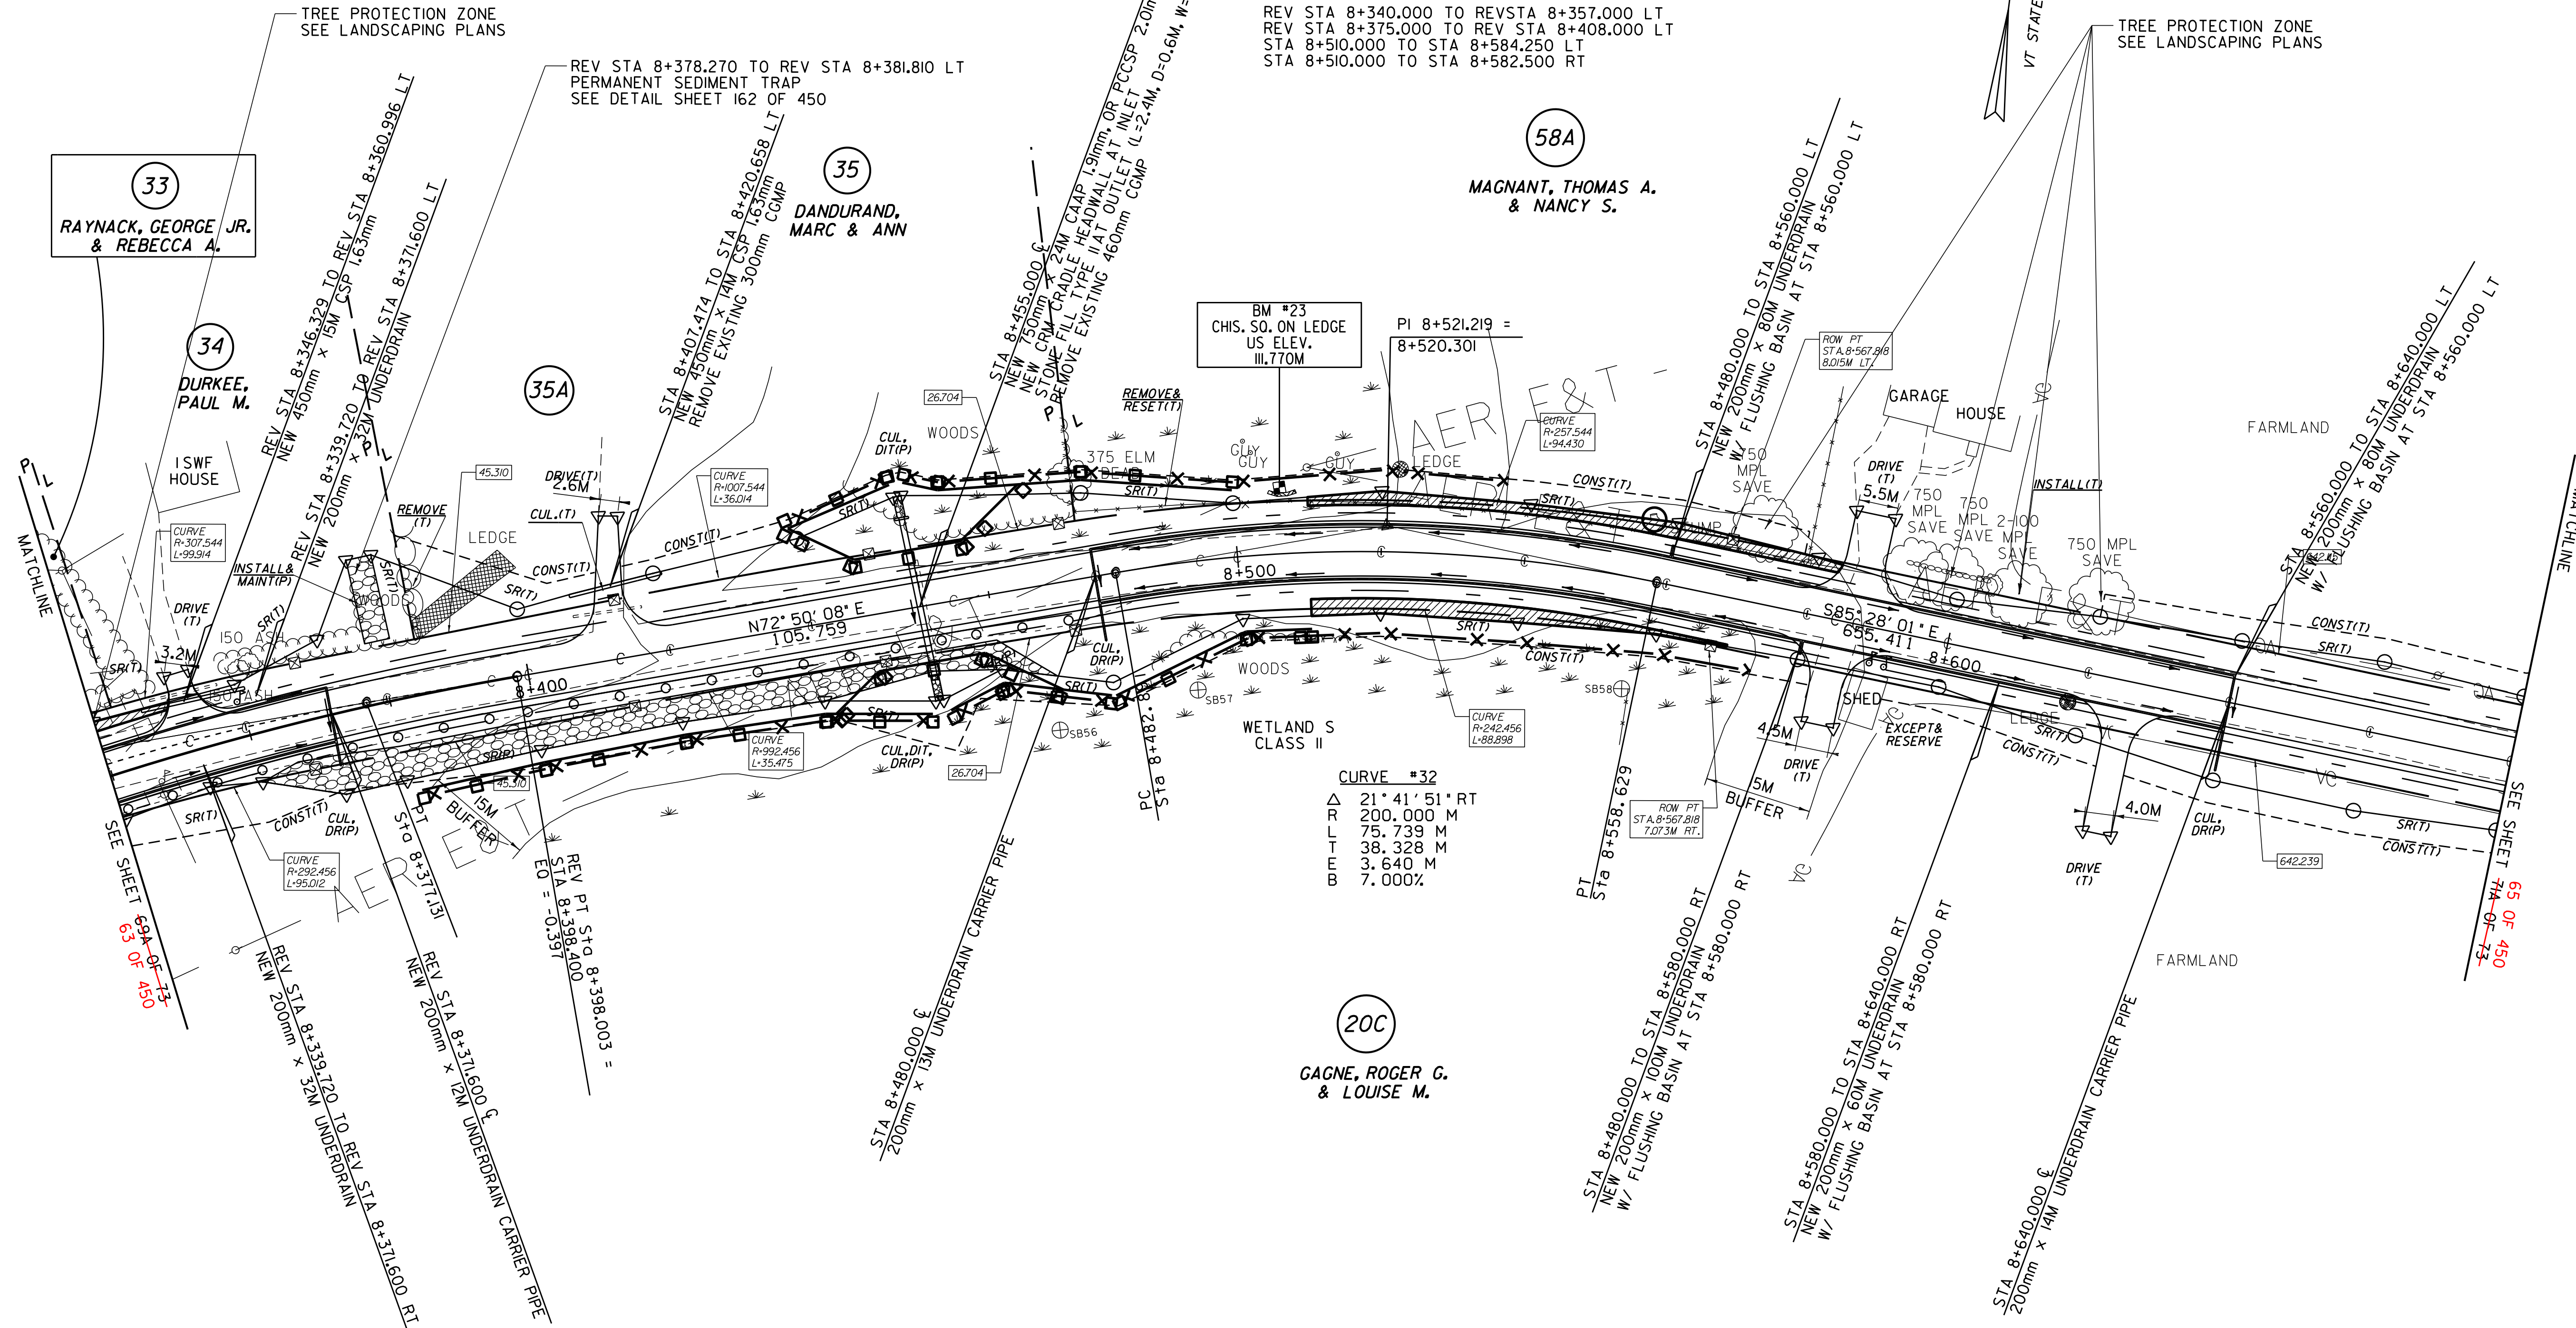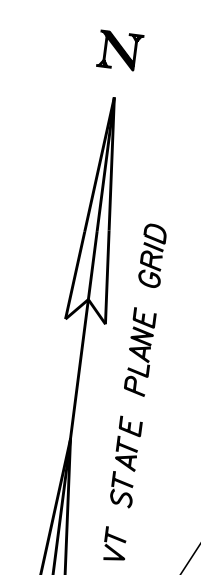


○ DENOTES TREE OR STUMP REMOVAL

LINES SHOWN ON THIS PLAN AS EXISTING PROPERTY LINES P/L ARE BELIEVED TO BE ACCURATE BUT SHOULD NOT BE RELIED UPON FOR PURPOSES UNRELATED TO THE STATE OF VERMONT'S ACQUISITION OF LAND AND RIGHTS FOR THIS PROJECT.

FOR R.O.W. USE ONLY

- NOTES:**
- ALL SIDE ROAD RADII SHALL BE 11M UNLESS OTHERWISE NOTED. REFER TO STD B-12M
 - ALL DRIVE RADII SHALL BE 6M UNLESS OTHERWISE NOTED. REFER TO STD B-7M

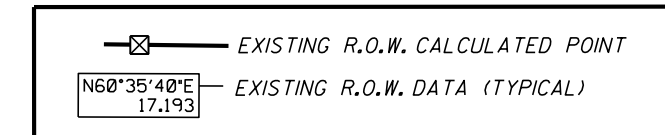

SEE LAYOUT SHEETS FOR CONSTRUCTION CHANGES

(R.O.W. AS BUILT)

PROJECT NAME:	HIGHGATE-FRANKLIN (AS BUILT)
PROJECT NUMBER:	STP RS 0301(I) SA
FILE NAME:	NAME\$DGN
PROJECT LEADER:	DELLASANTA
DESIGNED BY:	SQUAD B
ROW LAYOUT SHEET	23A OF 26 TO OF 73
PLOT DATE:	12-FEB-2014 11:47
DRAWN BY:	N. GARBACH-ROW
CHECKED BY:	H. PETROVS
SHEET	6470A OF 73-450