

CONSTRUCT DRIVE
 STA 3+244.000 RT GRAVEL
 STA 3+400.000 LT GRAVEL

GRUBBING MATERIAL
 STA 3+104.504 TO STA 3+176.638 LT
 STA 3+124.824 TO STA 3+178.039 RT
 STA 3+104.800 TO STA 3+187.000 LT
 STA 3+130.300 TO STA 3+160.000 RT

MANUFACTURED TERMINAL SECTION (TANGENTIAL)
 STA 3+104.850 TO STA 3+119.979 LT
 STA 3+161.383 TO STA 3+176.622 LT
 STA 3+124.620 TO STA 3+139.983 RT
 STA 3+162.784 TO STA 3+178.023 RT
 STA 3+100.400 TO STA 3+115.600 LT
 STA 3+163.500 TO STA 3+178.700 RT
STONE FILL TYPE II SEE BELOW
 STA 3+104.584 TO STA 3+176.638 LT
 STA 3+124.824 TO STA 3+178.039 RT
 STA 3+170.000 TO STA 3+172.700


STEEL BEAM GUARDRAIL
 STA 3+119.979 TO STA 3+161.383 LT
 STA 3+139.983 TO STA 3+162.784 RT
 STA 3+115.600 TO STA 3+188.000 LT
 STA 3+121.600 TO STA 3+163.500 RT

EROSION MATTING (JUTE) SEE BELOW
 STA 3+104.584 TO STA 3+176.638 LT
 STA 3+124.824 TO STA 3+178.039 RT

REMOVING AND RESETTING FENCE
 STA 3+100.000 TO STA 3+109.000 LT
 STA 3+110.110 RT 2M BACK
 STA 3+110.110 TO STA 3+139.850 RT
 STA 3+141.500 TO STA 3+166.000 LT
 STA 3+171.000 TO STA 3+184.000 LT
 STA 3+140.000 TO STA 3+170.000 RT

SNOW FENCE
 STA 3+200.000 TO STA 3+280.000 RT

CONSTRUCT SPECIAL DITCH
 STA 3+390.000 TO STA 3+430.000 RT
 STA 3+430.000 TO STA 3+458.000 LT

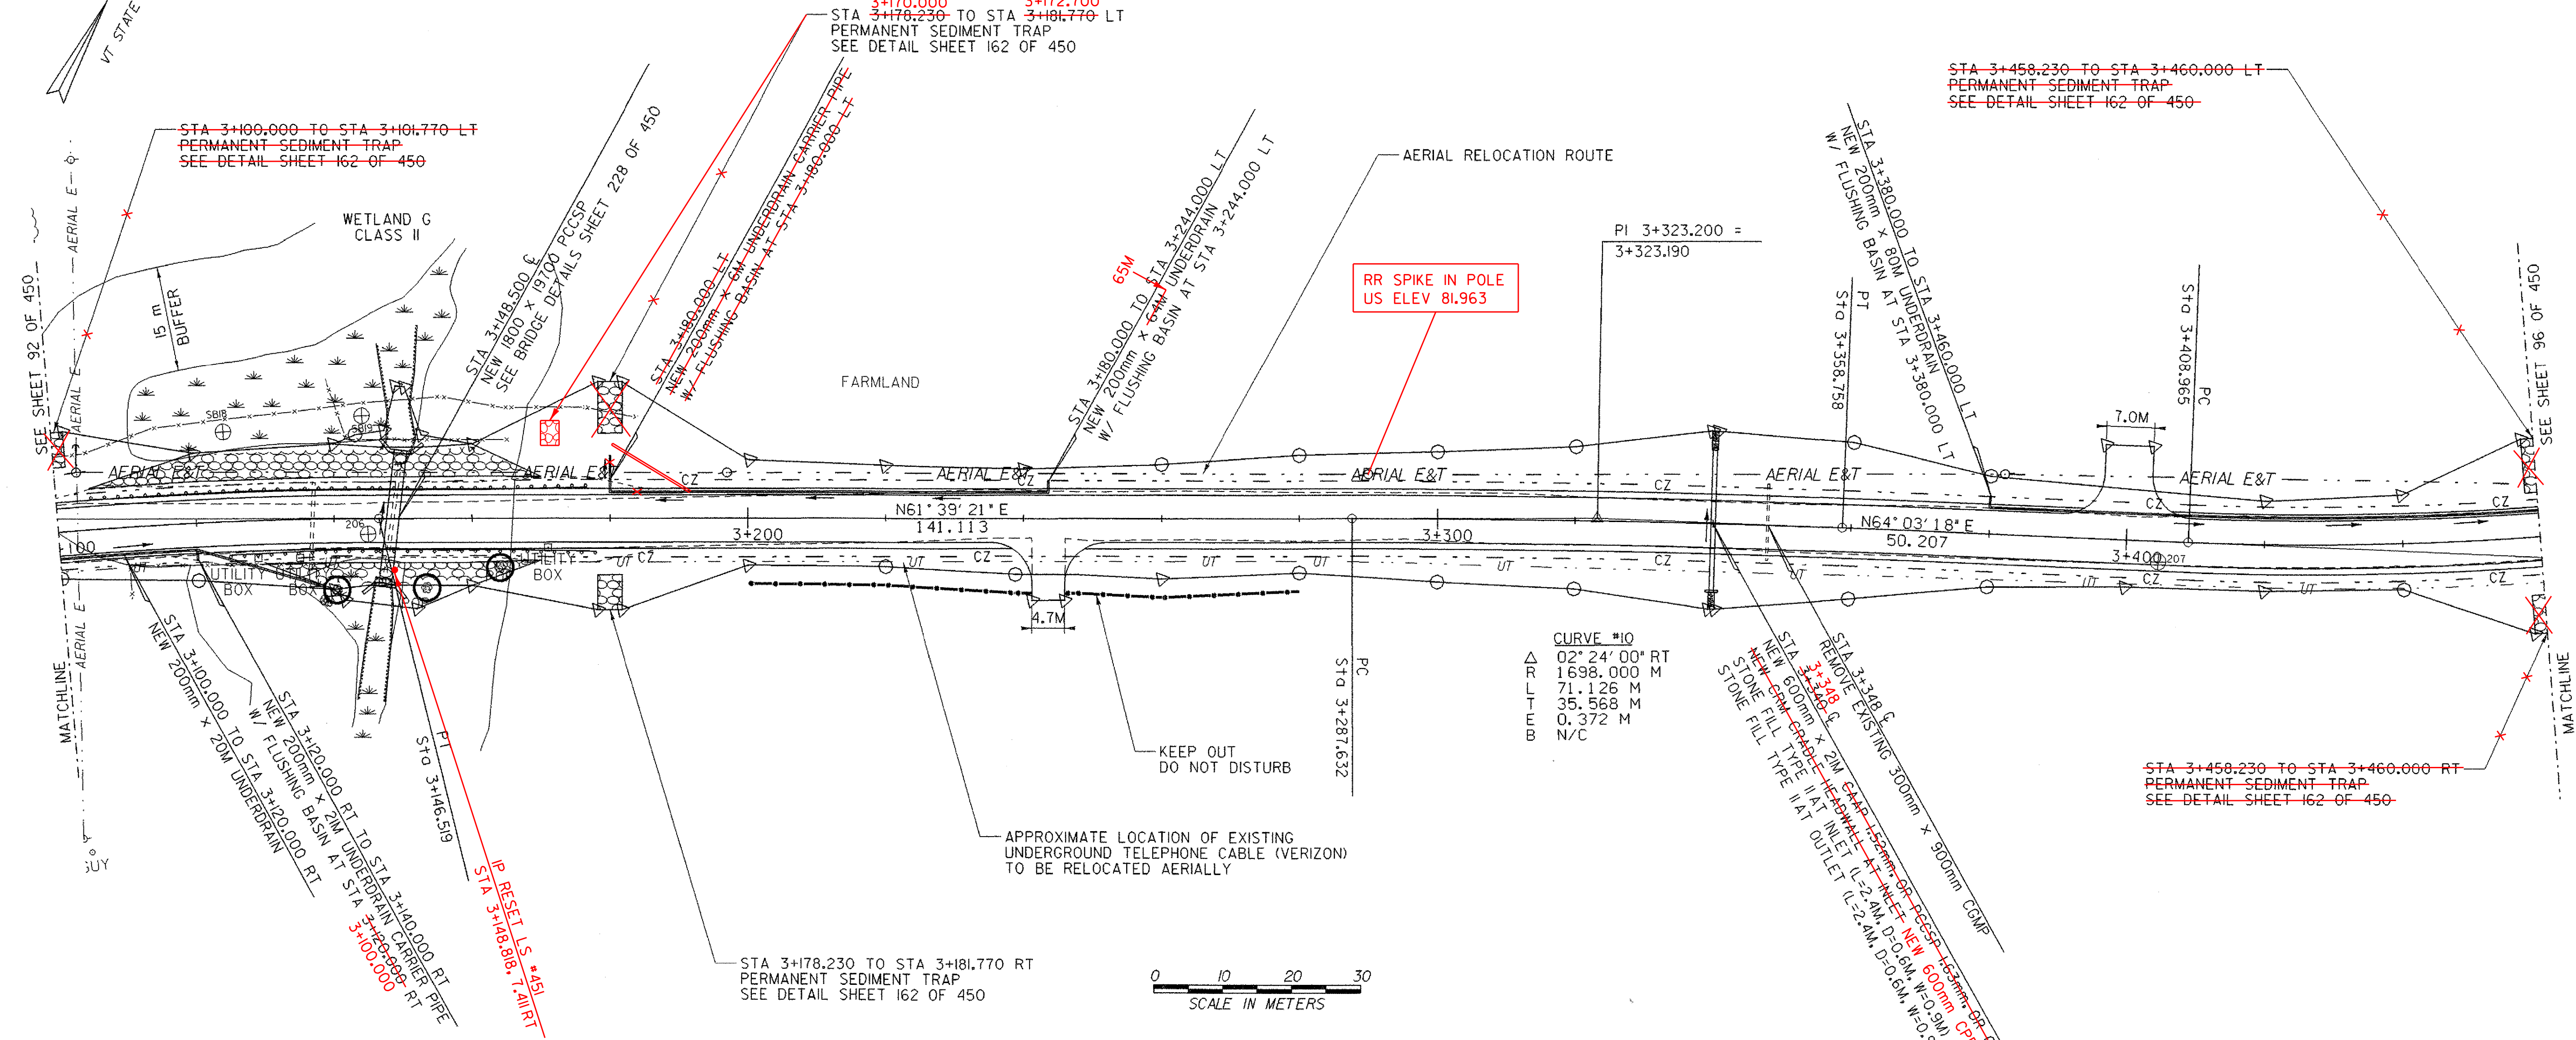

RR SPIKE IN POLE
 US ELEV 81.963



○ DENOTES TREE OR STUMP REMOVAL

- NOTES:**
1. ALL SIDE ROAD RADII SHALL BE 11M UNLESS OTHERWISE NOTED. REFER TO STD B-12M
 2. ALL DRIVE RADII SHALL BE 6M UNLESS OTHERWISE NOTED. REFER TO STD B-7M

STONE FILL TYPE II
 STA 3+104.800 TO STA 3+187.000 LT
 STA 3+130.300 TO STA 3+160.000 RT

EROSION MATTING (JUTE)
 STA 3+100.000 TO STA 3+120.000 RT
 STA 3+100.000 TO STA 3+120.000 LT
 STA 3+180.000 TO STA 3+213.000 LT
 STA 3+182.000 TO STA 3+195.000 RT
 STA 3+104.800 TO STA 3+187.000 LT
 STA 3+130.300 TO STA 3+160.000 RT

ANCHOR SFOR STEEL BEAM RAIL
 STA 3+184.200 LT
 STA 3+125.400 RT

PROJECT NAME:	HIGHGATE - FRANKLIN
PROJECT NUMBER:	STP RS 030(I) SA
FILE NAME:	...85c060/design/dc060bdr.dgn
PROJECT LEADER:	DELLASANTA
DESIGNED BY:	SQUAD B
IPARM FILE NAME:	dc060107.1
PLOT DATE:	09-MAY-2005
DRAWN BY:	SQUAD B
CHECKED BY:	SQUAD B
SHEET	94 OF 450