
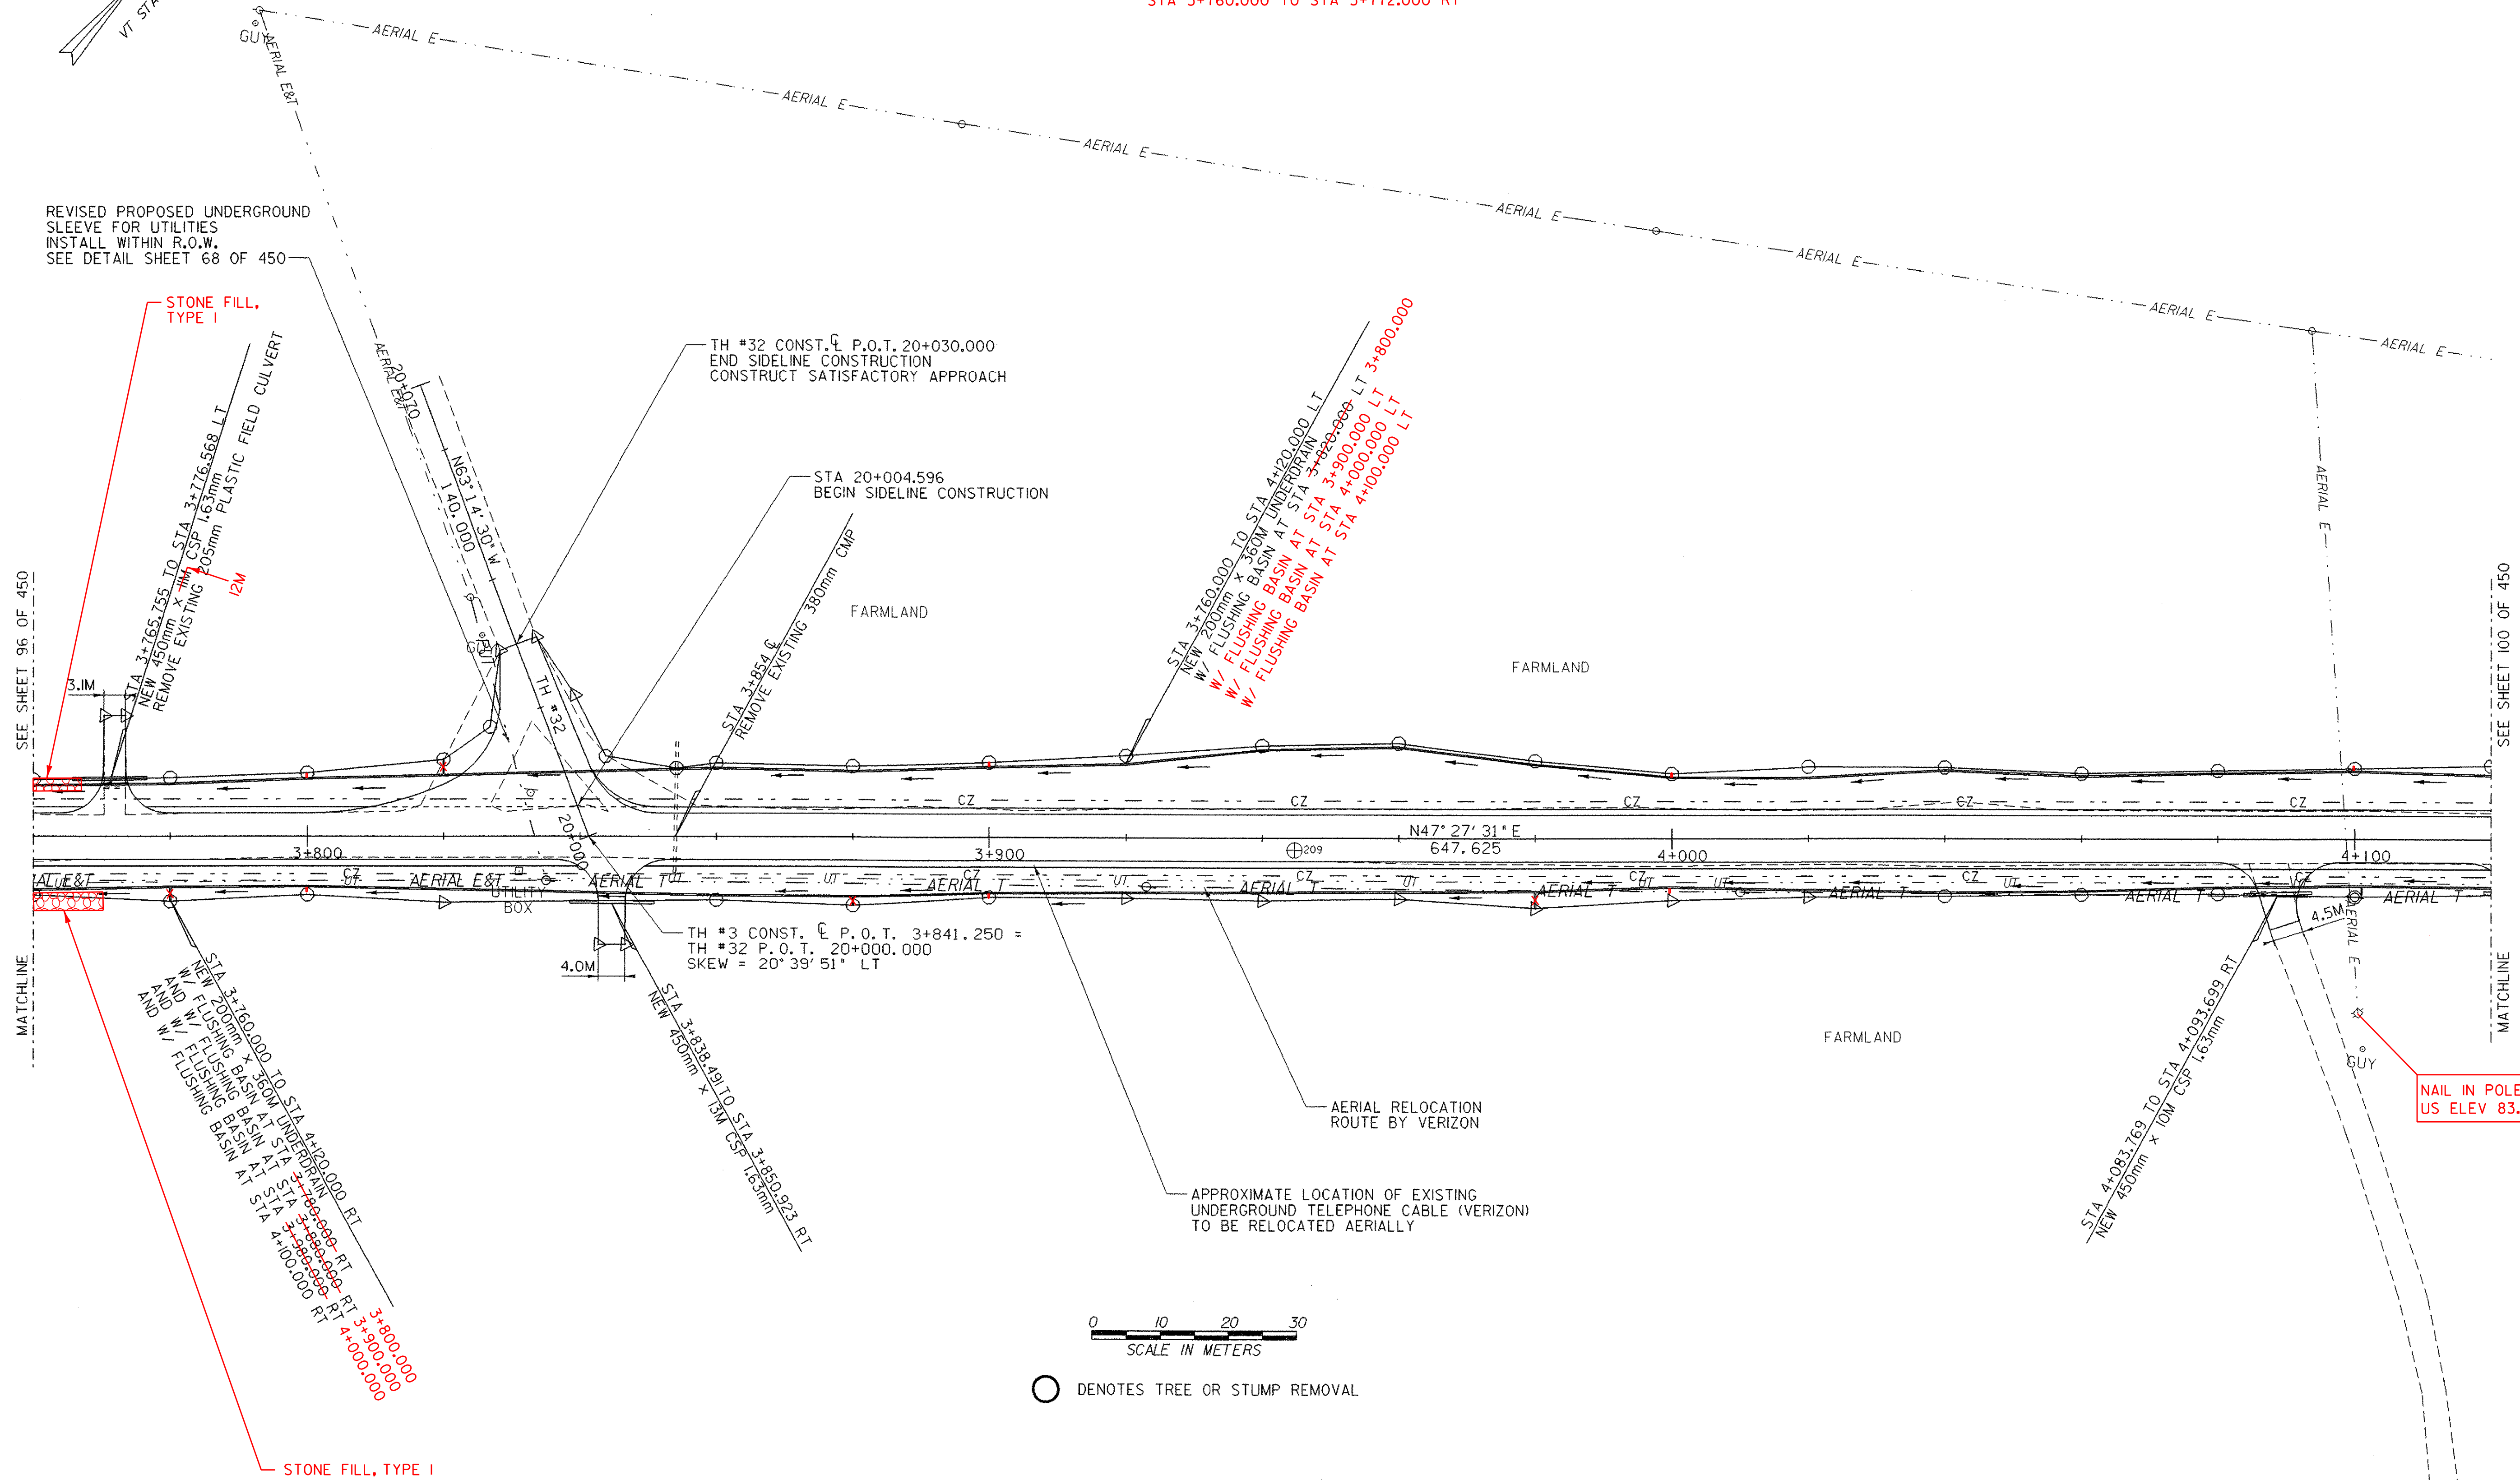


SLEEVES FOR UTILITIES (115 mm DIAMETER)(MOD)  
 STA 3+835.000 RT TO STA 20+038.748 LT

CONSTRUCT DRIVE  
 STA 3+772.000 LT GRAVEL  
 STA 3+845.000 RT GRAVEL  
 STA 4+086.000 RT GRAVEL

CONSTRUCT SPECIAL DITCH  
 STA 3+810.000 TO STA 3+830.000 RT  
 STA 3+930.000 TO STA 4+030.000 RT

STONE FILL, TYPE J  
 STA 3+760.000 TO STA 3+775.000 LT  
 STA 3+760.000 TO STA 3+772.000 RT

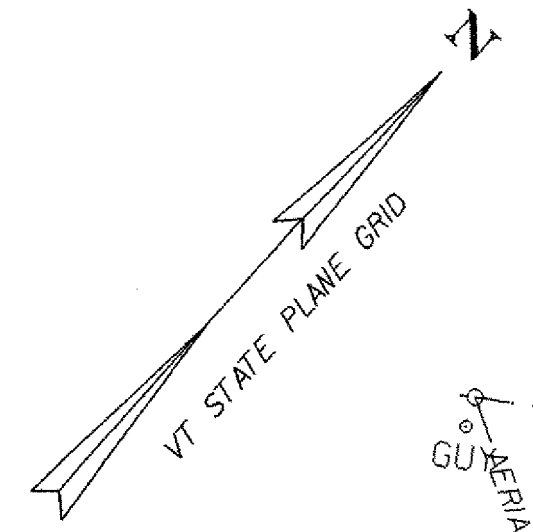

○ DENOTES TREE OR STUMP REMOVAL

- NOTES:
1. ALL SIDE ROAD RADII SHALL BE 11M UNLESS OTHERWISE NOTED. REFER TO STD B-12M
  2. ALL DRIVE RADII SHALL BE 6M UNLESS OTHERWISE NOTED. REFER TO STD B-7M

PROJECT NAME:	HIGHGATE - FRANKLIN
PROJECT NUMBER:	STP RS 030(I) SA
FILE NAME:	...85c060/design/dc060bdr.dgn
PLOT DATE:	09-MAY-2005
PROJECT LEADER:	DELLASANTA
DRAWN BY:	SQUAD B
DESIGNED BY:	SQUAD B
CHECKED BY:	SQUAD B
IPARM FILE NAME:	dc060109.1
	SHEET 98 OF 450