

**CONSTRUCT DRIVE**  
 STA 4+125.000 RT GRAVEL  
 STA 4+255.000 LT GRAVEL  
 STA 4+275.000 LT GRAVEL  
 STA 4+297.000 RT GRAVEL  
 STA 4+347.000 RT GRAVEL  
 STA 4+390.000 LT GRAVEL  
 STA 4+417.000 RT GRAVEL  
 STA 4+225.000 RT GRAVEL


**STEEL BEAM GUARDRAIL**  
 STA 4+476.314 TO STA 4+480.000 LT  
  
**RELOCATE MAIL BOX, SINGLE SUPPORT**  
 STA 4+305.000 LT  
 STA 4+421.000 LT  
  
**ANCHOR FOR STEEL BEAM RAIL**  
 STA 4+476.314 LT

**STONE FILL TYPE II**  
 STA 4+477.320 TO STA 4+480.000 LT  
 4+465.000  
**GRUBBING MATERIAL**  
 STA 4+477.320 TO STA 4+480.000 LT  
  
**EROSION MATTING (JUTE)**  
 STA 4+477.320 TO STA 4+480.000 LT  
 4+400.000  
 STA 4+136.000 TO STA 4+172.000 RT

**REMOVING AND RESETTING FENCE**  
 STA 4+392.000 RT 3M BACK  
  
**CONSTRUCT SPECIAL DITCH**  
 STA 4+230.000 TO STA 4+293.000 RT  
 STA 4+290.000 TO STA 4+385.500 LT  
 STA 4+394.500 TO STA 4+470.000 LT  
  
**STONE FILL TYPE I**  
 STA 4+277.000 TO STA 4+296.000 LT

**VERTICAL GRANITE CURB**  
 STA 4+247.000 TO STA 4+253.040 LT  
 STA 4+266.800 TO STA 4+272.830 LT  
 STA 4+276.590 TO STA 4+297.000 LT  
 STA 4+256.000 TO STA 4+270.000 LT  
 STA 4+277.000 TO STA 4+299.000 LT

**SLEEVES FOR UTILITIES (115 mm DIAMETER)(MOD)**  
 STA 4+235.000 RT TO STA 4+455.000 LT  
 STA 4+232.000 TO STA 4+390.000 RT

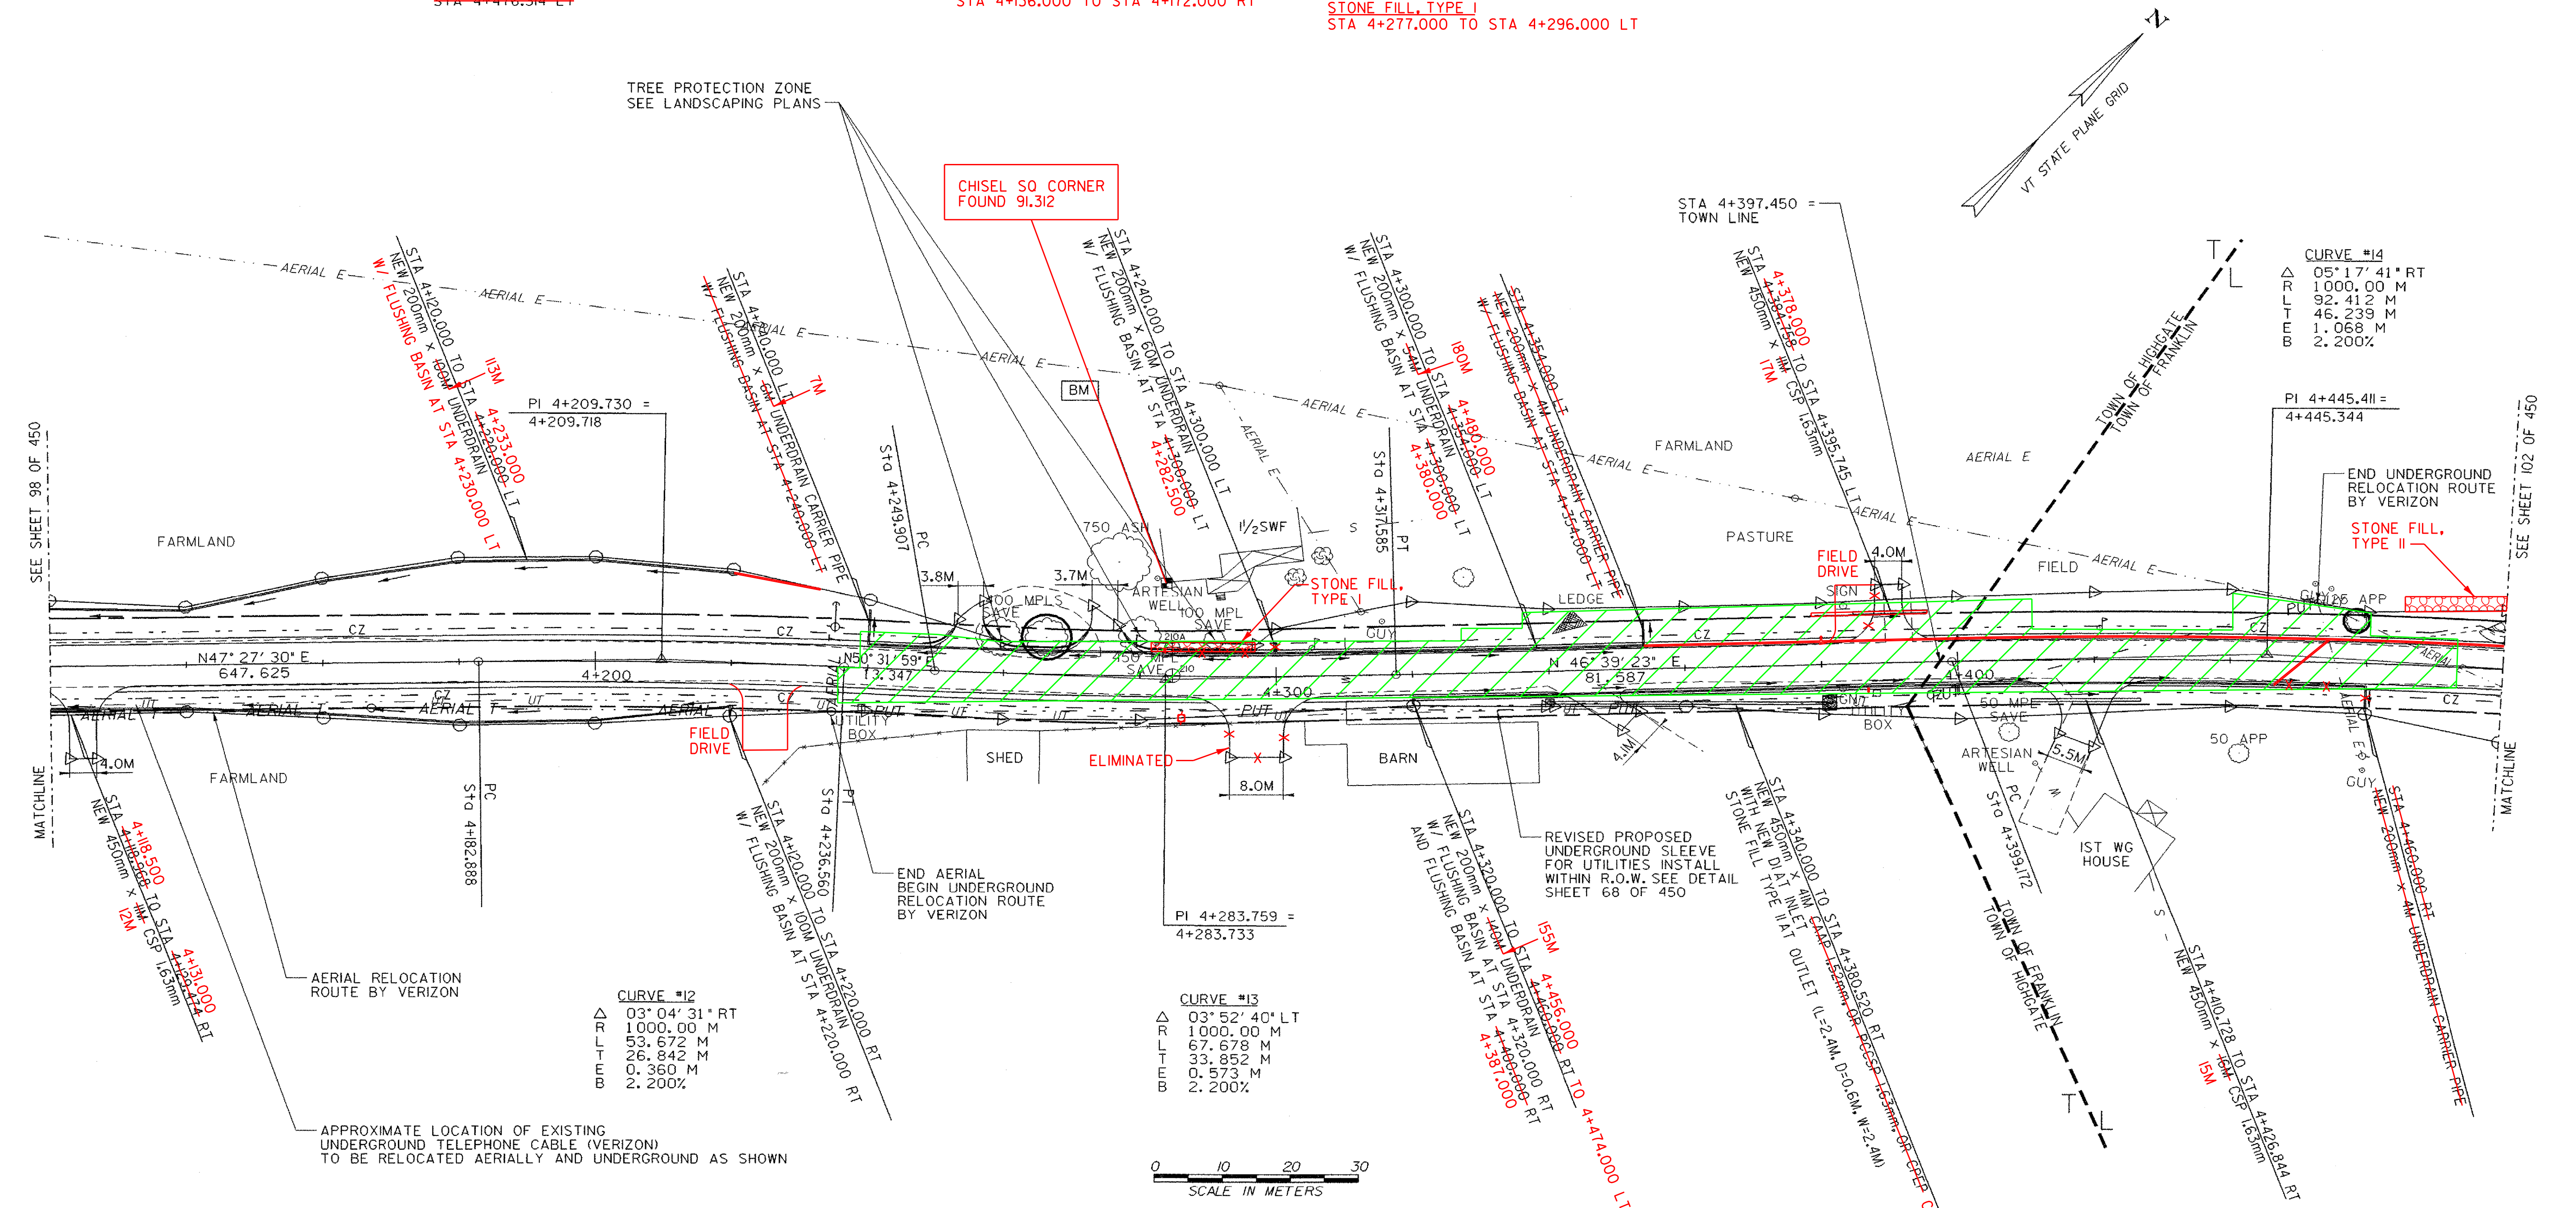

**CURVE #14**  
 $\Delta$  05°17'41" RT  
 R 1000.00 M  
 L 92.412 M  
 T 46.239 M  
 E 1.068 M  
 B 2.200%


**CURVE #12**  
 $\Delta$  03°04'31" RT  
 R 1000.00 M  
 L 53.672 M  
 T 26.842 M  
 E 0.360 M  
 B 2.200%

**CURVE #13**  
 $\Delta$  03°52'40" LT  
 R 1000.00 M  
 L 67.678 M  
 T 33.852 M  
 E 0.573 M  
 B 2.200%



○ DENOTES TREE OR STUMP REMOVAL

- NOTES:**
1. ALL SIDE ROAD RADII SHALL BE 11M UNLESS OTHERWISE NOTED. REFER TO STD B-12M
  2. ALL DRIVE RADII SHALL BE 6M UNLESS OTHERWISE NOTED. REFER TO STD B-7M

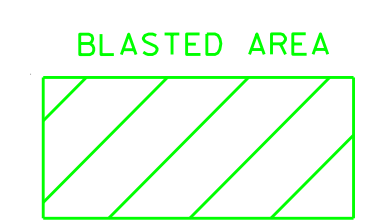

PROJECT NAME:	HIGHGATE - FRANKLIN
PROJECT NUMBER:	STP RS 030(I) SA
FILE NAME:	...85c060/design/dc060bdr.dgn
PLOT DATE:	09-MAY-2005
PROJECT LEADER:	DELLASANTA
DRAWN BY:	SQUAD B
DESIGNED BY:	SQUAD B
CHECKED BY:	SQUAD B
IPARM FILE NAME:	dc060II.1
	SHEET 100 OF 450