

STEEL BEAM GUARDRAIL
 STA 4+480.000 TO STA 4+498.788 LT
 STA 4+488.749 TO STA 4+496.130 RT

STONE FILL, TYPE II
 STA 4+480.000 TO STA 4+495.150 LT



CONSTRUCT DRIVE
 STA 4+637.000 LT GRAVEL
 STA 4+639.000 RT GRAVEL
 STA 4+633.000 LT GRAVEL
 STA 4+636.000 RT GRAVEL
 EROSION MATTING (JUTE)
 STA 4+480.000 TO STA 4+495.150 LT

ANCHOR FOR STEEL BEAM RAIL
 STA 4+488.749 RT
 STA 4+496.130 RT
 STA 4+498.788 LT

GRUBBING MATERIAL
 STA 4+480.000 TO STA 4+495.150 LT


SLEEVES FOR UTILITIES (115 mm DIAMETER)(MOD)
 STA 4+660.000 C

CONSTRUCT SPECIAL DITCH
 STA 4+491.500 TO STA 4+492.500 RT
 STA 4+670.000 TO STA 4+750.000 LT
 STA 4+790.000 TO STA 4+820.000 RT

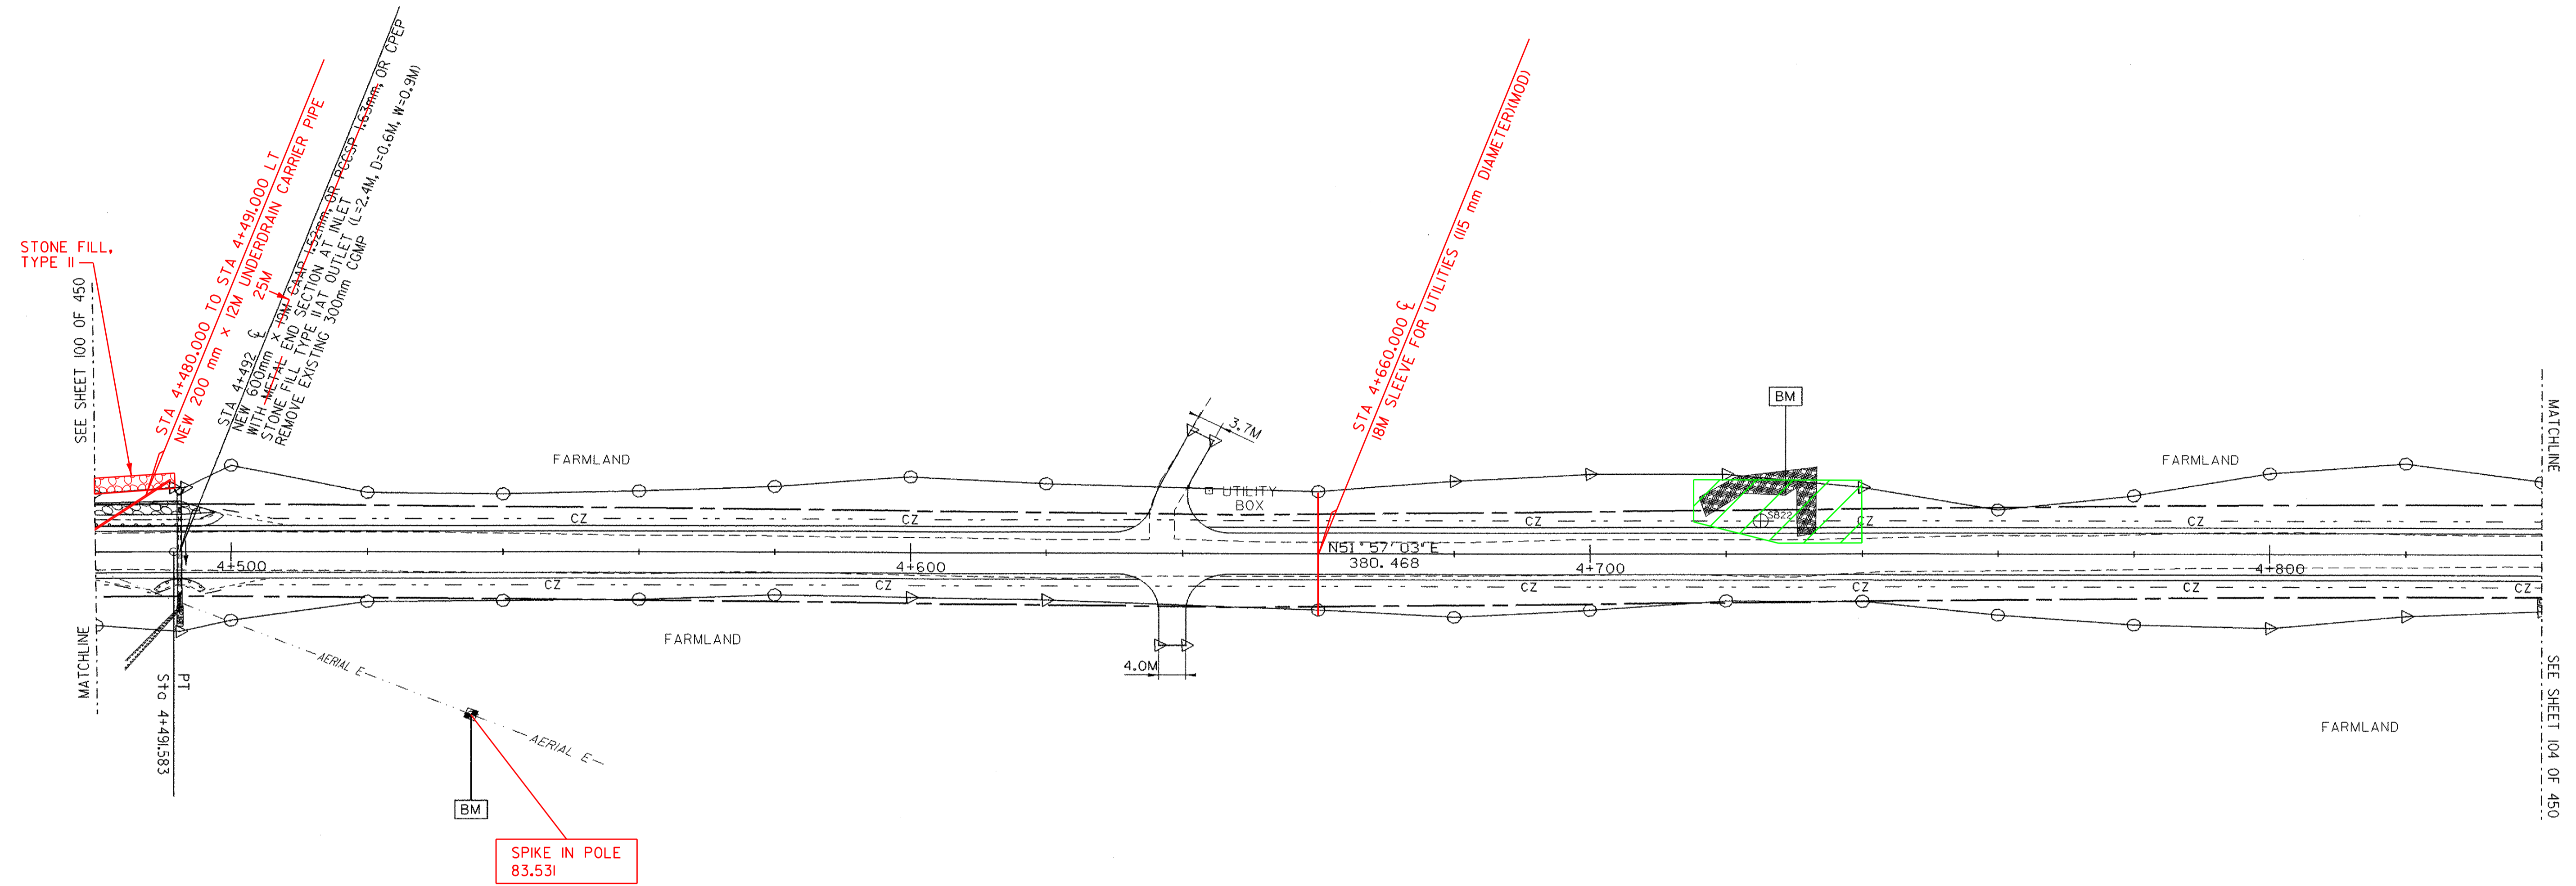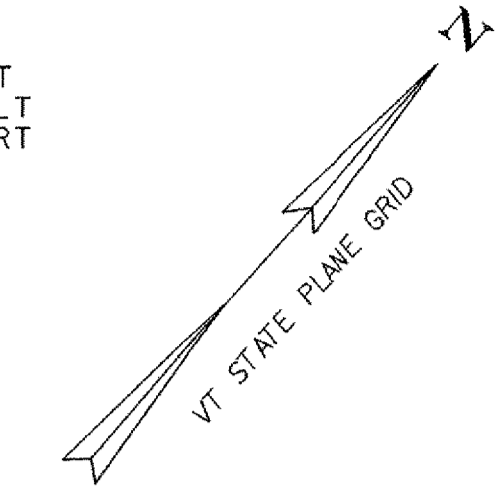

○ DENOTES TREE OR STUMP REMOVAL

- NOTES:
1. ALL SIDE ROAD RADII SHALL BE 11M UNLESS OTHERWISE NOTED. REFER TO STD B-12M
 2. ALL DRIVE RADII SHALL BE 6M UNLESS OTHERWISE NOTED. REFER TO STD B-7M

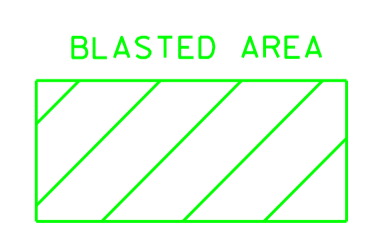

PROJECT NAME:	HIGHGATE - FRANKLIN
PROJECT NUMBER:	STP RS 030(I) SA
FILE NAME:	...85c060/design/dc060bdr.dgn
PROJECT LEADER:	DELLASANTA
DESIGNED BY:	SQUAD B
IPARM FILE NAME:	dc060III.I
PLOT DATE:	09-MAY-2005
DRAWN BY:	SQUAD B
CHECKED BY:	SQUAD B
SHEET	102 OF 450