

MANUFACTURED TERMINAL SECTION (TANGENTIAL)
~~STA 6+885.920 TO STA 6+901.097 RT~~
~~STA 6+882.000 TO STA 6+897.200 RT~~
STEEL BEAM GUARDRAIL
~~STA 6+901.097 TO STA 7+080.000 RT~~
6+897.200

CONSTRUCT DRIVE
 STA 6+774.000 LT GRAVEL
 STA 6+790.000 RT GRAVEL
 STA 6+810.000 RT GRAVEL
 STA 6+830.000 RT GRAVEL
 STA 6+840.000 LT GRAVEL
 STA 7+039.000 LT GRAVEL
 STA 7+053.000 LT GRAVEL
 STA 7+020.000 LT GRAVEL
 STA 7+036.000 LT GRAVEL

RELOCATE MAIL BOX, SINGLE SUPPORT
 STA 6+778.020 RT
 STA 6+804.700 RT



REMOVING AND RESETTING FENCE
~~STA 6+720.000 TO STA 6+737.790 RT~~
~~STA 6+737.790 RT 3.0M BACK~~
~~STA 6+816.140 RT 2.6M BACK~~

CONSTRUCT SPECIAL DITCH
 STA 6+720.000 TO STA 6+769.000 LT
 STA 6+775.000 TO STA 6+825.000 RT
 STA 6+845.000 TO STA 6+950.000 LT
 STA 7+057.000 TO STA 7+070.000 LT

STONE FILL, TYPE II
 STA ~~6+885.920~~ TO STA 7+080.000 RT
6+909.000

EROSION MATTING (JUTE)
 STA ~~6+885.920~~ TO STA 7+080.000 RT
6+909.000

GRUBBING MATERIAL
 STA ~~6+885.920~~ TO STA 7+080.000 RT
6+909.000

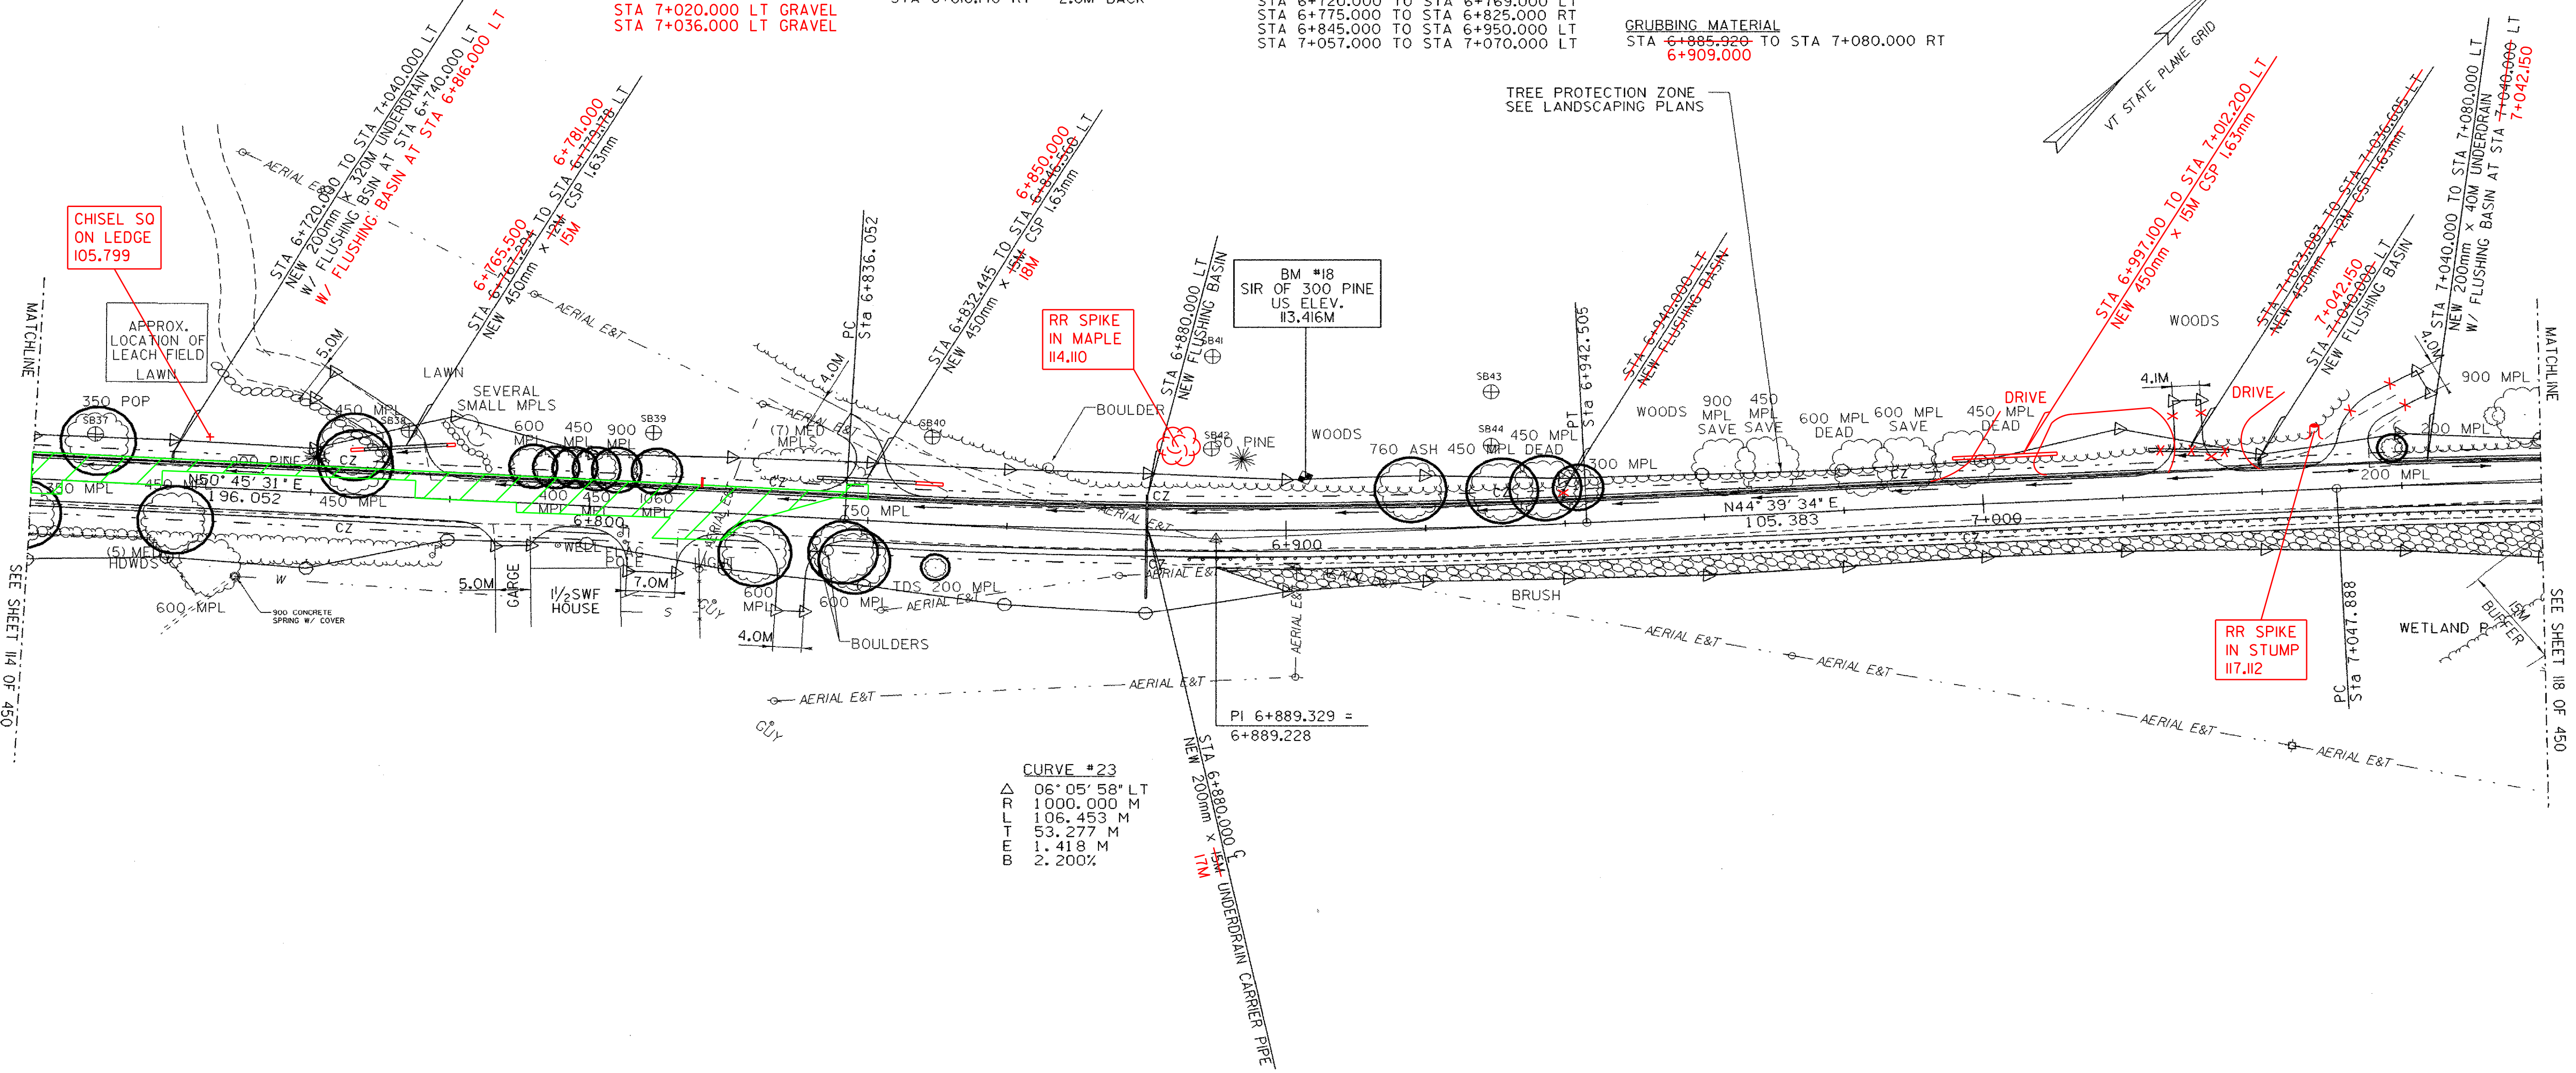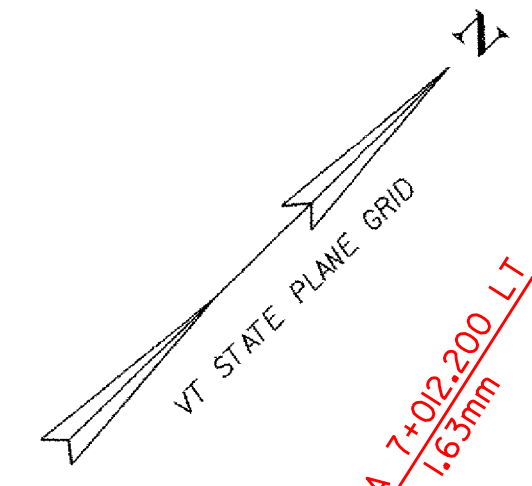


CURVE #23
 Δ 06° 05' 58" LT
 R 1000.000 M
 L 106.453 M
 T 53.277 M
 E 1.418 M
 B 2.200%



○ DENOTES TREE OR STUMP REMOVAL

NOTES:
 1. ALL SIDE ROAD RADII SHALL BE 11M UNLESS OTHERWISE NOTED. REFER TO STD B-12M
 2. ALL DRIVE RADII SHALL BE 6M UNLESS OTHERWISE NOTED. REFER TO STD B-71M

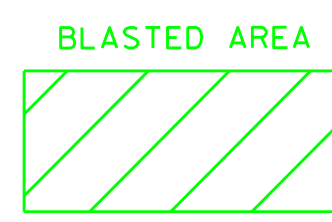

PROJECT NAME:	HIGHGATE - FRANKLIN
PROJECT NUMBER:	STP RS 030(I)SA
FILE NAME: ...85c060/design/dc060bdr.dgn	PLOT DATE: 09-MAY-2005
PROJECT LEADER: DELLASANTA	DRAWN BY: SQUAD B
DESIGNED BY: SQUAD B	CHECKED BY: SQUAD B
IPARM FILE NAME: dc060118.1	SHEET 116 OF 450