


STEEL BEAM GUARDRAIL
 STA 7+080.000 TO STA 7+360.000 RT
 MANUFACTURED TERMINAL SECTION (TANGENTIAL)
 STA 7+360.000 TO STA 7+375.243 RT
 STONE FILL TYPE II 7+360.000
 STA 7+080.000 TO STA 7+375.243 RT
 STA 7+120.000 TO STA 7+223.000 LT

GRUBBING MATERIAL 7+360.000
 STA 7+080.000 TO STA 7+375.243 RT
 EROSION MATTING (JUTE) 7+360.000
 STA 7+080.000 TO STA 7+375.243 RT
 CONSTRUCT DRIVE
 STA 7+405.000 LT PAVED

RELOCATE MAIL BOX, SINGLE SUPPORT
 STA 7+411.500 RT TO STA 7+398.780 LT
 REMOVING AND RESETTING FENCE
 STA 7+341.210 RT 4.9M BACK
 STONE FILL TYPE I
 STA 6+800.000 TO STA 6+850.000 LT

CONSTRUCT SPECIAL DITCH
 STA 7+170.000 TO STA 7+230.000 LT
 STA 7+270.000 TO STA 7+310.000 LT
 STA 7+370.000 TO STA 7+400.000 LT
 STA 7+410.000 TO STA 7+420.000 LT

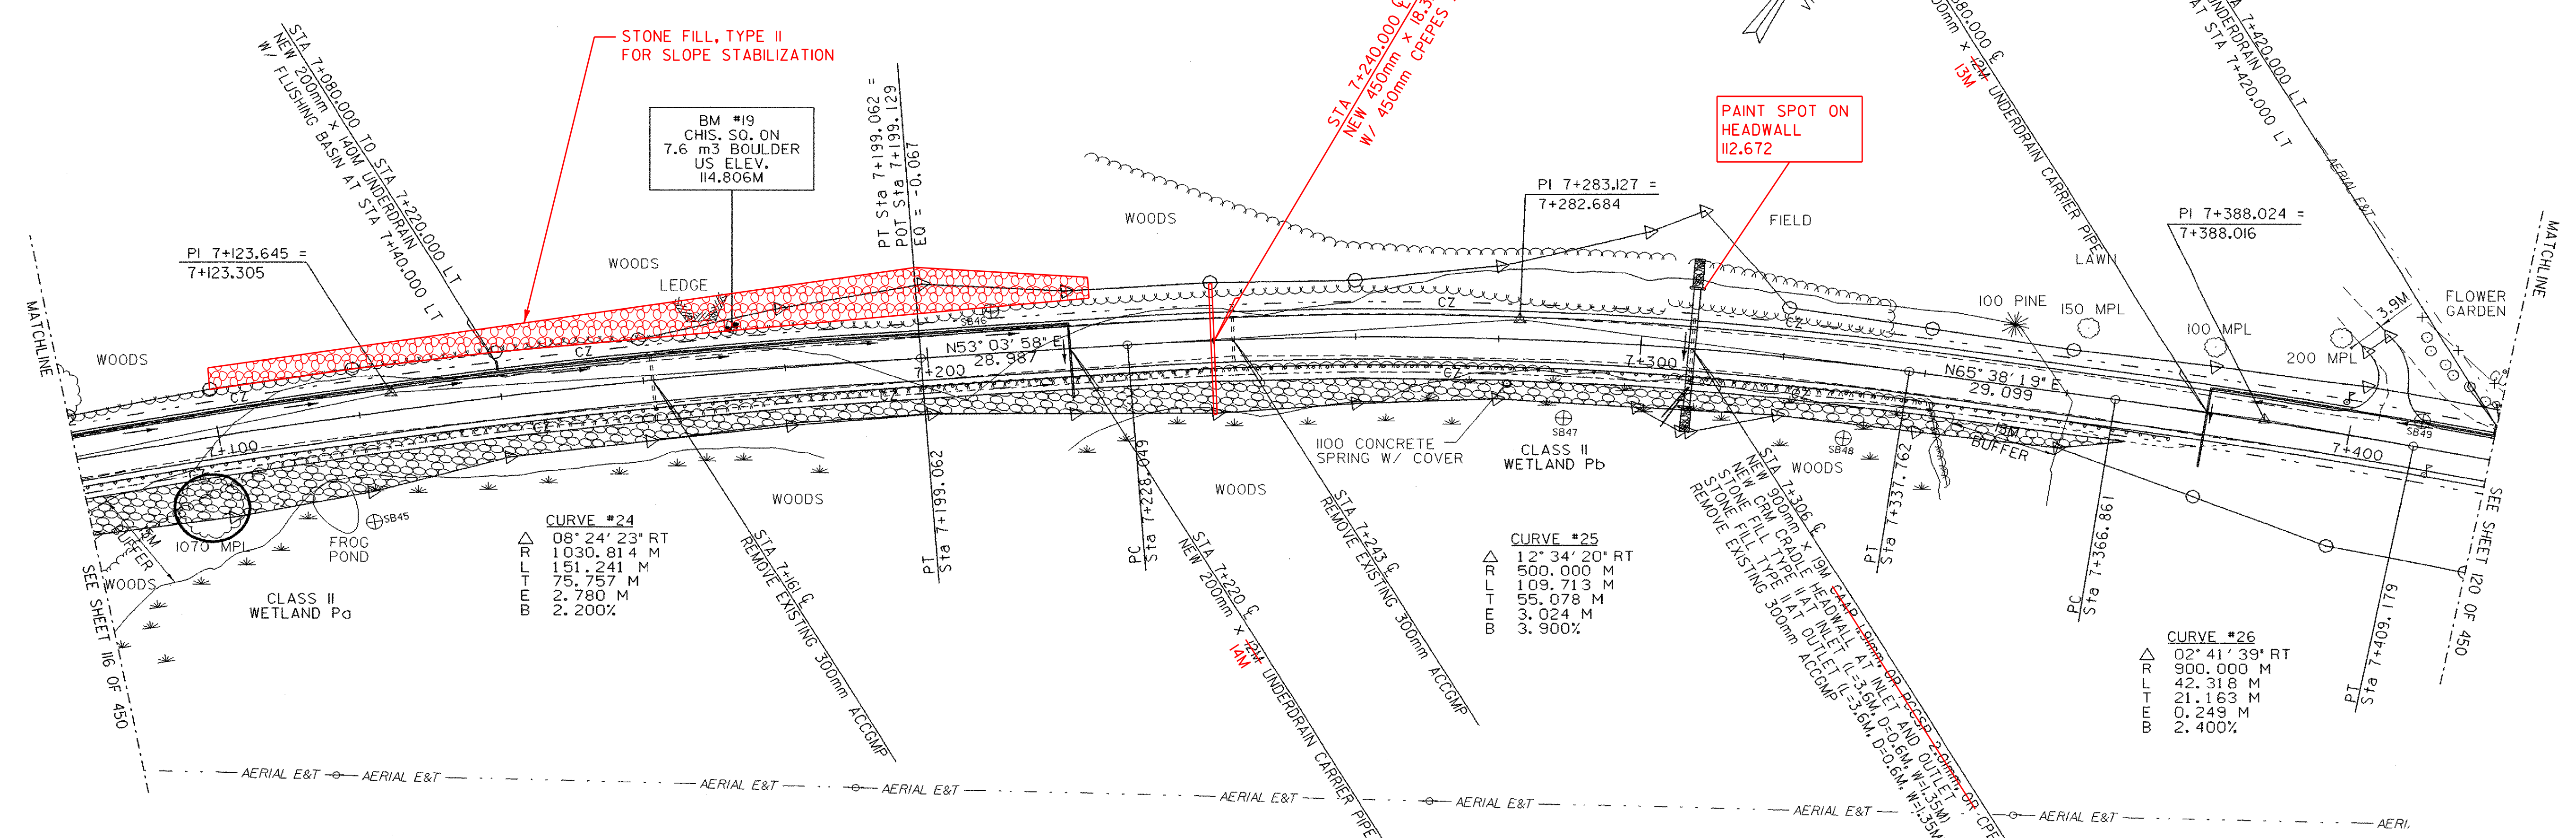

○ DENOTES TREE OR STUMP REMOVAL

NOTES:
 1. ALL SIDE ROAD RADII SHALL BE 11M UNLESS OTHERWISE NOTED. REFER TO STD B-12M
 2. ALL DRIVE RADII SHALL BE 6M UNLESS OTHERWISE NOTED. REFER TO STD B-71M

PROJECT NAME:	HIGHGATE - FRANKLIN
PROJECT NUMBER:	STP RS 030(I) SA
FILE NAME: ...85c060/design/dc060bdr.dgn	PLOT DATE: 09-MAY-2005
PROJECT LEADER: DELLASANTA	DRAWN BY: SQUAD B
DESIGNED BY: SQUAD B	CHECKED BY: SQUAD B
IPARM FILE NAME: dc060i19.i	SHEET 118 OF 450