


POE Sta 7+199.129 =  
 POB Sta 7+199.062  
 EO = -0.067

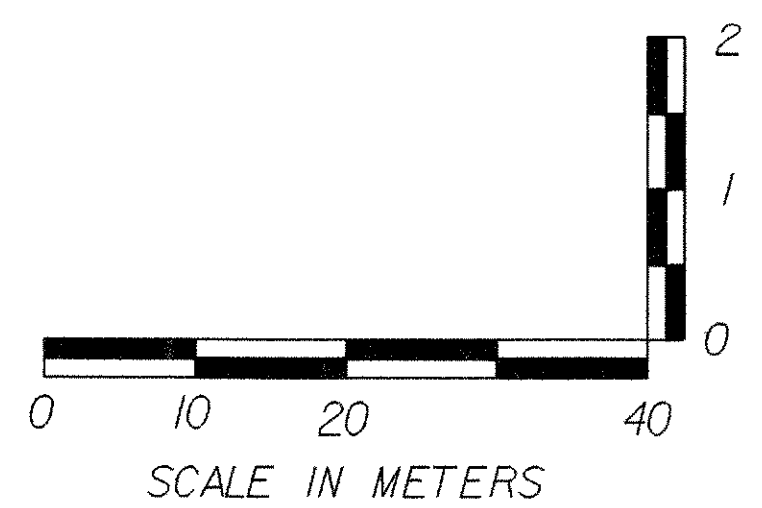

PROJECT NAME:	HIGHGATE - FRANKLIN	FILE NAME:	...85c060/design/dc060xst.dgn	PLOT DATE:	09-MAY-2005
PROJECT NUMBER:	STP RS 030(I) SA	PROJECT LEADER:	DELLASANTA	DRAWN BY:	SQUAD B
		DESIGNED BY:	SQUAD B	CHECKED BY:	SQUAD B
		IPARM FILE NAME:	dc060p19.i	SHEET #	19 OF 450