

CONSTRUCT DRIVE  
 STA 7+749.000 RT GRAVEL  
 STA 7+827.000 LT GRAVEL

MANUFACTURED TERMINAL SECTION (TANGENTIAL)  
 STA 7+763.682 TO STA 7+778.896 RT  
 STA 7+760.000 TO STA 7+775.200 RT  
 STEEL BEAM GUARDRAIL  
 STA 7+778.896 TO STA 8+040.000 RT  
 STA 7+775.200 TO STA 7+839.000 RT  
 STA 7+891.300 TO STA 8+040.000 RT  
 ANCHOR FOR STEEL BEAM GUARDRAIL  
 STA 7+835.200 RT  
 STA 7+895.100 RT

CONSTRUCT SPECIAL DITCH  
 STA 7+720.000 TO STA 7+747.000 LT  
 STA 7+751.000 TO STA 7+910.000 LT  
 STA 7+950.000 TO STA 8+030.000 LT  
 STA 7+950.000 TO STA 7+810.020 RT

GRUBBING MATERIAL SEE BELOW  
 STA 7+720.000 TO STA 7+732.786 RT  
 STA 8+810.020 TO STA 8+040.000 RT

EROSION MATTING (JUTE) SEE BELOW  
 STA 7+720.000 TO STA 7+732.786 RT  
 STA 8+810.020 TO STA 8+040.000 RT

REMOVING AND RESETTING FENCE  
 STA 7+815.017 RT 6M BACK


STONE FILL, TYPE II  
 STA 7+720.000 TO STA 7+732.786 RT  
 STA 8+810.020 TO STA 8+040.000 RT  
 STA 7+780.000 TO STA 7+827.000 RT  
 STA 7+900.000 TO STA 7+950.000 RT  
 STA 7+945.000 TO STA 8+017.000 LT  
 STA 8+810.000 TO STA 8+040.000 RT

RELOCATE MAIL BOX, SINGLE SUPPORT  
 STA 7+830.370 RT TO STA 7+832.088 LT

REMOVAL OF EXISTING FENCE  
 STA 8+013.200 TO STA 8+033.200 LT

GRUBBING MATERIAL  
 STA 7+780.000 TO STA 7+827.000 RT  
 STA 8+810.000 TO STA 8+040.000 RT  
 STA 7+900.000 TO STA 7+950.000 RT

EROSION MATTING (JUTE)  
 STA 7+780.000 TO STA 7+827.000 RT  
 STA 8+810.000 TO STA 8+040.000 RT  
 STA 7+900.000 TO STA 7+950.000 RT

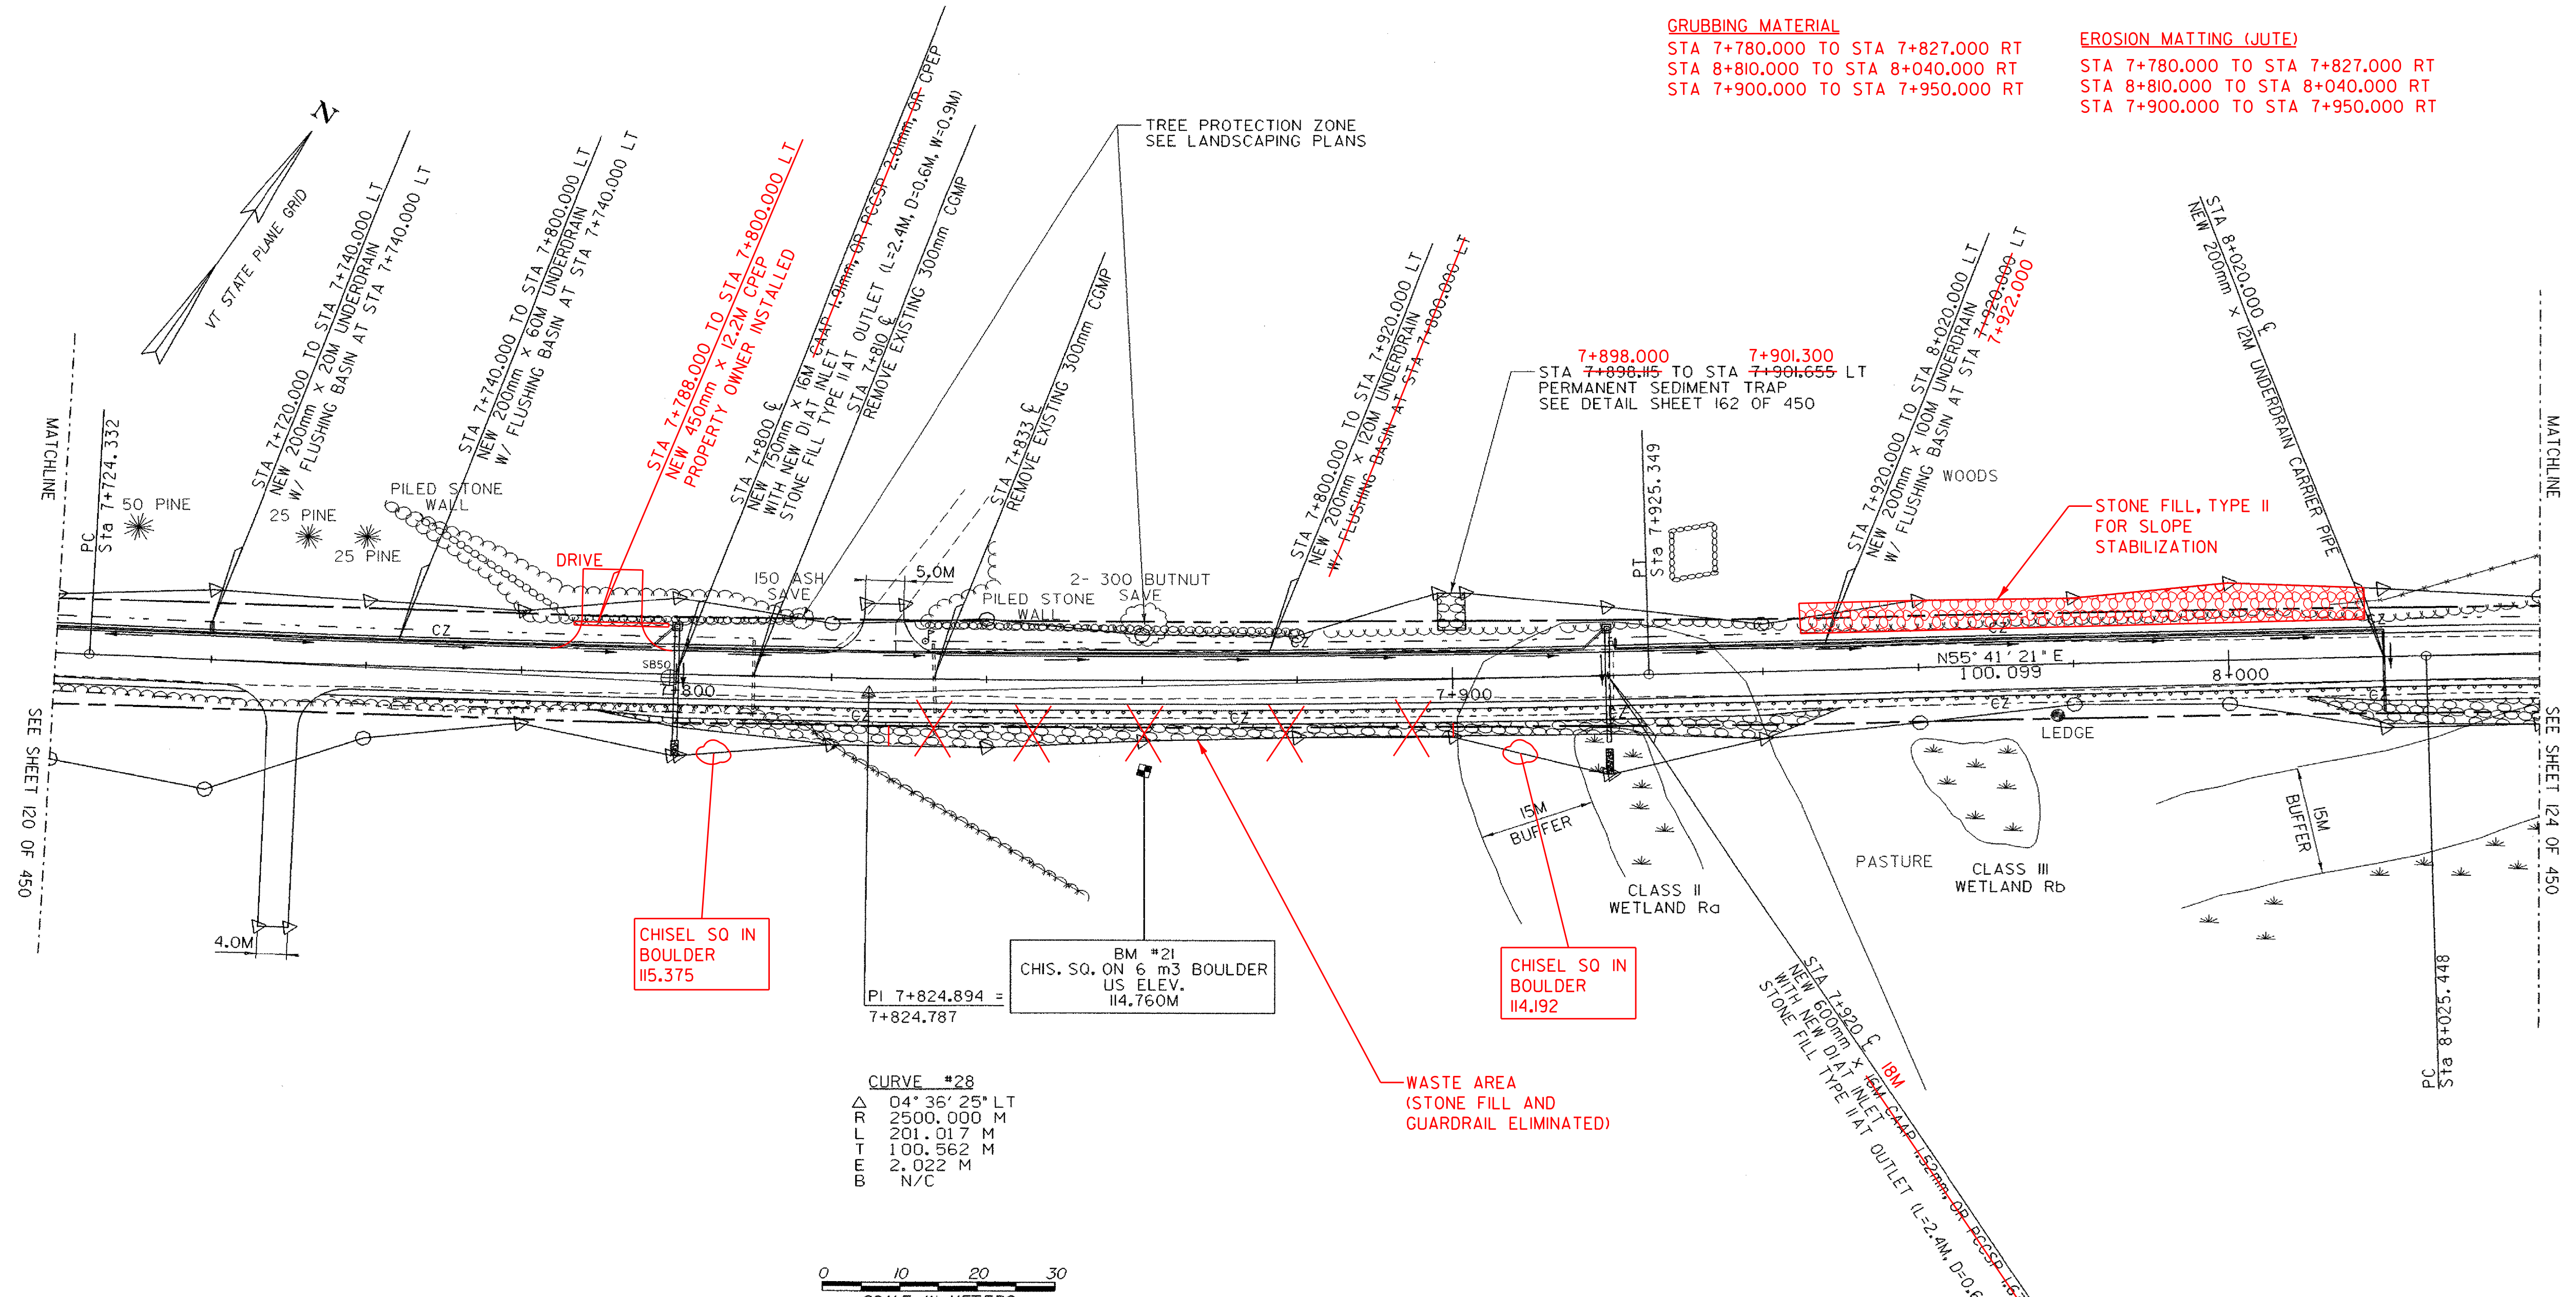

CHISEL SO IN BOULDER 115.375

BM #21  
 CHIS. SO. ON 6 m3 BOULDER  
 US ELEV. 114.760M

CHISEL SO IN BOULDER 114.192

CURVE #28  
 Δ 04° 36' 25" LT  
 R 2500.000 M  
 L 201.017 M  
 T 100.562 M  
 E 2.022 M  
 B N/C



○ DENOTES TREE OR STUMP REMOVAL

NOTES:  
 1. ALL SIDE ROAD RADII SHALL BE 11M UNLESS OTHERWISE NOTED. REFER TO STD B-12M  
 2. ALL DRIVE RADII SHALL BE 6M UNLESS OTHERWISE NOTED. REFER TO STD B-71M

|  |                        |
|--|------------------------|
| PROJECT NAME:                            | HIGHGATE - FRANKLIN    |
| PROJECT NUMBER:                          | STP RS 030(K) SA       |
| FILE NAME: ...85c060/design/dc060bdr.dgn | PLOT DATE: 09-MAY-2005 |
| PROJECT LEADER: DELLASANTA               | DRAWN BY: SQUAD B      |
| DESIGNED BY: SQUAD B                     | CHECKED BY: SQUAD B    |
| IPARM FILE NAME: dc060121I               | SHEET 122 OF 450       |