
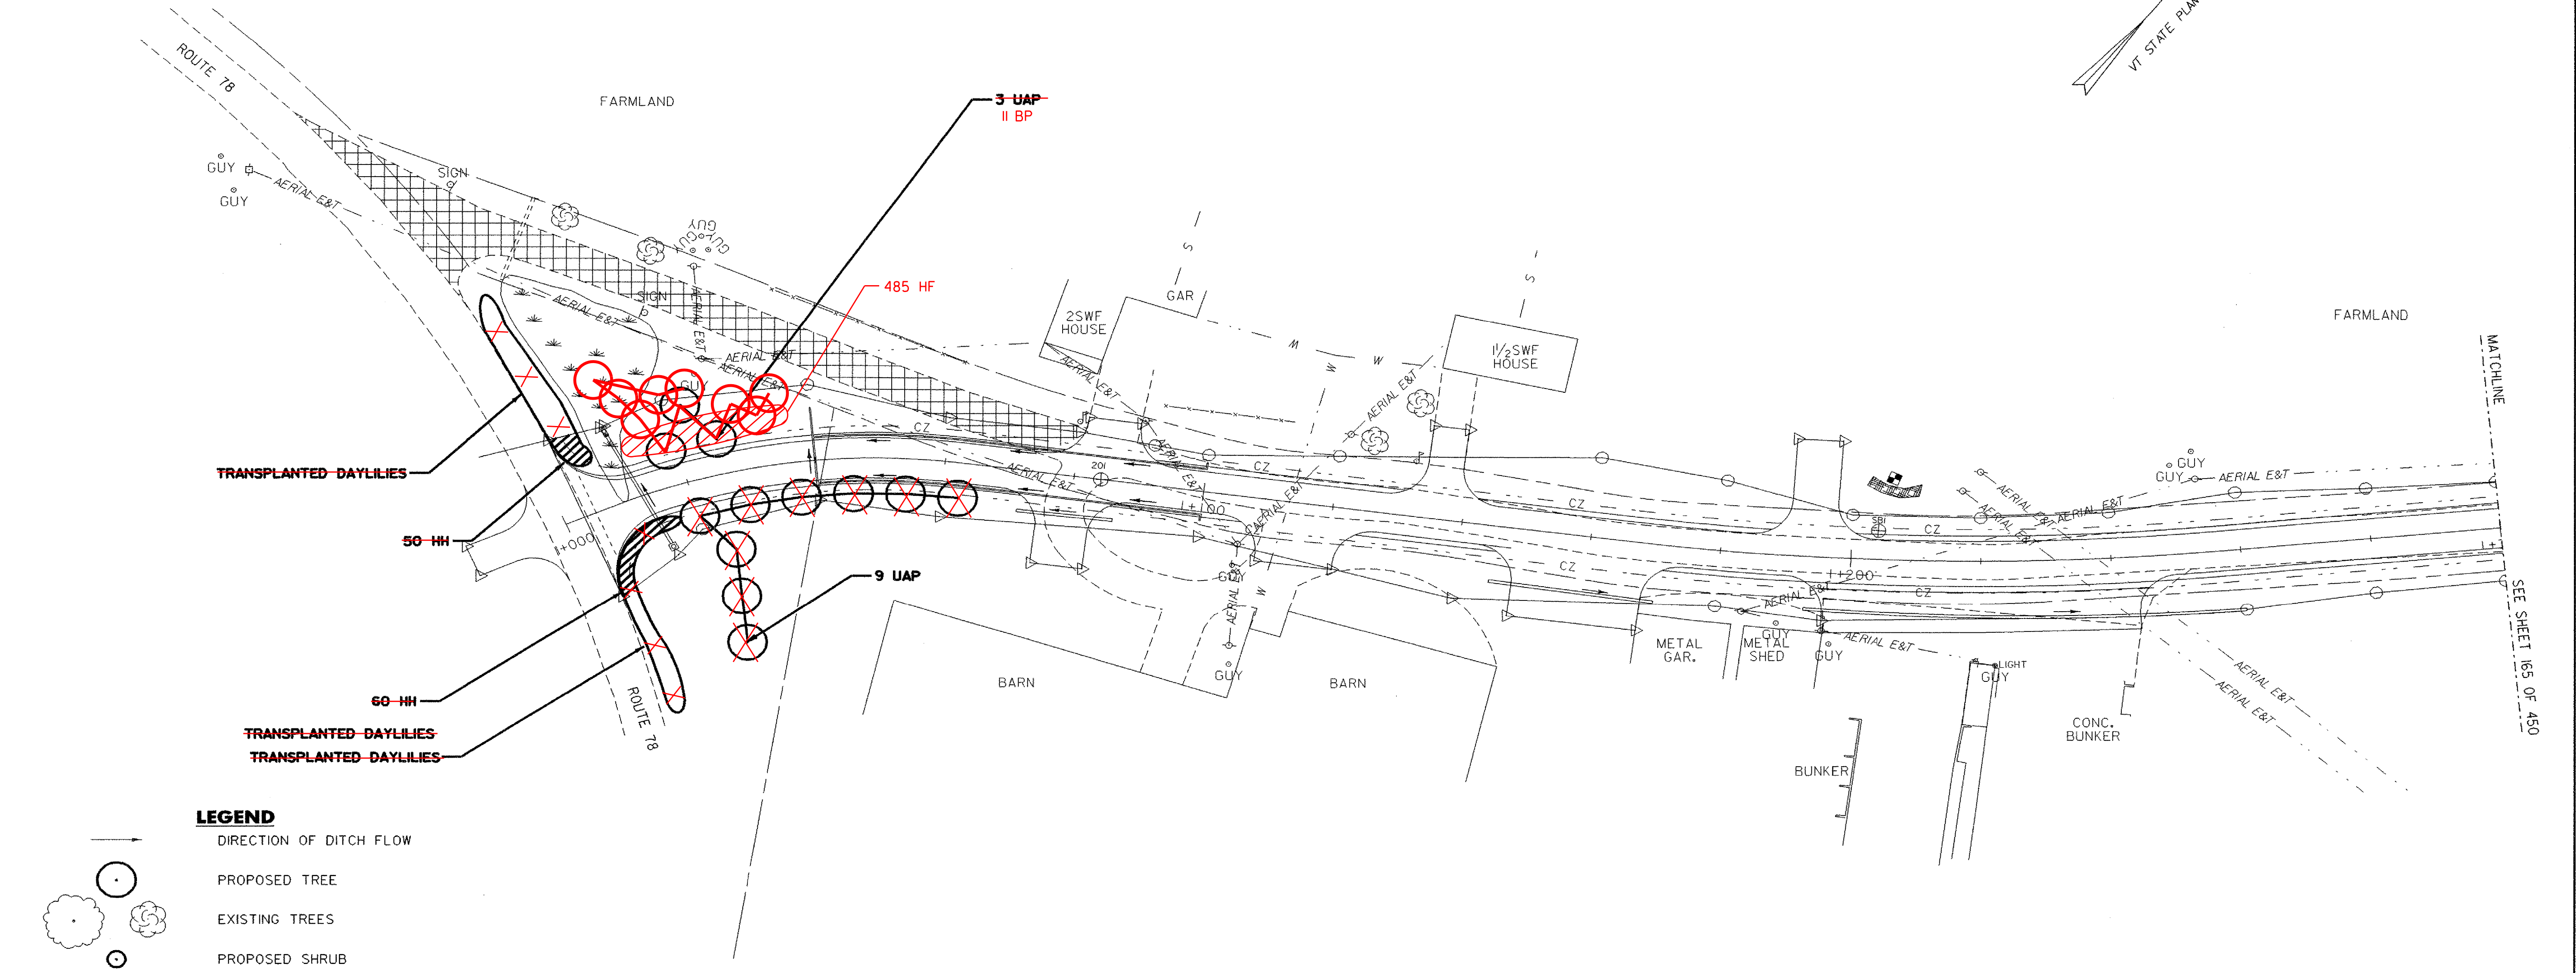


- KEY**
- ARN NORTHWOOD RED MAPLE
  - BP PAPER BIRCH (SINGLE STEM)
  - FP GREEN ASH
  - OV AMERICAN HOPHORNBEAM
  - OR NORTHERN RED OAK
  - UAP 'PRINCETON' AMERICAN ELM
  - AC SHADBLOW SERVICEBERRY (CLUMP FORM)
  - VP BLACKHAW VIBURNUM
  - SV LILAC
  - HH HYPERION DAYLILY
  - LP LUPINE
  - HF COMMON ORANGE DAYLILY


- DECIDUOUS TREES**
- STA 1+018 LT (1 UAP) BP
  - STA 1+022 LT (1 UAP) BP
  - STA 1+026 LT (1 UAP) BP
  - STA 1+020 RT (1 UAP)
  - STA 1+021 RT (1 UAP)
  - STA 1+023 RT (1 UAP)
  - STA 1+025 RT (1 UAP)
  - STA 1+029 RT (1 UAP)
  - STA 1+037 RT (1 UAP)
  - STA 1+046 RT (1 UAP)
  - STA 1+051 RT (1 UAP)
  - STA 1+063 RT (1 UAP)
  - STA 1+012 LT (1 BP)
  - STA 1+014 LT (1 BP)
  - STA 1+016 LT (1 BP)
  - STA 1+020 LT (1 BP)
  - STA 1+024 LT (1 BP)
  - STA 1+029 LT (1 BP)
  - STA 1+032 LT (1 BP)
  - STA 1+035 LT (1 BP)

- GROUND COVER AND VINES**
- STA 1+007 LT (50 HH)
  - STA 1+013 RT (60 HH)
  - STA 1+014 TO STA 1+037 LT (485 HF)

**NEW LOCATION FOR TRANSPLANTED MATERIAL ALONG ROUTE 78**

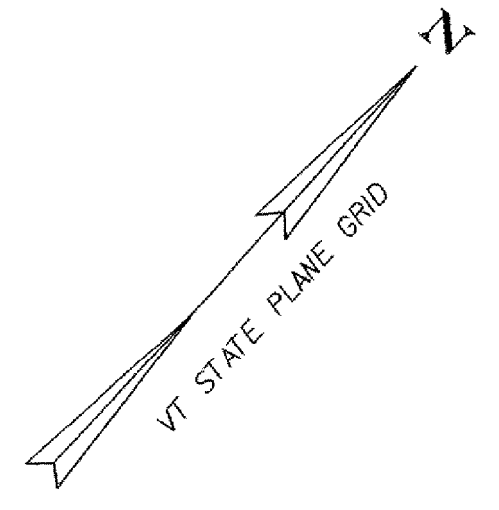

- LEGEND**
- DIRECTION OF DITCH FLOW
  - PROPOSED TREE
  - EXISTING TREES
  - PROPOSED SHRUB
  - PROPOSED GROUND COVER
  - NEW LOCATION FOR TRANSPLANTED MATERIAL
  - EXISTING PLANT MATERIAL TO BE TRANSPLANTED
  - TREE PROTECTION ZONE WITH FENCING
  - LIMIT OF CUT
  - LIMIT OF FILL

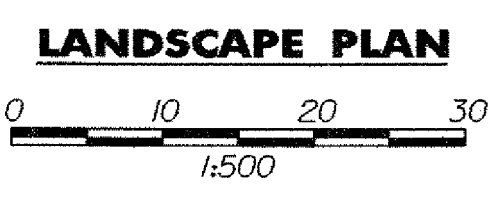

PROJECT NAME: HIGHGATE - FRANKLIN  
 PROJECT NUMBER: STP RS 030(I) SA  
 FILE NAME: 85c060/design/dc060landbdr.dgn PLOT DATE: 09-MAY-2005  
 PROJECT LEADER: DELLASANTA DRAWN BY: SQUAD B  
 DESIGNED BY: SQUAD B CHECKED BY: SQUAD B  
 IPARM FILE NAME: dc060land01.I SHEET 164 OF 450