


SNOW FENCE
 STA 4+257 TO STA 4+265 LT
 STA 4+278 TO STA 4+298 LT

DECIDUOUS TREES
 STA 4+340 LT (2 OR)


TREE PROTECTION ZONE:
 STA 4+257 TO STA 4+265 LT
 TO INCLUDE:
 STA 4+259 LT, 400 MAPLE
 SEE NOTES ON SHEET 190 OF 450.
 TREE PROTECTION DETAIL ON SHEET 192 OF 450,
 AND SPECIAL PROVISIONS.

TREE PROTECTION ZONE:
 STA 4+278 TO STA 4+298 LT
 TO INCLUDE:
 STA 4+280 LT, 450 MAPLE
 STA 4+291 LT, 100 MAPLE
 SEE NOTES ON SHEET 190 OF 450.
 TREE PROTECTION DETAIL ON SHEET 192 OF 450,
 AND SPECIAL PROVISIONS.

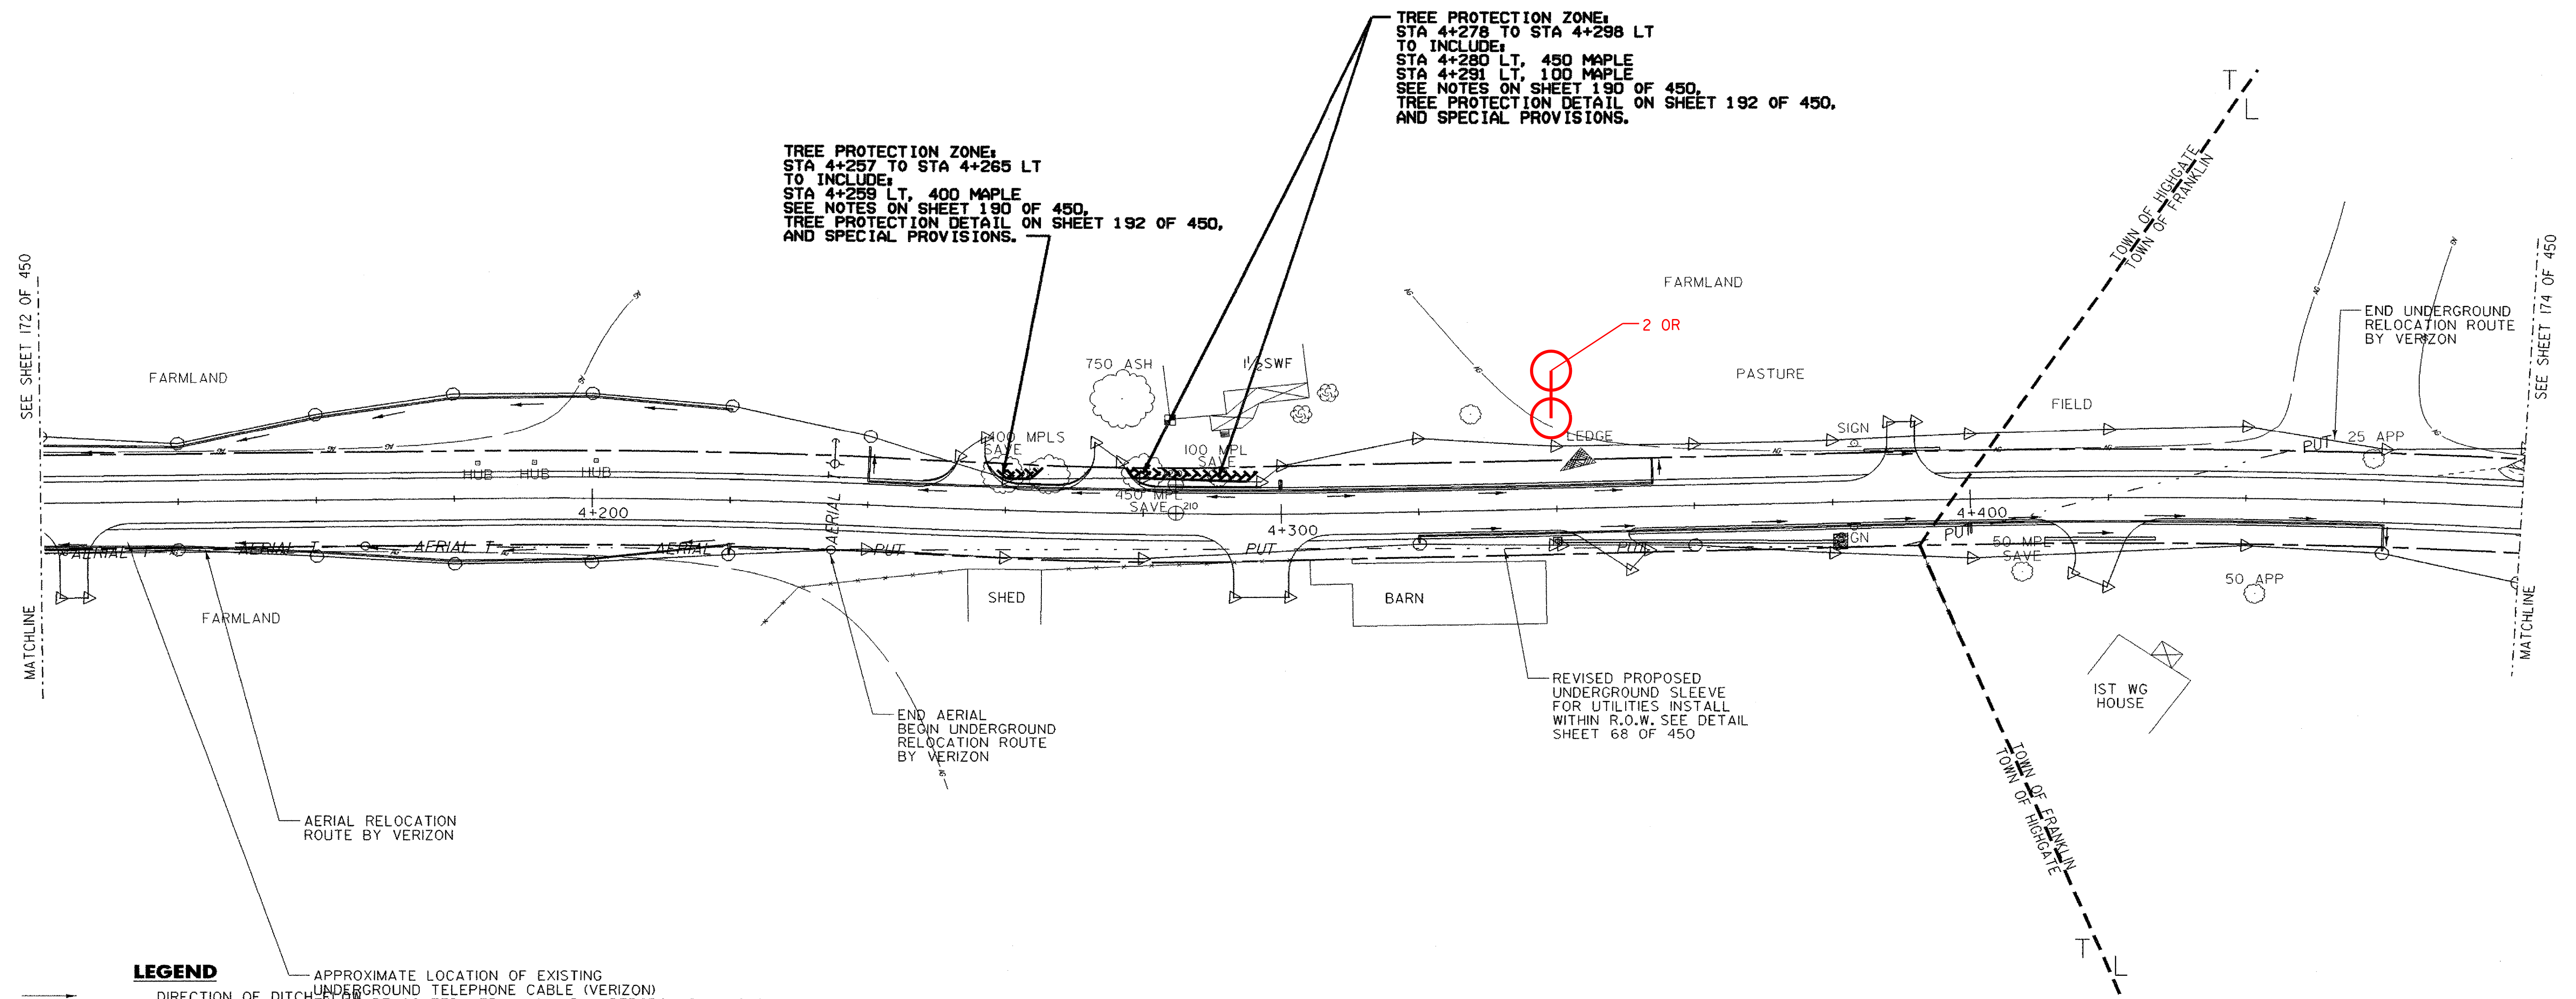

LEGEND

- APPROXIMATE LOCATION OF EXISTING UNDERGROUND TELEPHONE CABLE (VERIZON) TO BE RELOCATED AERIALLY AND UNDERGROUND AS SHOWN
- PROPOSED TREE
- EXISTING TREES
- PROPOSED SHRUB
- PROPOSED GROUND COVER
- NEW LOCATION FOR TRANSPLANTED MATERIAL
- EXISTING PLANT MATERIAL TO BE TRANSPLANTED
- TREE PROTECTION ZONE WITH FENCING
- LIMIT OF CUT
- LIMIT OF FILL

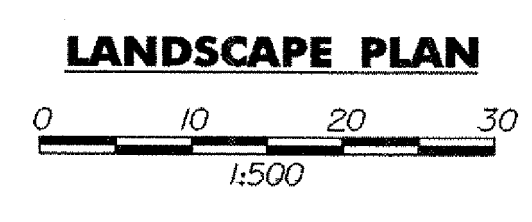

PROJECT NAME: HIGHGATE - FRANKLIN	
PROJECT NUMBER: STP RS 030(I) SA	
FILE NAME: 85c060/design/dc060landbdr.dgn	PLOT DATE: 09-MAY-2005
PROJECT LEADER: DELLASANTA	DRAWN BY: SQUAD B
DESIGNED BY: SQUAD B	CHECKED BY: SQUAD B
IPARM FILE NAME: dc060land10.1	SHEET 173 OF 450