


LEGEND

- DIRECTION OF DITCH FLOW
- PROPOSED TREE
- ☼ EXISTING TREES
- PROPOSED SHRUB
- ▨ PROPOSED GROUND COVER
- ▭ NEW LOCATION FOR TRANSPLANTED MATERIAL
- - - EXISTING PLANT MATERIAL TO BE TRANSPLANTED
- ▩ TREE PROTECTION ZONE WITH FENCING
- ▶▶▶ LIMIT OF CUT
- LIMIT OF FILL

LANDSCAPE PLAN

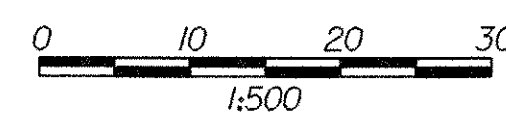

PROJECT NAME:	HIGHGATE - FRANKLIN
PROJECT NUMBER:	STP RS 030(I) SA
FILE NAME:	85c060/design/dc060landbdr.dgn
PROJECT LEADER:	DELLASANTA
DESIGNED BY:	SQUAD B
IPARM FILE NAME:	dc060landll.i
PLLOT DATE:	09-MAY-2005
DRAWN BY:	SQUAD B
CHECKED BY:	SQUAD B
SHEET	174 OF 450