

DURABLE 100mm WHITE LINE
 STA I+003.080 TO STA I+300.000 LT (EDGE LINE)
 STA I+003.080 TO STA I+300.000 RT (EDGE LINE)
 ROUTE 78 - 40M (EDGE LINE)

DURABLE 100mm YELLOW LINE
 STA I+006.080 TO STA I+300.000 LT (CENTER LINE)
 STA I+006.080 TO STA I+300.000 RT (CENTER LINE)
 ROUTE 78 - 40M (CENTER LINE)

DURABLE LETTER OR SYMBOL
 STA I+009.150 LT "STOP"

DURABLE 600mm STOP BAR
 STA I+006.410 LT (6M)



TEMPORARY 100mm WHITE LINE
 STA I+003.080 TO STA I+300.000 LT (EDGE LINE)
 STA I+003.080 TO STA I+300.000 RT (EDGE LINE)
 ROUTE 78 - 40M (EDGE LINE)

TEMPORARY 100mm YELLOW LINE
 STA I+006.080 TO STA I+300.000 LT (CENTER LINE)
 STA I+006.080 TO STA I+300.000 RT (CENTER LINE)
 ROUTE 78 - 40M (CENTER LINE)

TEMPORARY LETTER OR SYMBOL
 STA I+009.150 LT "STOP"

TEMPORARY 600mm STOP BAR
 STA I+006.410 LT (6M)

REMOVAL OF EXISTING PAVEMENT MARKINGS
 23M ON ROUTE 78 (CENTER LINE)
 23M ON ROUTE 78 RT (EDGE LINE)

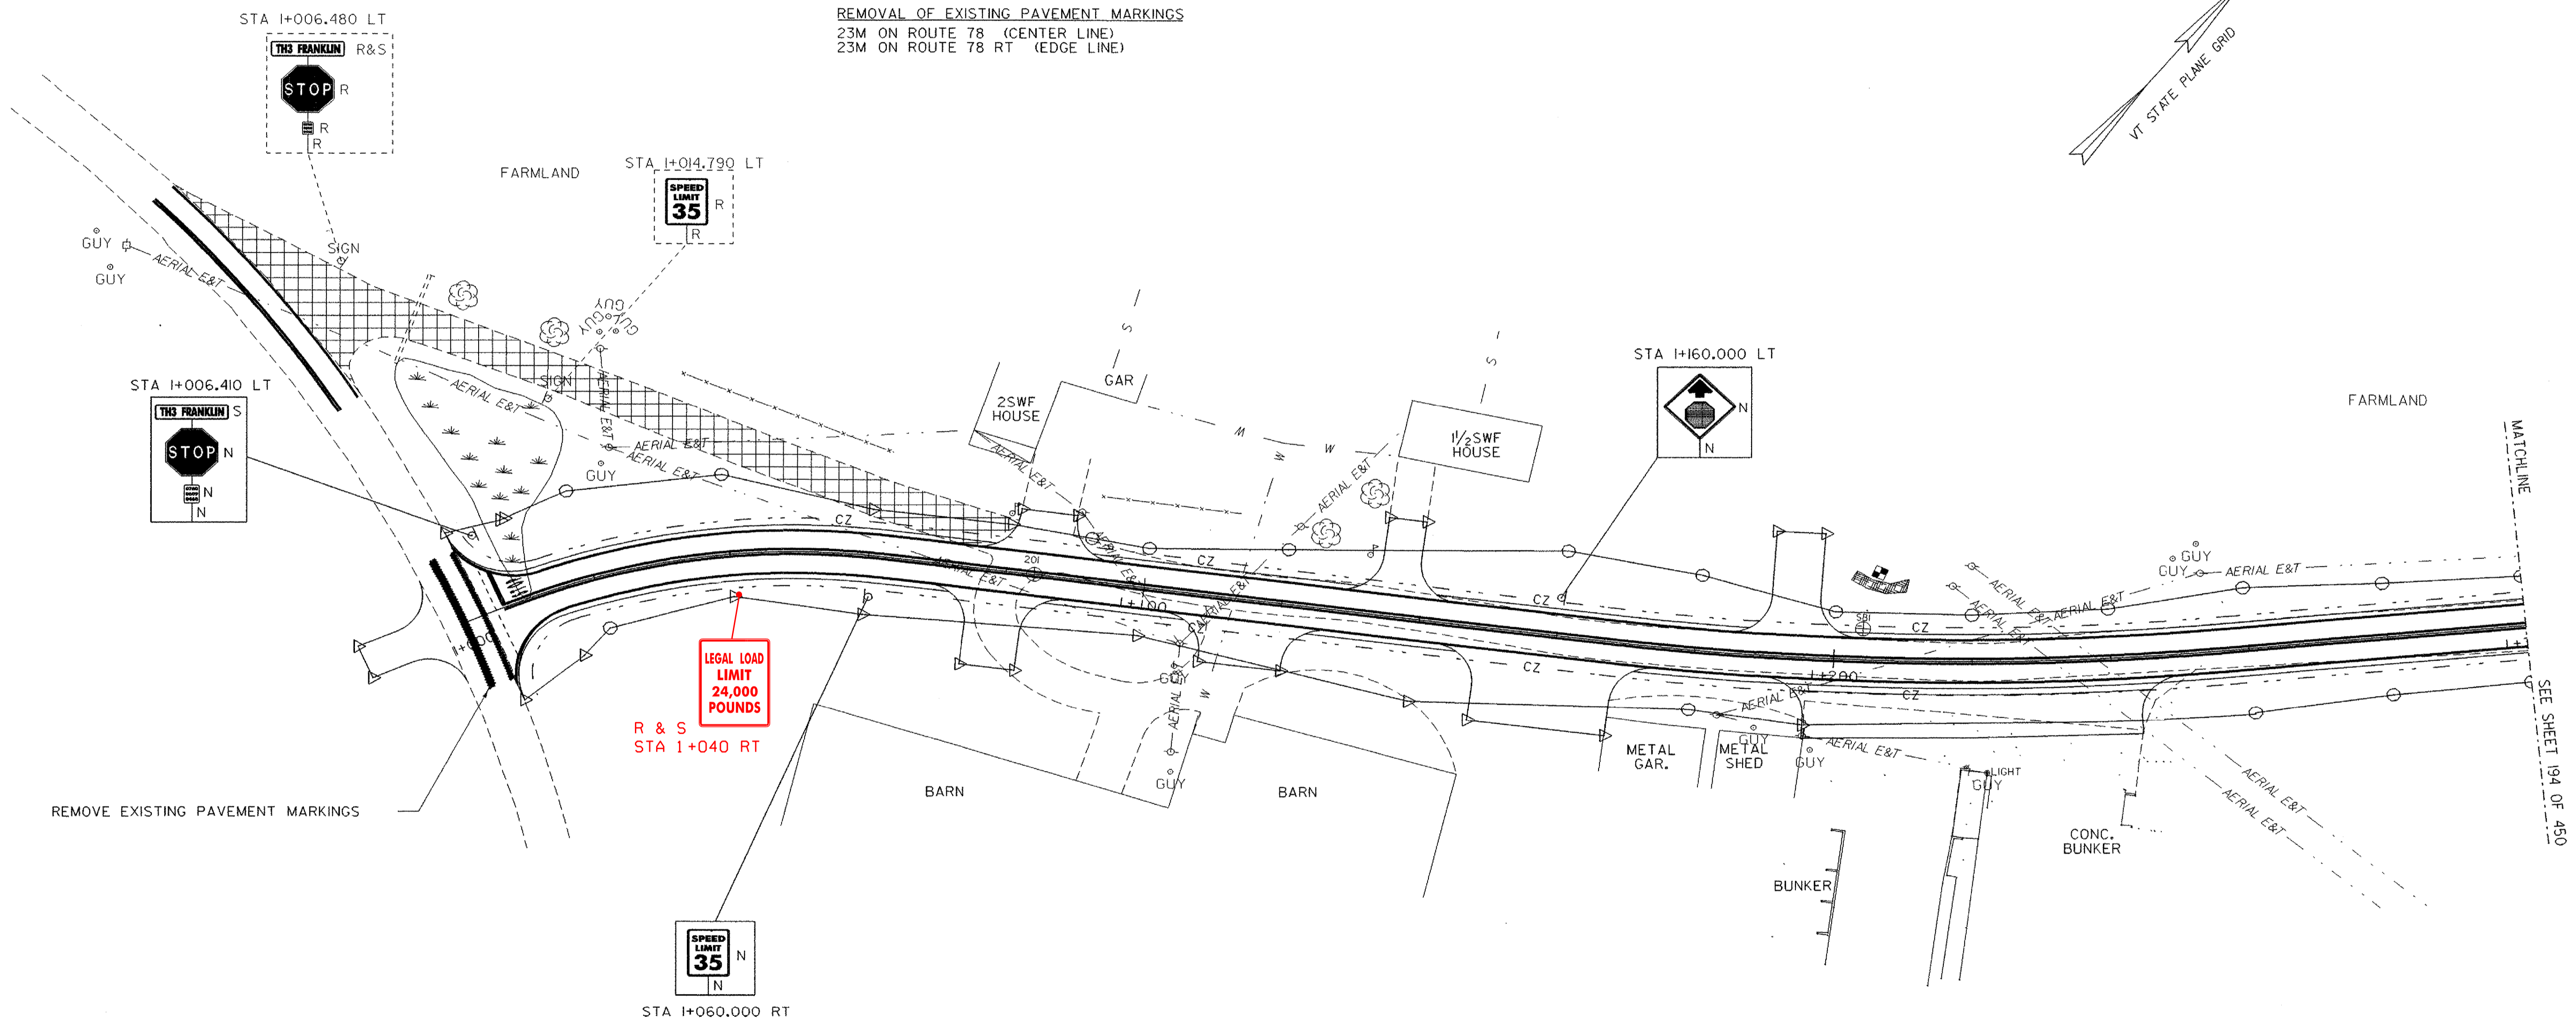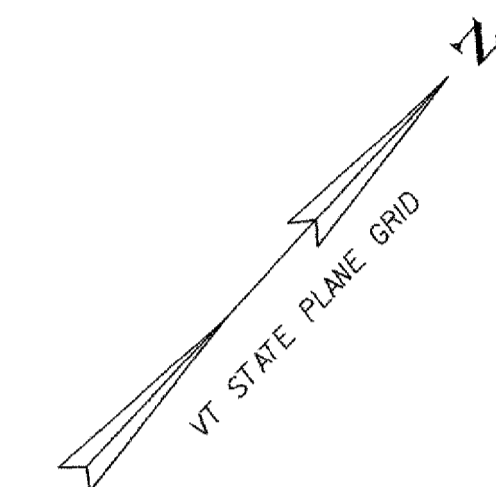

SIGN LEGEND
 R = REMOVE
 S = SALVAGE
 N = NEW
 RET = RETAIN
 T&T = THINNING & TRIMMING
 B-B = BACK TO BACK

TRAFFIC SIGNS & PAVEMENT MARKINGS SHEET



PROJECT NAME: HIGHGATE - FRANKLIN	
PROJECT NUMBER: STP RS 0301(I) SA	
FILE NAME: ...85c060/design/dc060tts.dgn	PLOT DATE: 09-MAY-2005
PROJECT LEADER: DELLASANTA	DRAWN BY: SQUAD B
DESIGNED BY: SQUAD B	CHECKED BY: SQUAD B
IPARM FILE NAME: dc060+sl.t	SHEET 193 OF 450