


DURABLE 100mm WHITE LINE
 STA 2+020.000 TO STA 2+380.000 LT (EDGE LINE)
 STA 2+020.000 TO STA 2+380.000 RT (EDGE LINE)

DURABLE 100mm YELLOW LINE
 STA 2+020.000 TO STA 2+380.000 LT (CENTER LINE)
 STA 2+020.000 TO STA 2+380.000 RT (CENTER LINE)

TEMPORARY 100mm WHITE LINE
 STA 2+020.000 TO STA 2+380.000 LT (EDGE LINE)
 STA 2+020.000 TO STA 2+380.000 RT (EDGE LINE)

TEMPORARY 100mm YELLOW LINE
 STA 2+020.000 TO STA 2+380.000 LT (CENTER LINE)
 STA 2+020.000 TO STA 2+380.000 RT (CENTER LINE)

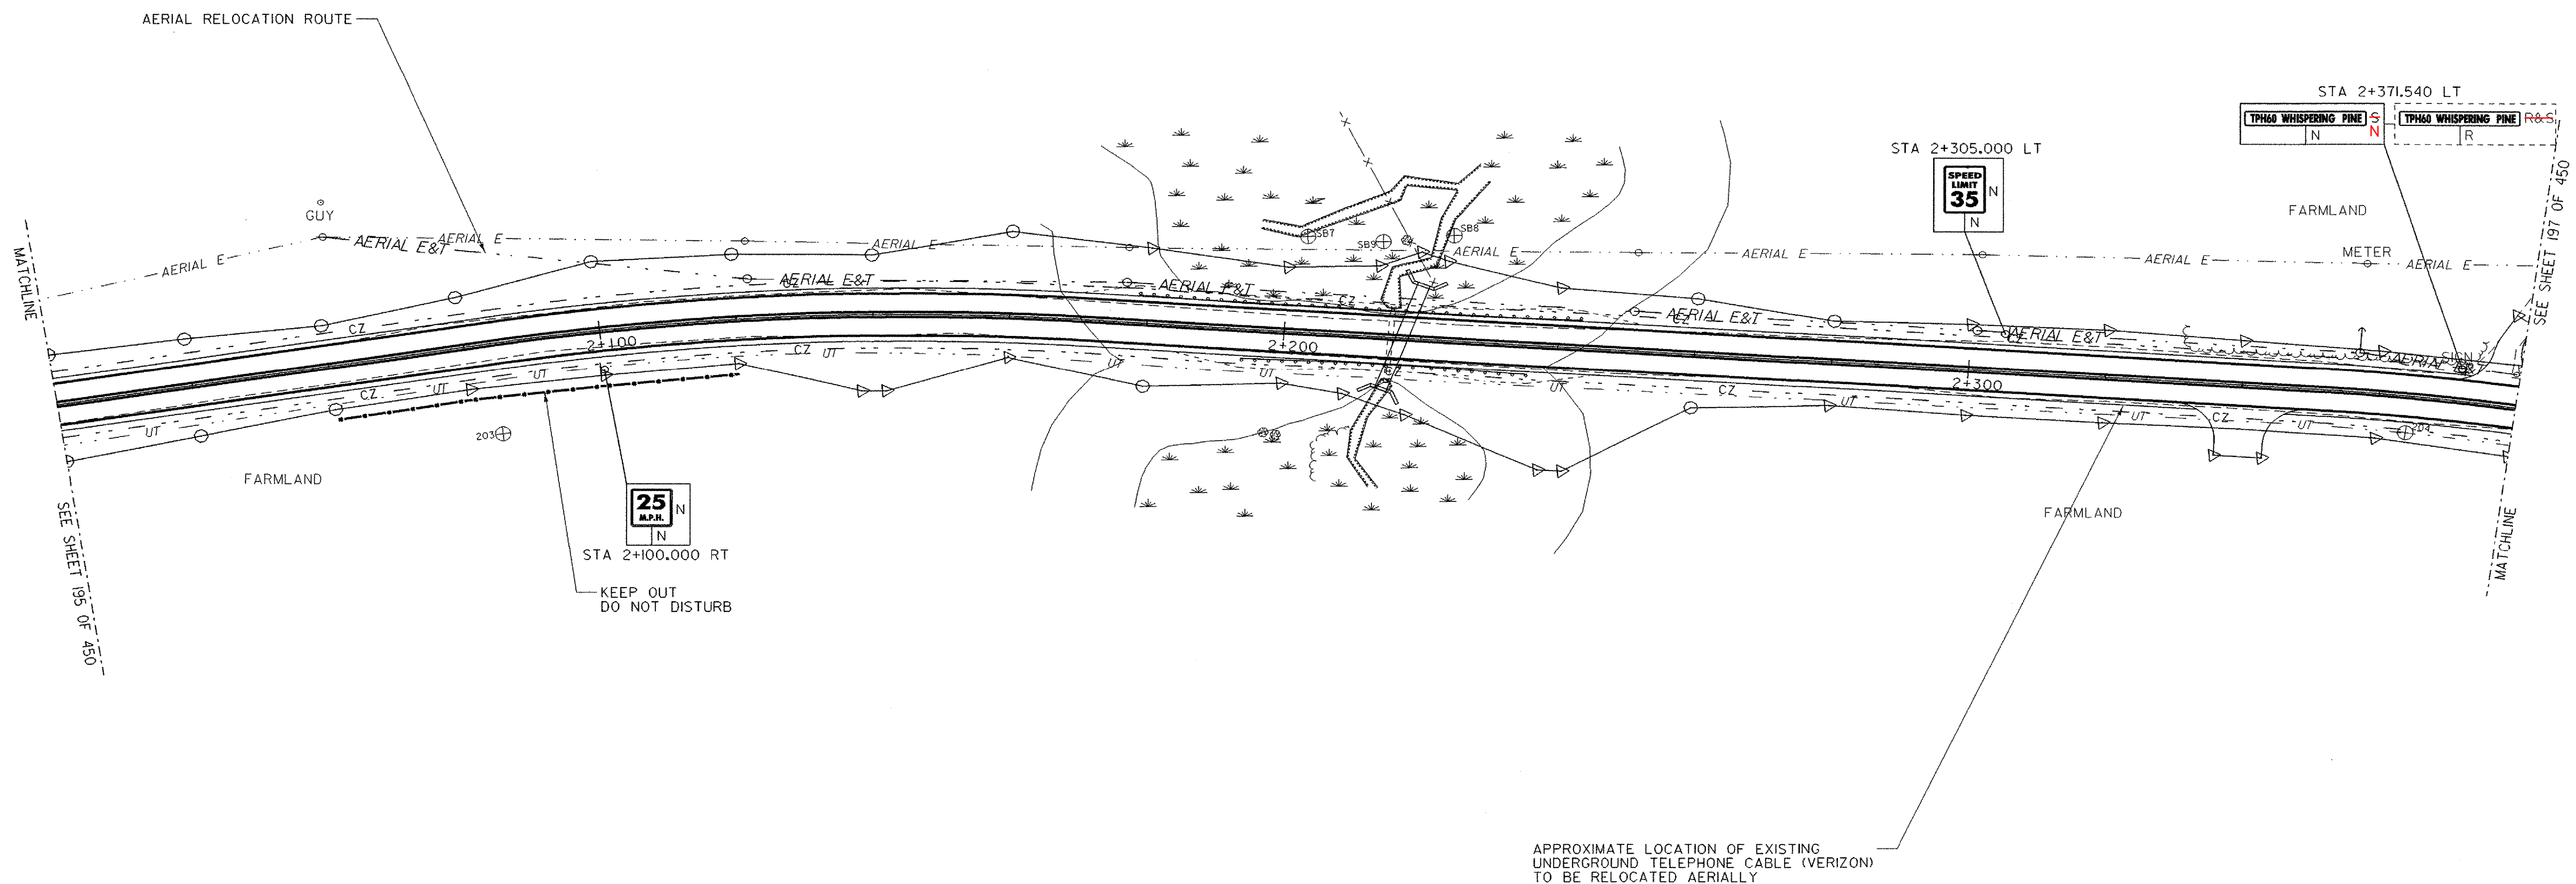

APPROXIMATE LOCATION OF EXISTING UNDERGROUND TELEPHONE CABLE (VERIZON) TO BE RELOCATED AERIALLY

SIGN LEGEND
 R = REMOVE
 S = SALVAGE
 N = NEW
 RET = RETAIN
 T&T = THINNING & TRIMMING
 B-B = BACK TO BACK

TRAFFIC SIGNS & PAVEMENT MARKINGS SHEET



PROJECT NAME: HIGHGATE - FRANKLIN	
PROJECT NUMBER: STP RS 0301(I) SA	
FILE NAME: ...85c060/design/dc060+ts.dgn	PLOT DATE: 09-MAY-2005
PROJECT LEADER: DELLASANTA	DRAWN BY: SQUAD B
DESIGNED BY: SQUAD B	CHECKED BY: SQUAD B
IPARM FILE NAME: dc060+ts4.1	SHEET 196 OF 450