
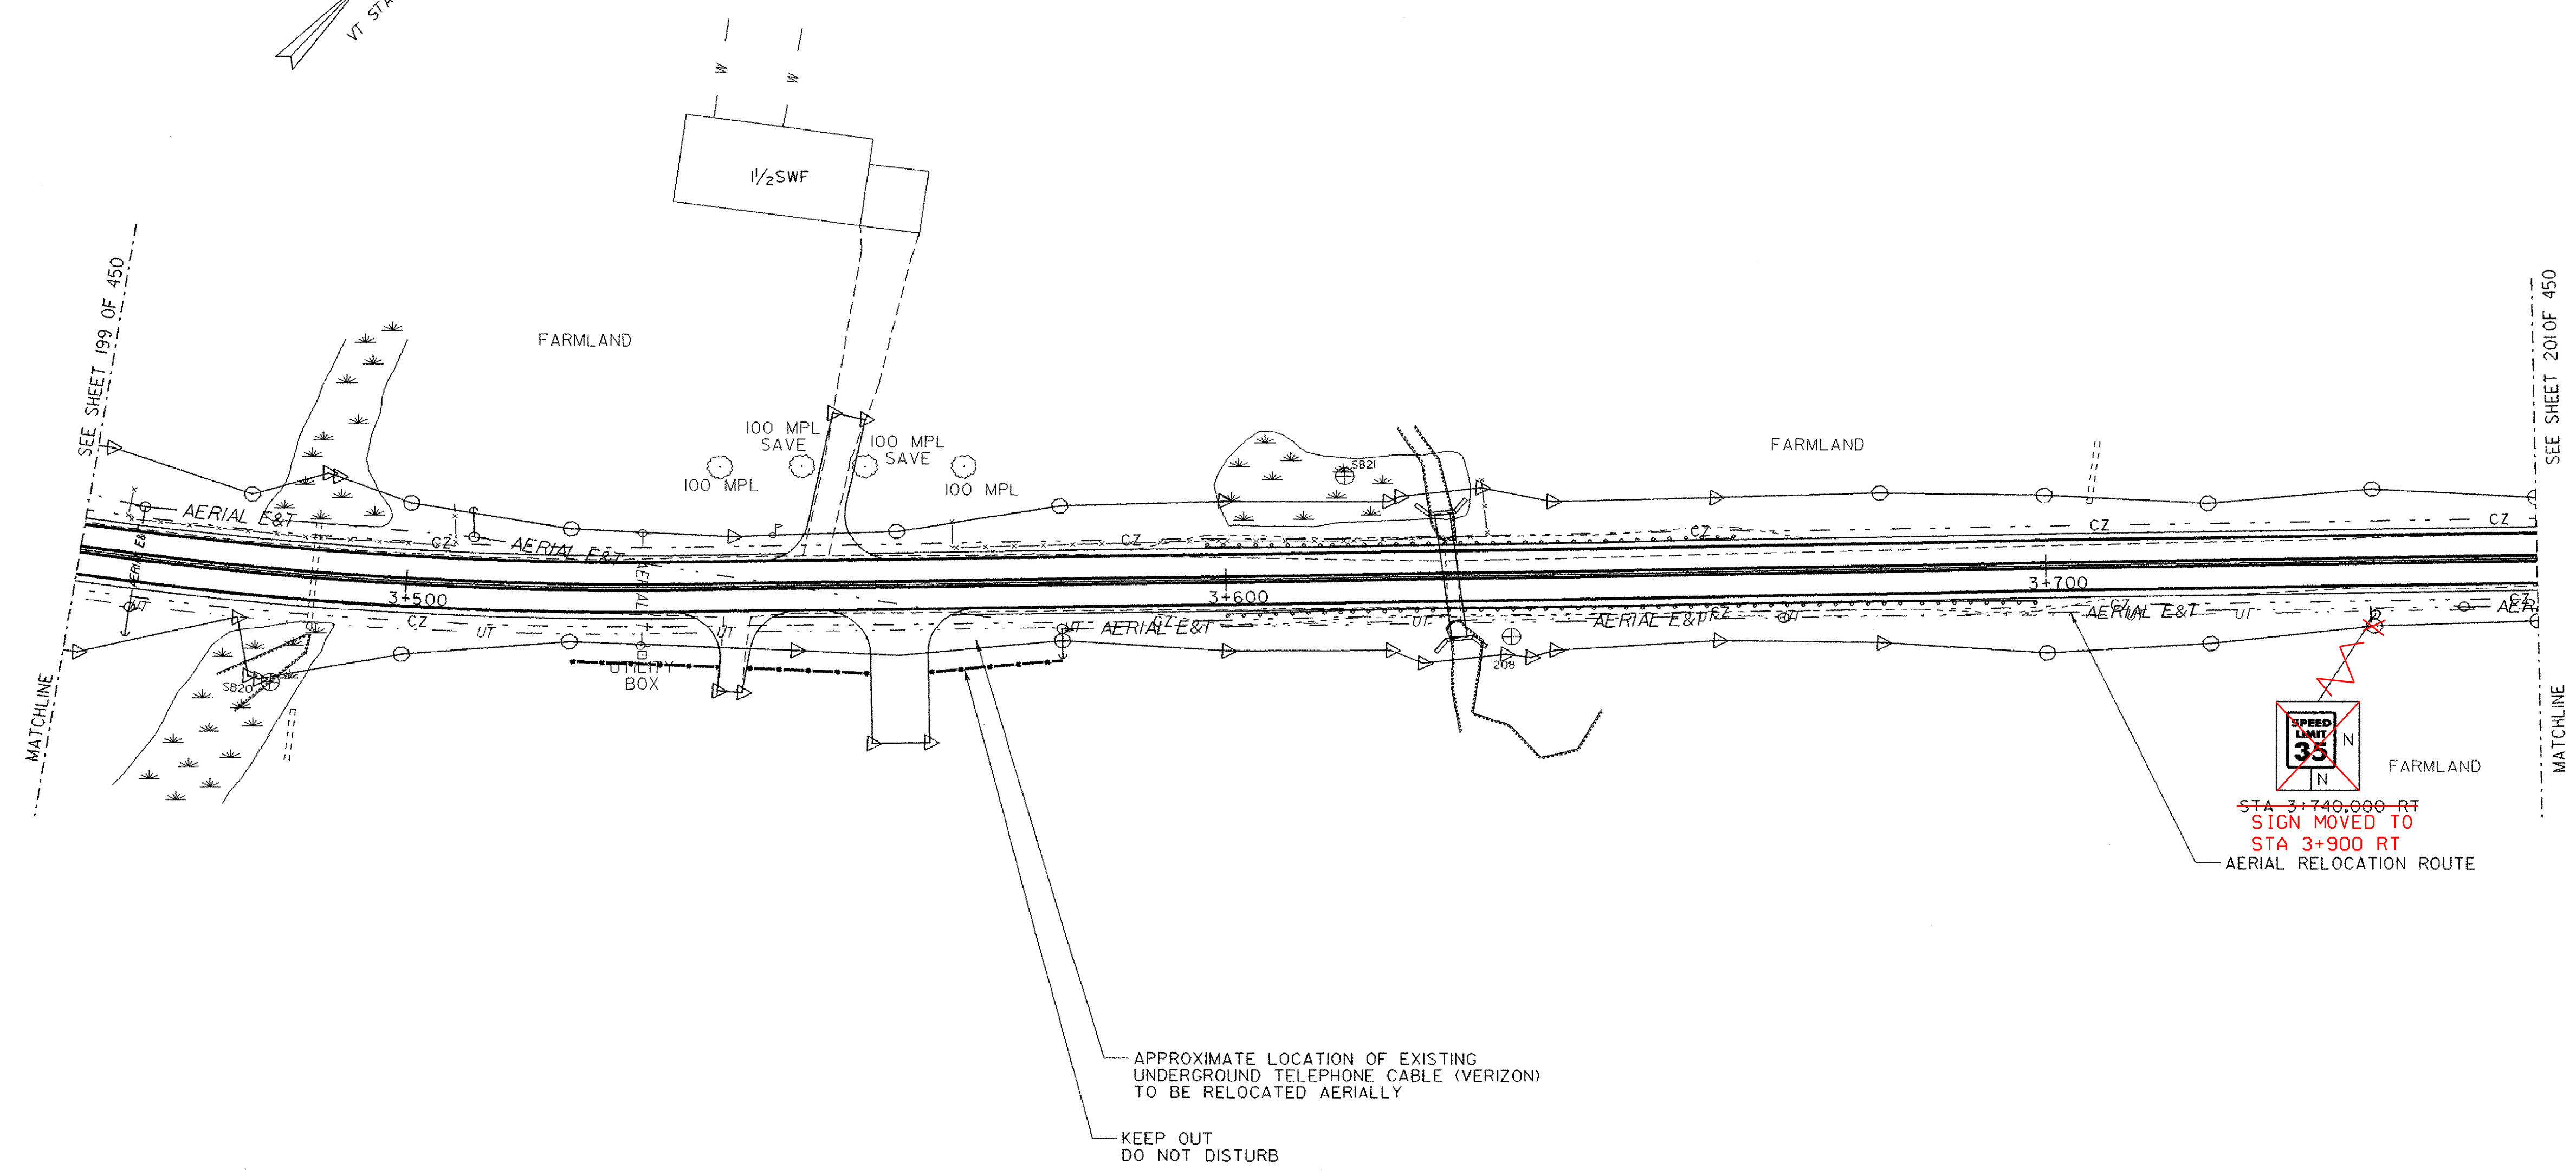


DURABLE 100mm WHITE LINE
 STA 3+460.000 TO STA 3+760.00 LT (EDGE LINE)
 STA 3+460.000 TO STA 3+760.00 RT (EDGE LINE)

DURABLE 100mm YELLOW LINE
 STA 3+460.000 TO STA 3+760.00 LT (CENTER LINE)
 STA 3+460.000 TO STA 3+760.00 RT (CENTER LINE)

TEMPORARY 100mm WHITE LINE
 STA 3+460.000 TO STA 3+760.00 LT (EDGE LINE)
 STA 3+460.000 TO STA 3+760.00 RT (EDGE LINE)

TEMPORARY 100mm YELLOW LINE
 STA 3+460.000 TO STA 3+760.00 LT (CENTER LINE)
 STA 3+460.000 TO STA 3+760.00 RT (CENTER LINE)

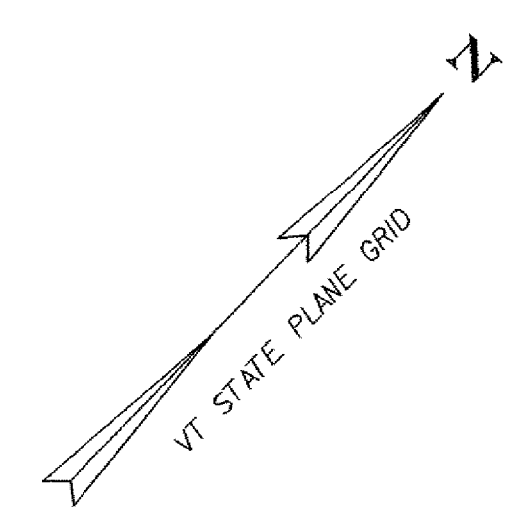

APPROXIMATE LOCATION OF EXISTING UNDERGROUND TELEPHONE CABLE (VERIZON) TO BE RELOCATED AERIALLY

KEEP OUT DO NOT DISTURB

- SIGN LEGEND**
- R = REMOVE
 - S = SALVAGE
 - N = NEW
 - RET = RETAIN
 - T&T = THINNING & TRIMMING
 - B-B = BACK TO BACK

TRAFFIC SIGNS & PAVEMENT MARKINGS SHEET



PROJECT NAME:	HIGHGATE - FRANKLIN
PROJECT NUMBER:	STP RS 0301(I) SA
FILE NAME: ...85c060/design/dc060+ts.dgn	PLOT DATE: 09-MAY-2005
PROJECT LEADER: DELLASANTA	DRAWN BY: SQUAD B
DESIGNED BY: SQUAD B	CHECKED BY: SQUAD B
IPARM FILE NAME: dc060+ts.l	SHEET 200 OF 450