

**DURABLE 100mm WHITE LINE**  
 STA 3+760.000 TO STA 3+821.200 LT (EDGE LINE)  
 STA 3+760.000 TO STA 4+120.000 RT (EDGE LINE)  
 STA 3+851.310 TO STA 4+120.000 LT (EDGE LINE)  
 STA 20+000.000 TO STA 20+030.000 LT (TH #32 EDGE LINE)  
 STA 20+000.000 TO STA 20+030.000 RT (TH #32 EDGE LINE)

**DURABLE 100mm YELLOW LINE**  
 STA 3+760.000 TO STA 3+827.660 LT (CENTER LINE)  
 STA 3+760.000 TO STA 3+827.660 RT (CENTER LINE)  
 STA 3+846.790 TO STA 4+120.000 LT (CENTER LINE)  
 STA 3+846.790 TO STA 4+120.000 RT (CENTER LINE)  
 STA 20+005.800 TO STA 20+030.000 LT (TH #32 CENTER LINE)  
 STA 20+005.800 TO STA 20+030.000 RT (TH #32 CENTER LINE)

**DURABLE LETTER OR SYMBOL**  
 STA 20+009.070 LT (TH #32 - "STOP")


**DURABLE 600mm STOP BAR**  
 STA 20+006.320 LT (TH #32 - IIM)

**TEMPORARY LETTER OR SYMBOL**  
 STA 20+009.070 LT (TH #32 - "STOP")

**TEMPORARY 600mm STOP BAR**  
 STA 20+006.320 LT (TH #32 - IIM)

**TEMPORARY 100mm WHITE LINE**  
 STA 3+760.000 TO STA 3+821.200 LT (EDGE LINE)  
 STA 3+760.000 TO STA 4+120.000 RT (EDGE LINE)  
 STA 3+851.310 TO STA 4+120.000 LT (EDGE LINE)  
 STA 20+000.000 TO STA 20+030.000 LT (TH #32 EDGE LINE)  
 STA 20+000.000 TO STA 20+030.000 RT (TH #32 EDGE LINE)

**TEMPORARY 100mm YELLOW LINE**  
 STA 3+760.000 TO STA 3+827.660 LT (CENTER LINE)  
 STA 3+760.000 TO STA 3+827.660 RT (CENTER LINE)  
 STA 3+846.790 TO STA 4+120.000 LT (CENTER LINE)  
 STA 3+846.790 TO STA 4+120.000 RT (CENTER LINE)  
 STA 20+005.800 TO STA 20+030.000 LT (TH #32 CENTER LINE)  
 STA 20+005.800 TO STA 20+030.000 RT (TH #32 CENTER LINE)

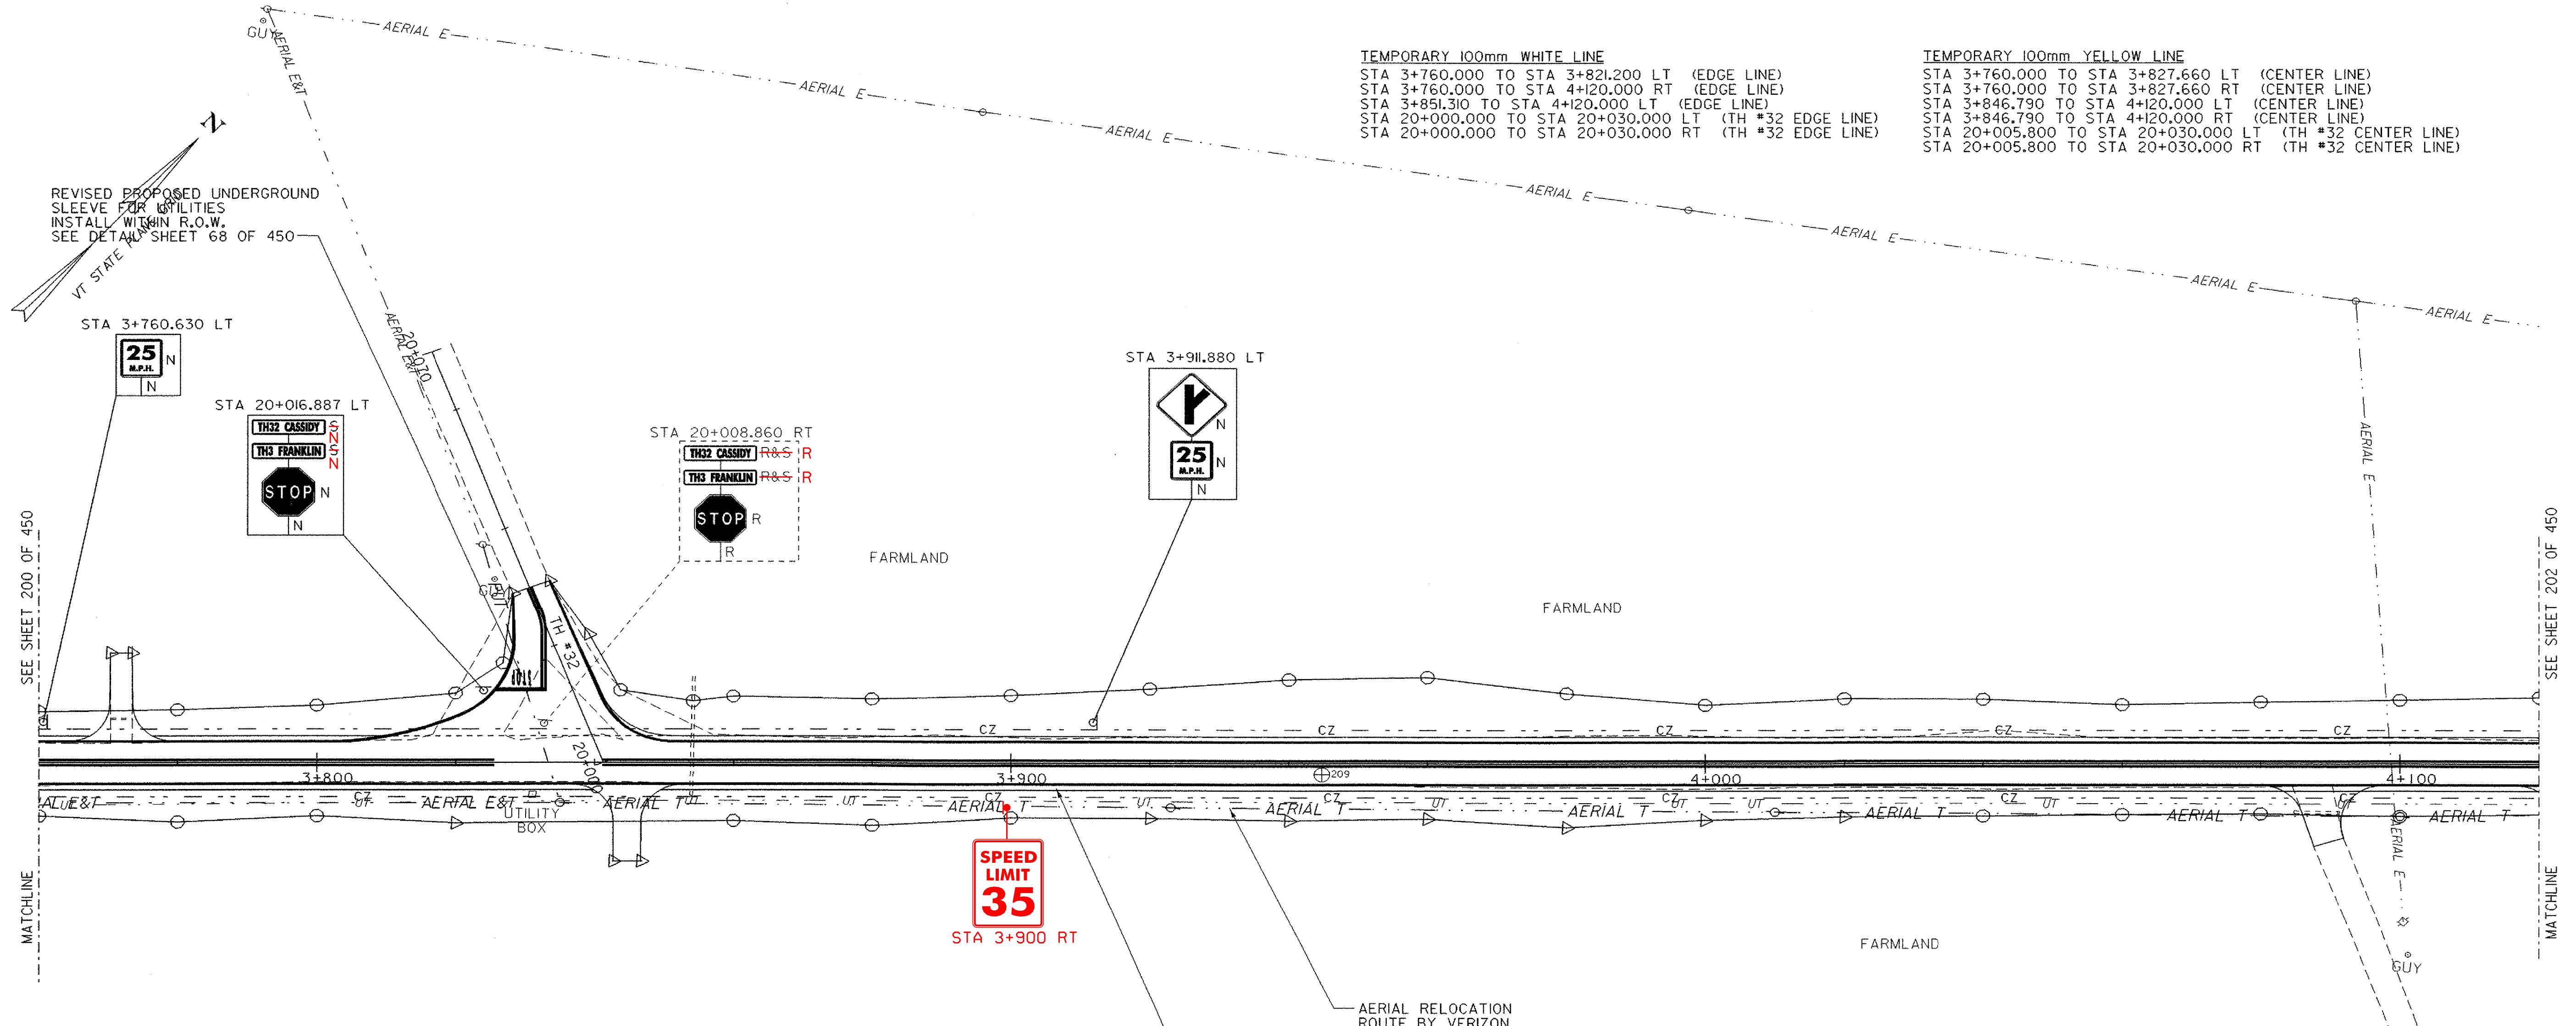

**SIGN LEGEND**  
 R = REMOVE  
 S = SALVAGE  
 N = NEW  
 RET = RETAIN  
 T&T = THINNING & TRIMMING  
 B-B = BACK TO BACK

**TRAFFIC SIGNS & PAVEMENT MARKINGS SHEET**



PROJECT NAME: HIGHGATE - FRANKLIN  
 PROJECT NUMBER: STP RS 030(K) SA  
 FILE NAME: ...85c060/design/dc060++s.dgn PLOT DATE: 09-MAY-2005  
 PROJECT LEADER: DELLASANTA DRAWN BY: SQUAD B  
 DESIGNED BY: SQUAD B CHECKED BY: SQUAD B  
 IPARM FILE NAME: dc060+s9.i SHEET 201 OF 450