

DURABLE 100mm WHITE LINE
 STA 6+440.000 TO STA 6+720.000 LT (EDGE LINE)
 STA 6+440.000 TO STA 6+613.890 RT (EDGE LINE)
 STA 6+643.220 TO STA 6+720.000 RT (EDGE LINE)
 STA 23+002.520 TO STA 23+010.000 LT (TH #25 EDGE LINE)
 STA 23+002.550 TO STA 23+010.000 RT (TH #25 EDGE LINE)

DURABLE 100mm YELLOW LINE
 STA 6+440.000 TO STA 6+622.560 LT (CENTER LINE)
 STA 6+440.000 TO STA 6+622.560 RT (CENTER LINE)
 STA 6+634.550 TO STA 6+720.000 LT (CENTER LINE)
 STA 6+634.550 TO STA 6+720.000 RT (CENTER LINE)
 STA 23+004.600 TO STA 23+010.000 LT (TH #25 CENTER LINE)
 STA 23+004.600 TO STA 23+010.000 RT (TH #25 CENTER LINE)


DURABLE LETTER OR SYMBOL
 STA 23+008.128 LT (TH #25 - 'STOP')

TEMPORARY 100mm WHITE LINE
 STA 6+440.000 TO STA 6+720.000 LT (EDGE LINE)
 STA 6+440.000 TO STA 6+613.890 RT (EDGE LINE)
 STA 6+643.220 TO STA 6+720.000 RT (EDGE LINE)
 STA 23+002.520 TO STA 23+010.000 LT (TH #25 EDGE LINE)
 STA 23+002.550 TO STA 23+010.000 RT (TH #25 EDGE LINE)

TEMPORARY LETTER OR SYMBOL
 STA 23+008.128 LT (TH #25 - 'STOP')

TEMPORARY 100mm YELLOW LINE
 STA 6+440.000 TO STA 6+622.560 LT (CENTER LINE)
 STA 6+440.000 TO STA 6+622.560 RT (CENTER LINE)
 STA 6+634.550 TO STA 6+720.000 LT (CENTER LINE)
 STA 6+634.550 TO STA 6+720.000 RT (CENTER LINE)
 STA 23+004.600 TO STA 23+010.000 LT (TH #25 CENTER LINE)
 STA 23+004.600 TO STA 23+010.000 RT (TH #25 CENTER LINE)

TEMPORARY 600mm STOP BAR
 STA 23+005.378 LT (TH #25 - 9M)

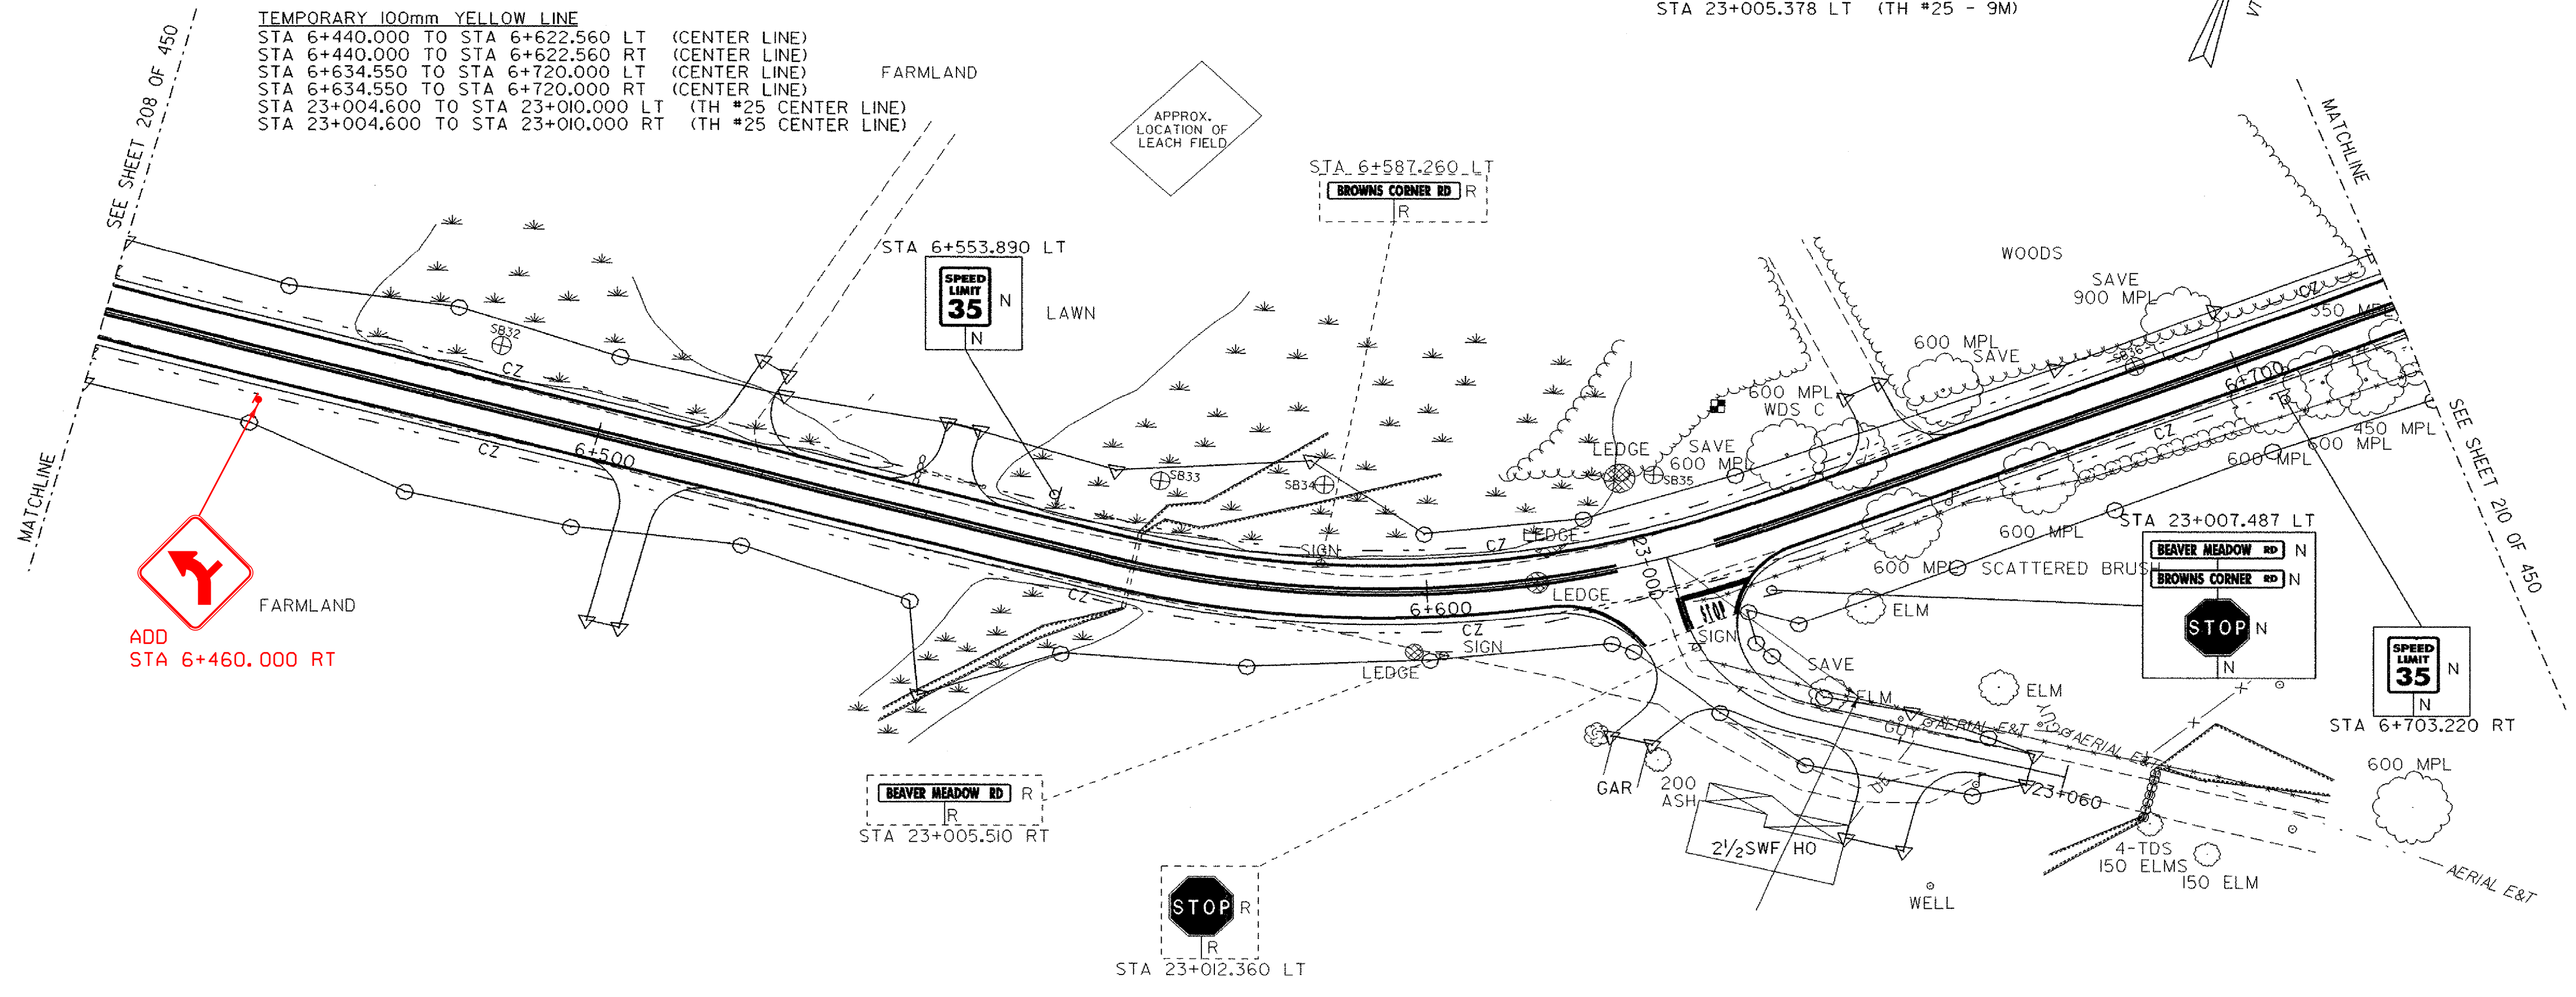

ADD
 STA 6+460.000 RT

SIGN LEGEND

- R = REMOVE
- S = SALVAGE
- N = NEW
- RET = RETAIN
- T&T = THINNING & TRIMMING
- B-B = BACK TO BACK

TRAFFIC SIGNS & PAVEMENT MARKINGS SHEET



| | |
|------------------|-------------------------------|
| PROJECT NAME: | HIGHGATE - FRANKLIN |
| PROJECT NUMBER: | STP RS 030(I) SA |
| FILE NAME: | ...85c060/design/dc060+ts.dgn |
| PROJECT LEADER: | DELLASANTA |
| DESIGNED BY: | SQUAD B |
| IPARM FILE NAME: | dc060+st7.i |
| PLOT DATE: | 09-MAY-2005 |
| DRAWN BY: | SQUAD B |
| CHECKED BY: | SQUAD B |
| SHEET | 209 OF 450 |