
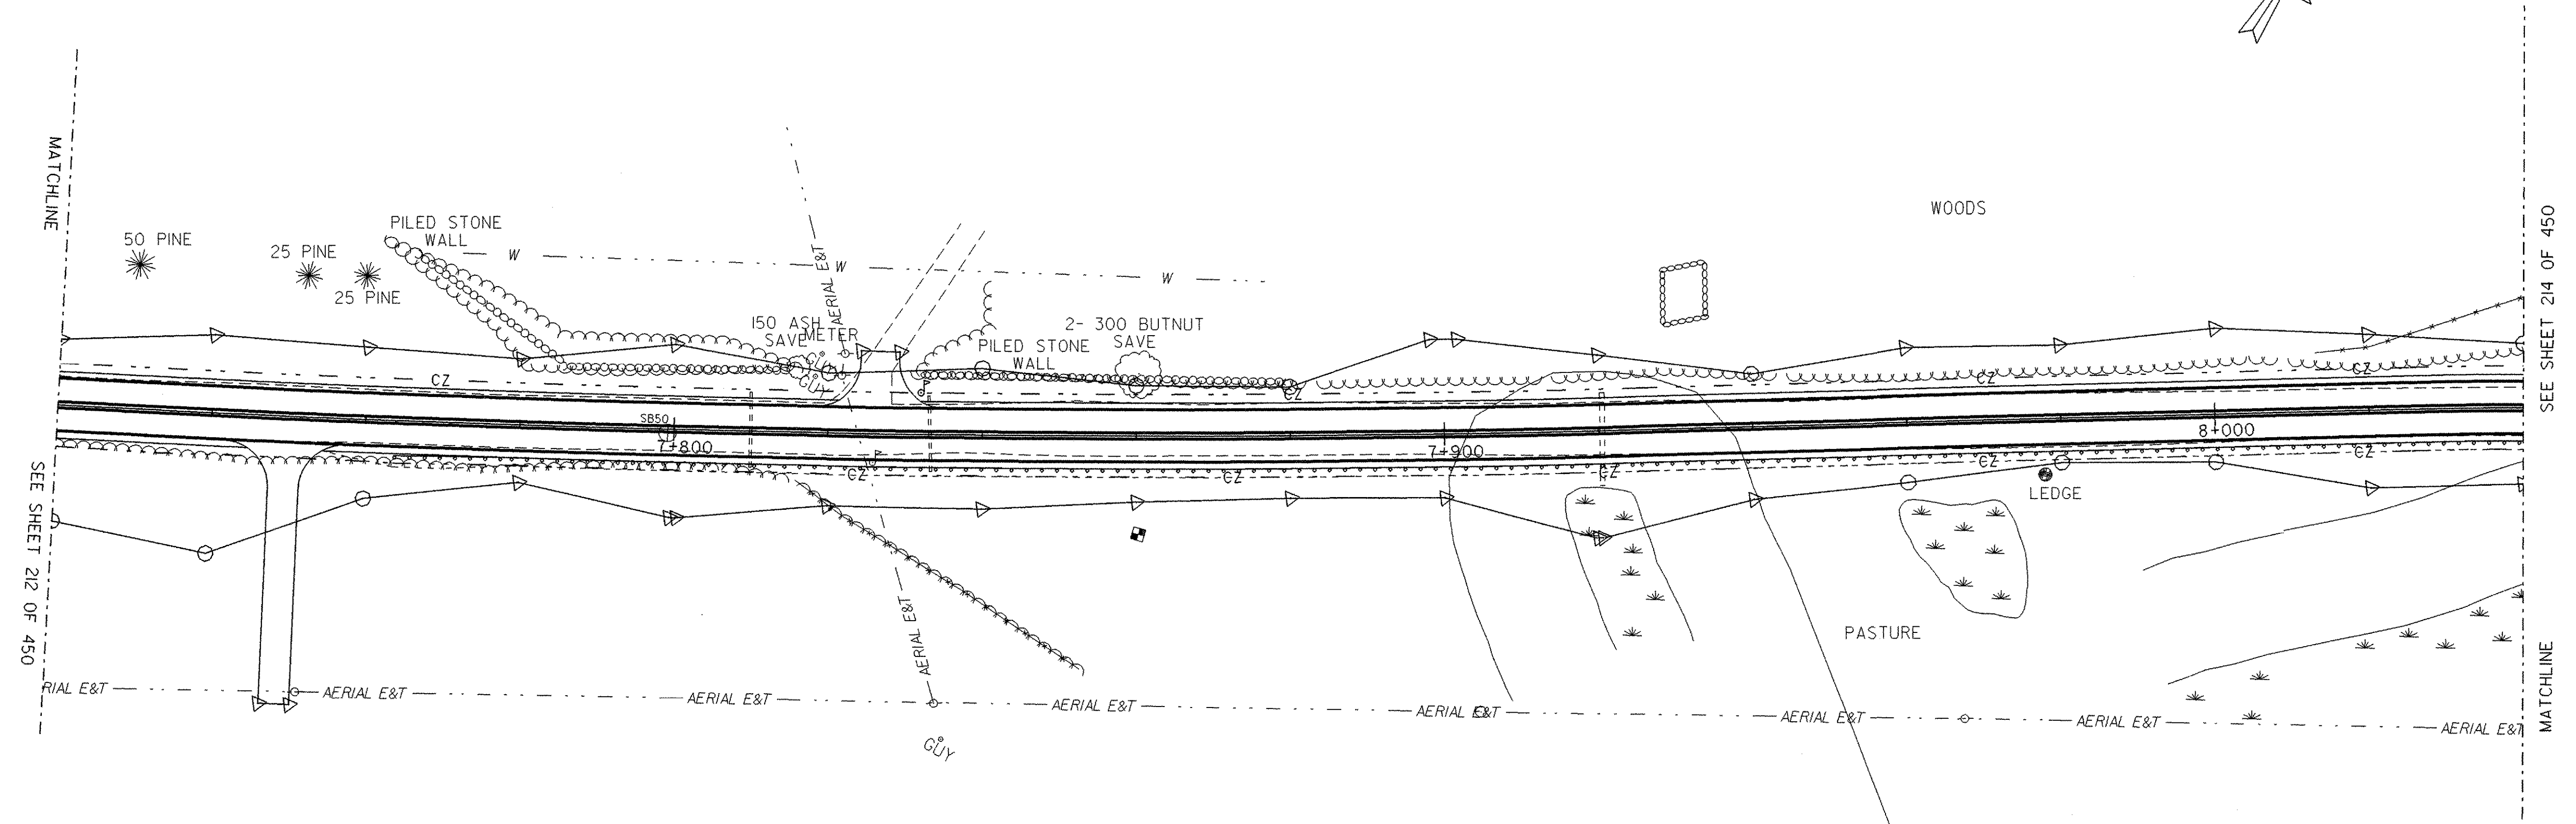


DURABLE 100mm WHITE LINE
 STA 7+720.000 TO STA 8+040.000 LT (EDGE LINE)
 STA 7+720.000 TO STA 8+040.000 RT (EDGE LINE)

DURABLE 100mm YELLOW LINE
 STA 7+720.000 TO STA 8+040.000 LT (CENTER LINE)
 STA 7+720.000 TO STA 8+040.000 RT (CENTER LINE)

TEMPORARY 100mm WHITE LINE
 STA 7+720.000 TO STA 8+040.000 LT (EDGE LINE)
 STA 7+720.000 TO STA 8+040.000 RT (EDGE LINE)

TEMPORARY 100mm YELLOW LINE
 STA 7+720.000 TO STA 8+040.000 LT (CENTER LINE)
 STA 7+720.000 TO STA 8+040.000 RT (CENTER LINE)

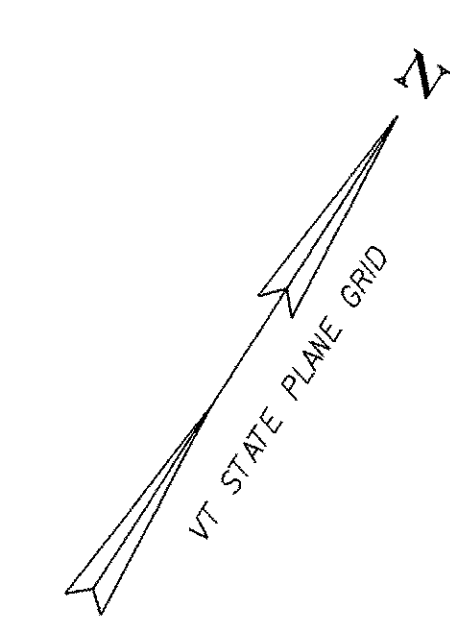

SIGN LEGEND

- R = REMOVE
- S = SALVAGE
- N = NEW
- RET = RETAIN
- T&T = THINNING & TRIMMING
- B-B = BACK TO BACK

TRAFFIC SIGNS & PAVEMENT MARKINGS SHEET



PROJECT NAME: HIGHGATE - FRANKLIN	
PROJECT NUMBER: STP RS 030(K) SA	
FILE NAME: ...85c060/design/dc060+ts.dgn	PLOT DATE: 09-MAY-2005
PROJECT LEADER: DELLASANTA	DRAWN BY: SQUAD B
DESIGNED BY: SQUAD B	CHECKED BY: SQUAD B
IPARM FILE NAME: dc060+ts2LI	SHEET 213 OF 450