
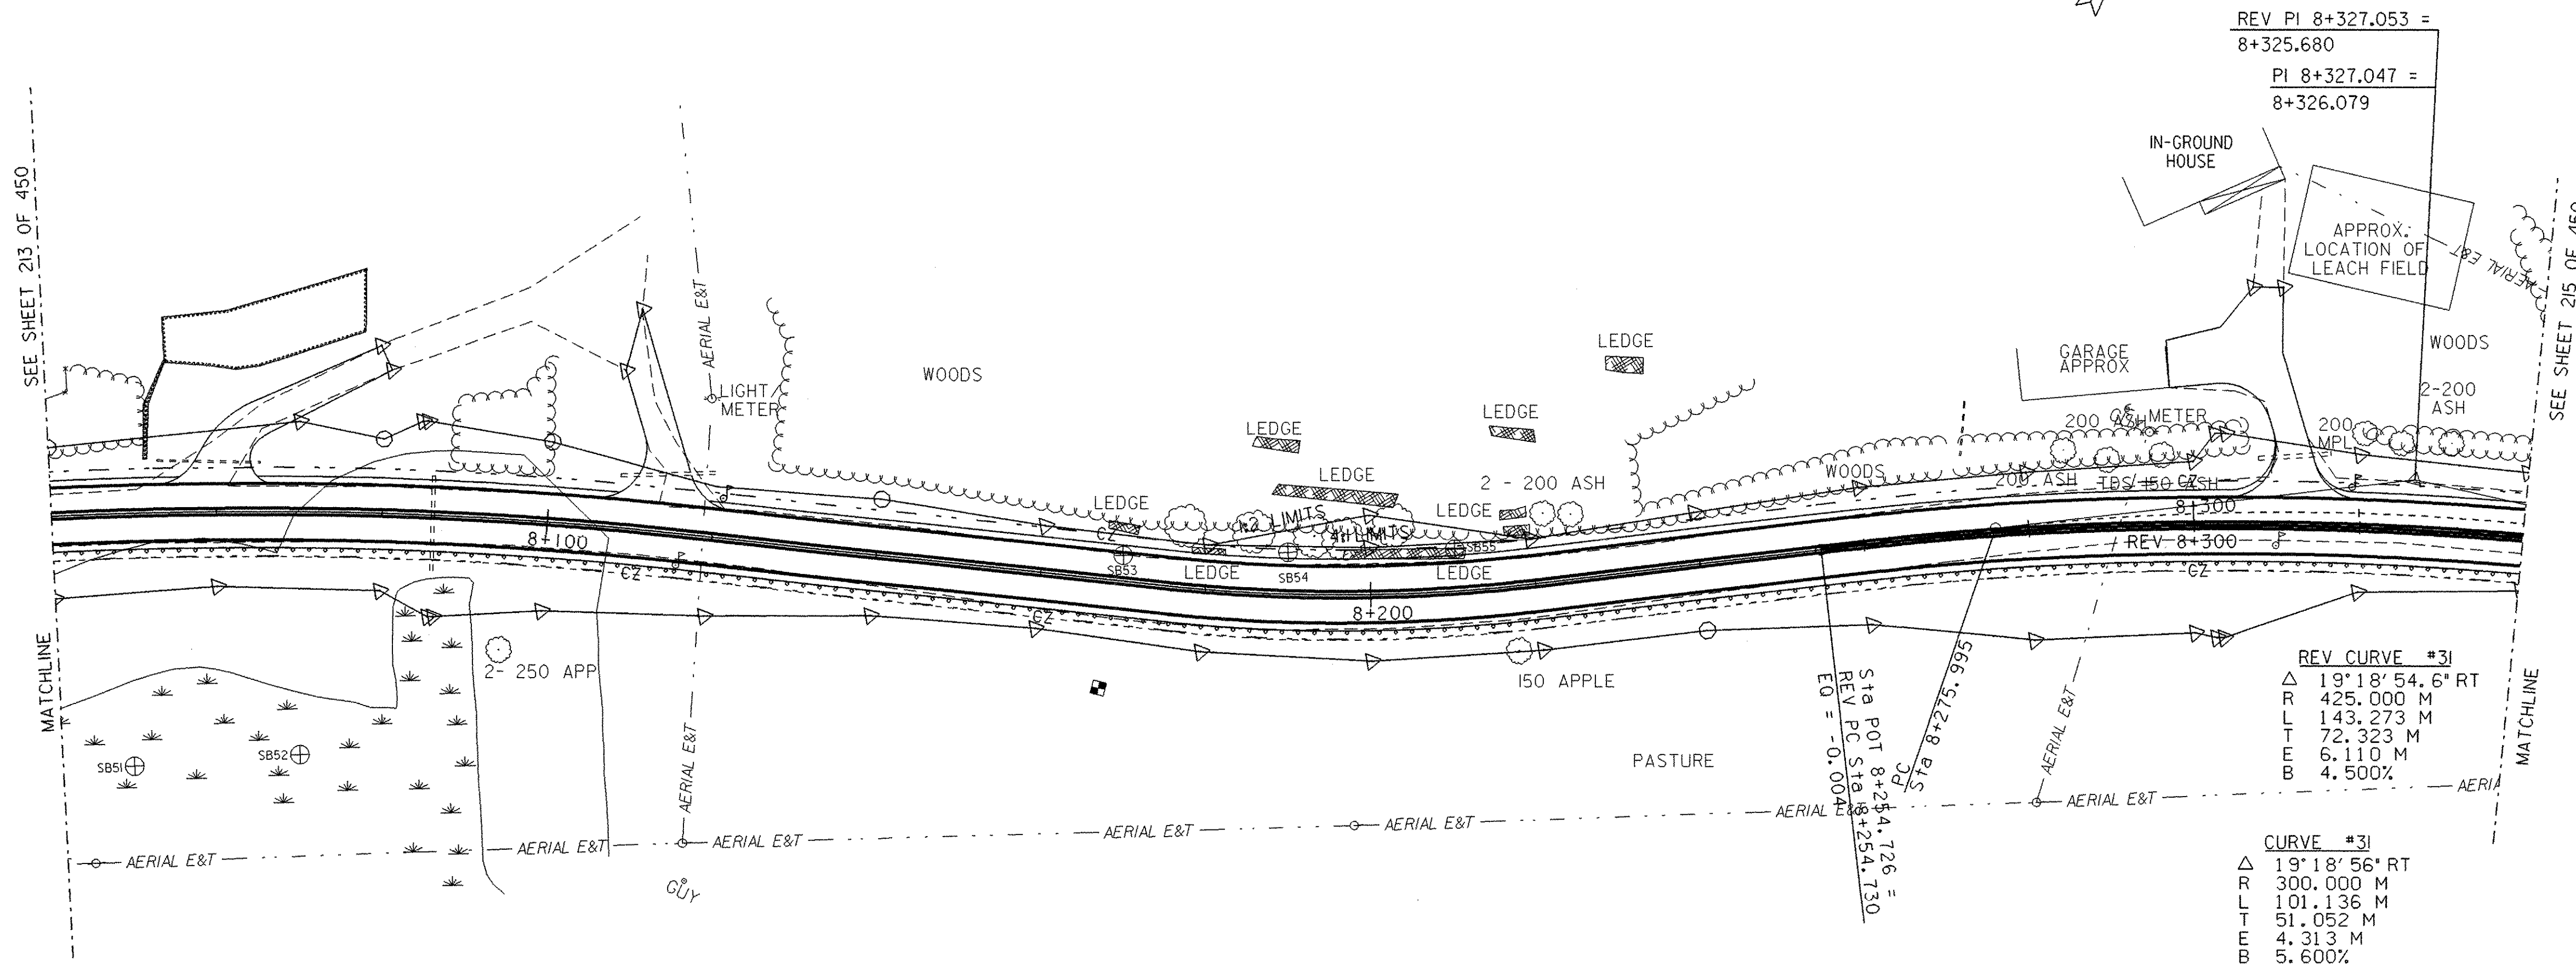


DURABLE 100mm WHITE LINE
 STA 8+040.000 TO REV STA 8+339.720 LT (EDGE LINE)
 STA 8+040.000 TO REV STA 8+339.720 RT (EDGE LINE)

DURABLE 100mm YELLOW LINE
 STA 8+040.000 TO REV STA 8+339.720 LT (CENTER LINE)
 STA 8+040.000 TO REV STA 8+339.720 RT (CENTER LINE)

TEMPORARY 100mm WHITE LINE
 STA 8+040.000 TO REV STA 8+339.720 LT (EDGE LINE)
 STA 8+040.000 TO REV STA 8+339.720 RT (EDGE LINE)

TEMPORARY 100mm YELLOW LINE
 STA 8+040.000 TO REV STA 8+339.720 LT (CENTER LINE)
 STA 8+040.000 TO REV STA 8+339.720 RT (CENTER LINE)

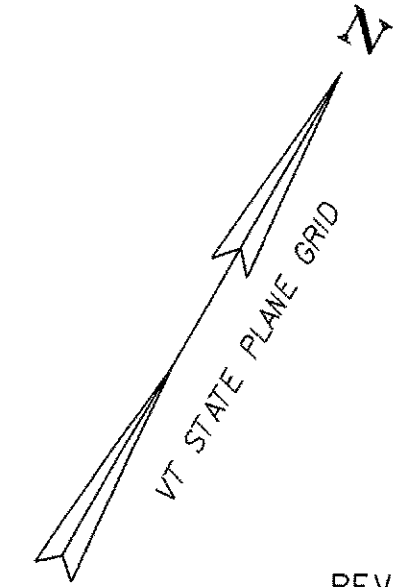

SIGN LEGEND

- R = REMOVE
- S = SALVAGE
- N = NEW
- RET = RETAIN
- T&T = THINNING & TRIMMING
- B-B = BACK TO BACK

TRAFFIC SIGNS & PAVEMENT MARKINGS SHEET



PROJECT NAME:	HIGHGATE - FRANKLIN
PROJECT NUMBER:	STP RS 030(K) SA
FILE NAME:	...85c060/design/dc060+ts.dgn
PROJECT LEADER:	DELLASANTA
DESIGNED BY:	SQUAD B
IPARM FILE NAME:	dc060+ts22.i
PLOT DATE:	09-MAY-2005
DRAWN BY:	SQUAD B
CHECKED BY:	SQUAD B
SHEET	214 OF 450