
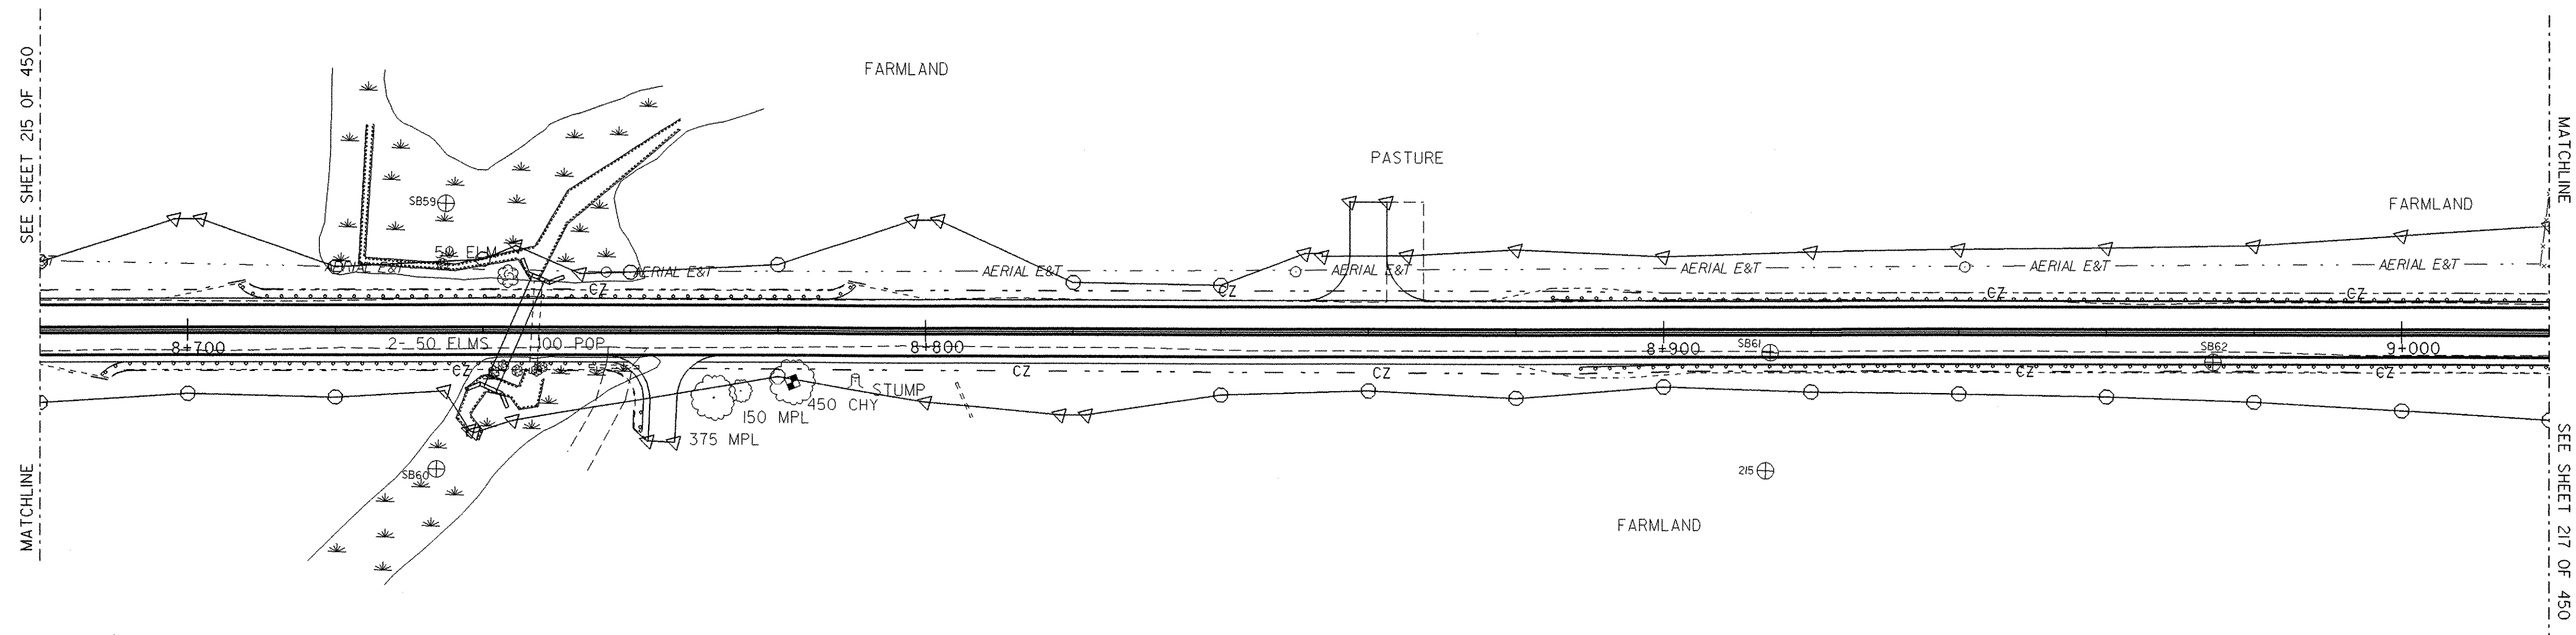


**DURABLE 100mm WHITE LINE**  
 STA 8+680.000 TO STA 9+020.000 LT (EDGE LINE)  
 STA 8+680.000 TO STA 9+020.000 RT (EDGE LINE)

**DURABLE 100mm YELLOW LINE**  
 STA 8+680.000 TO STA 9+020.000 LT (CENTER LINE)  
 STA 8+680.000 TO STA 9+020.000 RT (CENTER LINE)

**TEMPORARY 100mm WHITE LINE**  
 STA 8+680.000 TO STA 9+020.000 LT (EDGE LINE)  
 STA 8+680.000 TO STA 9+020.000 RT (EDGE LINE)

**TEMPORARY 100mm YELLOW LINE**  
 STA 8+680.000 TO STA 9+020.000 LT (CENTER LINE)  
 STA 8+680.000 TO STA 9+020.000 RT (CENTER LINE)

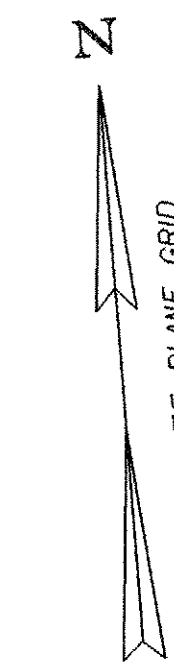

**SIGN LEGEND**

- R = REMOVE
- S = SALVAGE
- N = NEW
- RET = RETAIN
- T&T = THINNING & TRIMMING
- B-B = BACK TO BACK

**TRAFFIC SIGNS & PAVEMENT MARKINGS SHEET**



PROJECT NAME:	HIGHGATE - FRANKLIN
PROJECT NUMBER:	STP RS 030(I) SA
FILE NAME: ...85c060/design/dc060+ts.dgn	PLOT DATE: 09-MAY-2005
PROJECT LEADER: DELLASANTA	DRAWN BY: SQUAD B
DESIGNED BY: SQUAD B	CHECKED BY: SQUAD B
IPARM FILE NAME: dc060+ts24.i	SHEET 216 OF 450