



120+007.900

BEGIN TYPE II STONE FILL AND GRUBBING MATERIAL
STA. 120+008.500 GEOTEXTILE UNDER STONE FILL

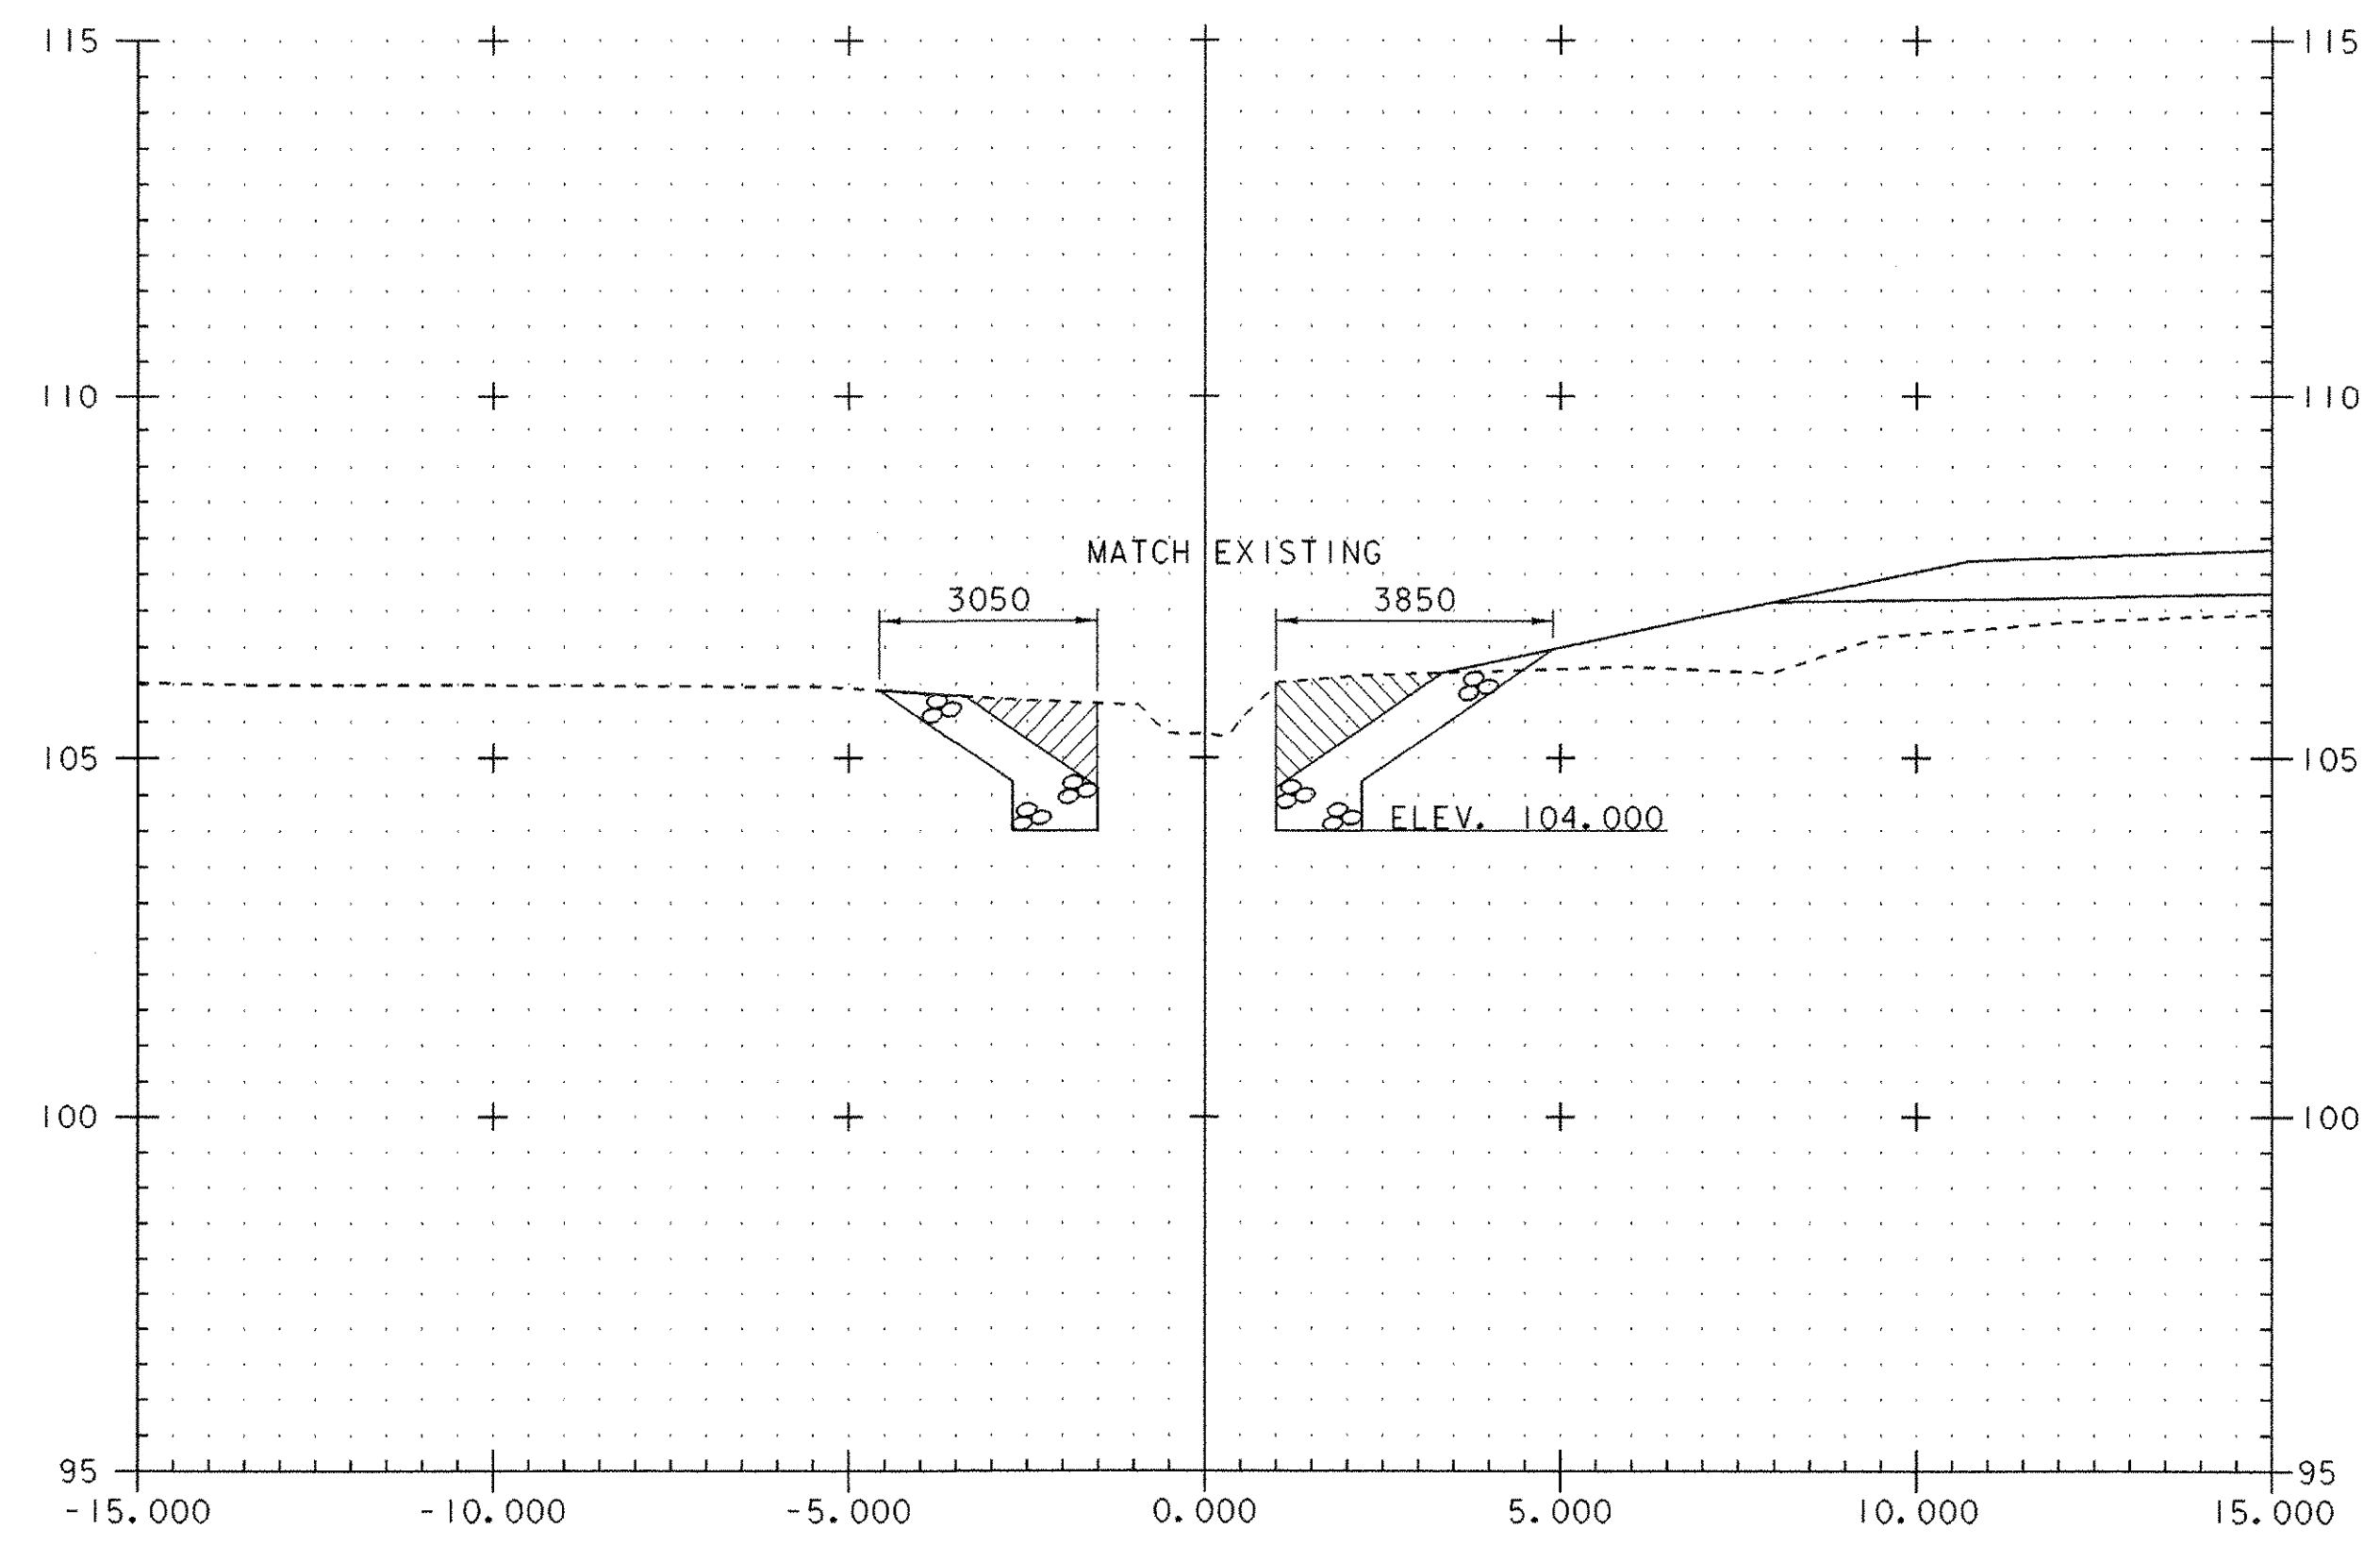


120+010.450

STA. 120+010.440 END TYPE II STONE FILL
STA. 120+009.990 END GEOTEXTILE UNDER STONE FILL

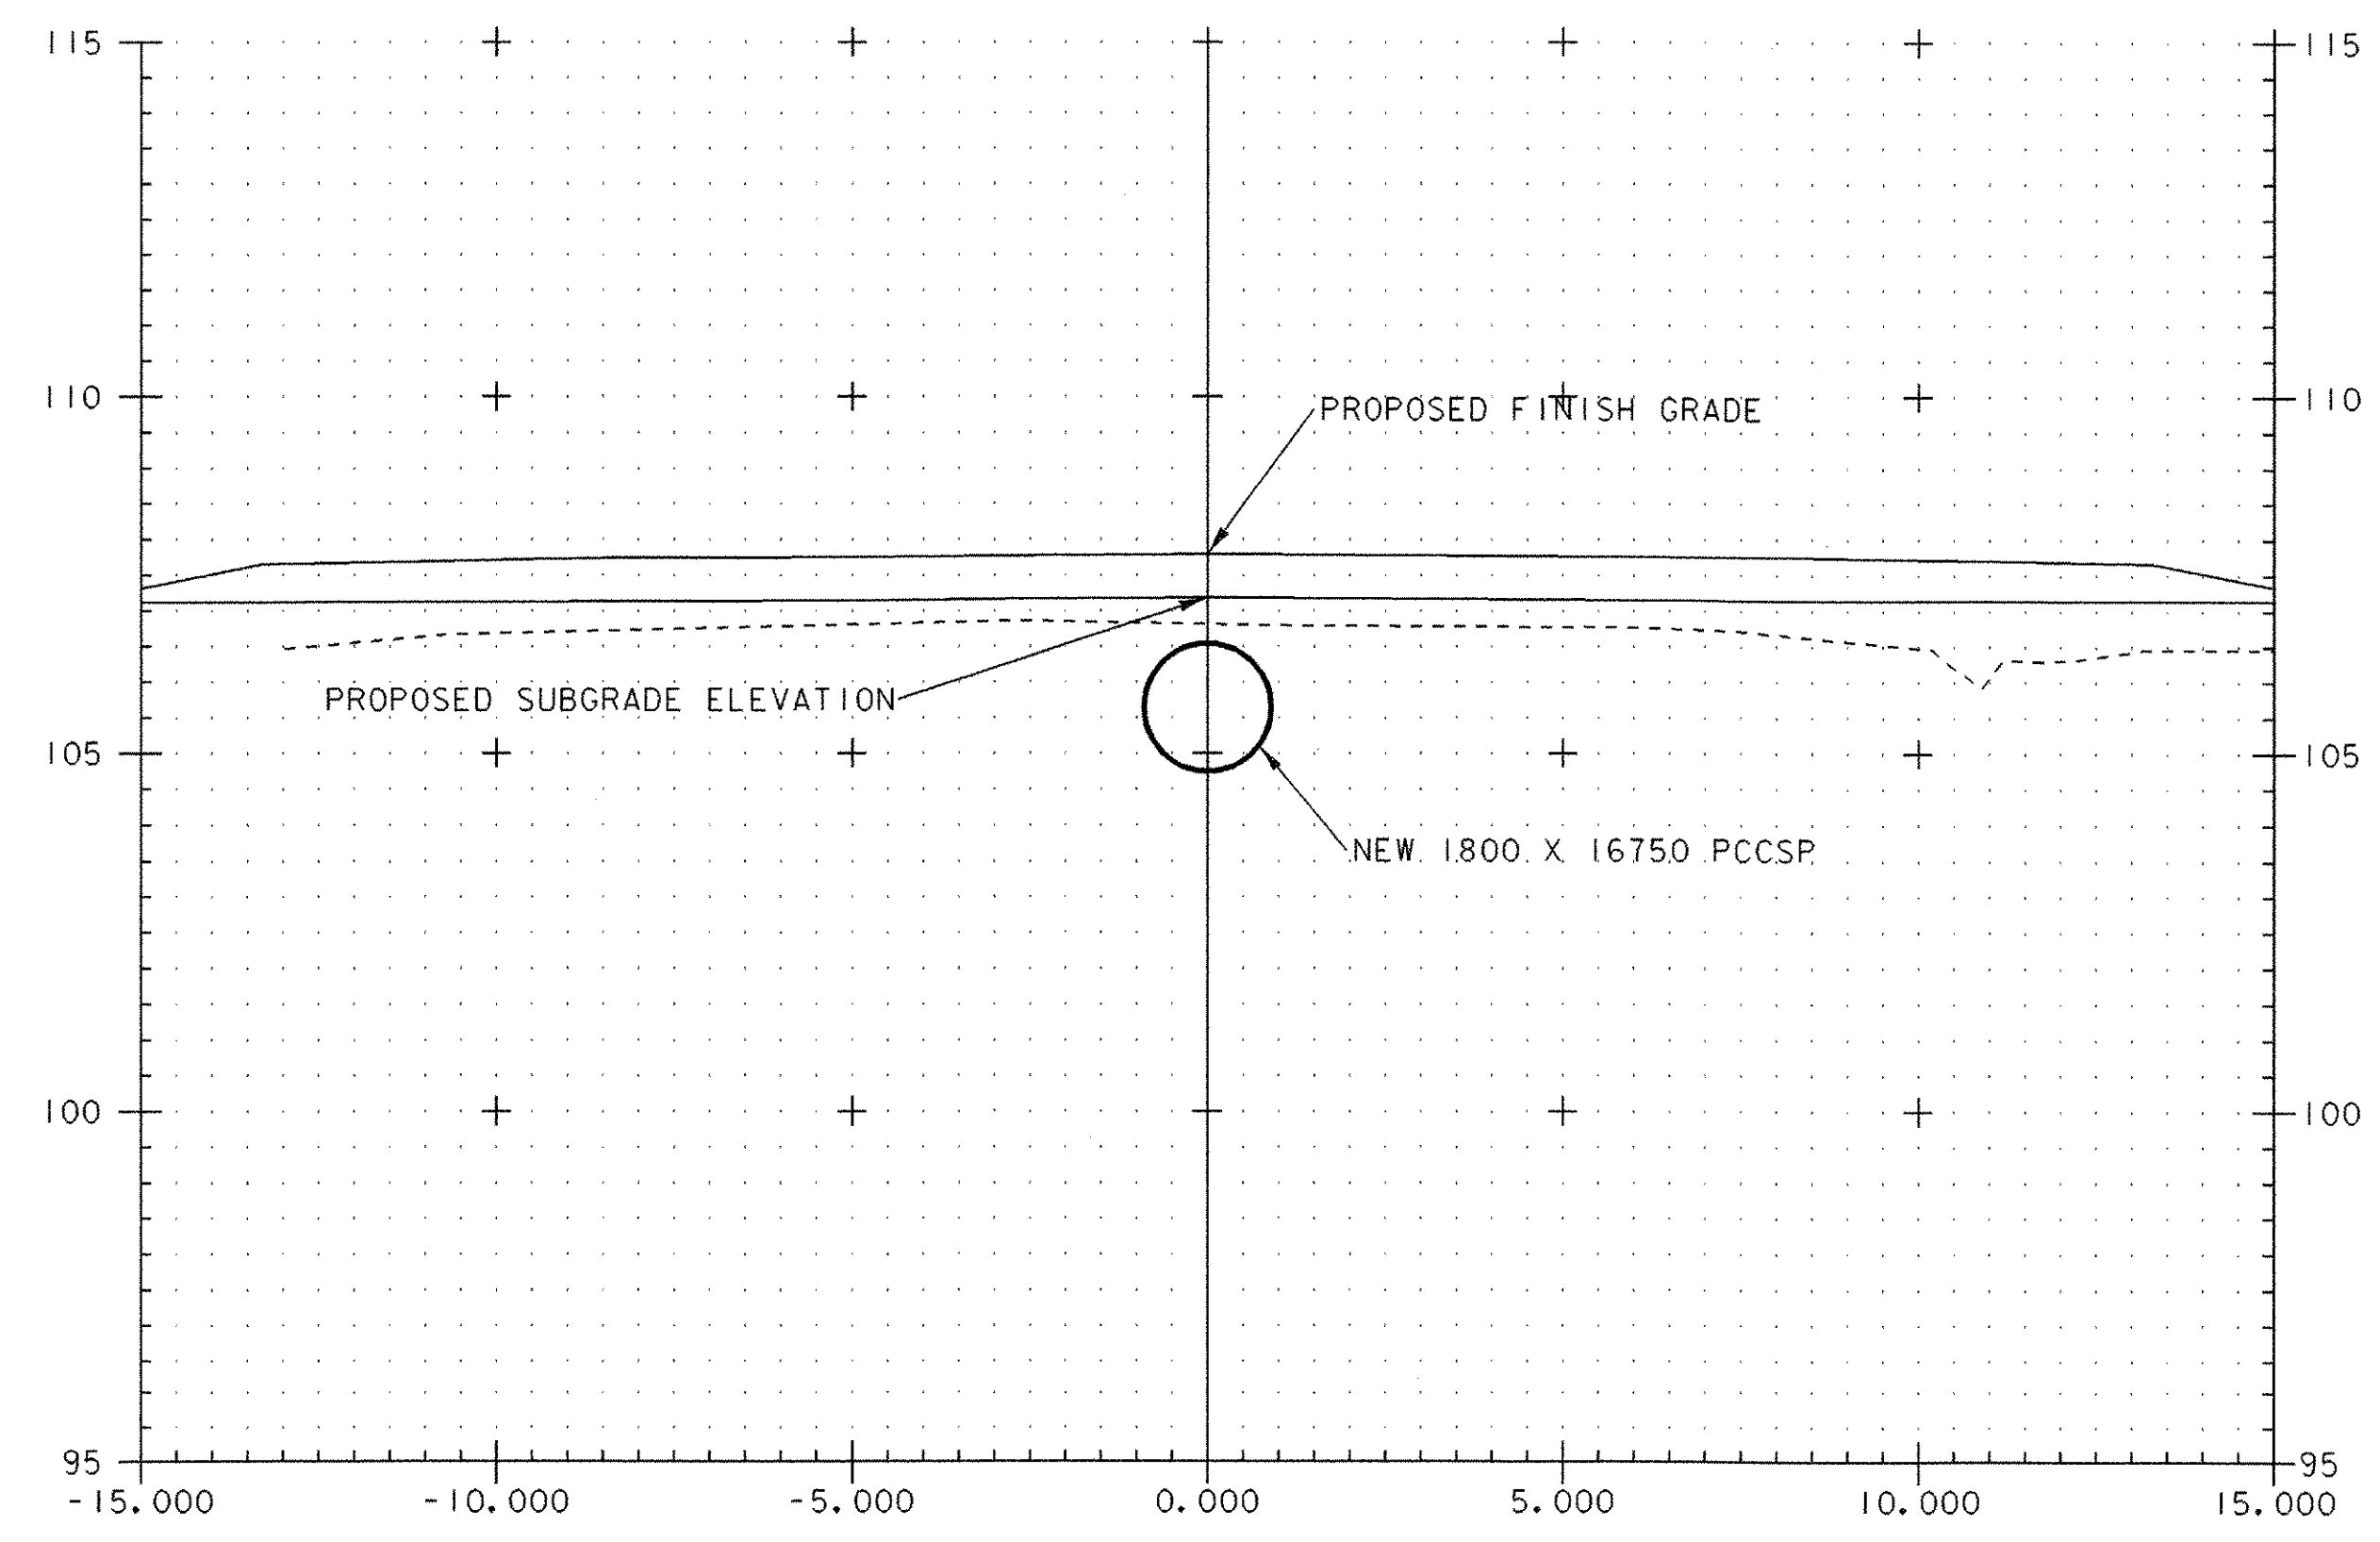

120+000.000

PROPOSED FINISH GRADE
PROPOSED SUBGRADE ELEVATION
NEW 1800 X 16750 PCCSP

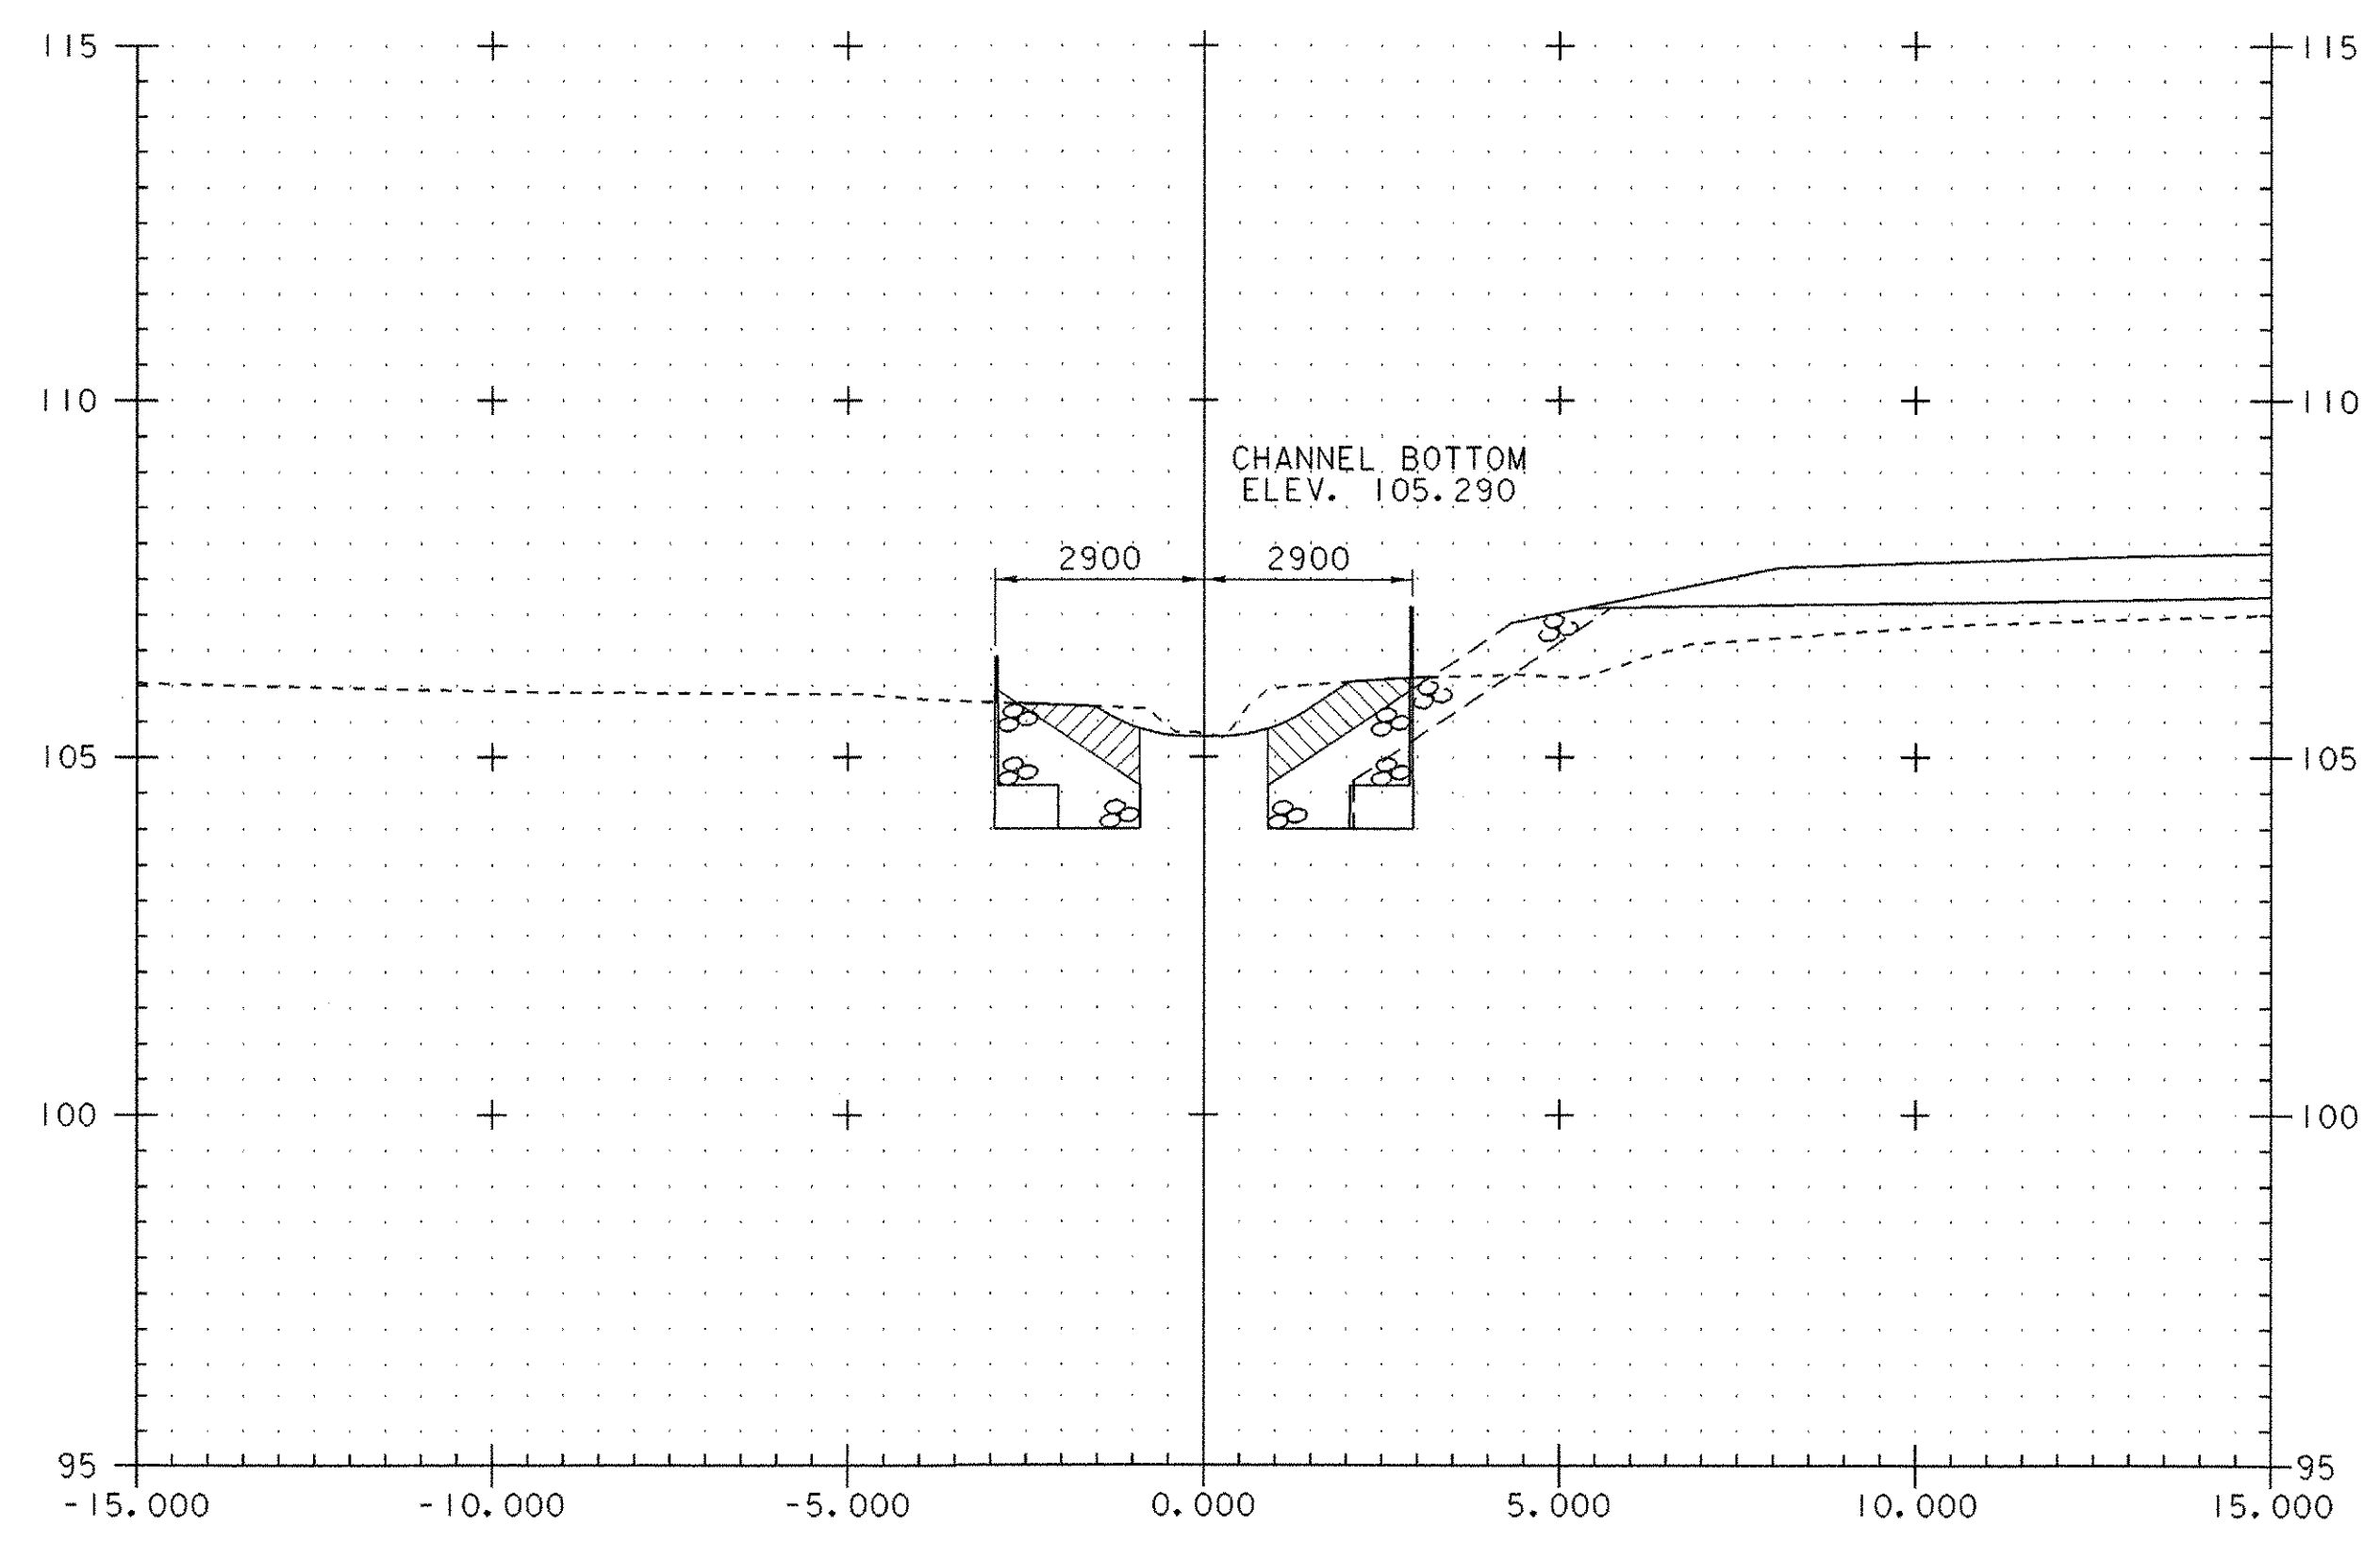

120+009.300

END GRUBBING MATERIAL

PIPE STA. 8+744.50 - CHANNEL SECTIONS

PROJECT NAME: HIGHGATE - FRANKLIN	PROJECT NUMBER: STP RS 030(I) SA
FILE NAME: /85c060/str/s85c060xs.dgn	PLOT DATE: 09-MAY-2005
PROJECT LEADER: S. FARNSWORTH	DRAWN BY: R. PELLETT
DESIGNED BY: M. FOWLER	CHECKED BY: G. SPILAK
sc060xs8744b.i	SHEET 247 OF 450

