
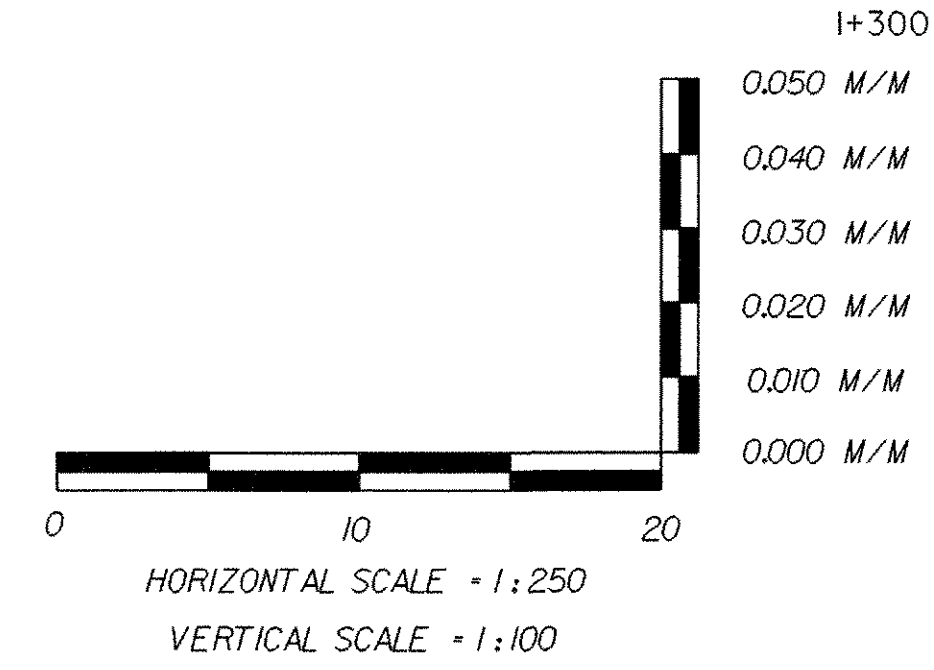
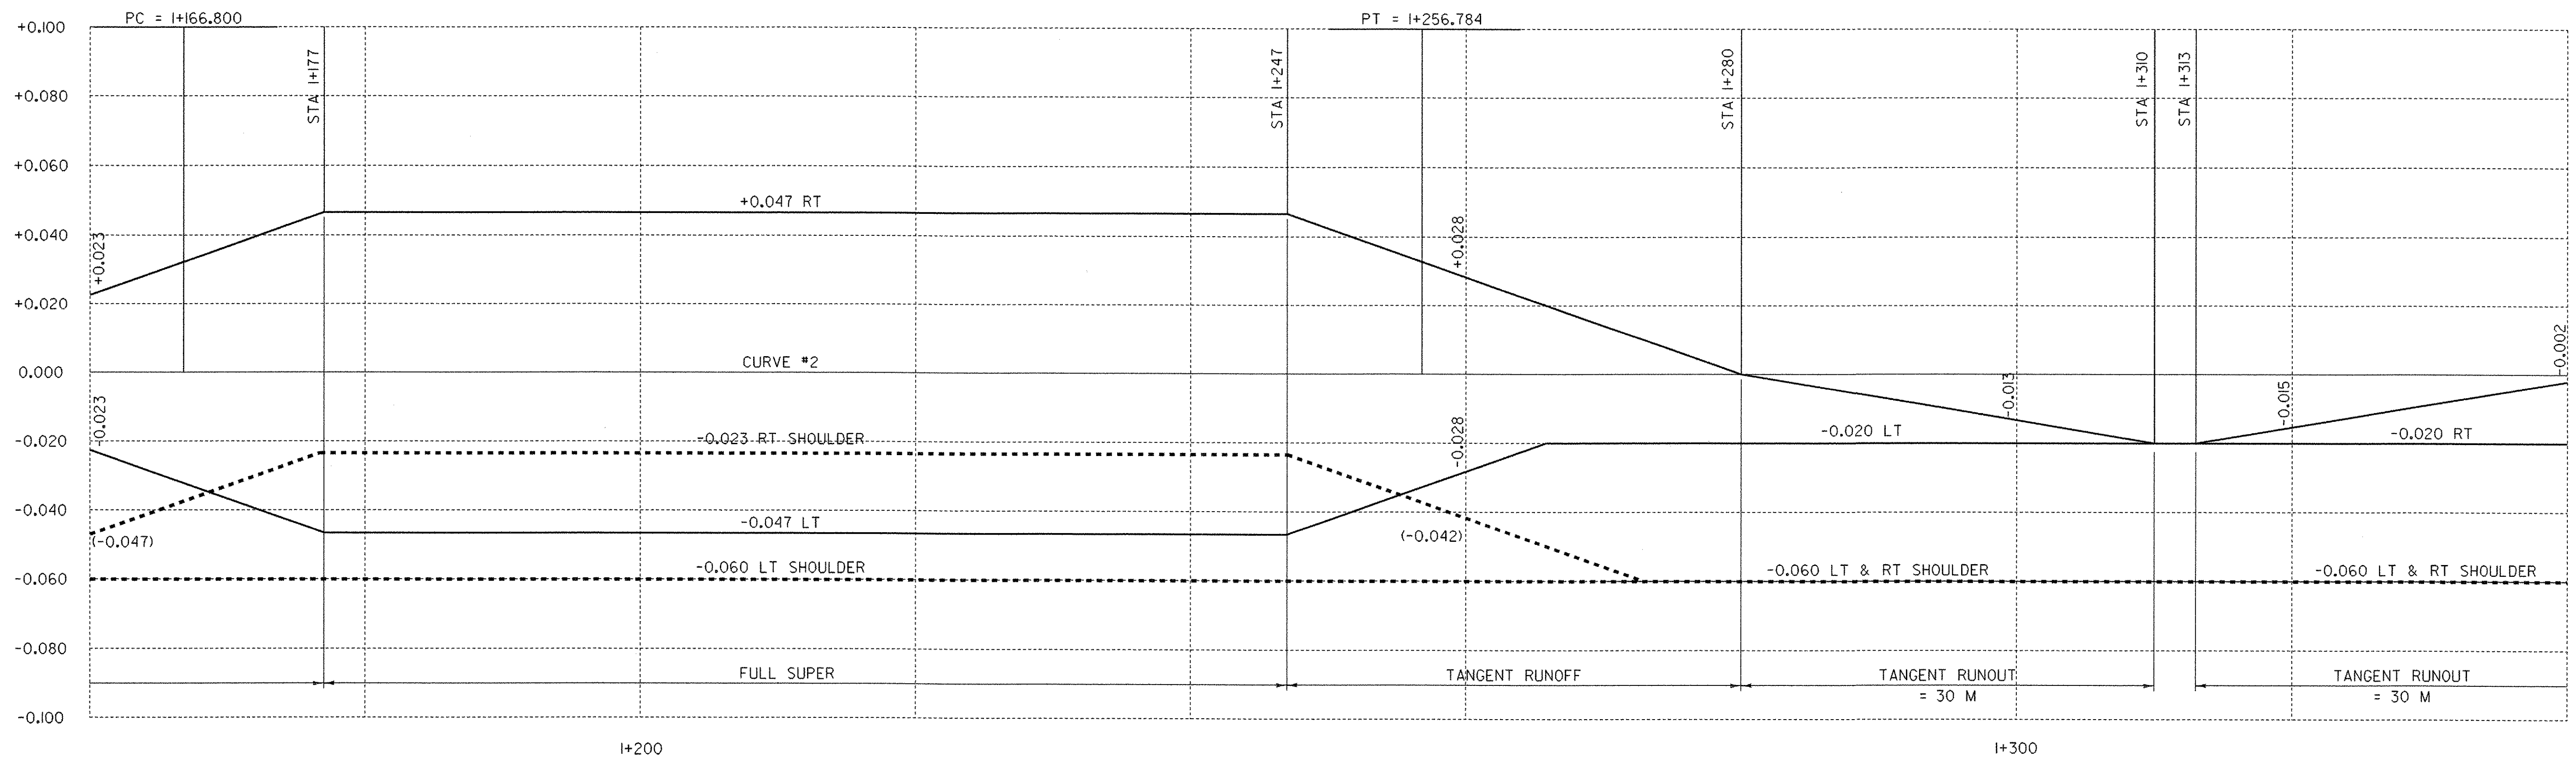


BEGIN PROJECT =
I+000.000

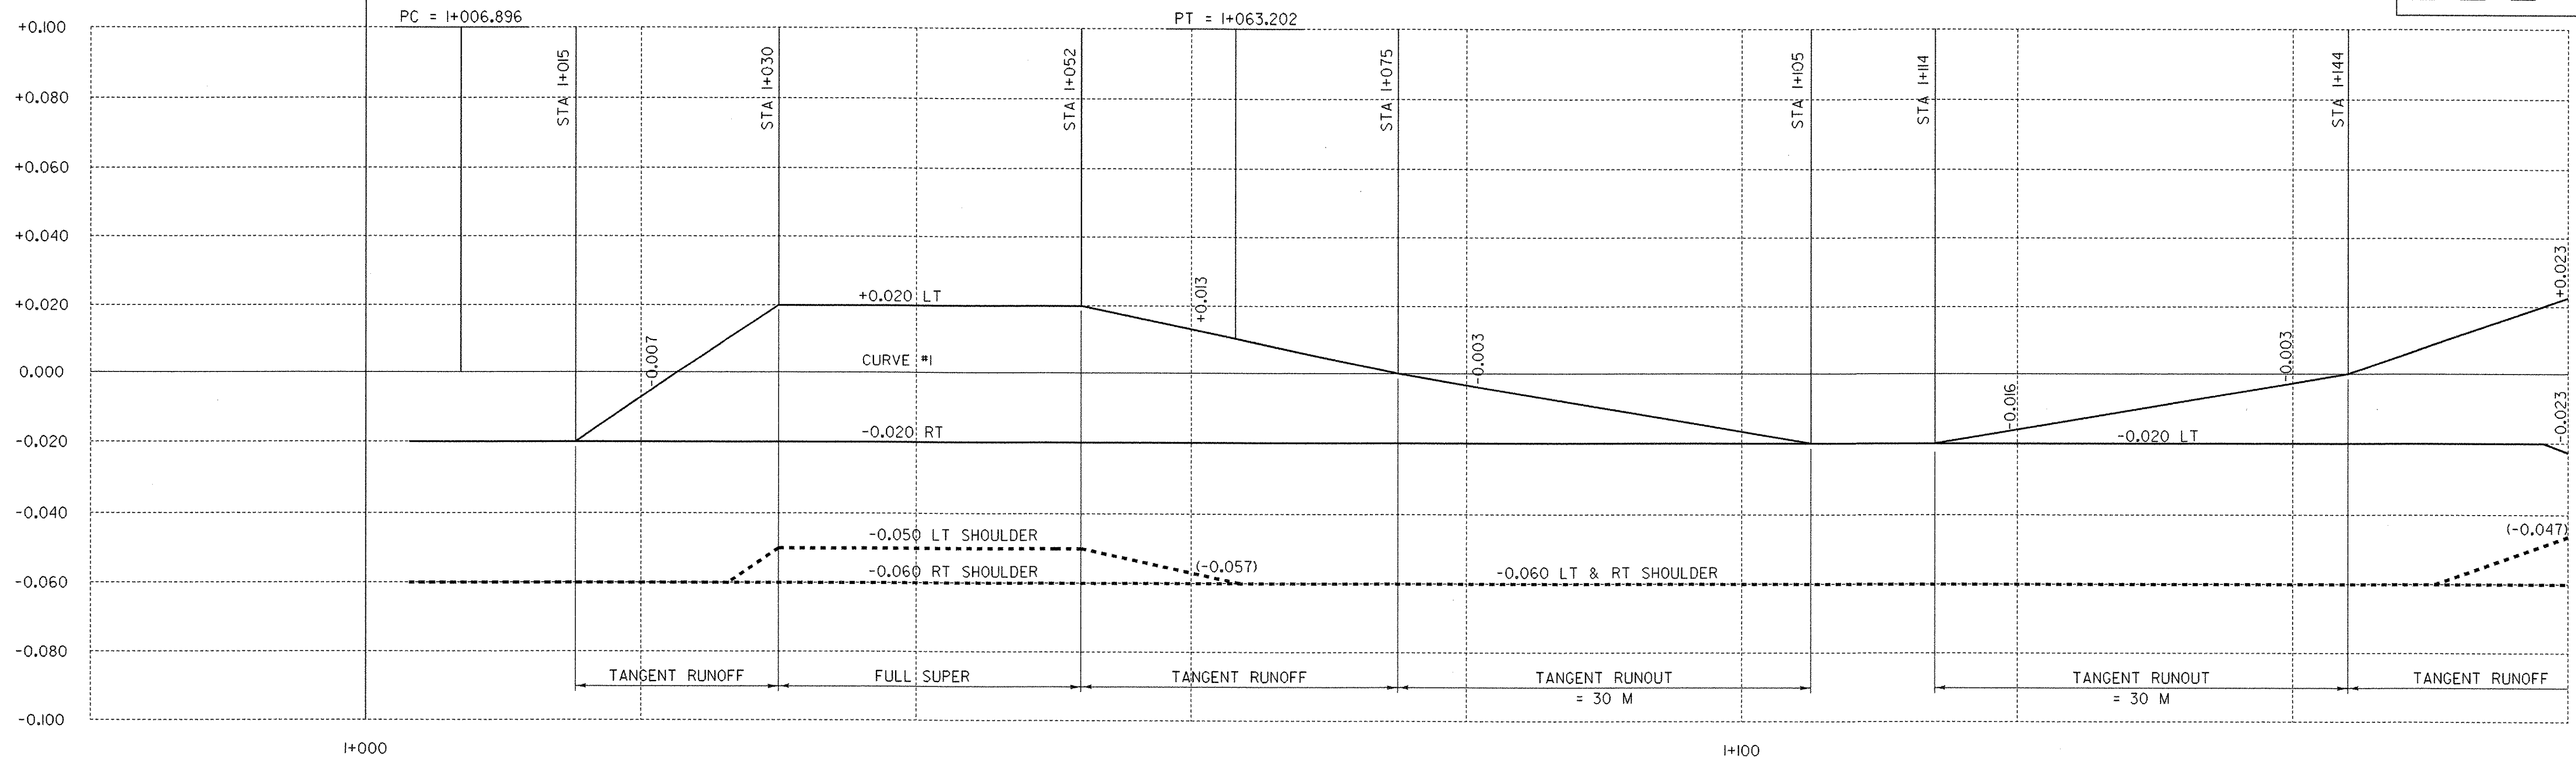

| | | | |
|------------------|-------------------------------|-------------|-------------|
| PROJECT NAME: | HIGHGATE - FRANKLIN | PLOT DATE: | 09-MAY-2005 |
| PROJECT NUMBER: | STP RS 030(I) SA | DRAWN BY: | SQUAD B |
| FILE NAME: | ...85c060/design/dc060xsl.dgn | CHECKED BY: | SQUAD B |
| PROJECT LEADER: | DELLASANTA | SHEET | 248 OF 450 |
| DESIGNED BY: | SQUAD B | | |
| IPARM FILE NAME: | dc060b01.i | | |