
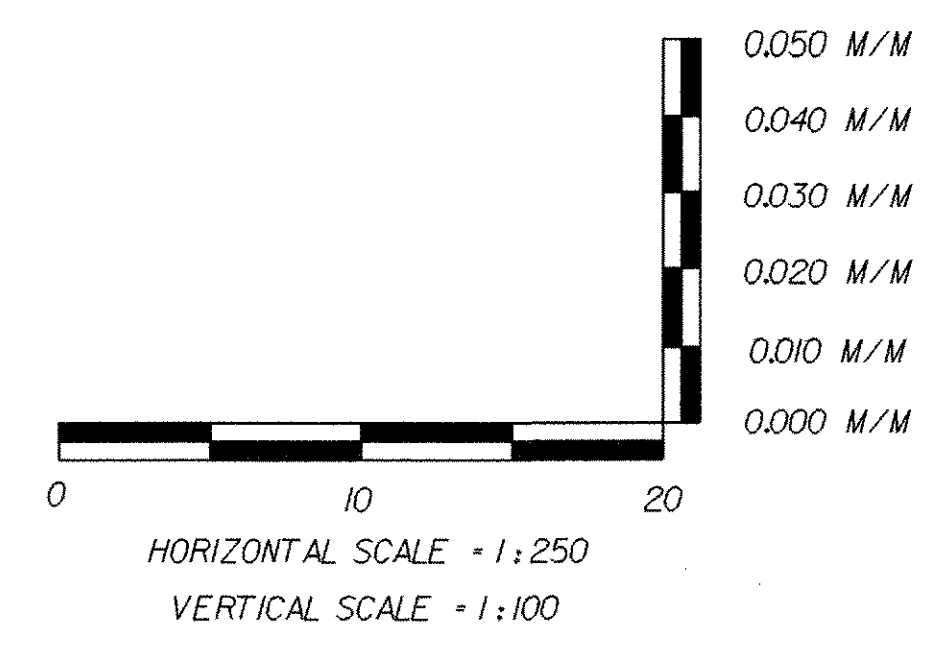
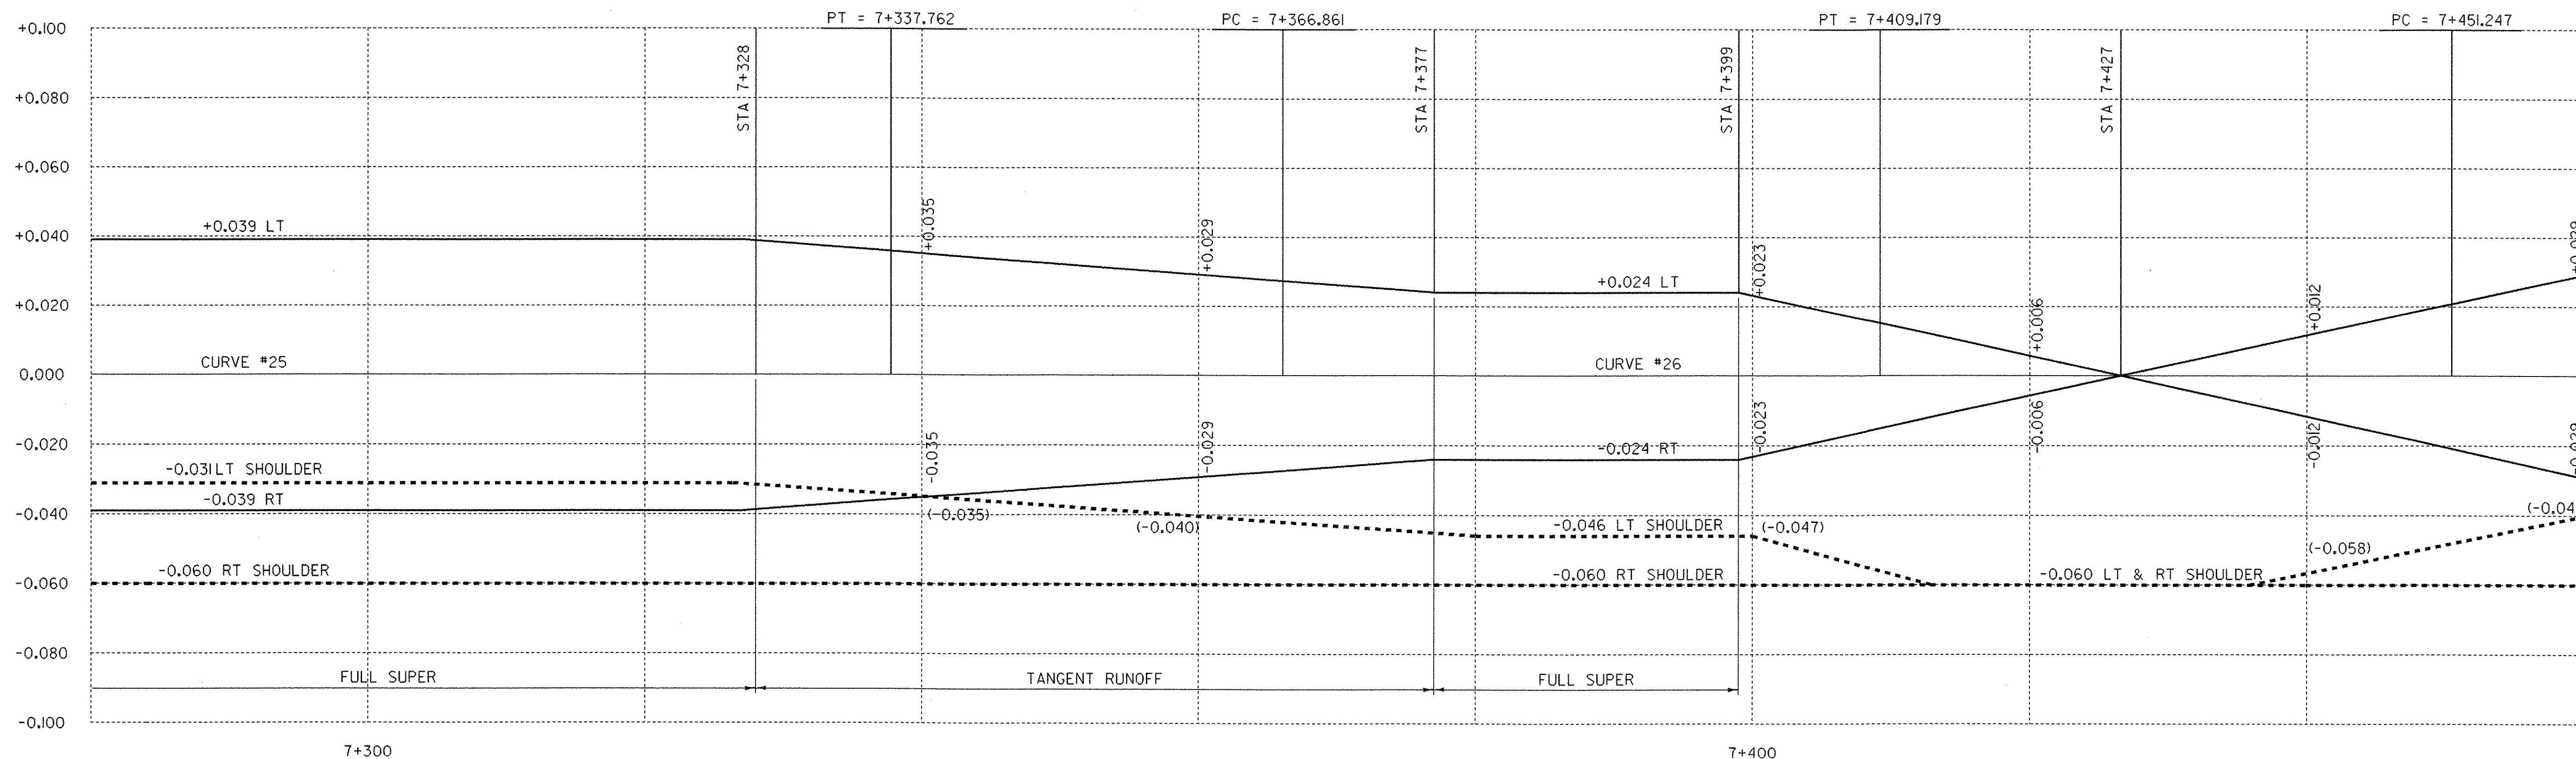


PT Sta 7+199.062 =
 POT Sta 7+199.129
 EO = -0.067

PT = 7+199.062

PC = 7+228.049

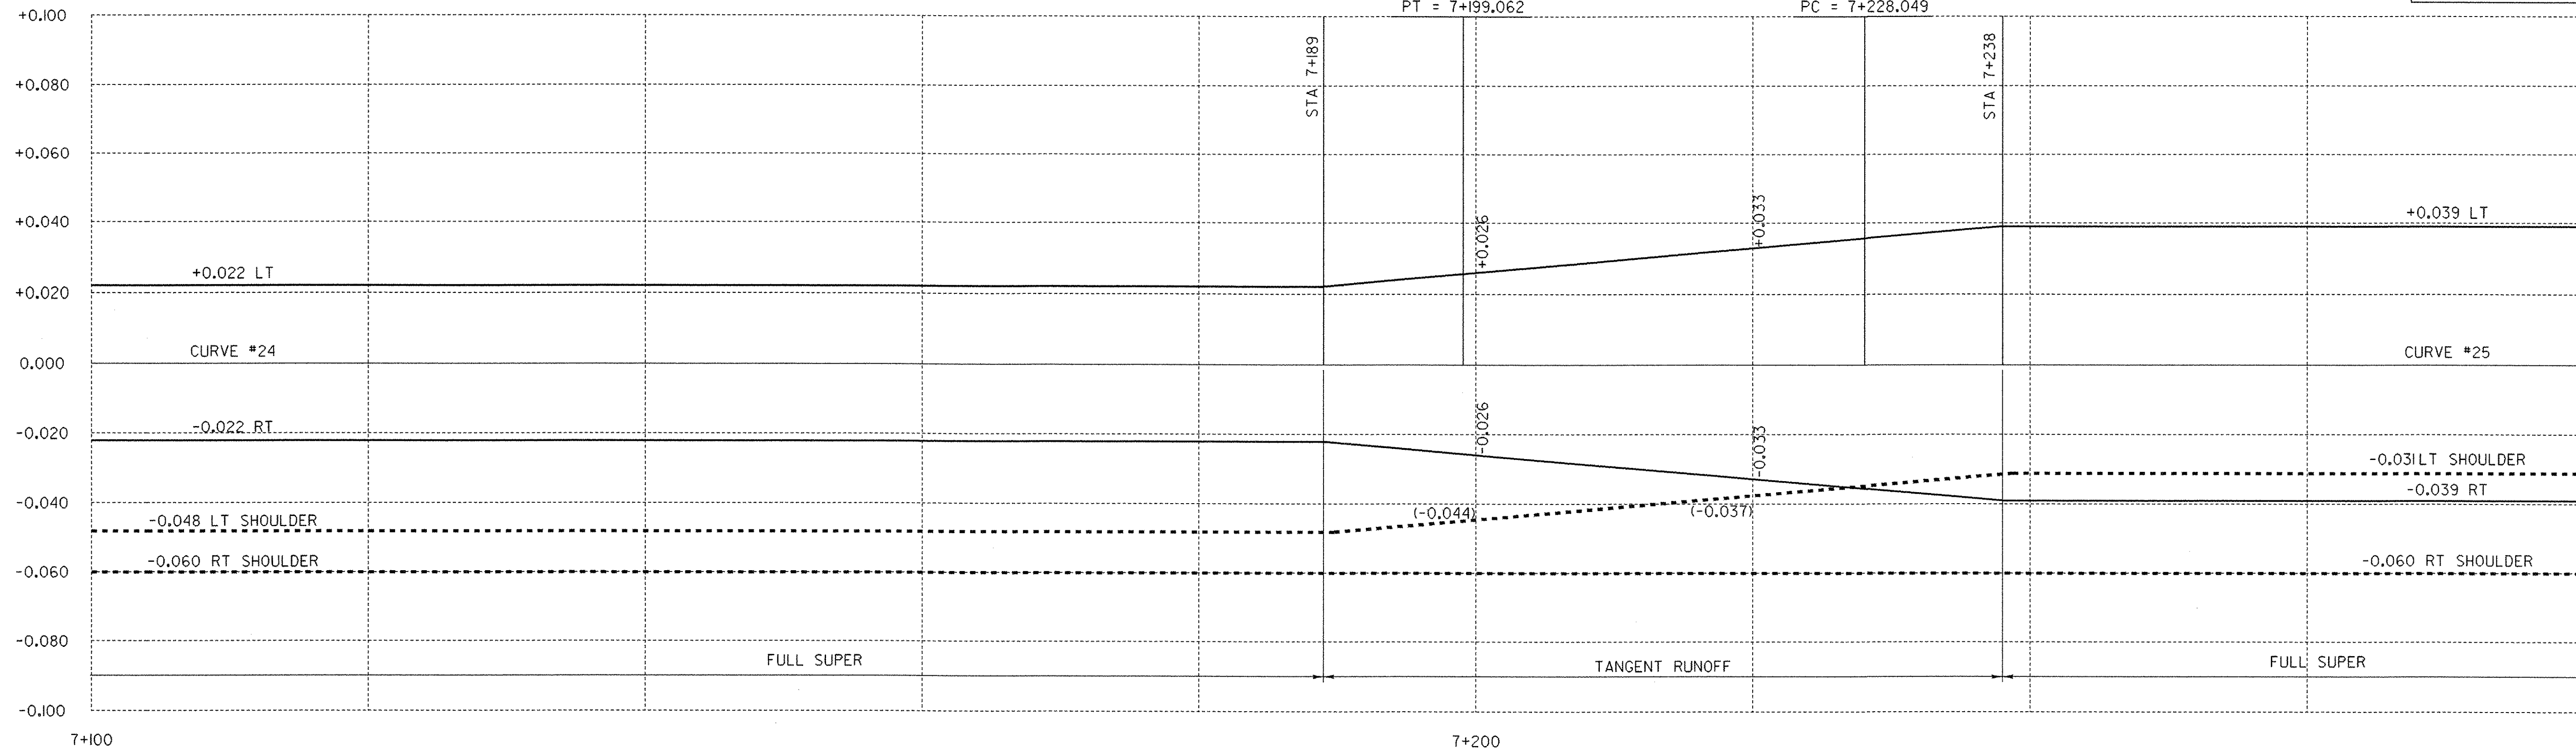

PROJECT NAME: HIGHGATE - FRANKLIN
 PROJECT NUMBER: STP RS 030(I) SA
 FILE NAME: ...85c060/design/dc060xsl.dgn PLOT DATE: 09-MAY-2005
 PROJECT LEADER: DELLASANTA DRAWN BY: SQUAD B
 DESIGNED BY: SQUAD B CHECKED BY: SQUAD B
 IPARM FILE NAME: dc060b18.i SHEET 265 OF 450