
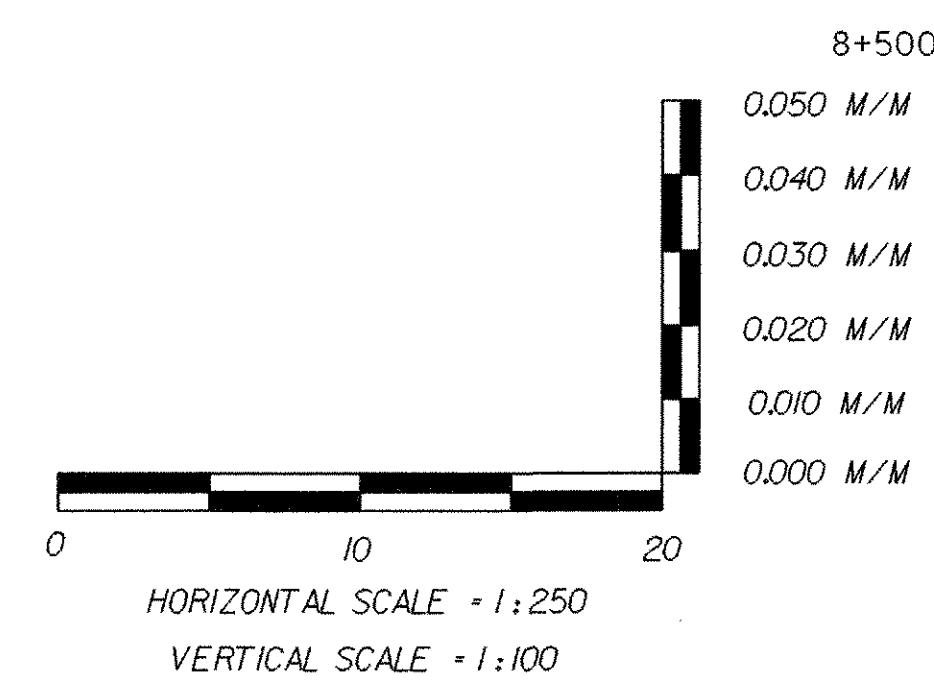
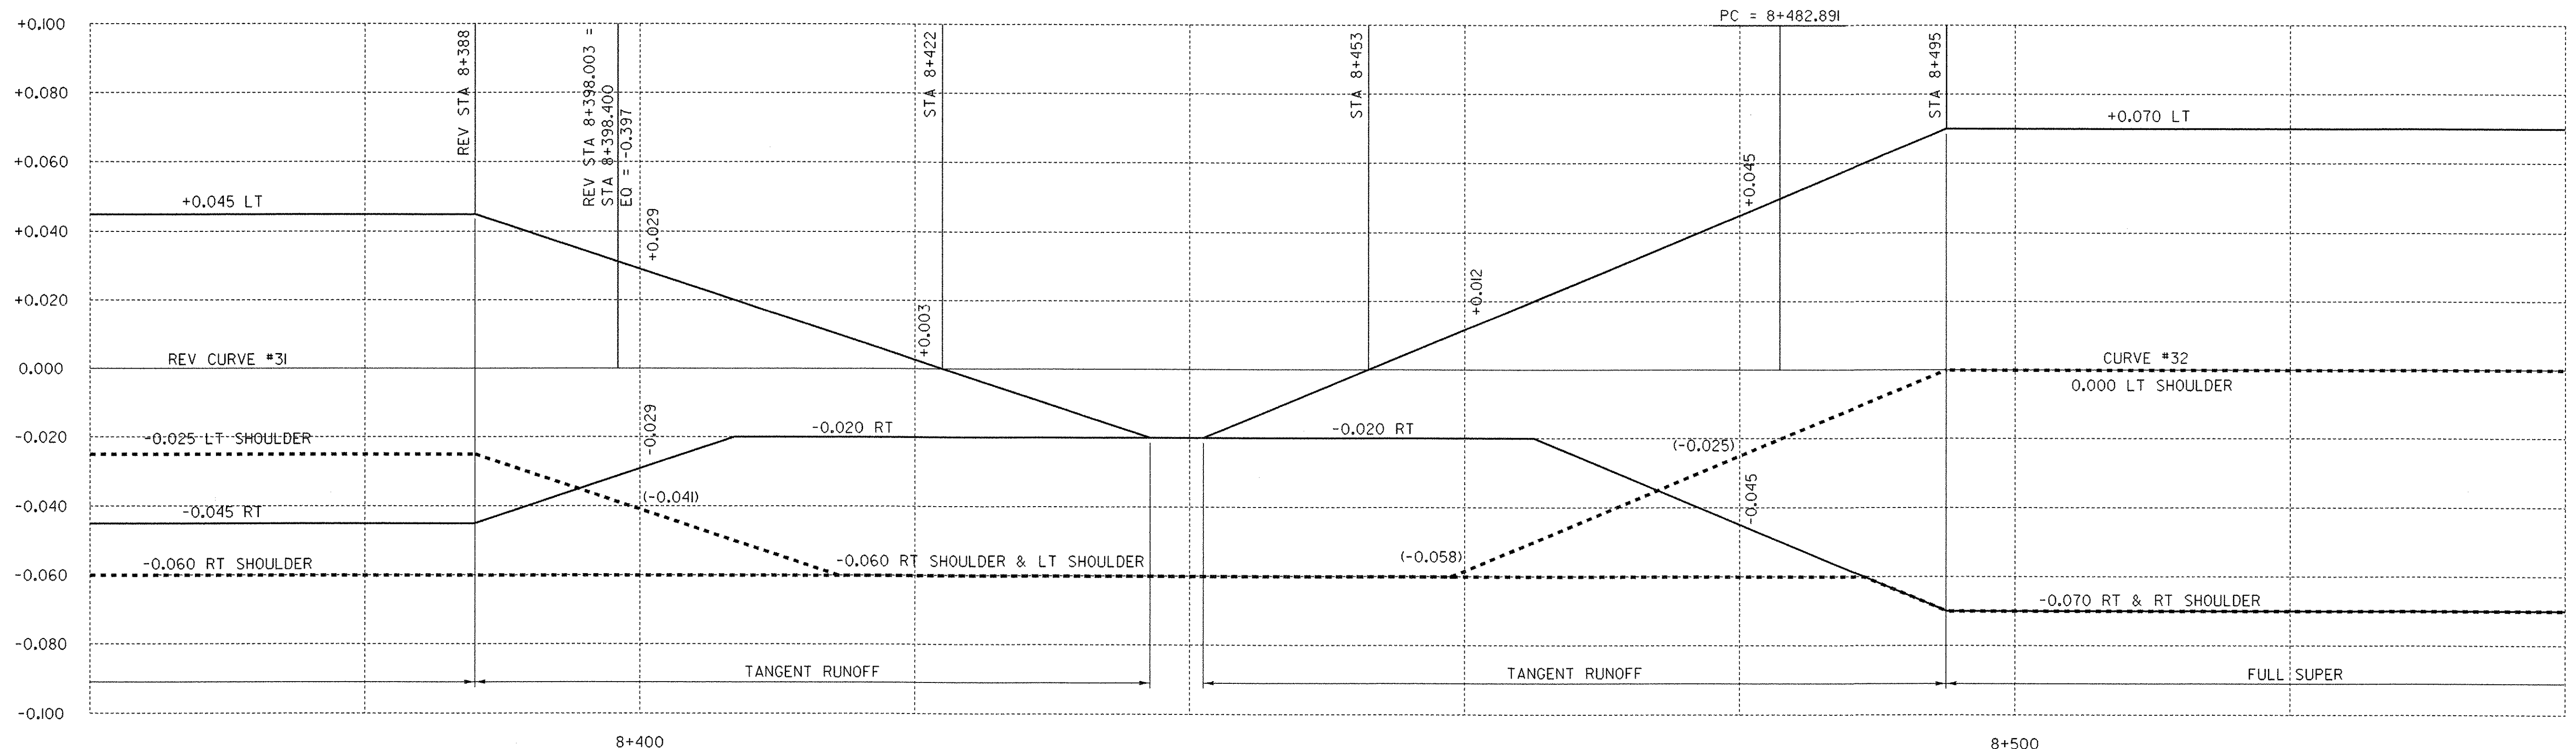


Sta POT 8+254.726 =
 REV PC Sta 8+254.730
 EO = -0.004

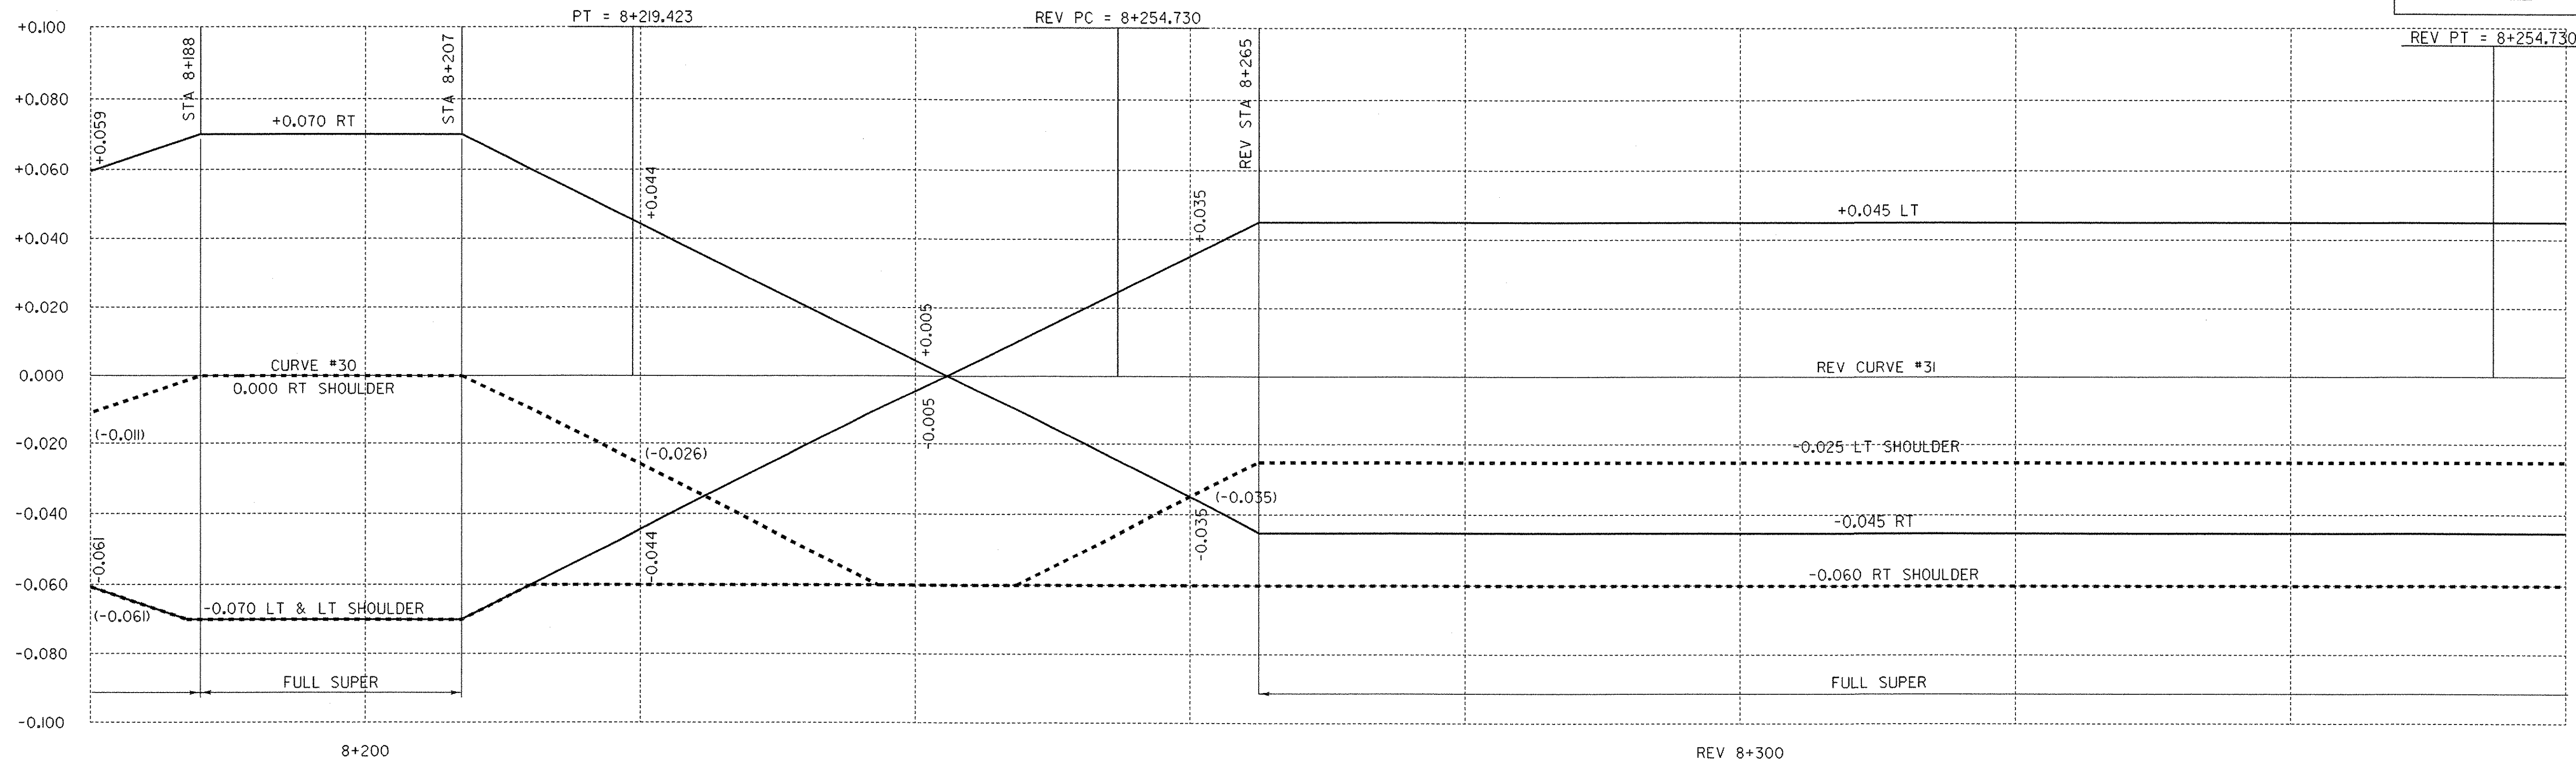

PROJECT NAME:	HIGHGATE - FRANKLIN	PLOT DATE:	09-MAY-2005
PROJECT NUMBER:	STP RS 030(I) SA	DRAWN BY:	SQUAD B
FILE NAME:	...85c060/design/dc060xsl.dgn	CHECKED BY:	SQUAD B
PROJECT LEADER:	DELLASANTA	SHEET	268 OF 450
DESIGNED BY:	SQUAD B		
IPARM FILE NAME:	dc060b21.i		