


I+853
ASKEW = 82° 49' 21" LT

STA I+865.420 END TAPER
STA I+863.620 END FULL DEPTH SAND (450MM) BEGIN TAPER

STA I+847.940 END TAPER BEGIN FULL DEPTH SAND (450MM)
STA I+846.100 BEGIN TAPER

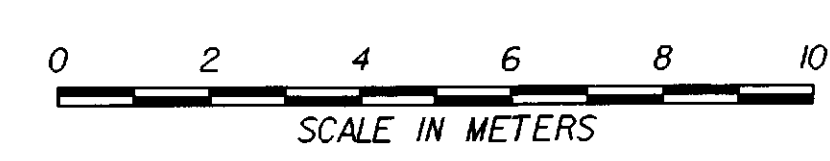

PROJECT NAME:	HIGHGATE - FRANKLIN
PROJECT NUMBER:	STP RS 030I(I) SA
FILE NAME:	...85c060\design\dc060x03.dgn
PLOT DATE:	09-MAY-2005
PROJECT LEADER:	DELLASANTA
DRAWN BY:	SQUAD B
DESIGNED BY:	SQUAD B
CHECKED BY:	SQUAD B
IPARM FILE NAME:	dc060x0314.1
SHEET	300 OF 450