
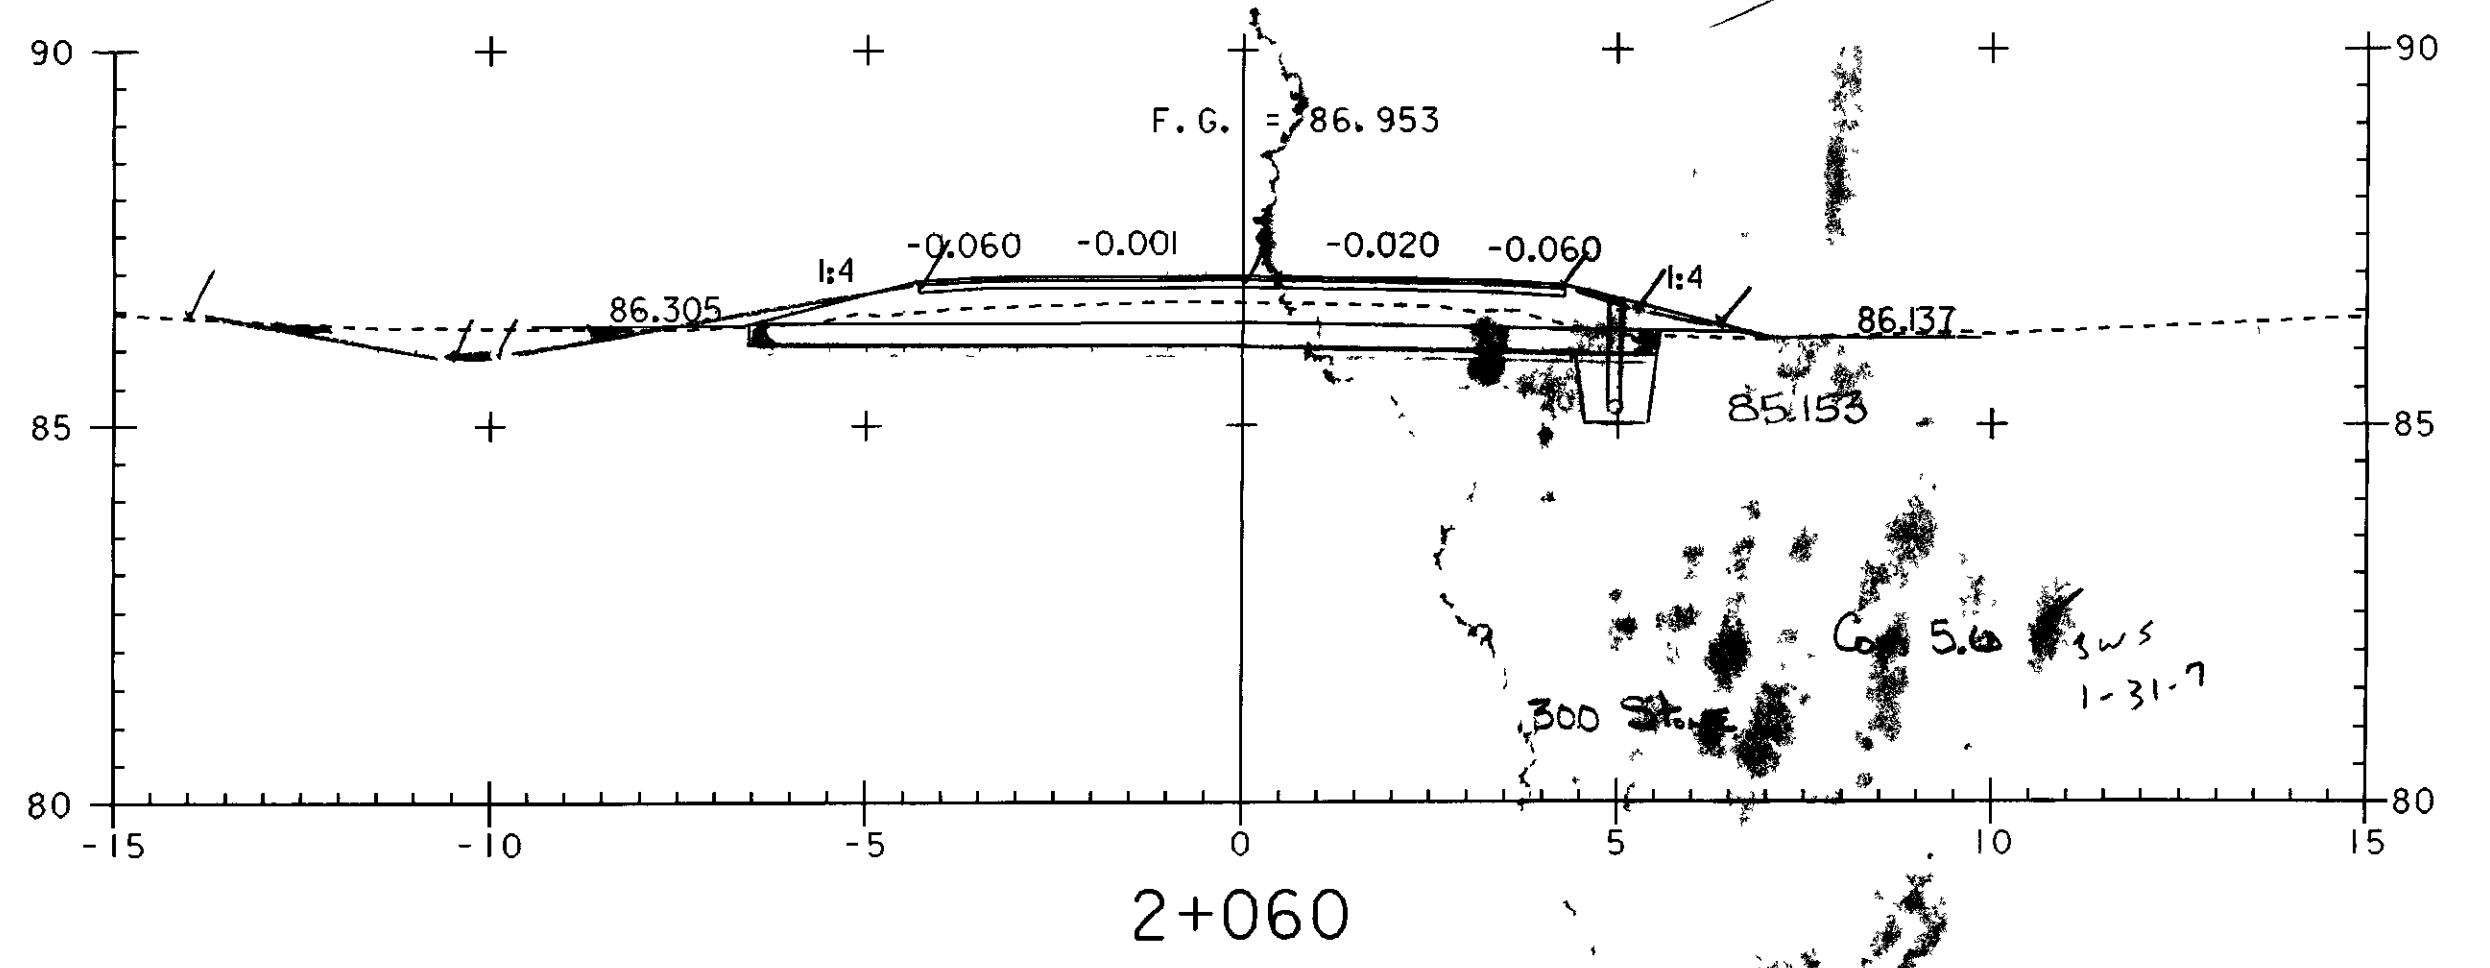
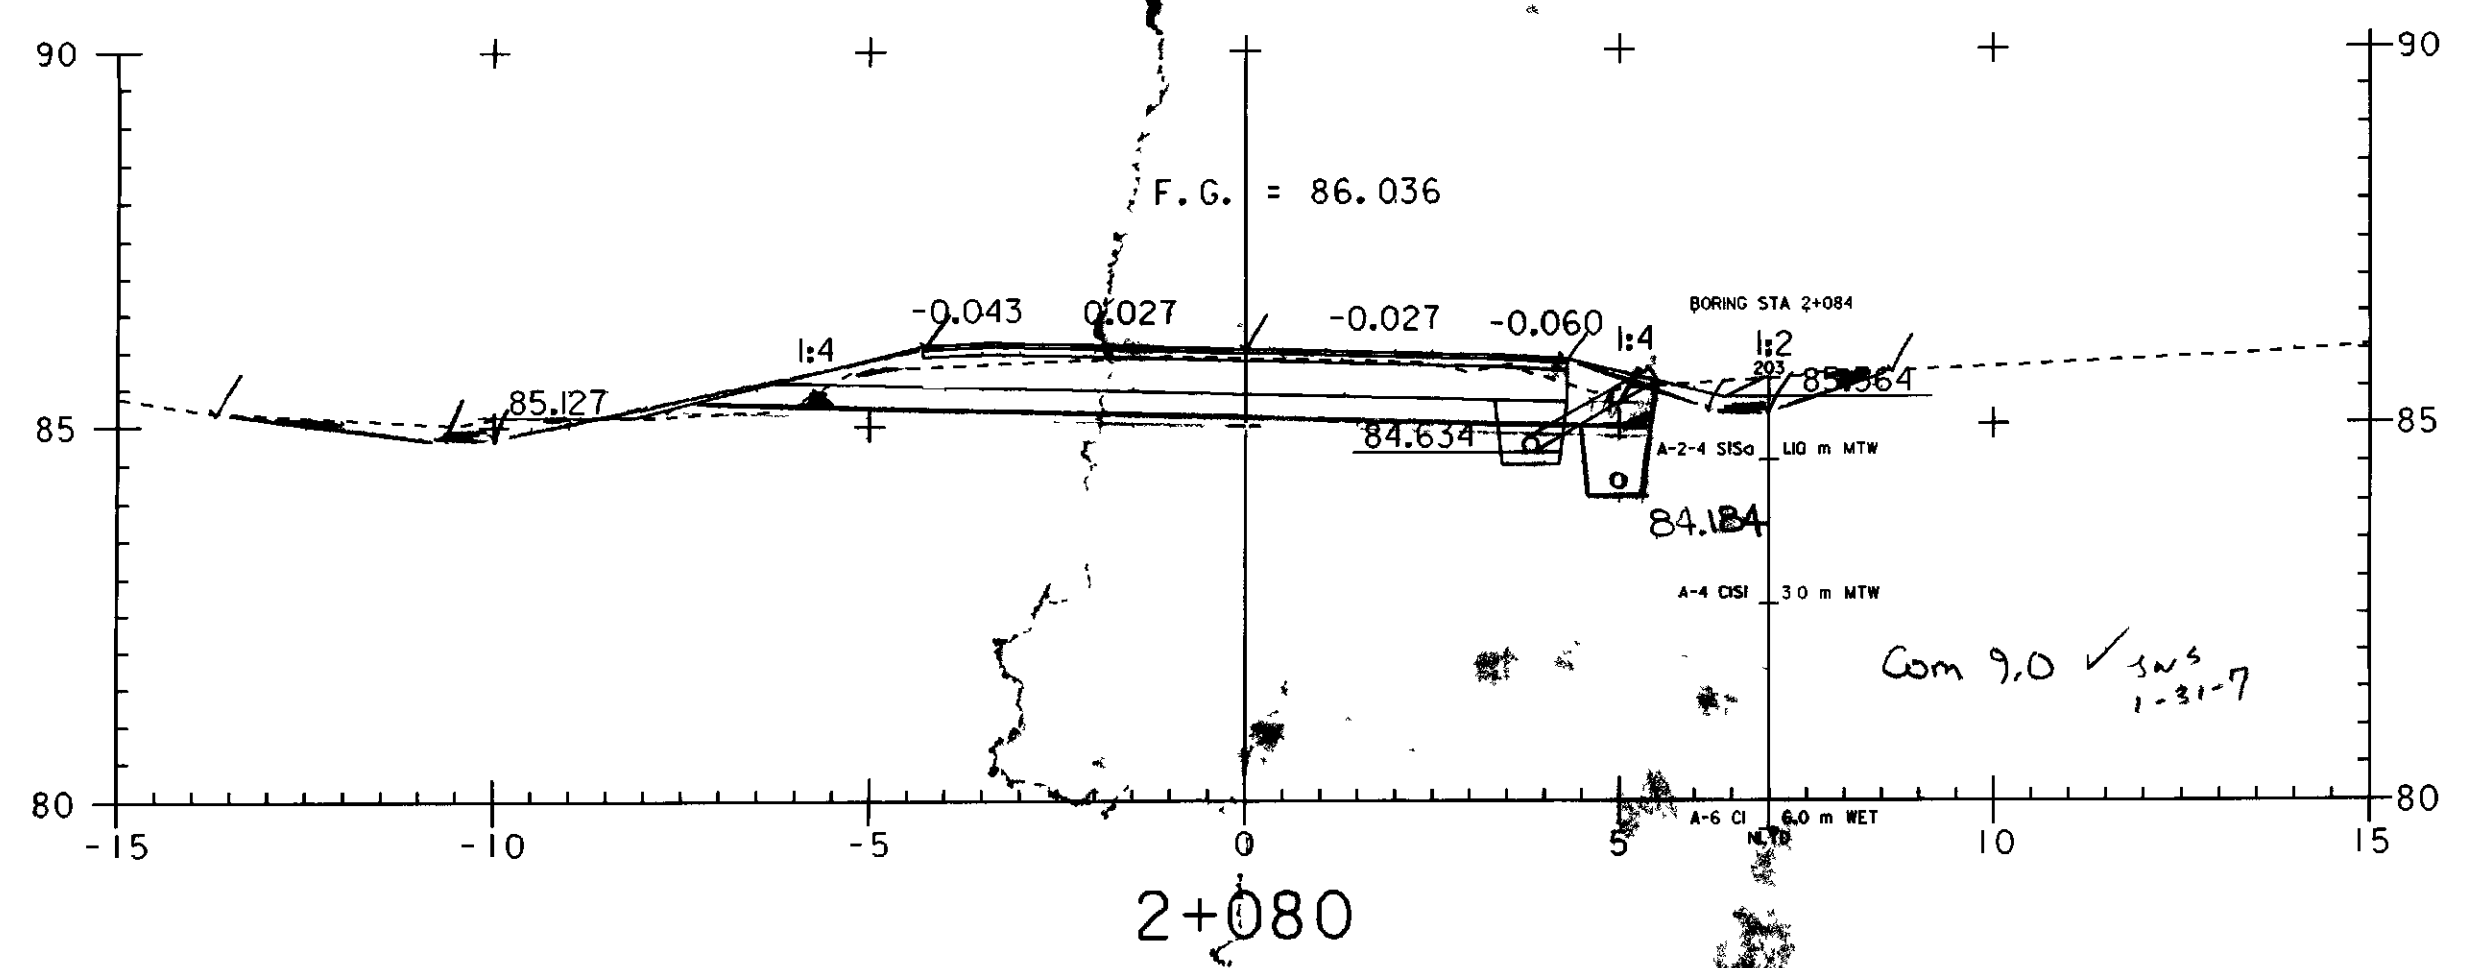


STA 2+036.440 END TAPER
STA 2+034.780 END FULL DEPTH SAND (450MM) BEGIN TAPER

STA 2+015.240 END TAPER BEGIN FULL DEPTH SAND (450MM)
STA 2+013.420 BEGIN TAPER

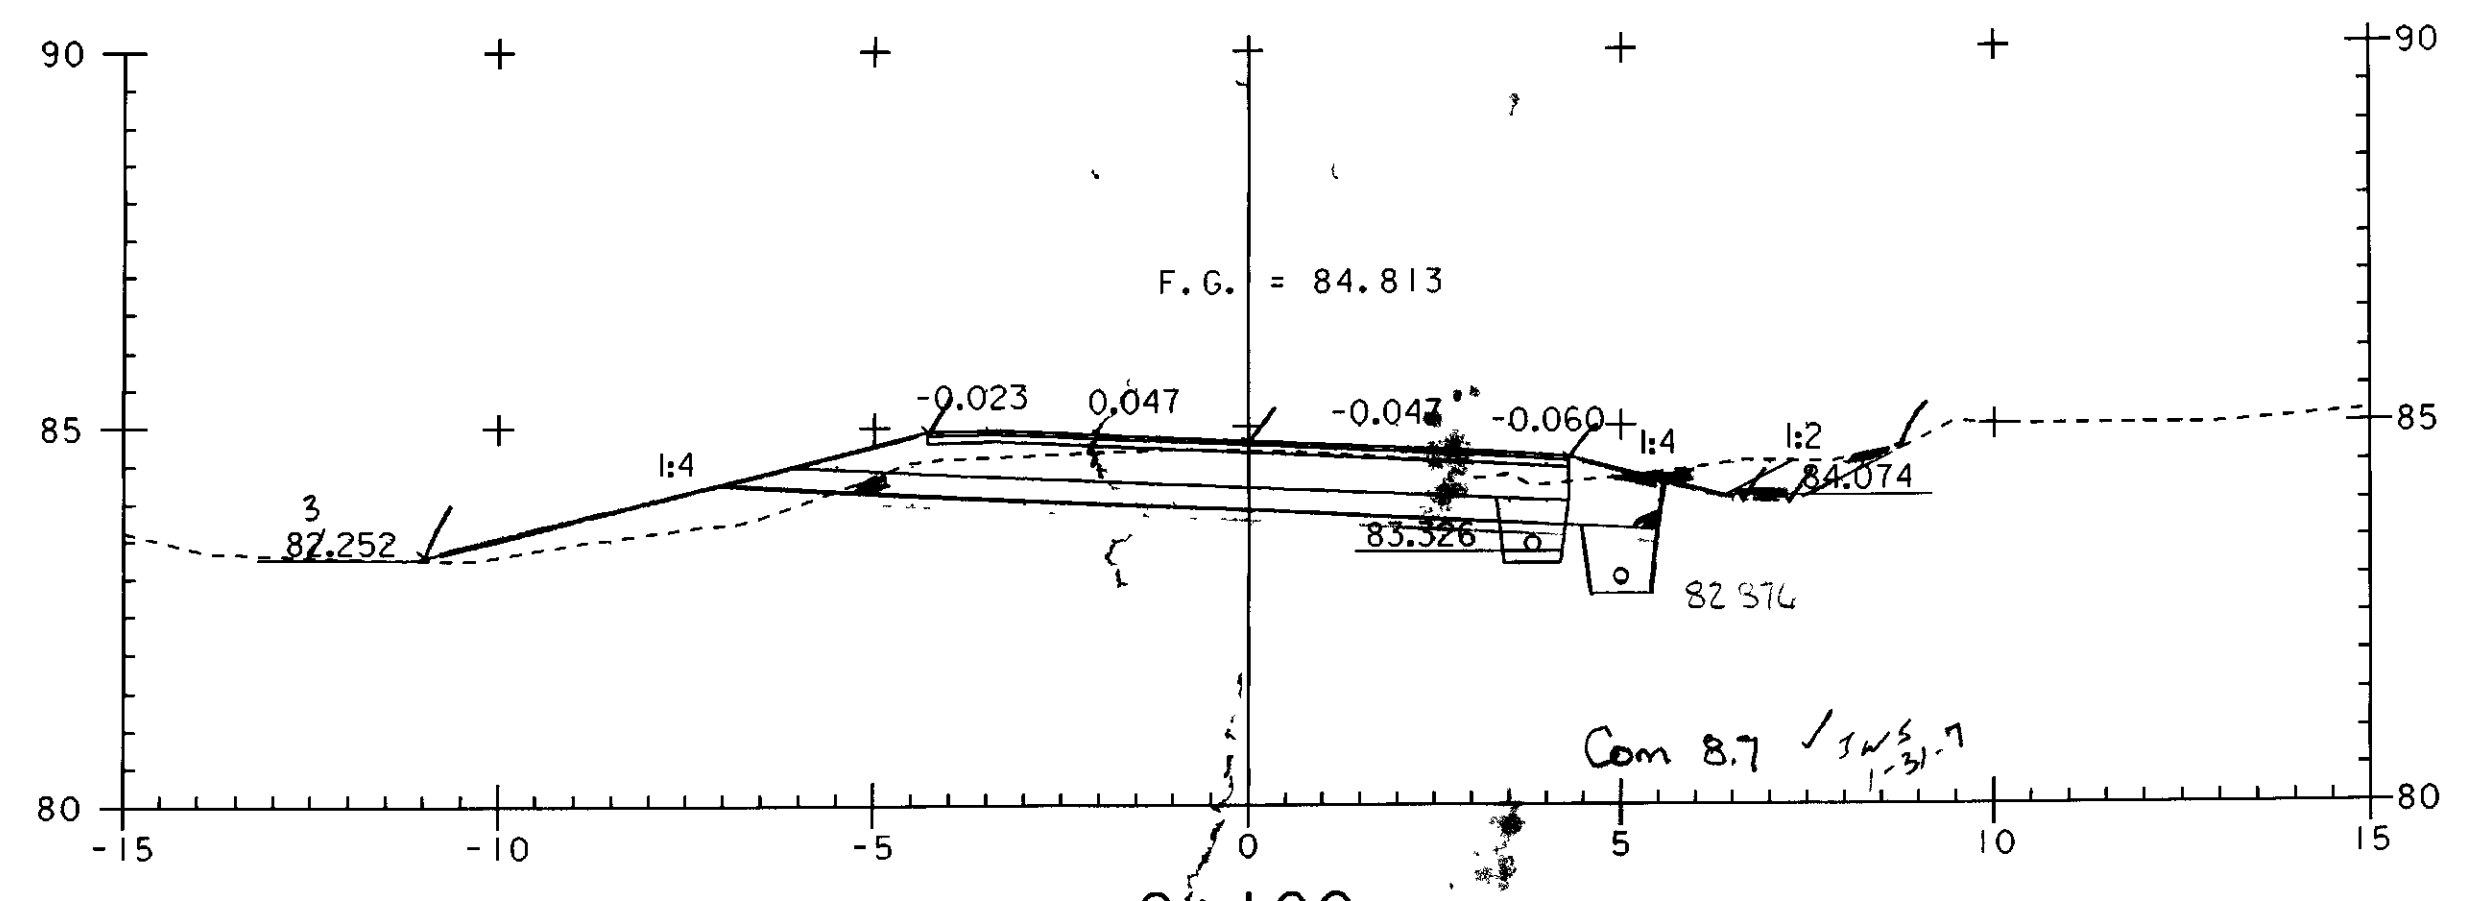

PROJECT NAME:	HIGHGATE - FRANKLIN	PLOT DATE:	09-MAY-2005
PROJECT NUMBER:	STP RS 030(I) SA	DRAWN BY:	SQUAD B
FILE NAME:	...85c060\desig\dc060x04.dgn	CHECKED BY:	SQUAD B
PROJECT LEADER:	DELLASANTA	SHEET	303 OF 450
DESIGNED BY:	SQUAD B		
IPARM FILE NAME:	dc060x04.I		