


$\frac{2.2}{1.31} = 1.68$

$\frac{2.30}{1.31} = 1.76$

3+592 Lt # 3+591 Ct  
TB =

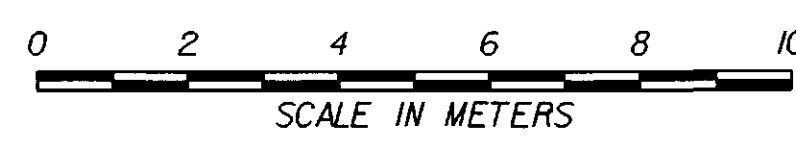

PROJECT NAME:	HIGHGATE - FRANKLIN	PLOT DATE:	09-MAY-2005
PROJECT NUMBER:	STP RS 030(I) SA	DRAWN BY:	SQUAD B
FILE NAME:	...85c060\design\dc060x05.dgn	CHECKED BY:	SQUAD B
DESIGNED BY:	SQUAD B	SHEET	328 OF 450
IPARM FILE NAME:	dc060x059.i		