

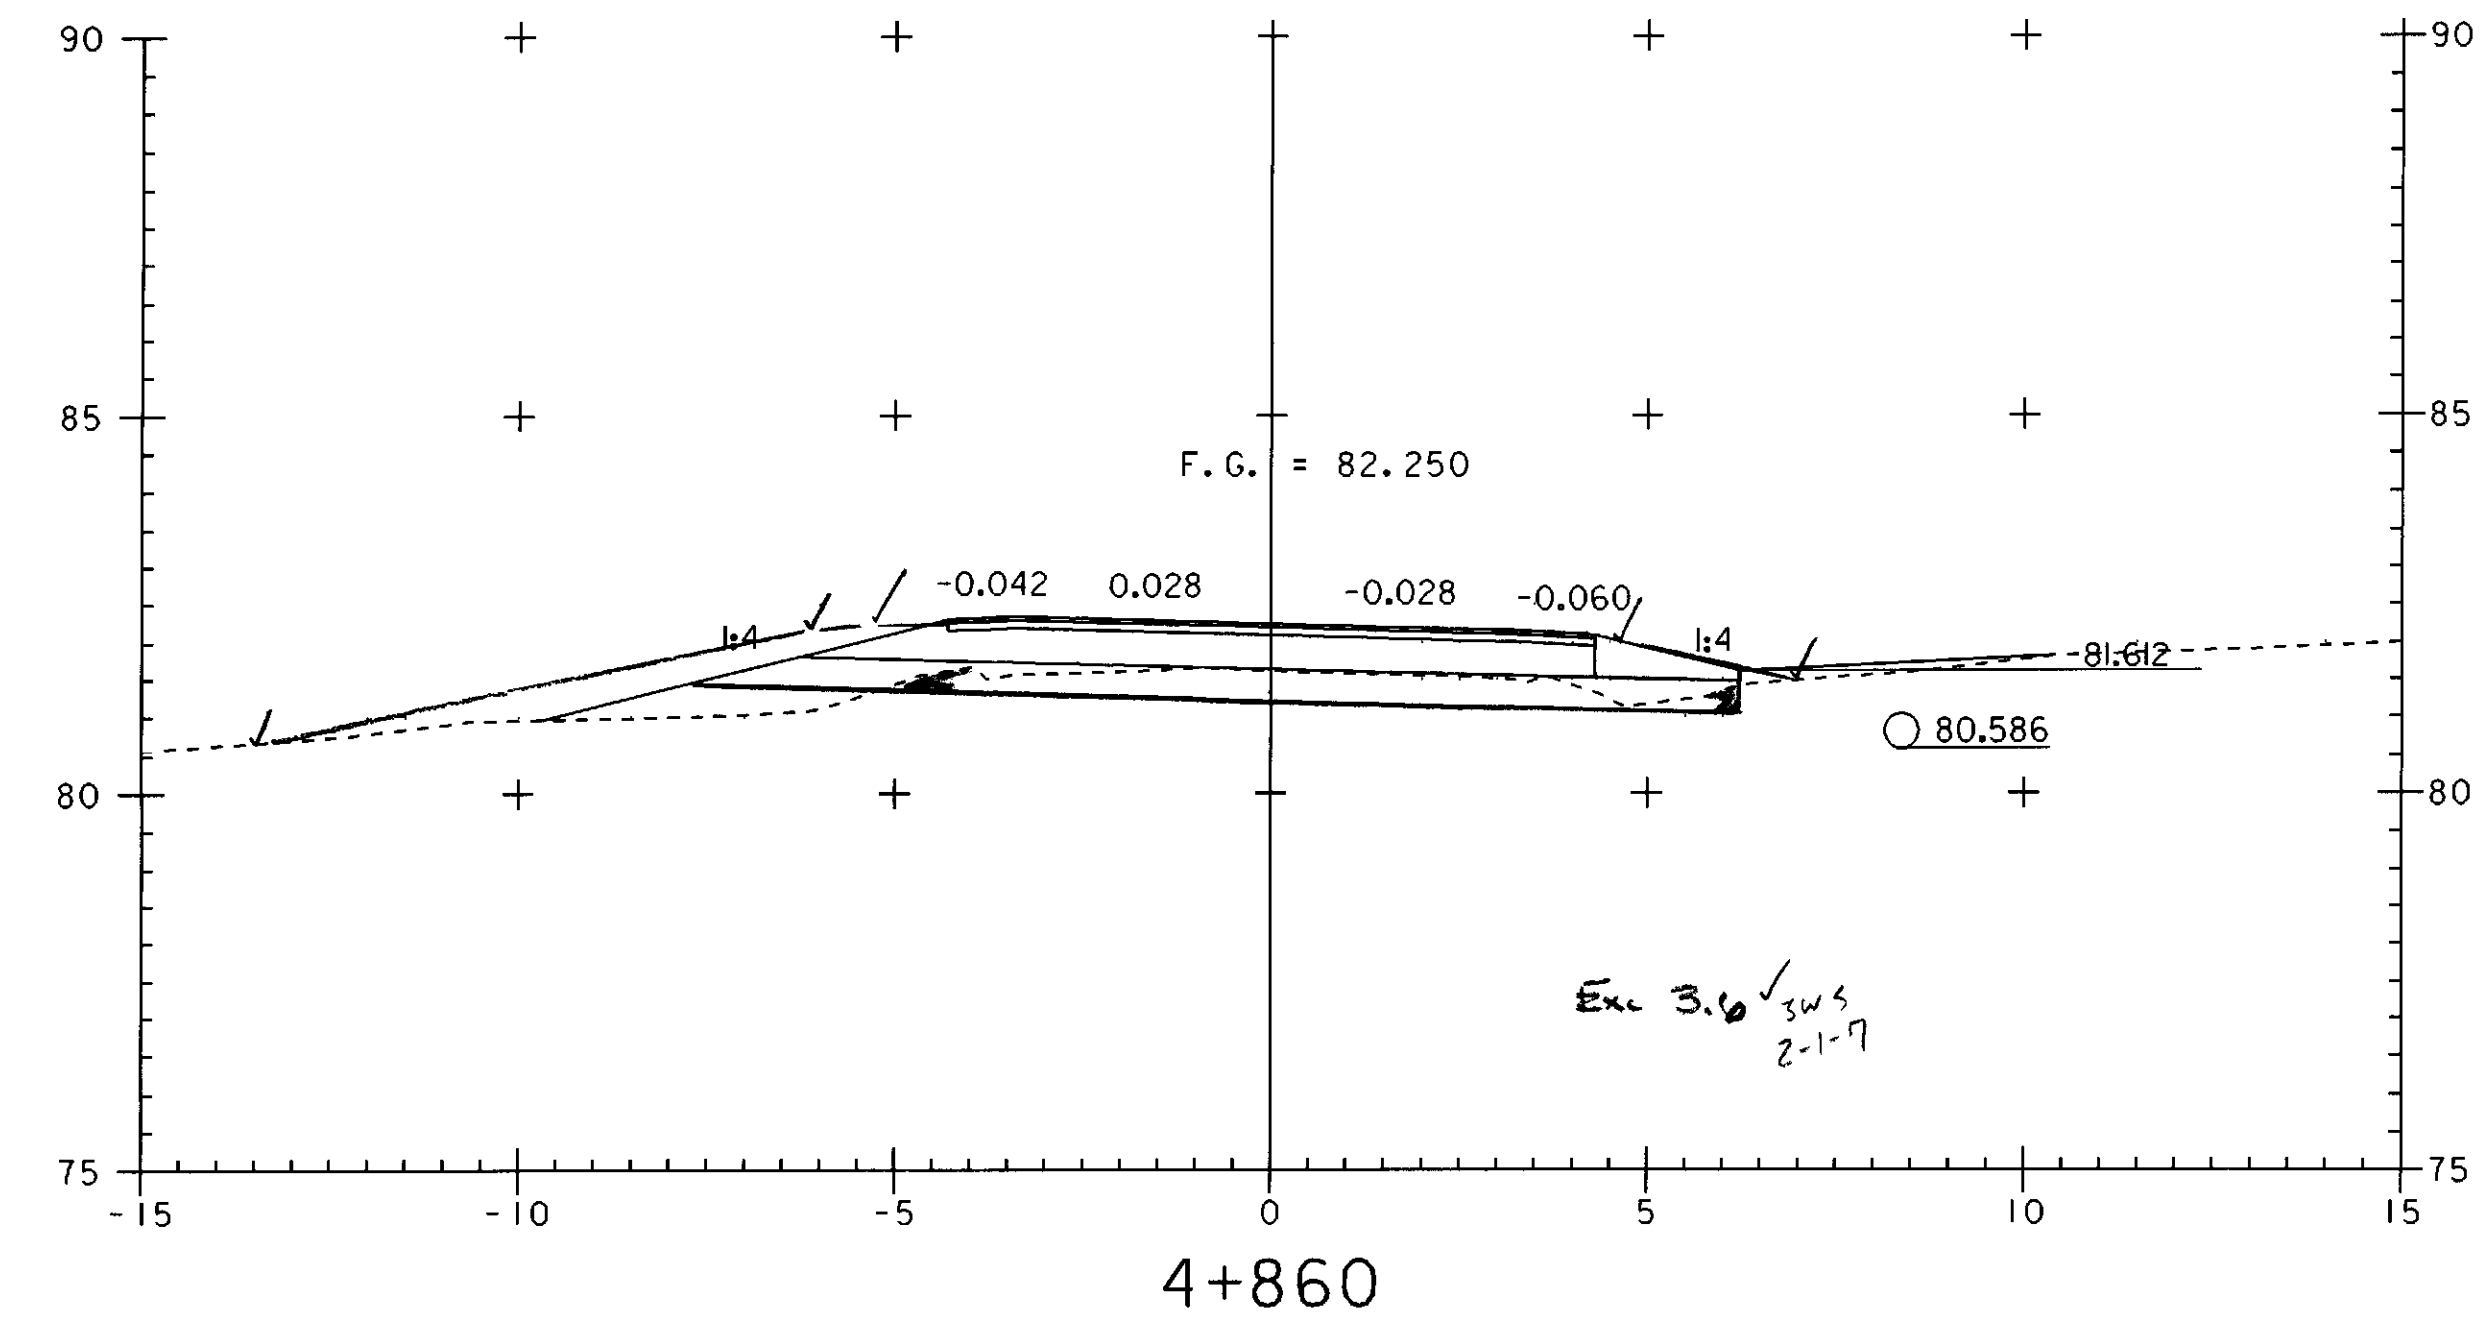
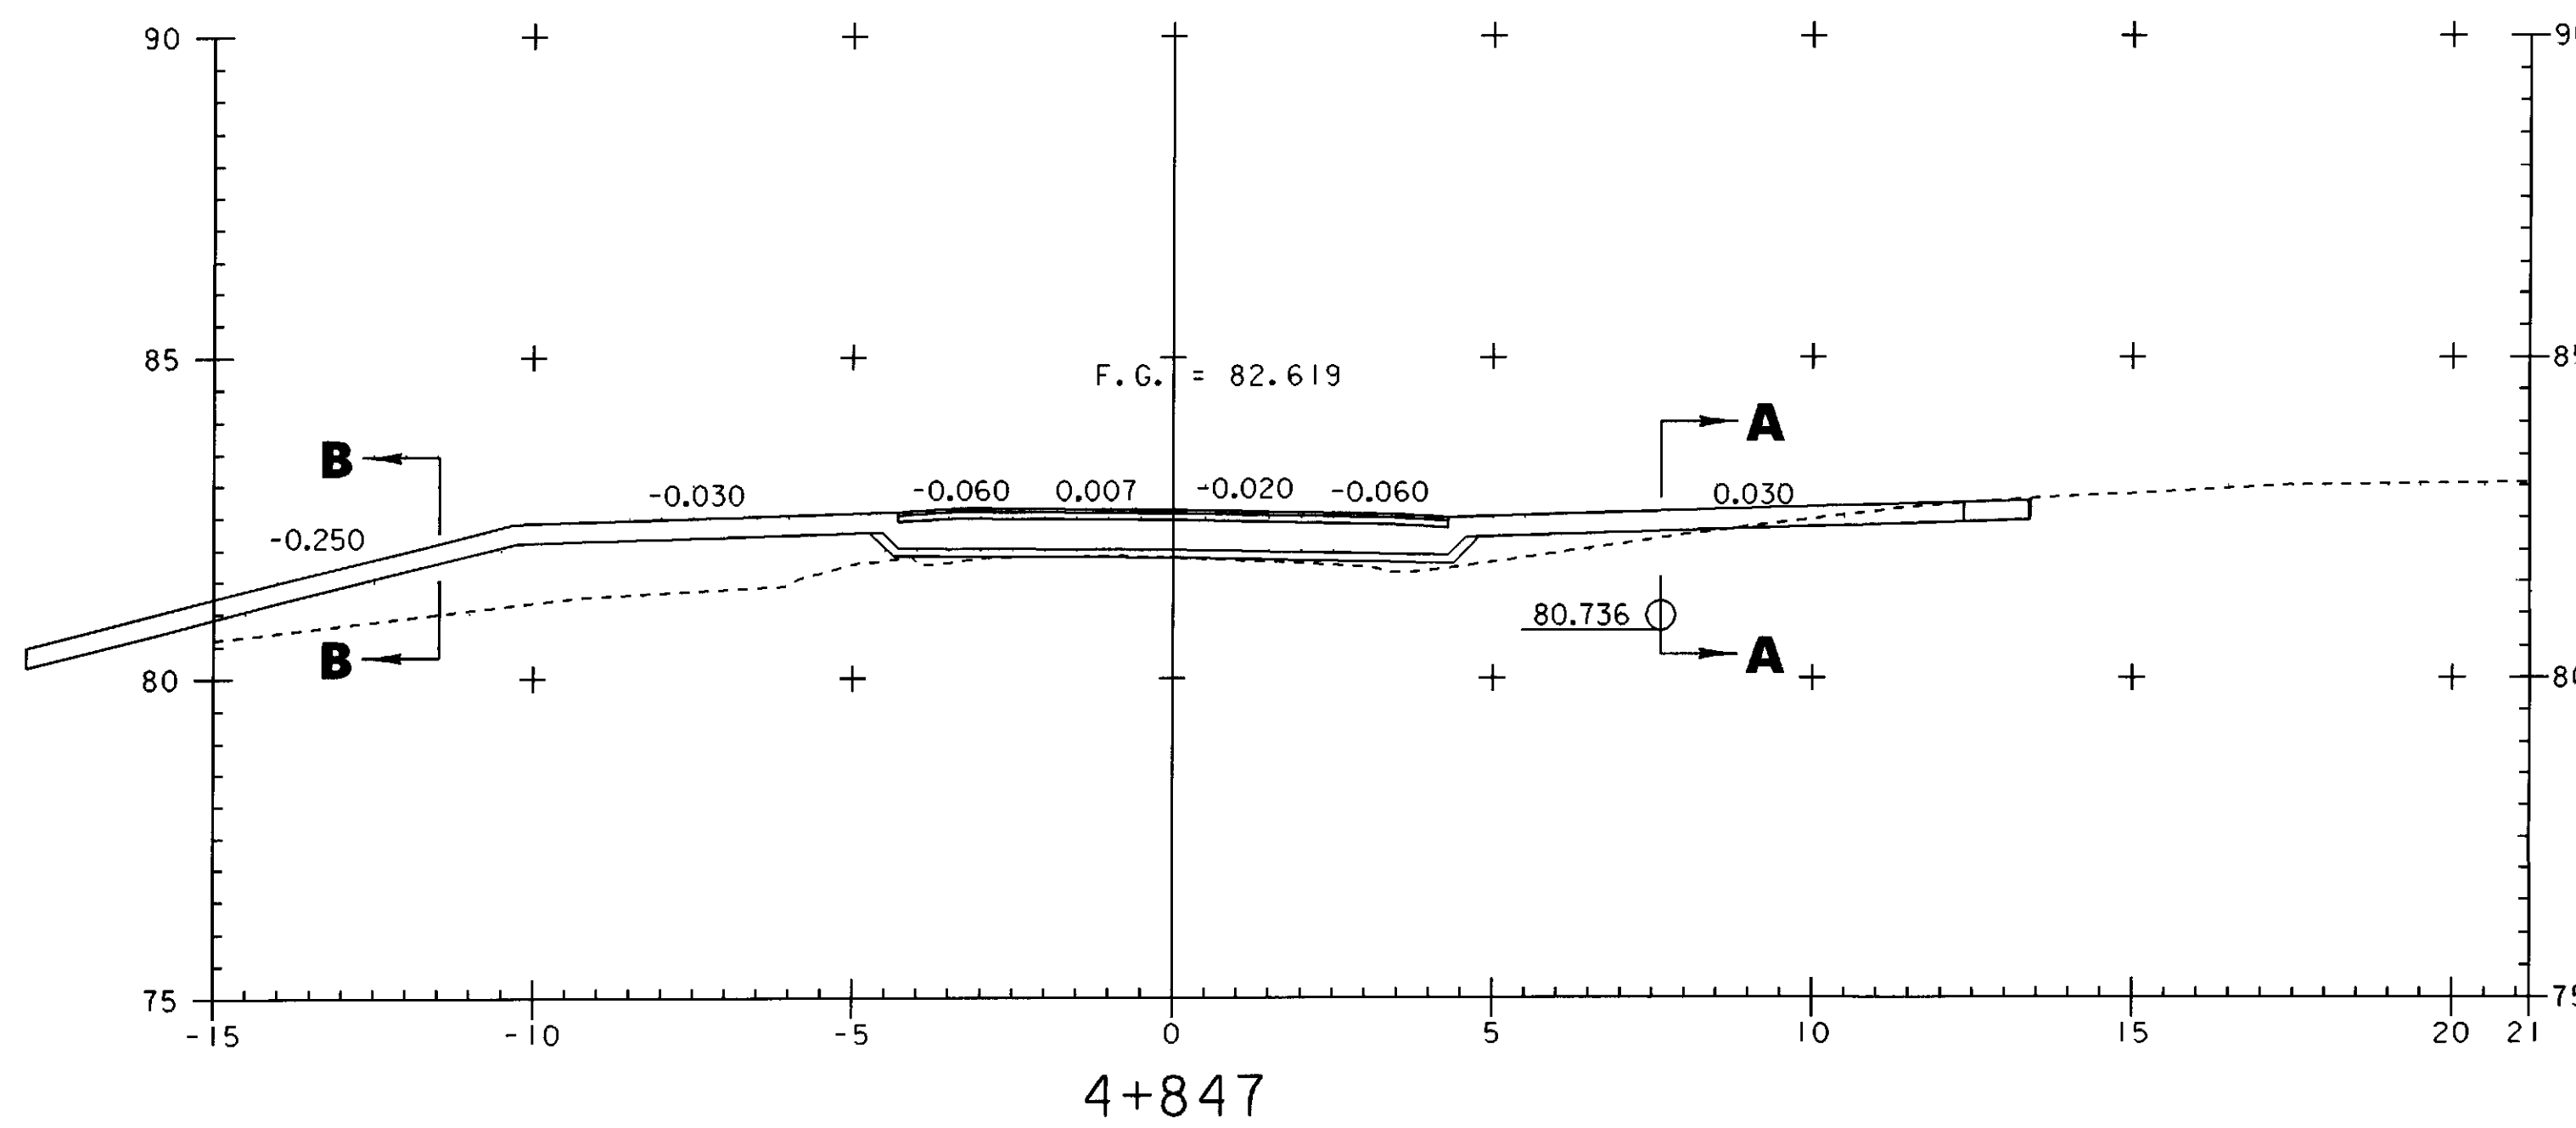



STA 4+847.570 END TAPER

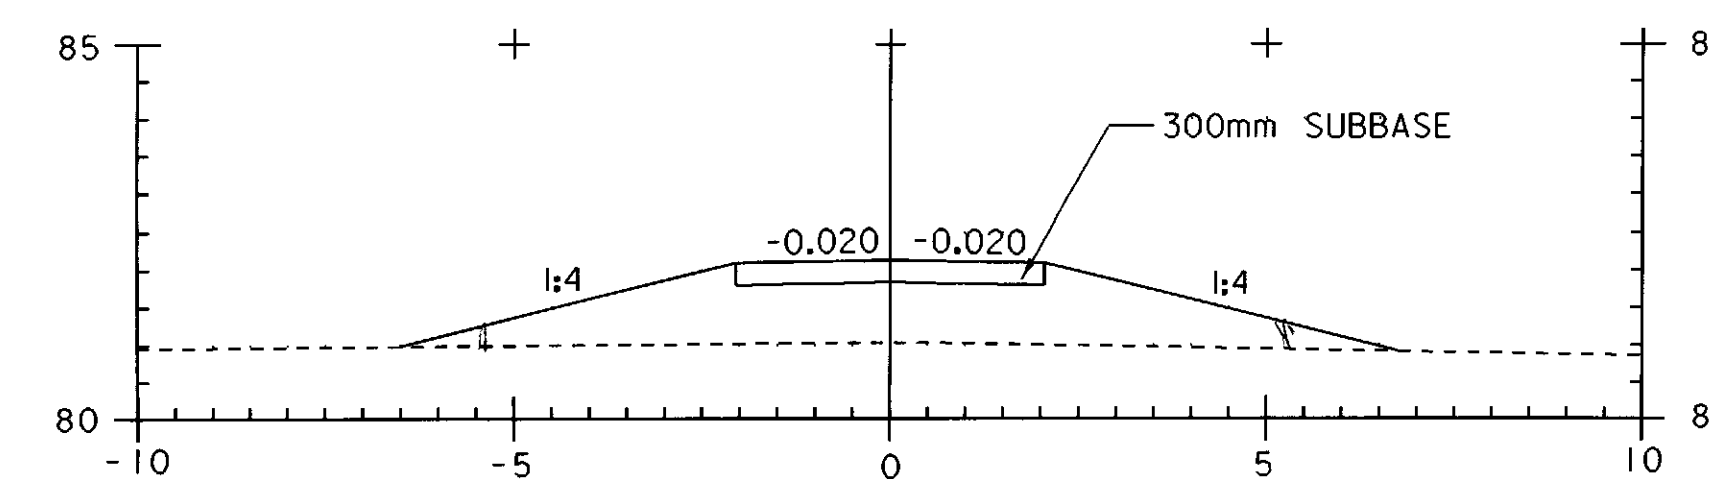

STA 4+845.980 END FULL DEPTH SAND (450MM) BEGIN TAPER

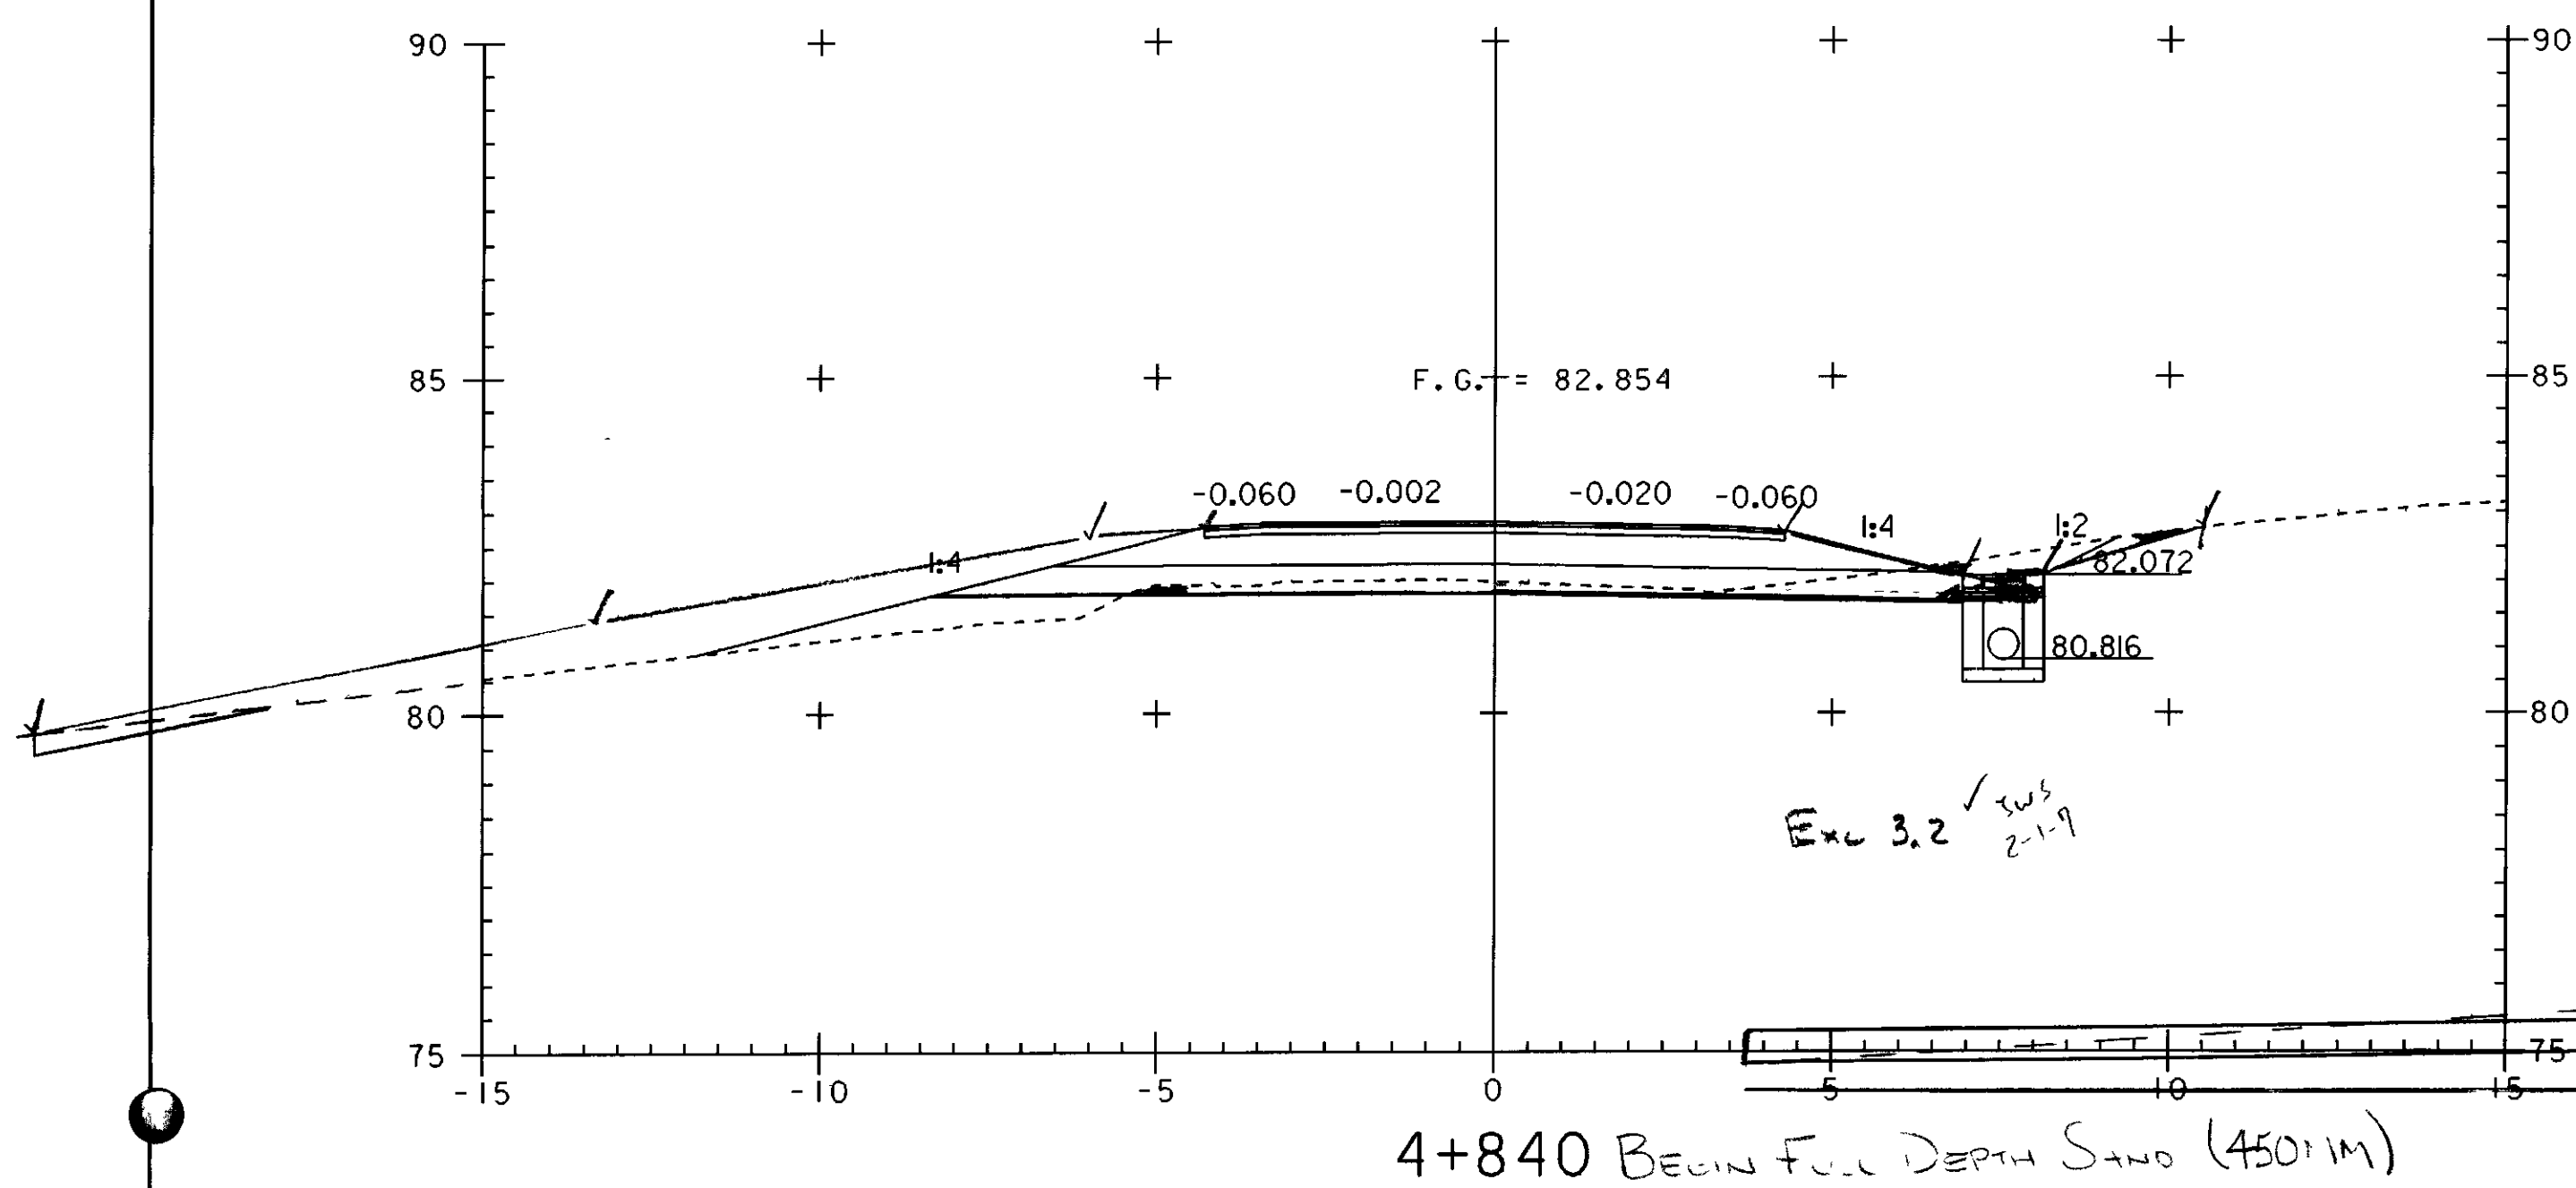

DRIVE AT 4+847 LT
B - B

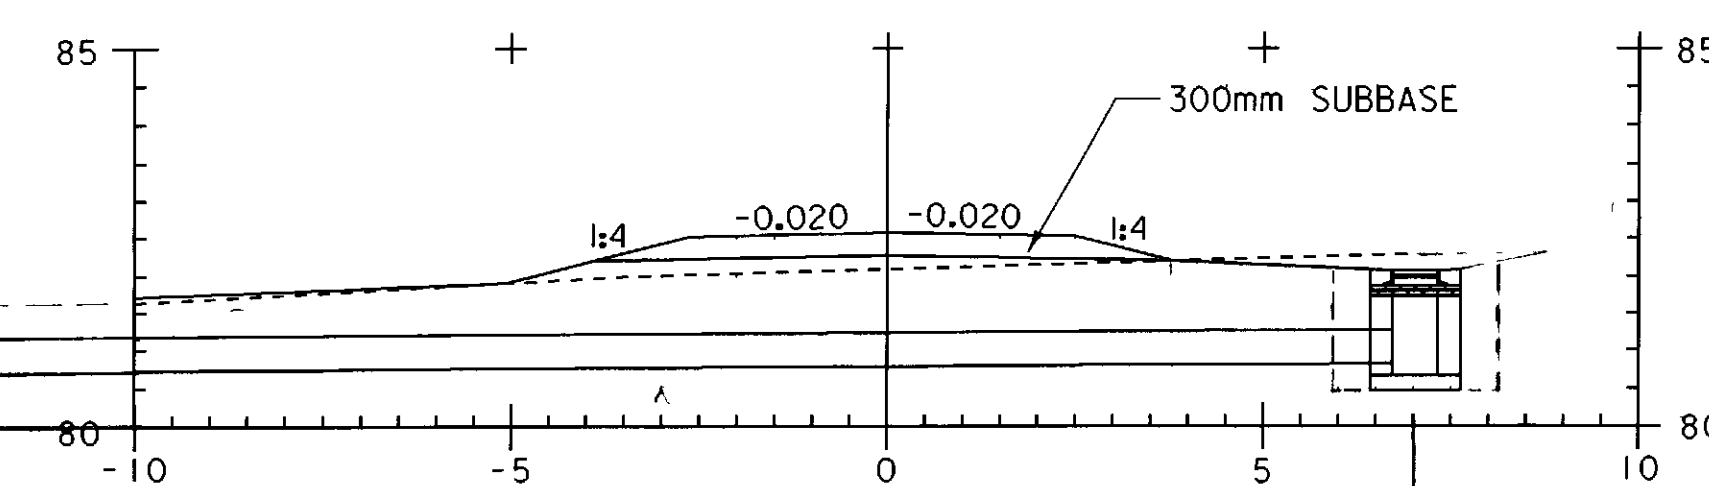

DRIVE AT 4+847 RT
A - A



PROJECT NAME:	HIGHGATE - FRANKLIN
PROJECT NUMBER:	STP RS 030(I) SA
FILE NAME:	...85c060\design\dc060x07.dgn
PROJECT LEADER:	DELLASANTA
DESIGNED BY:	SQUAD B
IPARM FILE NAME:	dc060x07.l
PLOT DATE:	09-MAY-2005
DRAWN BY:	SQUAD B
CHECKED BY:	SQUAD B
SHEET	347 OF 450

17
27
38
27