
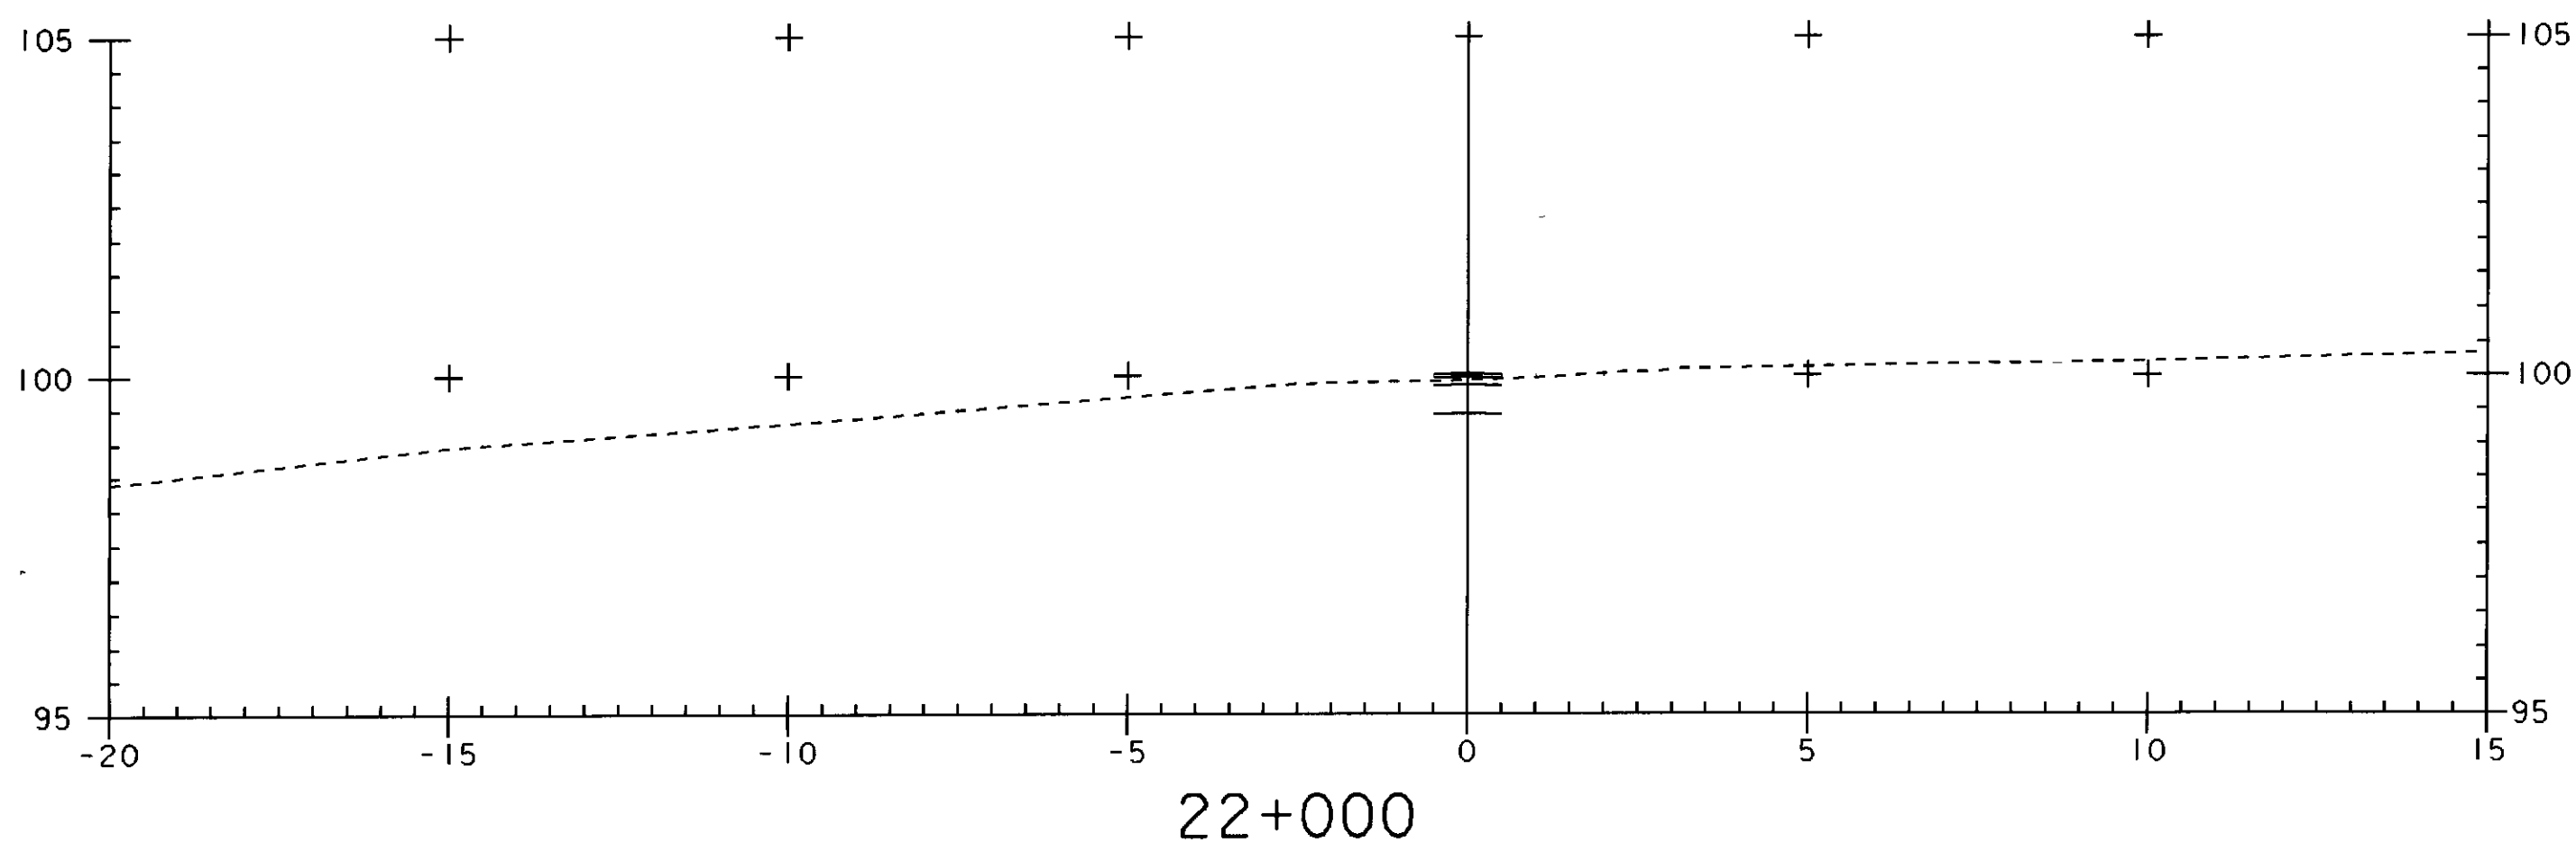
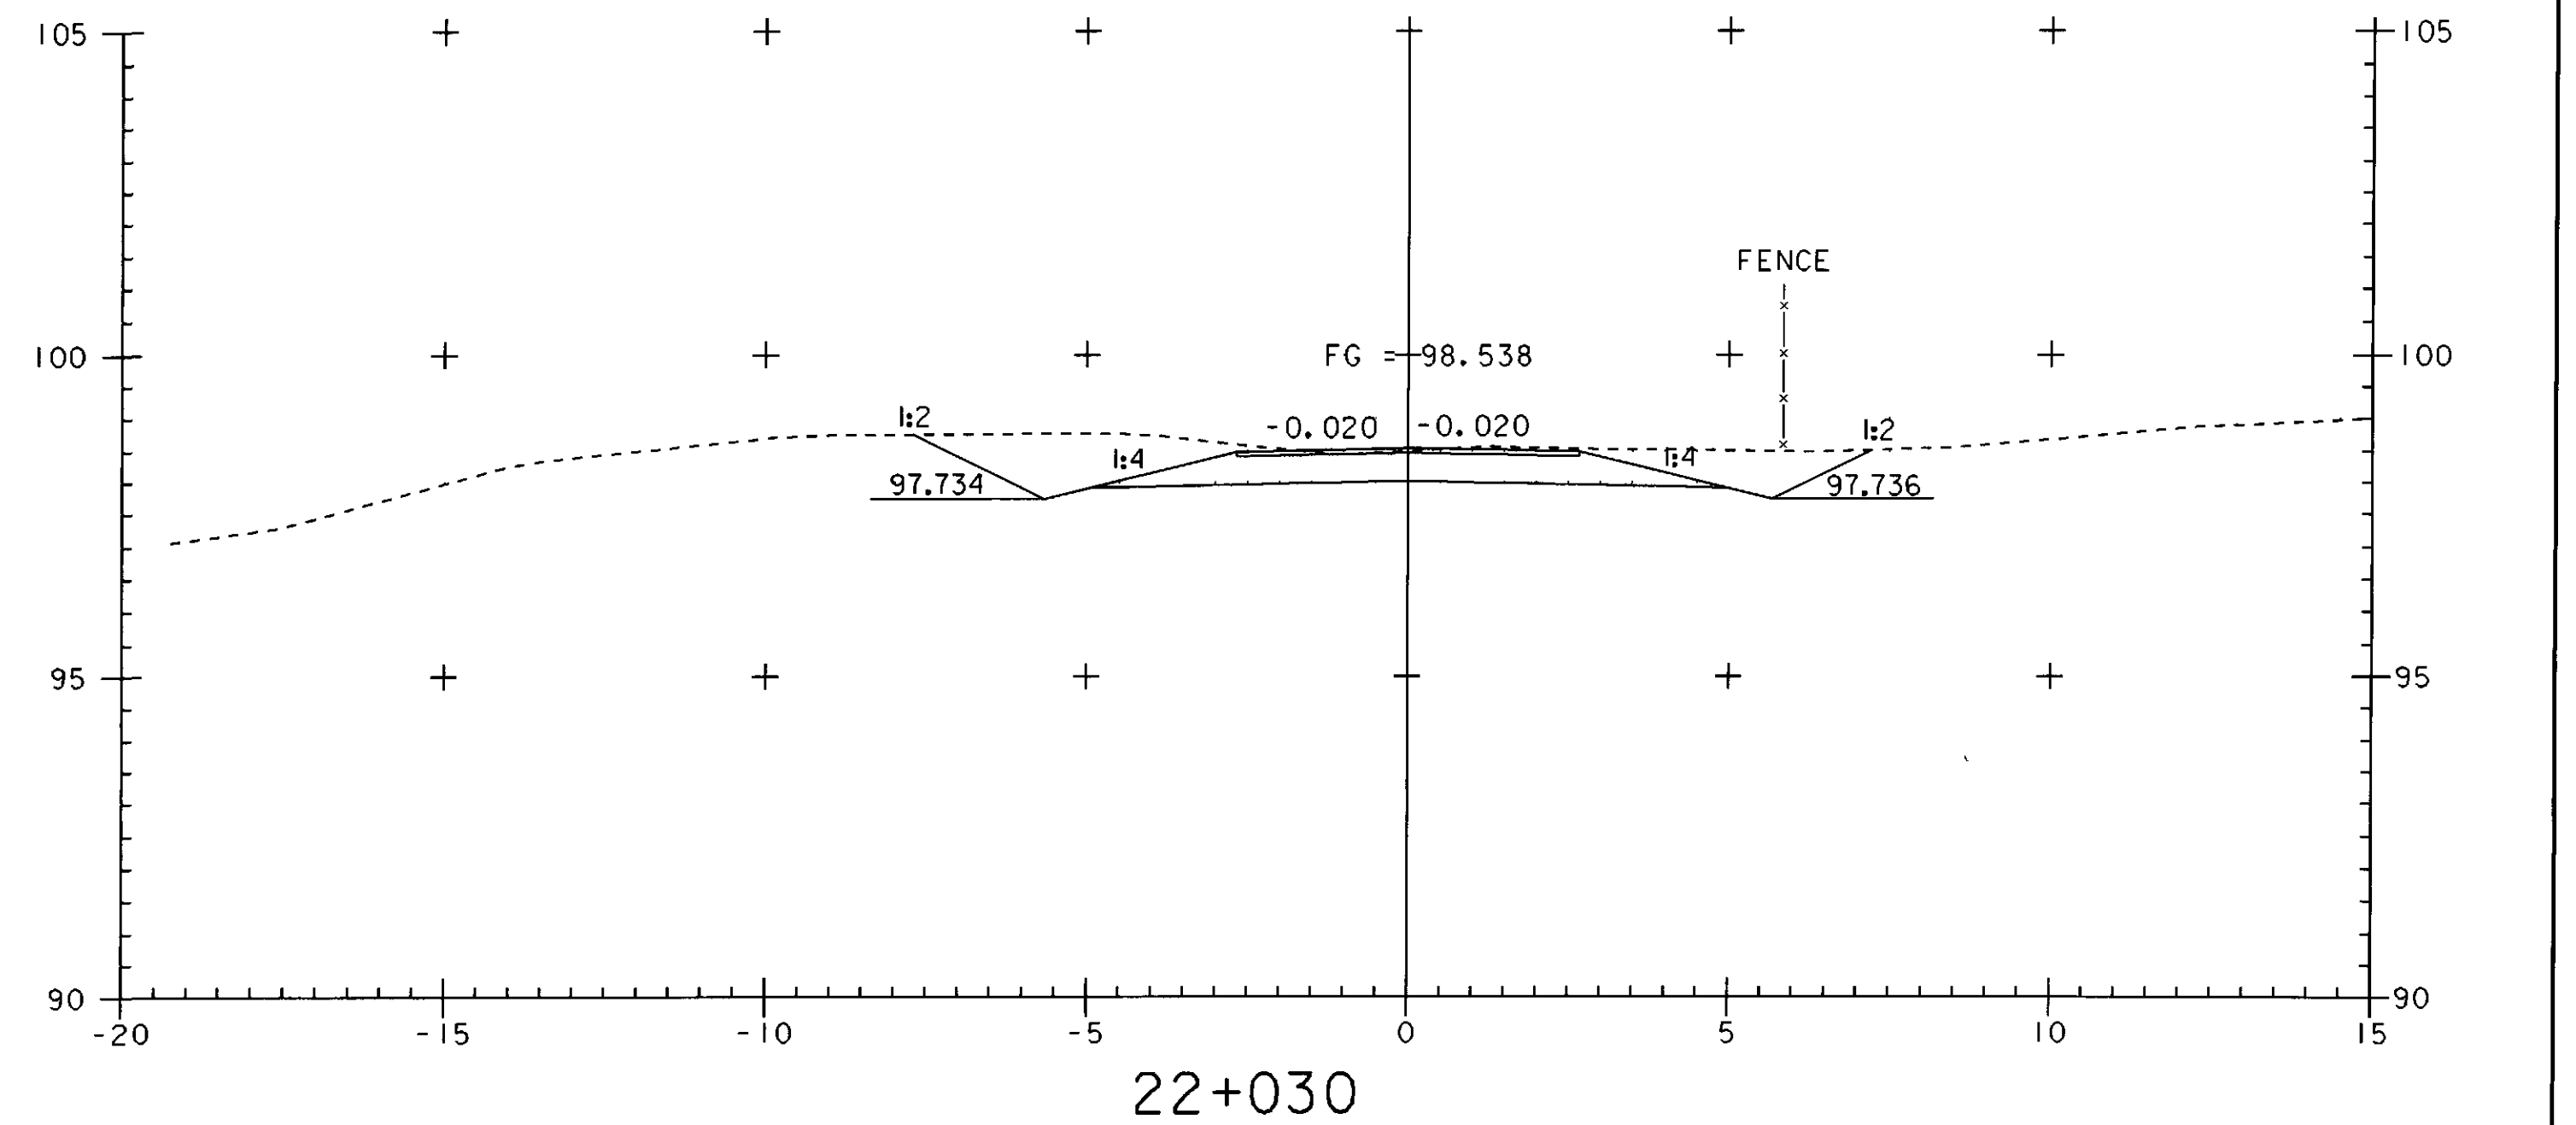
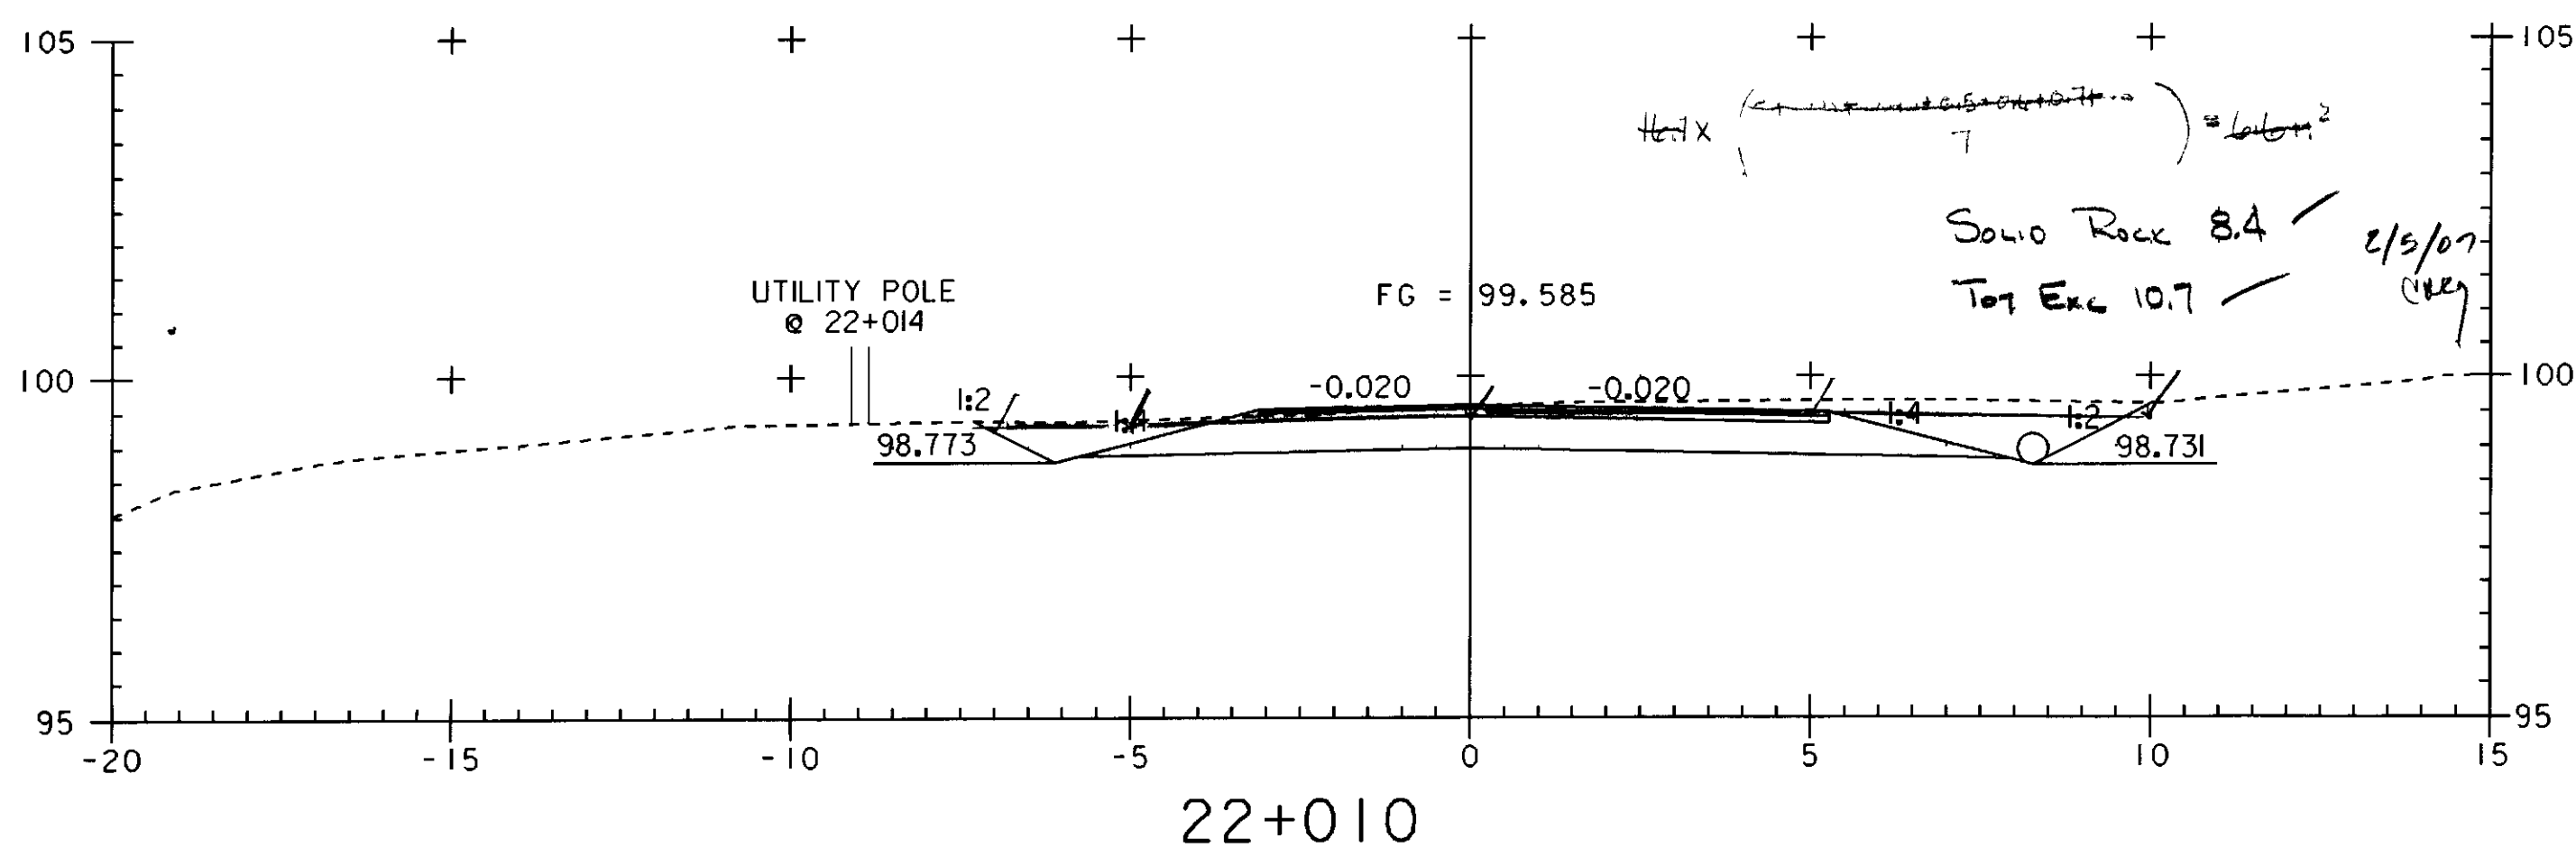
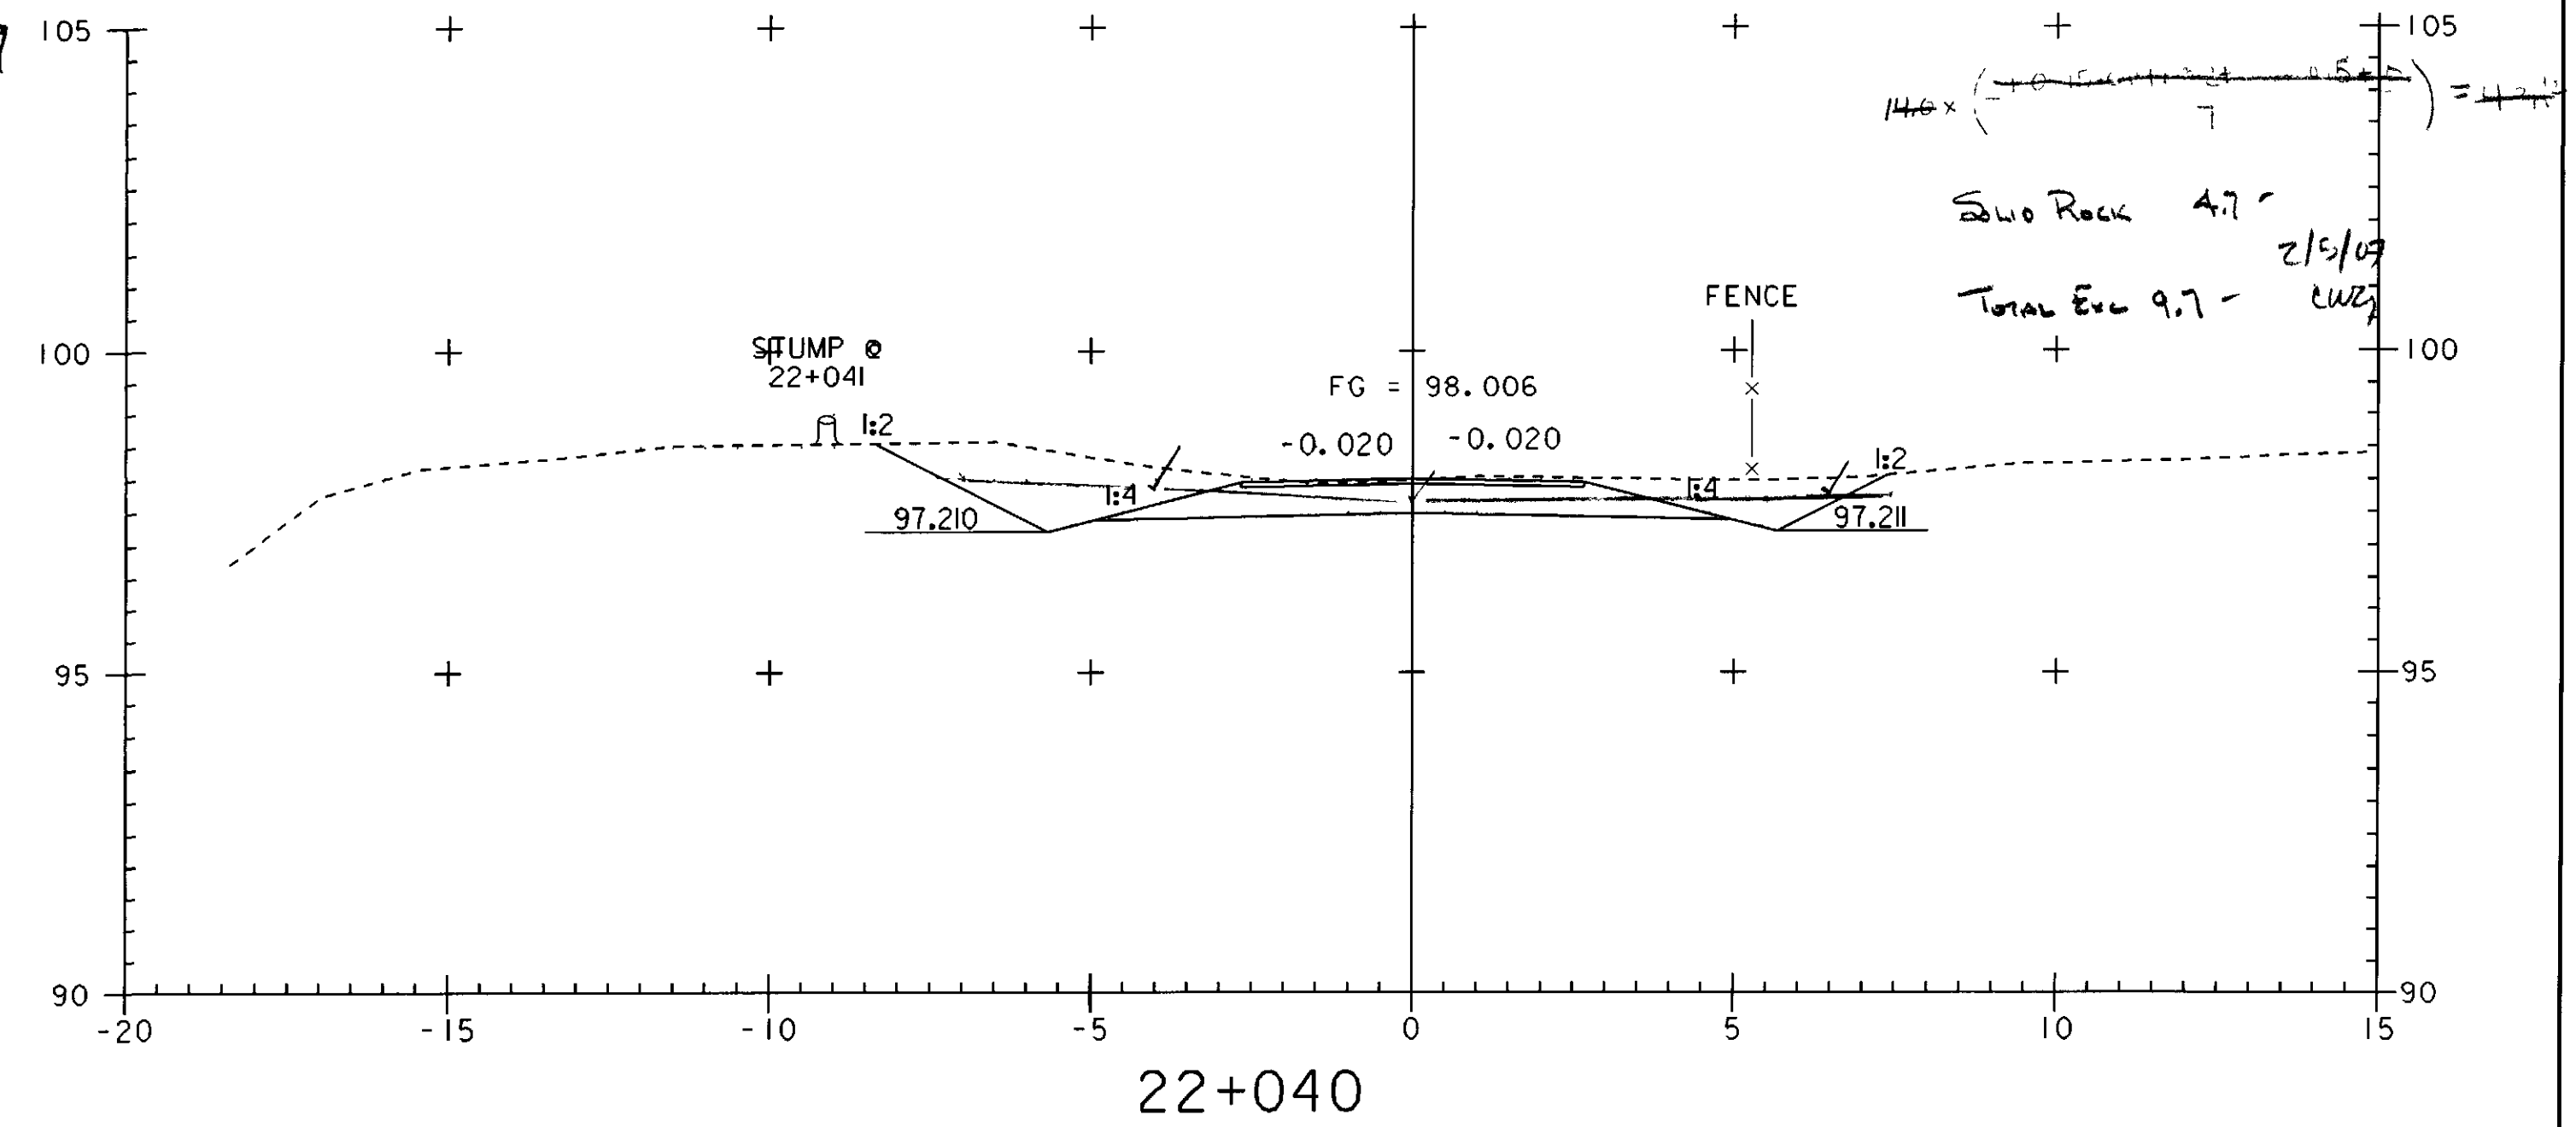


# TH #15 SECTIONS

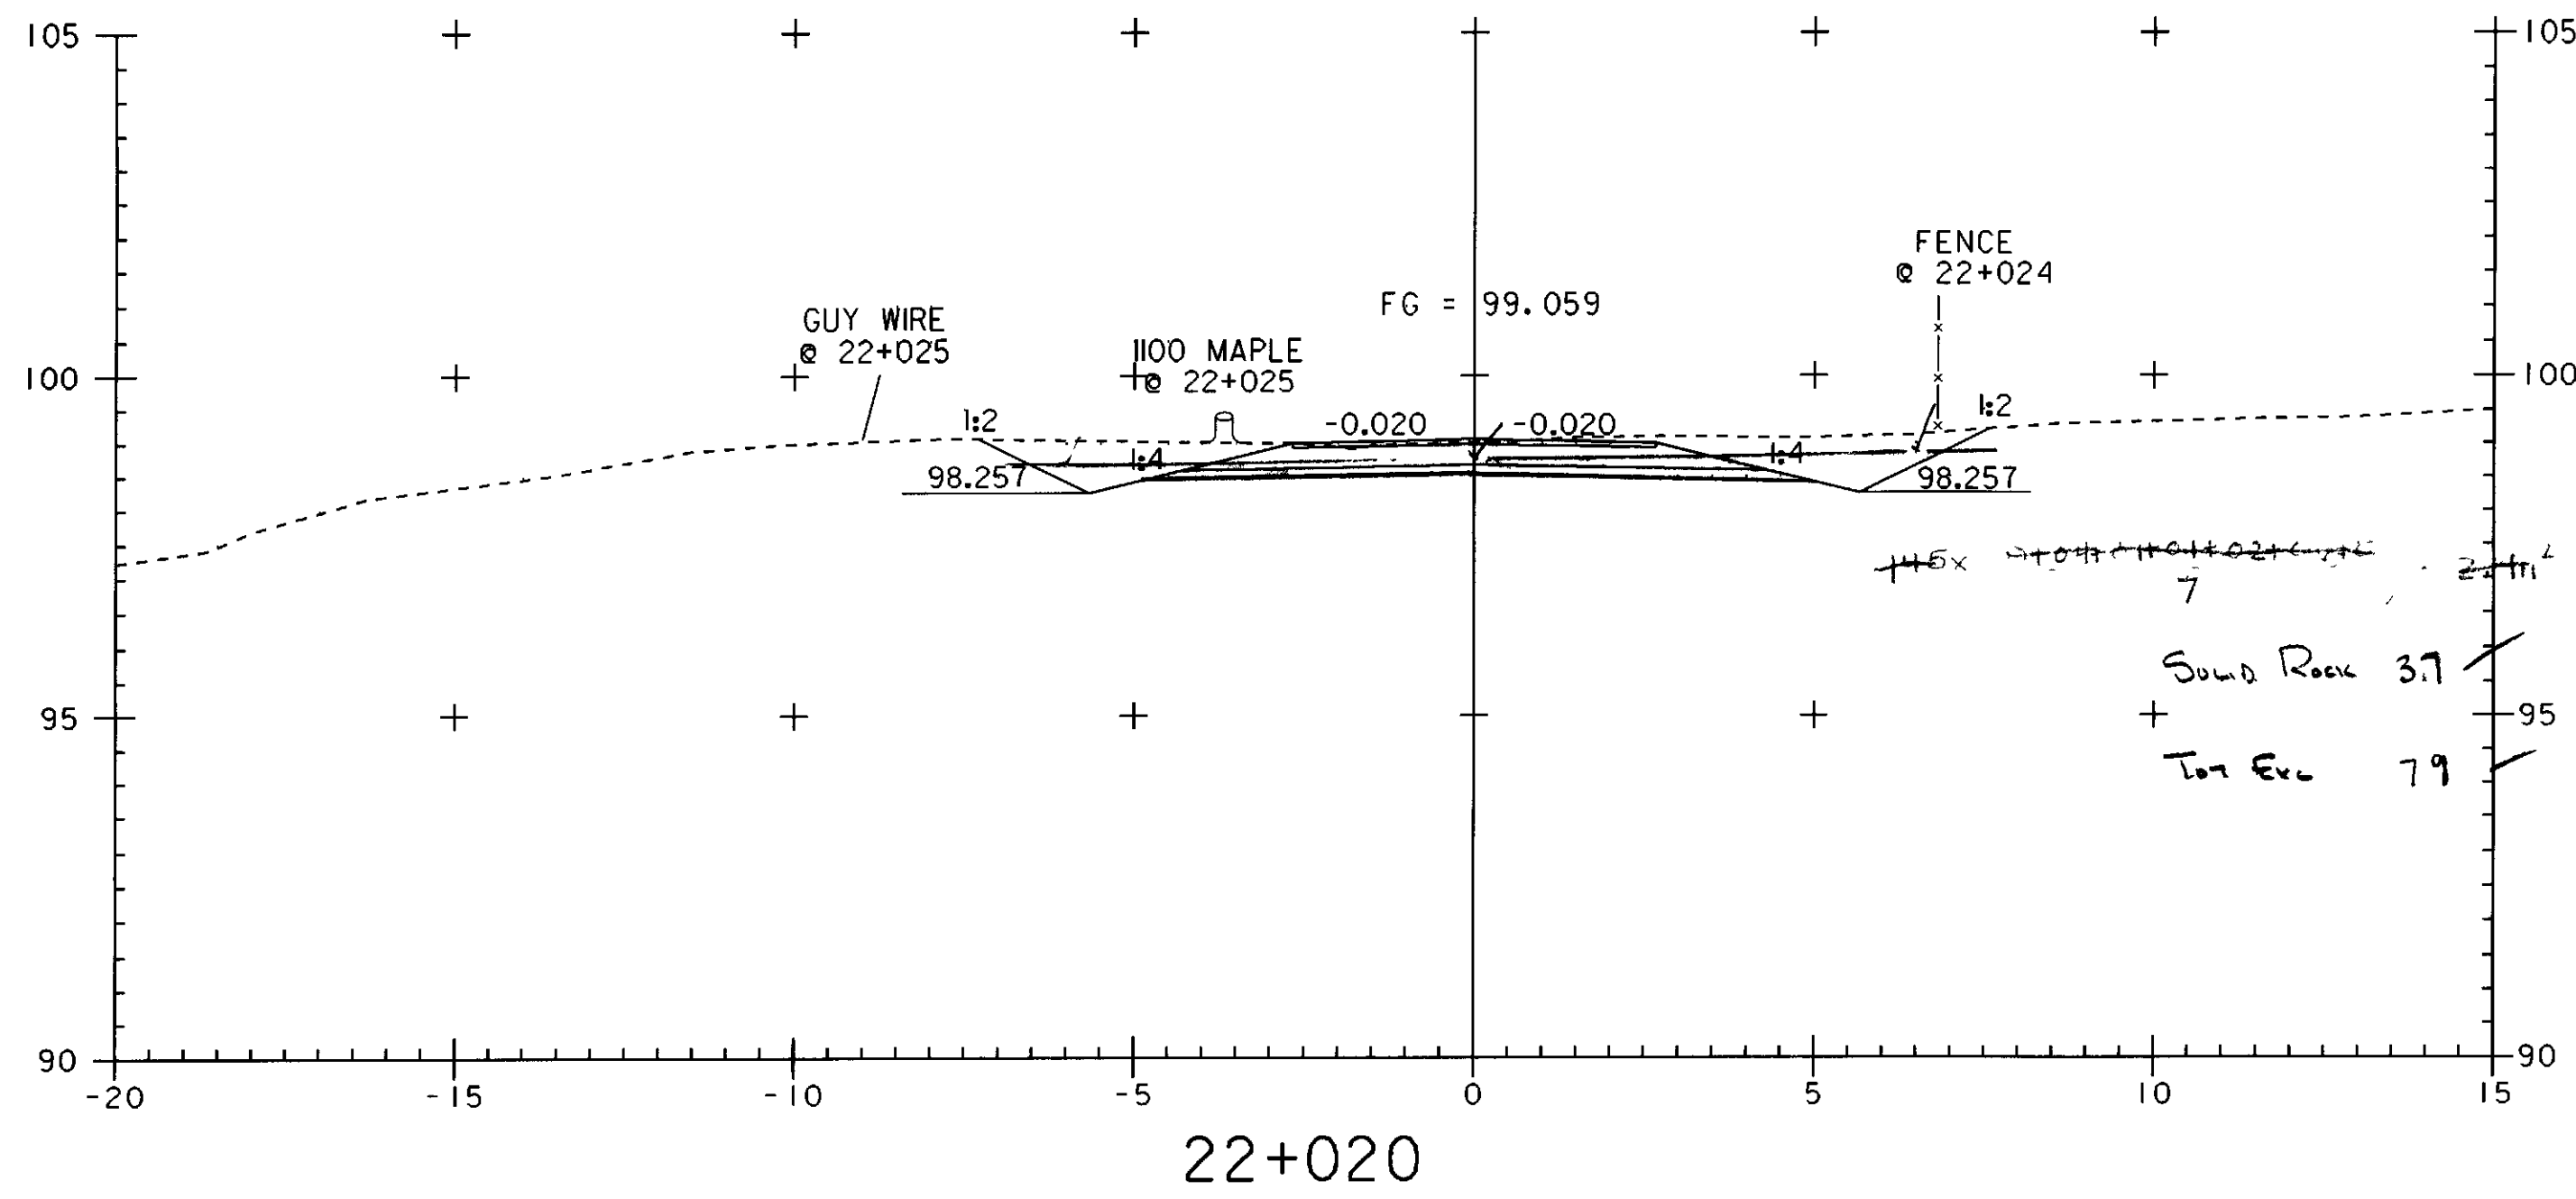

PROJECT NAME:	HIGHGATE - FRANKLIN	PLOT DATE:	09-MAY-2005
PROJECT NUMBER:	STP RS 0301(I) SA	DRAWN BY:	SQUAD B
FILE NAME:	...85c060\design\dc060x07.dgn	CHECKED BY:	SQUAD B
PROJECT LEADER:	DELLASANTA	SHEET	362 OF 450
DESIGNED BY:	SQUAD B		
IPARM FILE NAME:	dc060x0716.i		