


STA 6+038.060 END TAPER BEGIN FULL DEPTH SAND (450MM)  
 STA 6+036.200 BEGIN TAPER

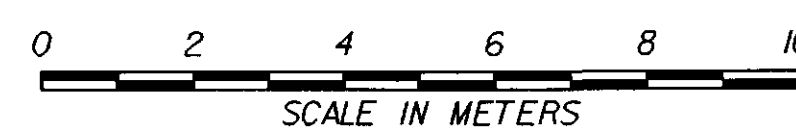

PROJECT NAME:	HIGHGATE - FRANKLIN
PROJECT NUMBER:	STP RS 030(K) SA
FILE NAME:	...85c060\design\dc060x08.dgn
PLOT DATE:	09-MAY-2005
PROJECT LEADER:	DELLASANTA
DRAWN BY:	SQUAD B
DESIGNED BY:	SQUAD B
CHECKED BY:	SQUAD B
IPARM FILE NAME:	dc060x085.l
SHEET	370 OF 450