
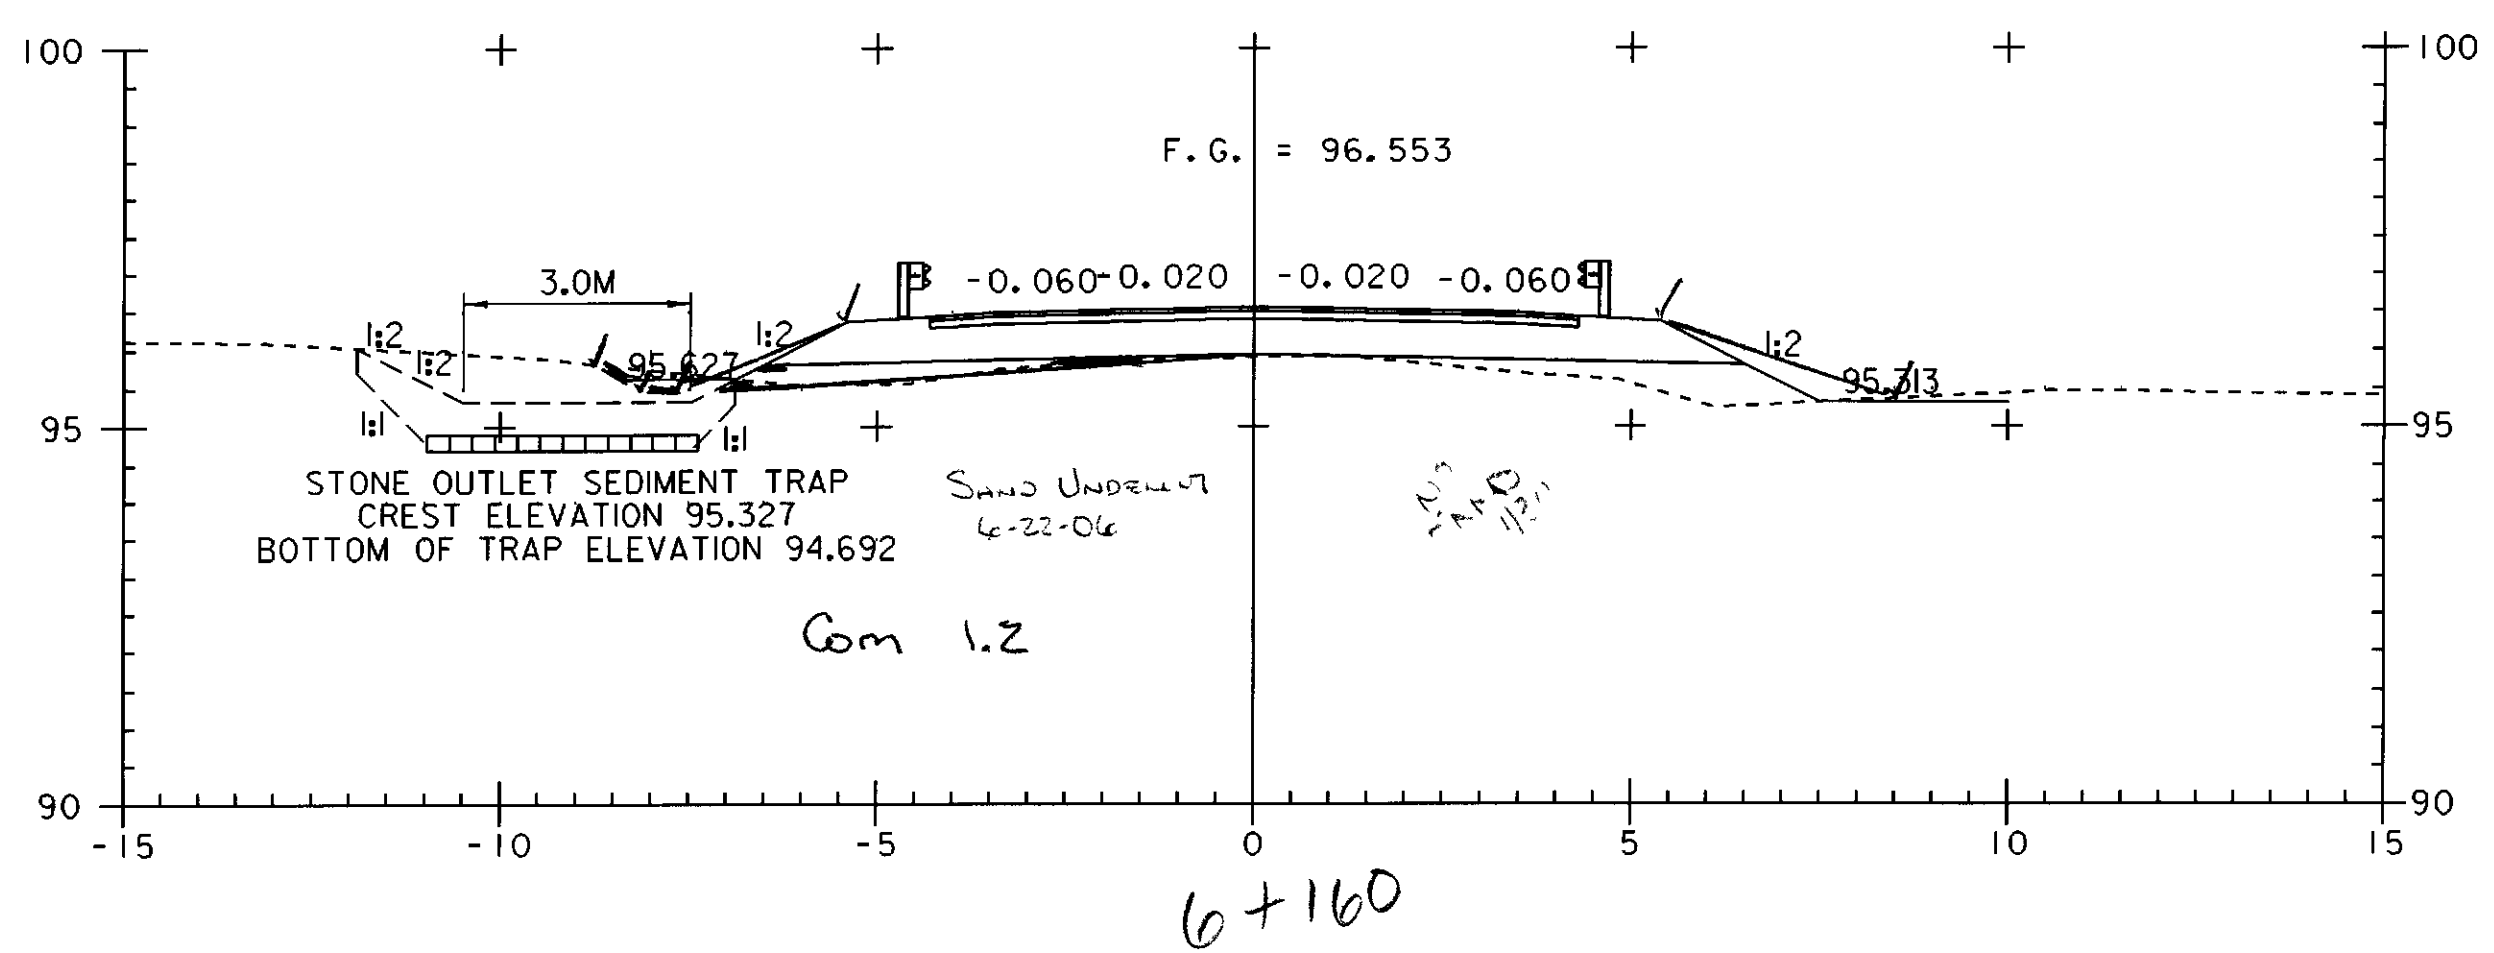


STA 6+199.714 END TAPER  
 STA 6+199.904 END FULL DEPTH SAND (450MM) BEGIN TAPER

STA 6+184.156 END TAPER BEGIN FULL DEPTH SAND (450MM)  
 STA 6+182.806 BEGIN TAPER

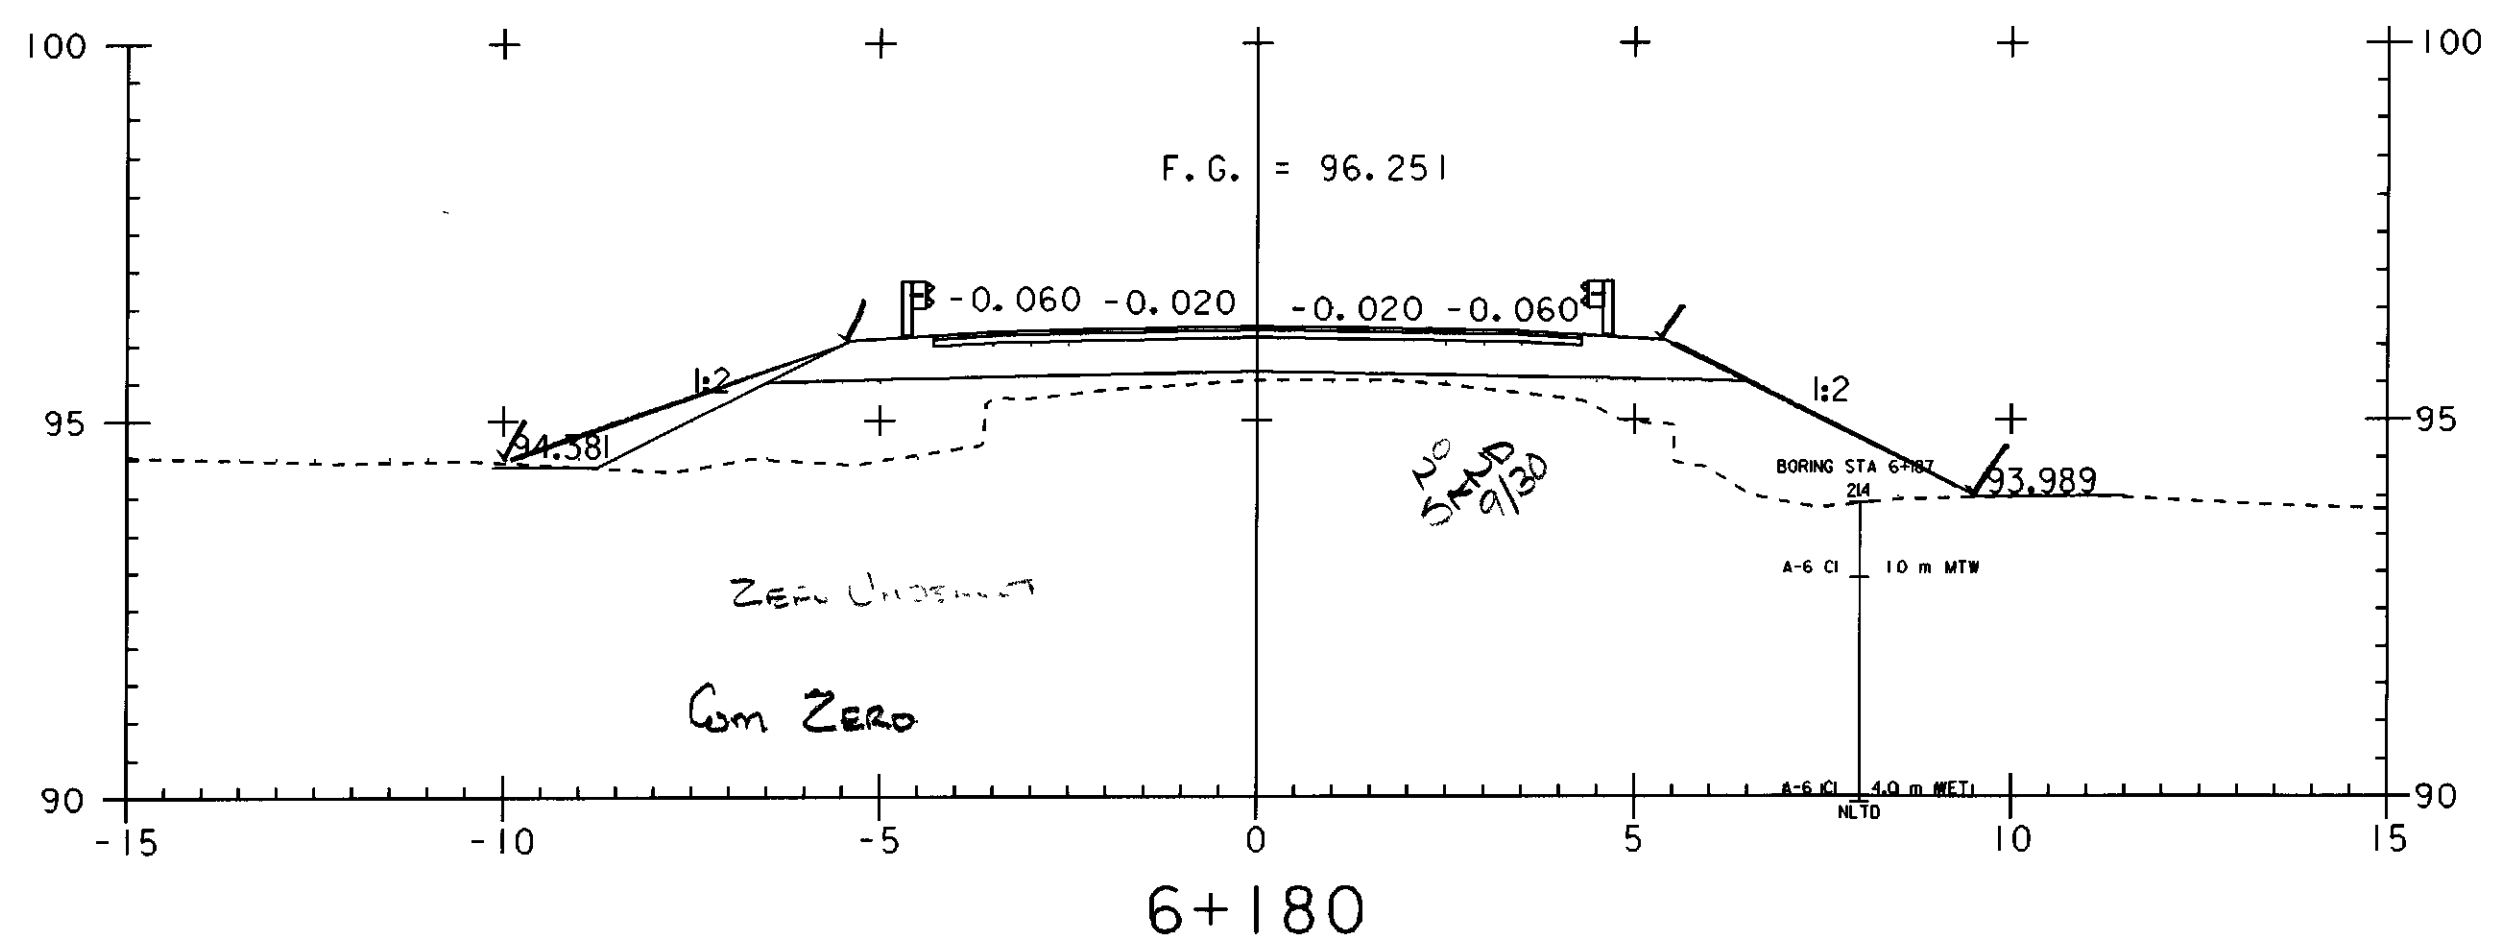

PROJECT NAME:	HIGHGATE - FRANKLIN	PLOT DATE:	09-MAY-2005
PROJECT NUMBER:	STP RS 0301(I) SA	DRAWN BY:	SQUAD B
FILE NAME:	...85c060\design\dc060x08.dgn	CHECKED BY:	SQUAD B
DESIGNED BY:	SQUAD B	SHEET	372 OF 450
IPARM FILE NAME:	dc060x087.i		