
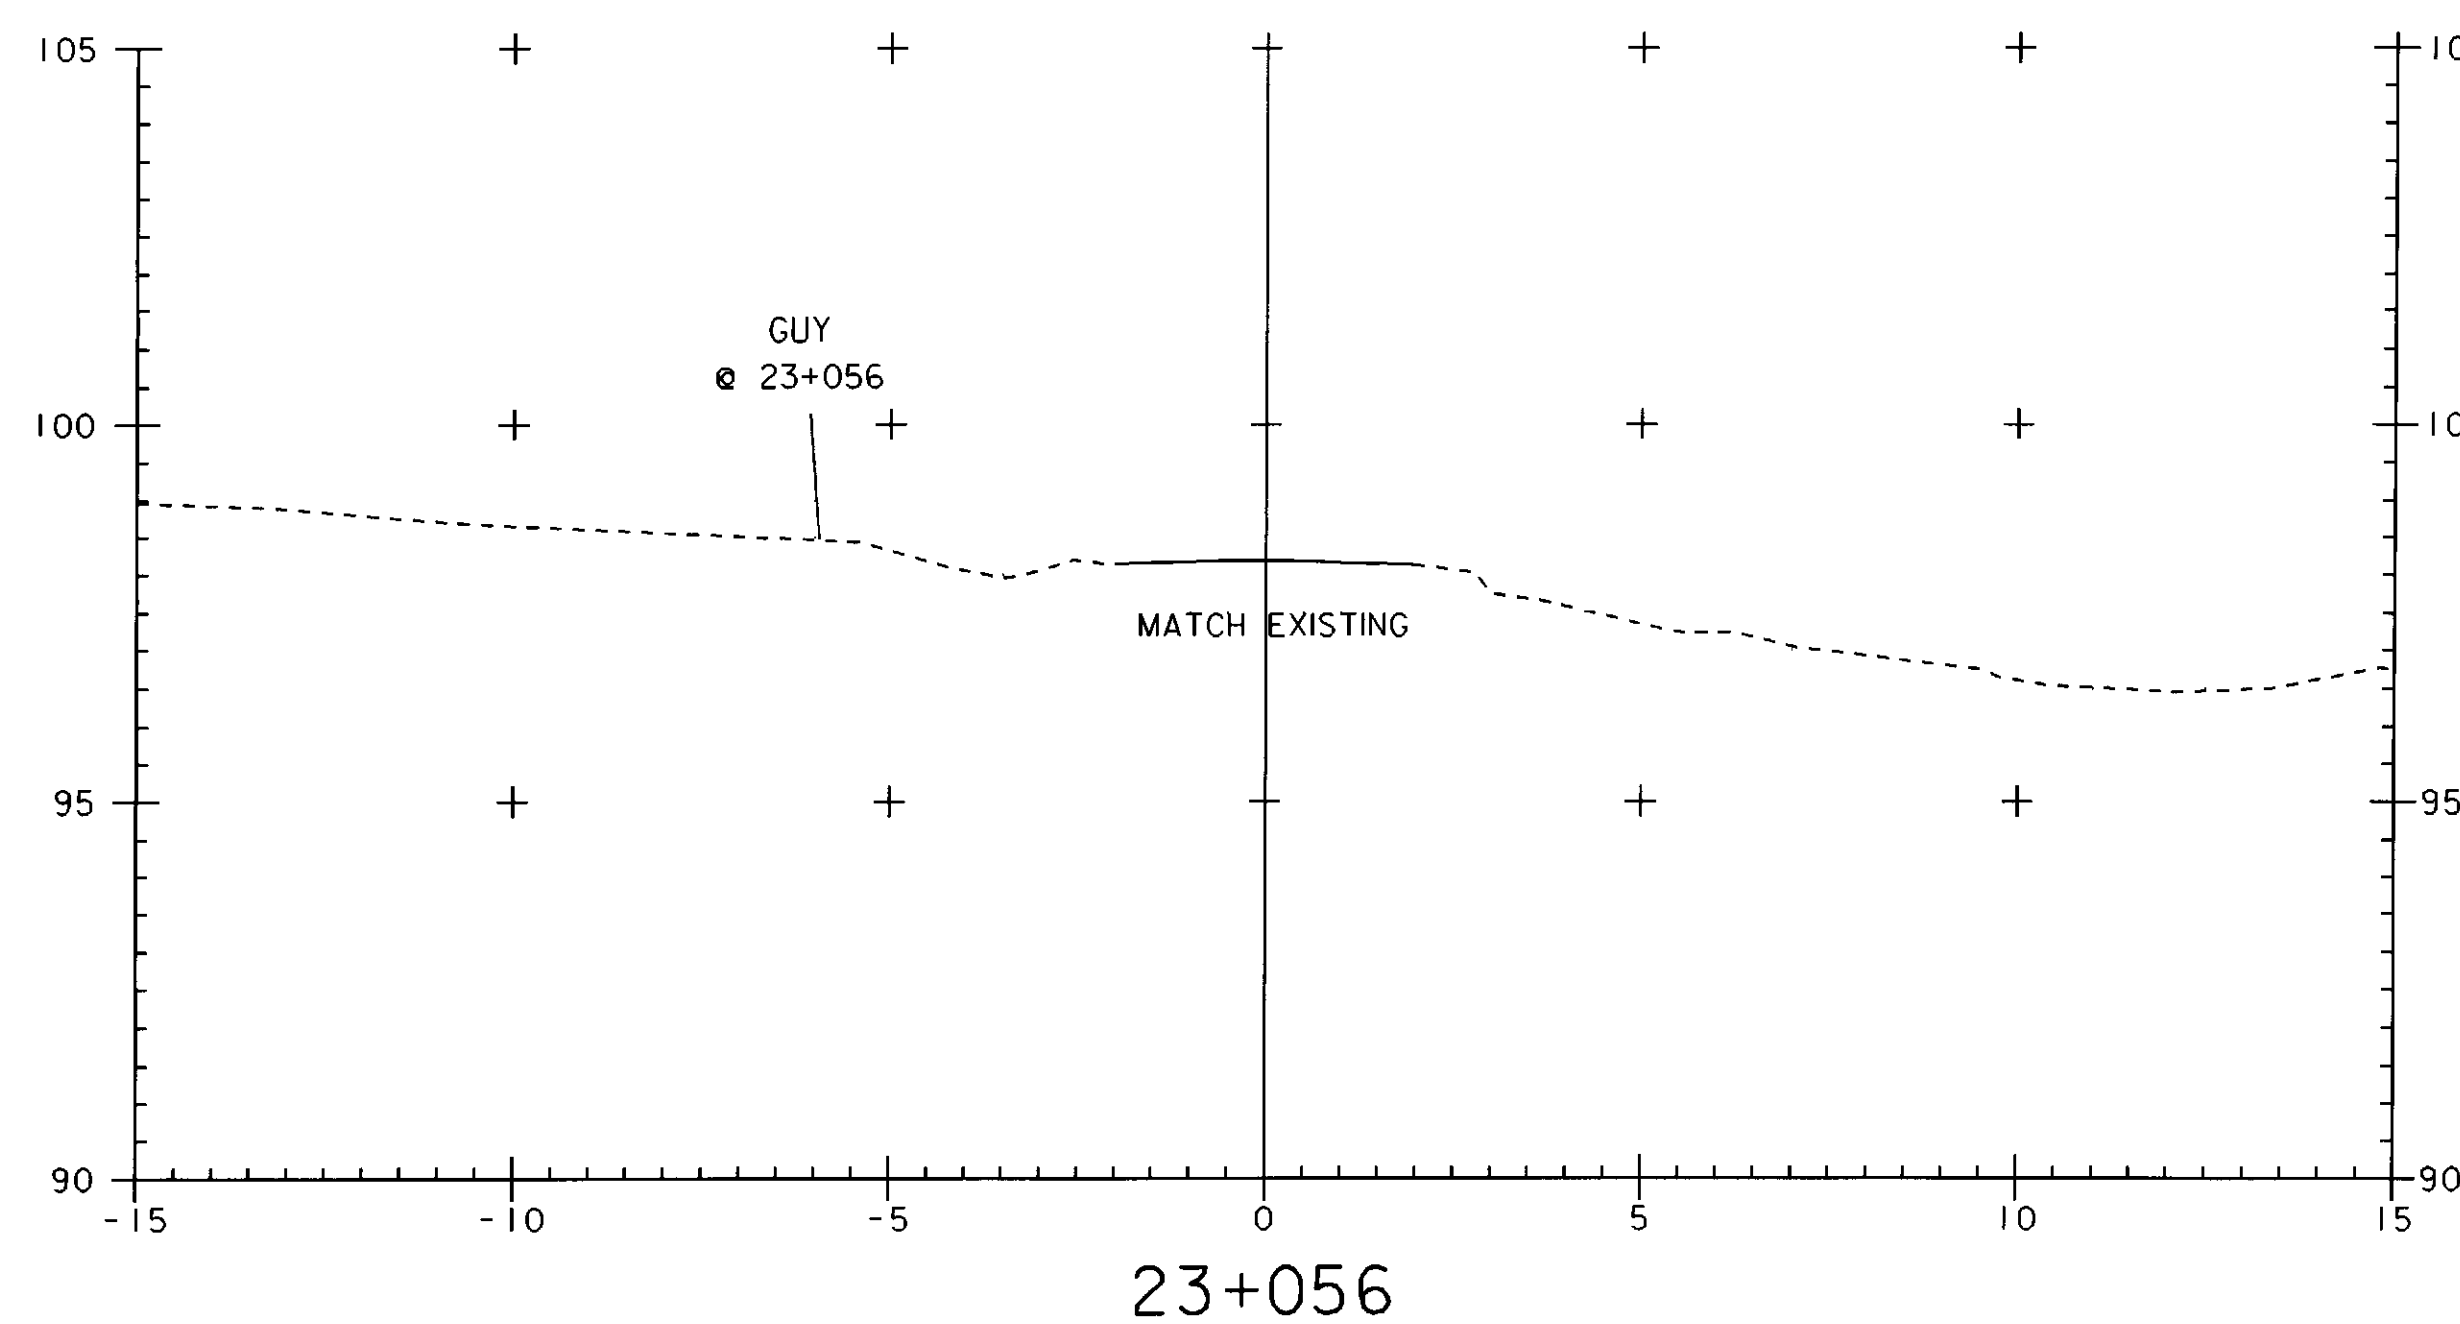
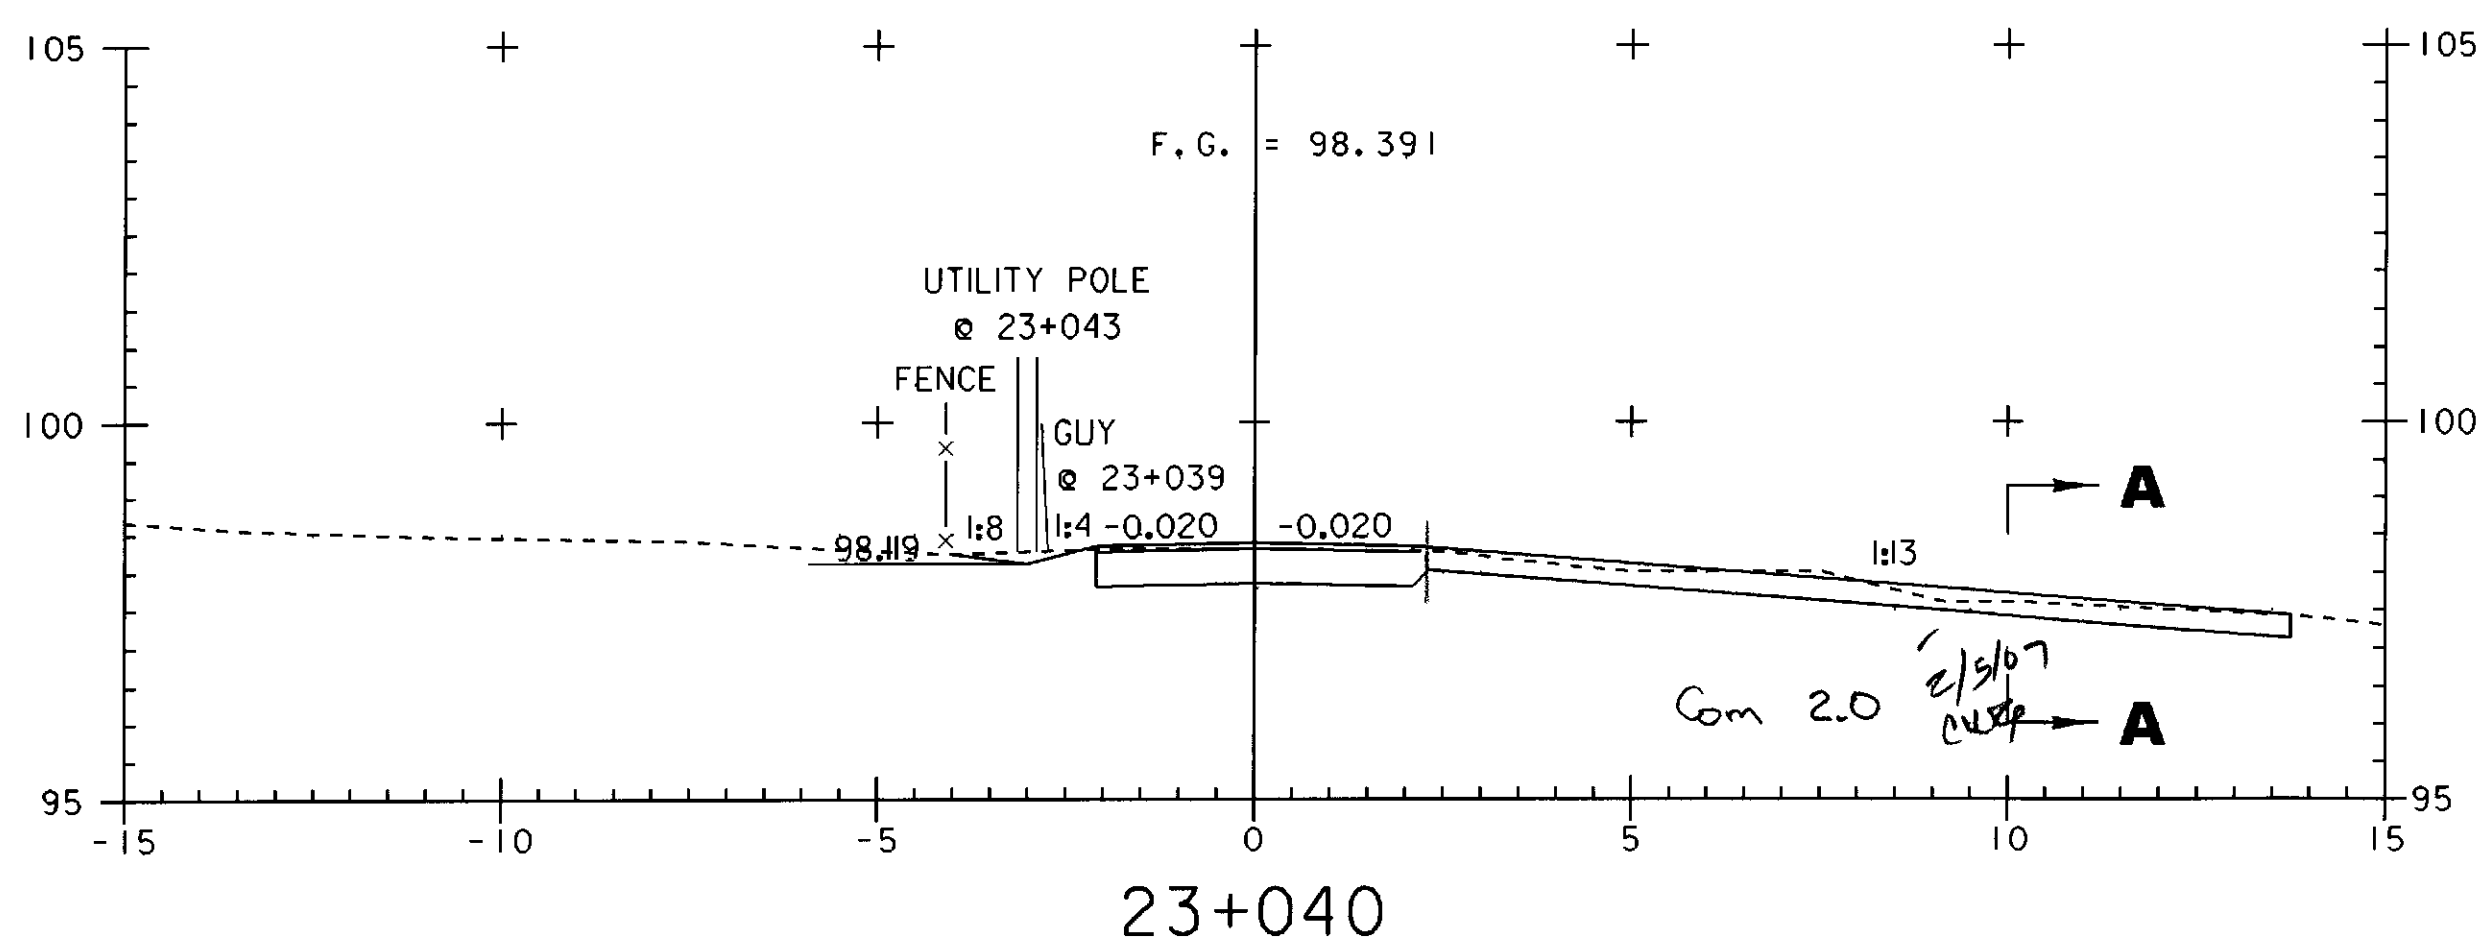
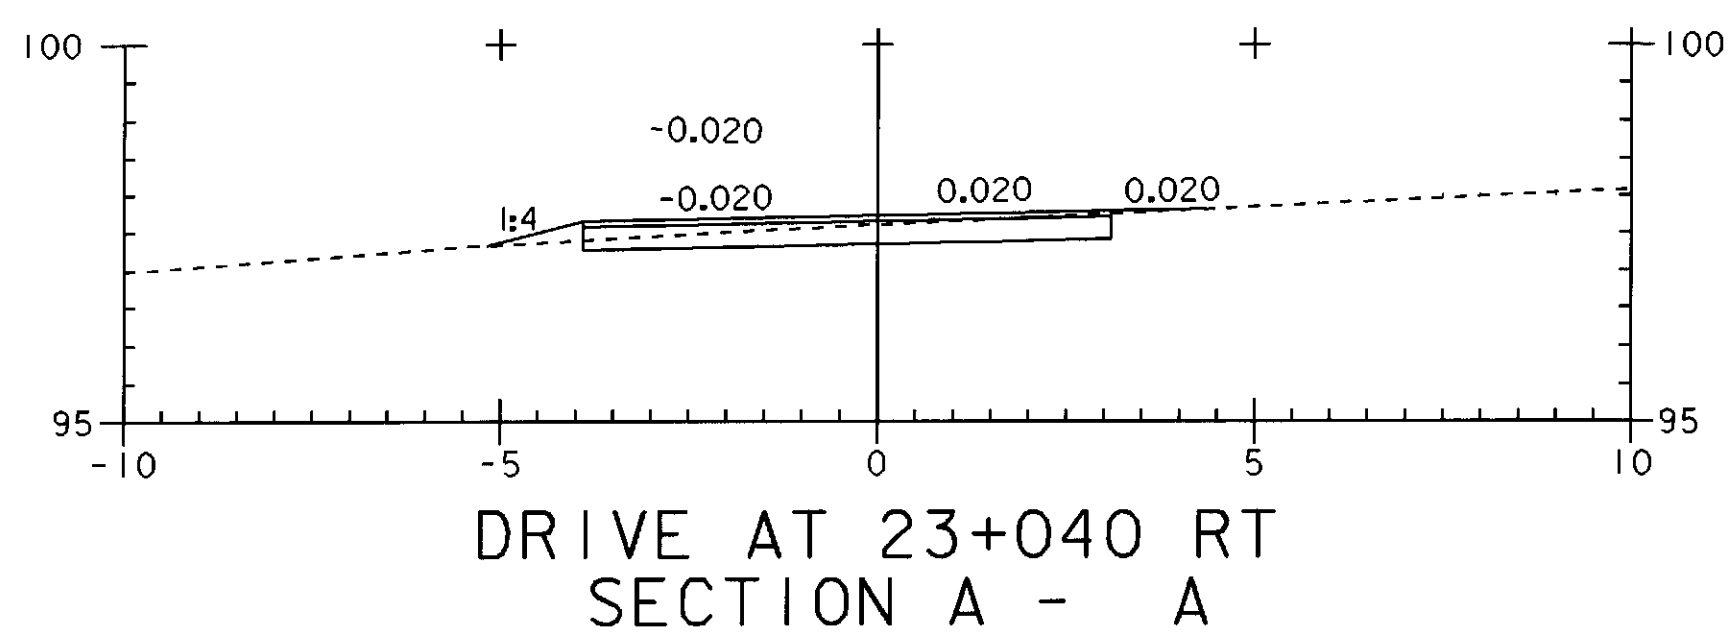
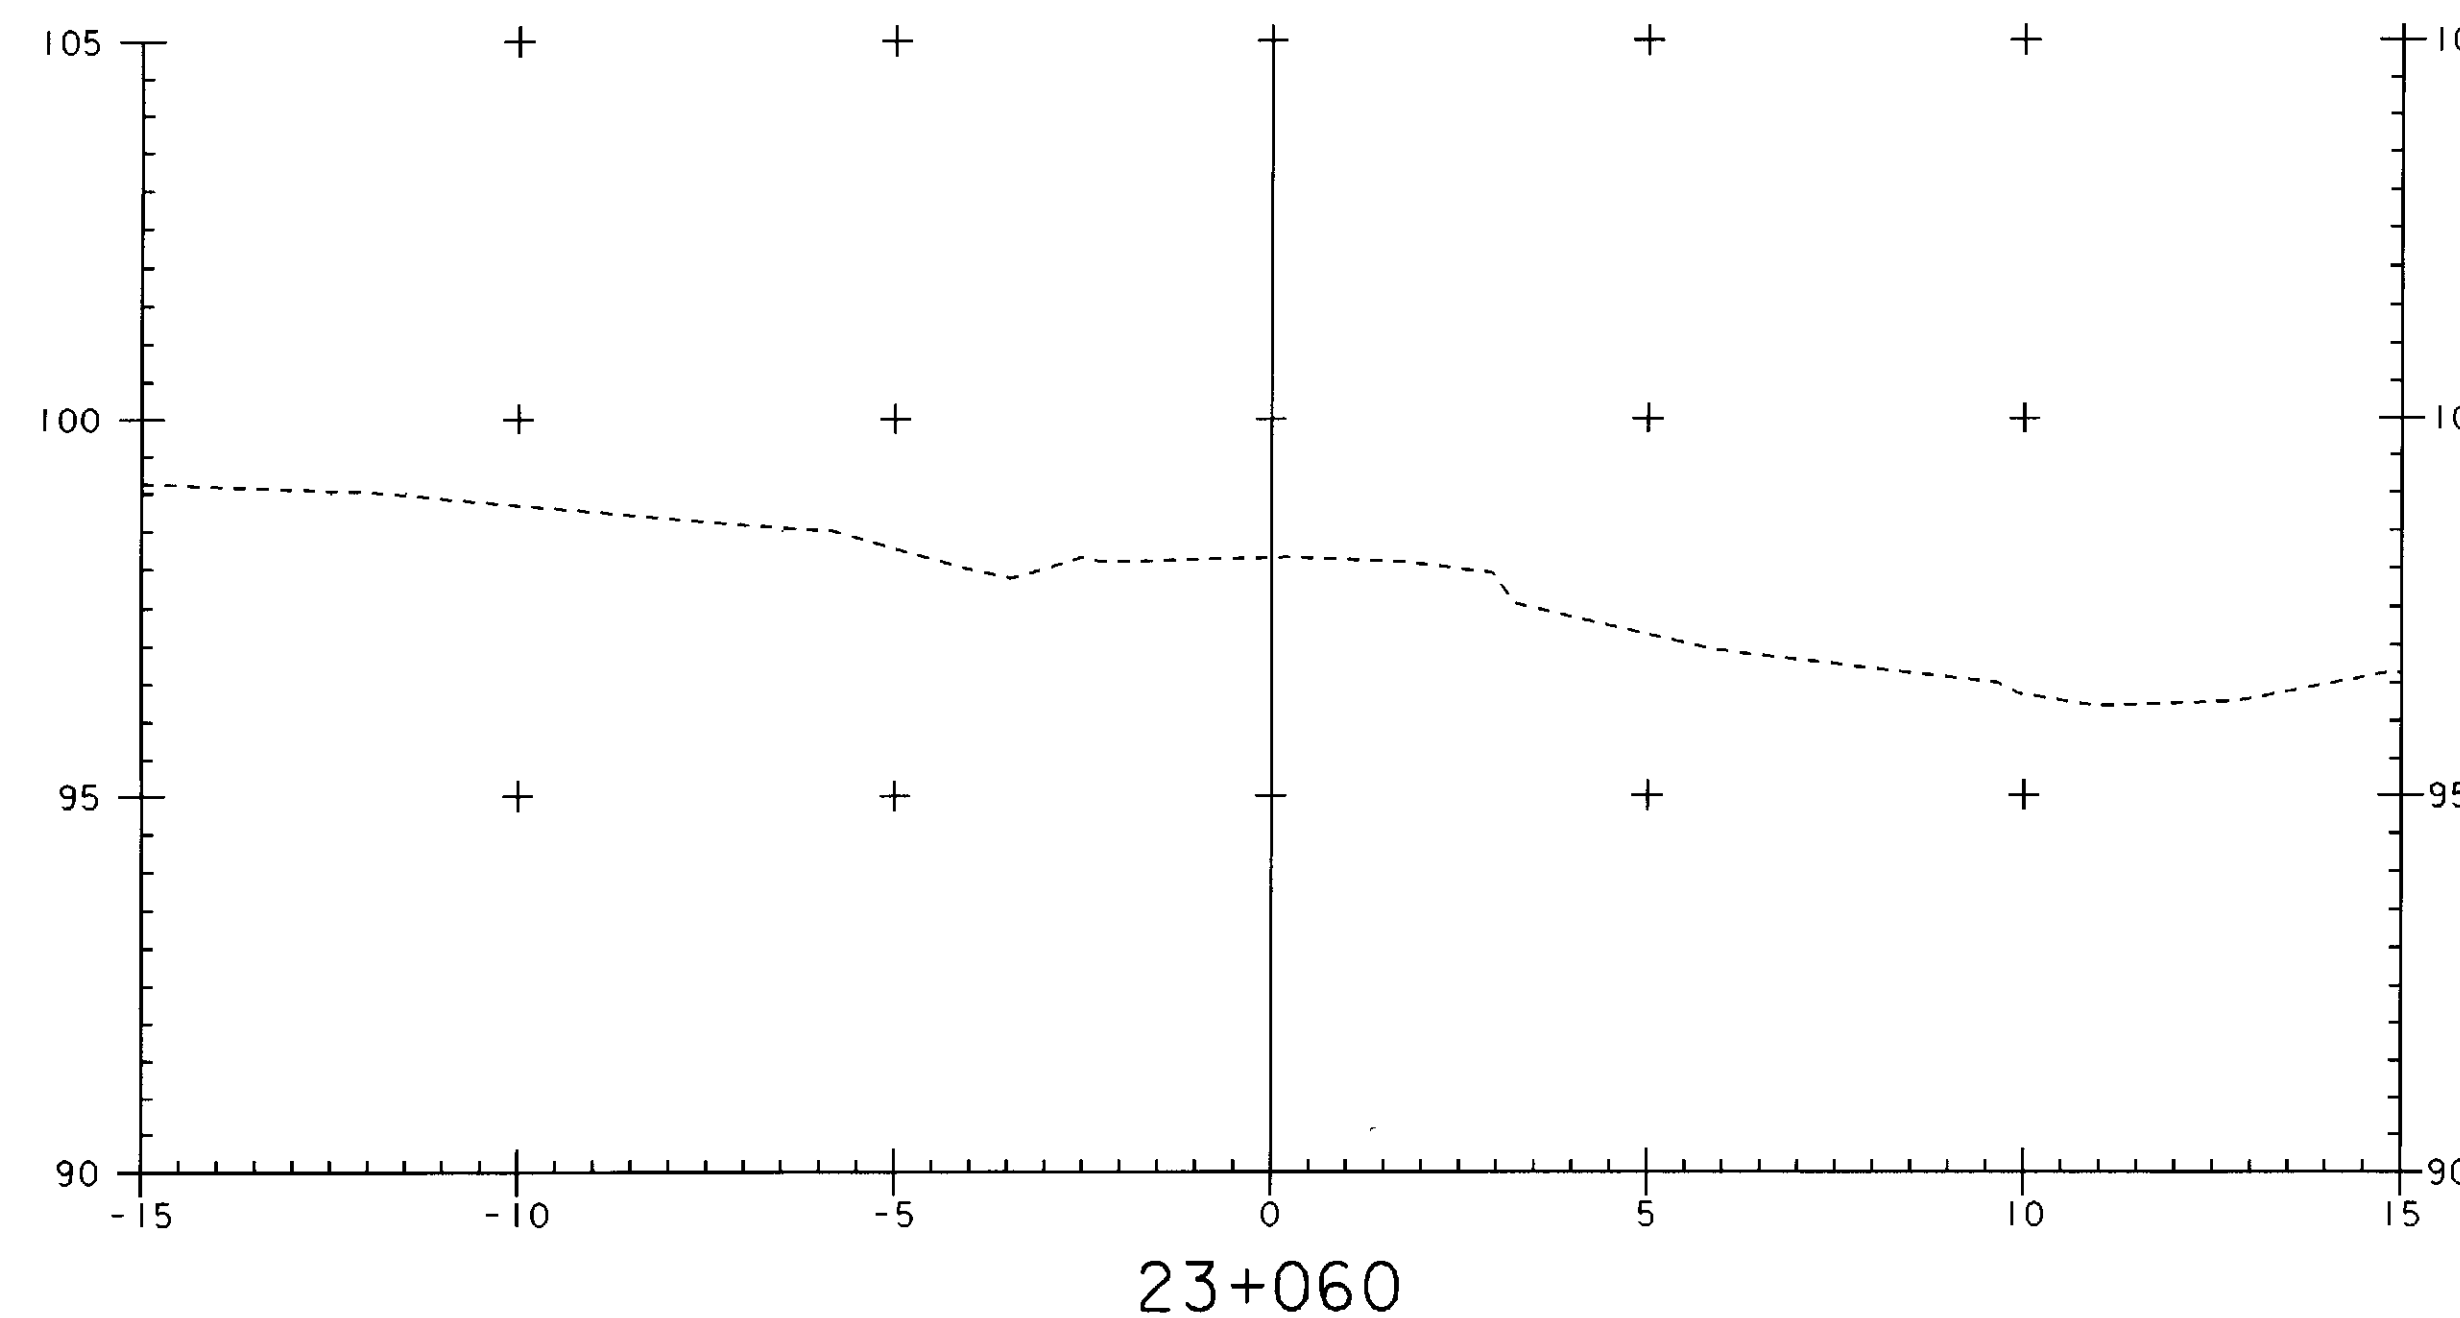
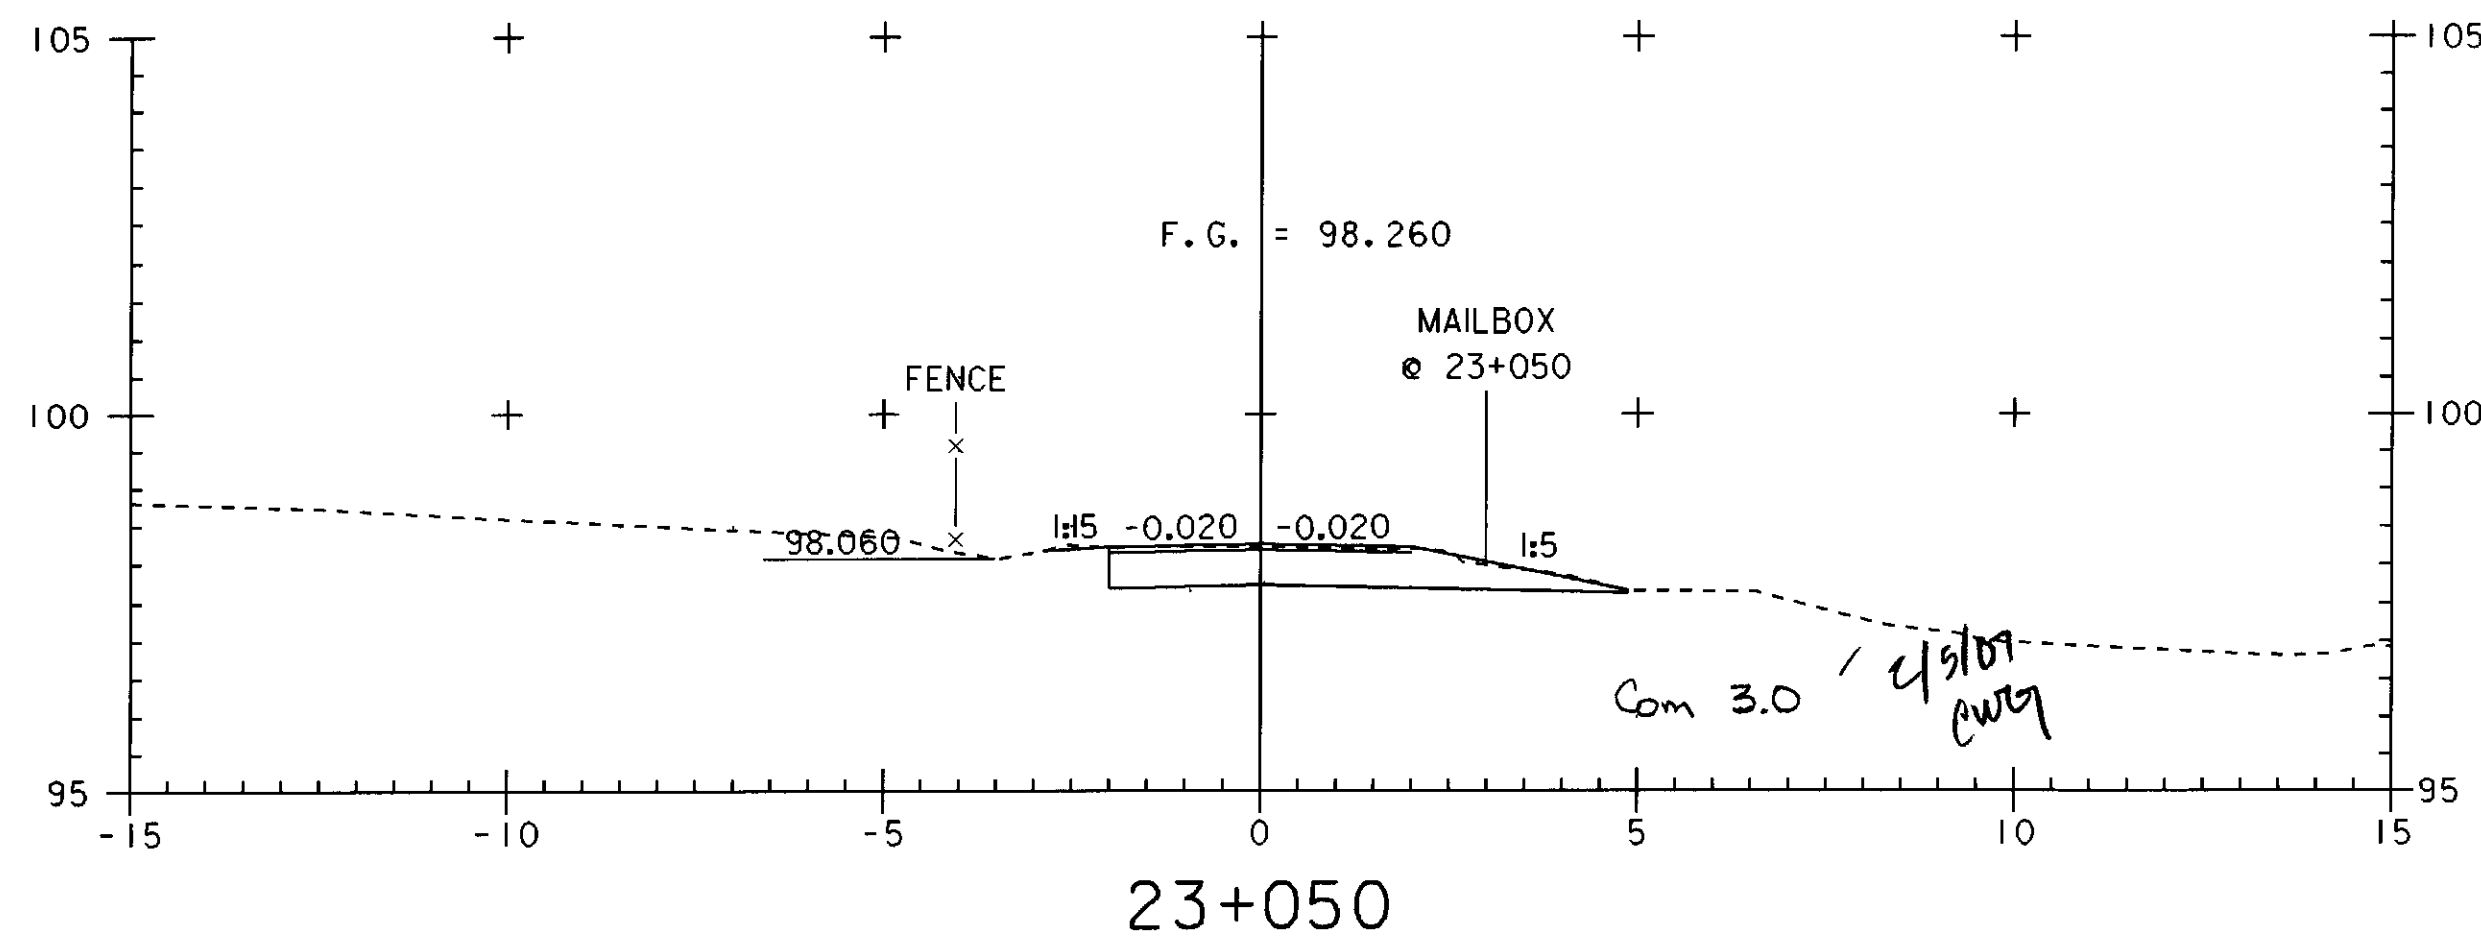


TH #25 SECTIONS

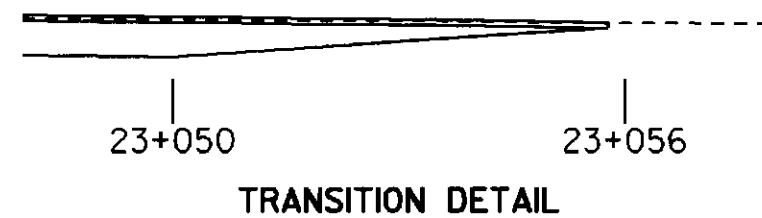

PROJECT NAME:	HIGHGATE - FRANKLIN	PLOT DATE:	09-MAY-2005
PROJECT NUMBER:	STP RS 030(I) SA	DRAWN BY:	SQUAD B
PROJECT LEADER:	DELLASANTA	CHECKED BY:	SQUAD B
DESIGNED BY:	SQUAD B	SHEET	384 OF 450
IPARM FILE NAME:	dc060x0819.1		