


STA 7+022.440 END TAPER BEGIN FULL DEPTH SAND (450MM)
STA 7+050.580 BEGIN TAPER

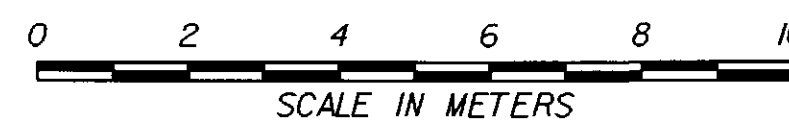

PROJECT NAME:	HIGHGATE - FRANKLIN
PROJECT NUMBER:	STP RS 030(K) SA
FILE NAME: ...85c060\design\dc060x09.dgn	PLOT DATE: 09-MAY-2005
PROJECT LEADER: DELLASANTA	DRAWN BY: SQUAD B
DESIGNED BY: SQUAD B	CHECKED BY: SQUAD B
IPARM FILE NAME: dc060x097.1	SHEET 392 OF 450