




7+500

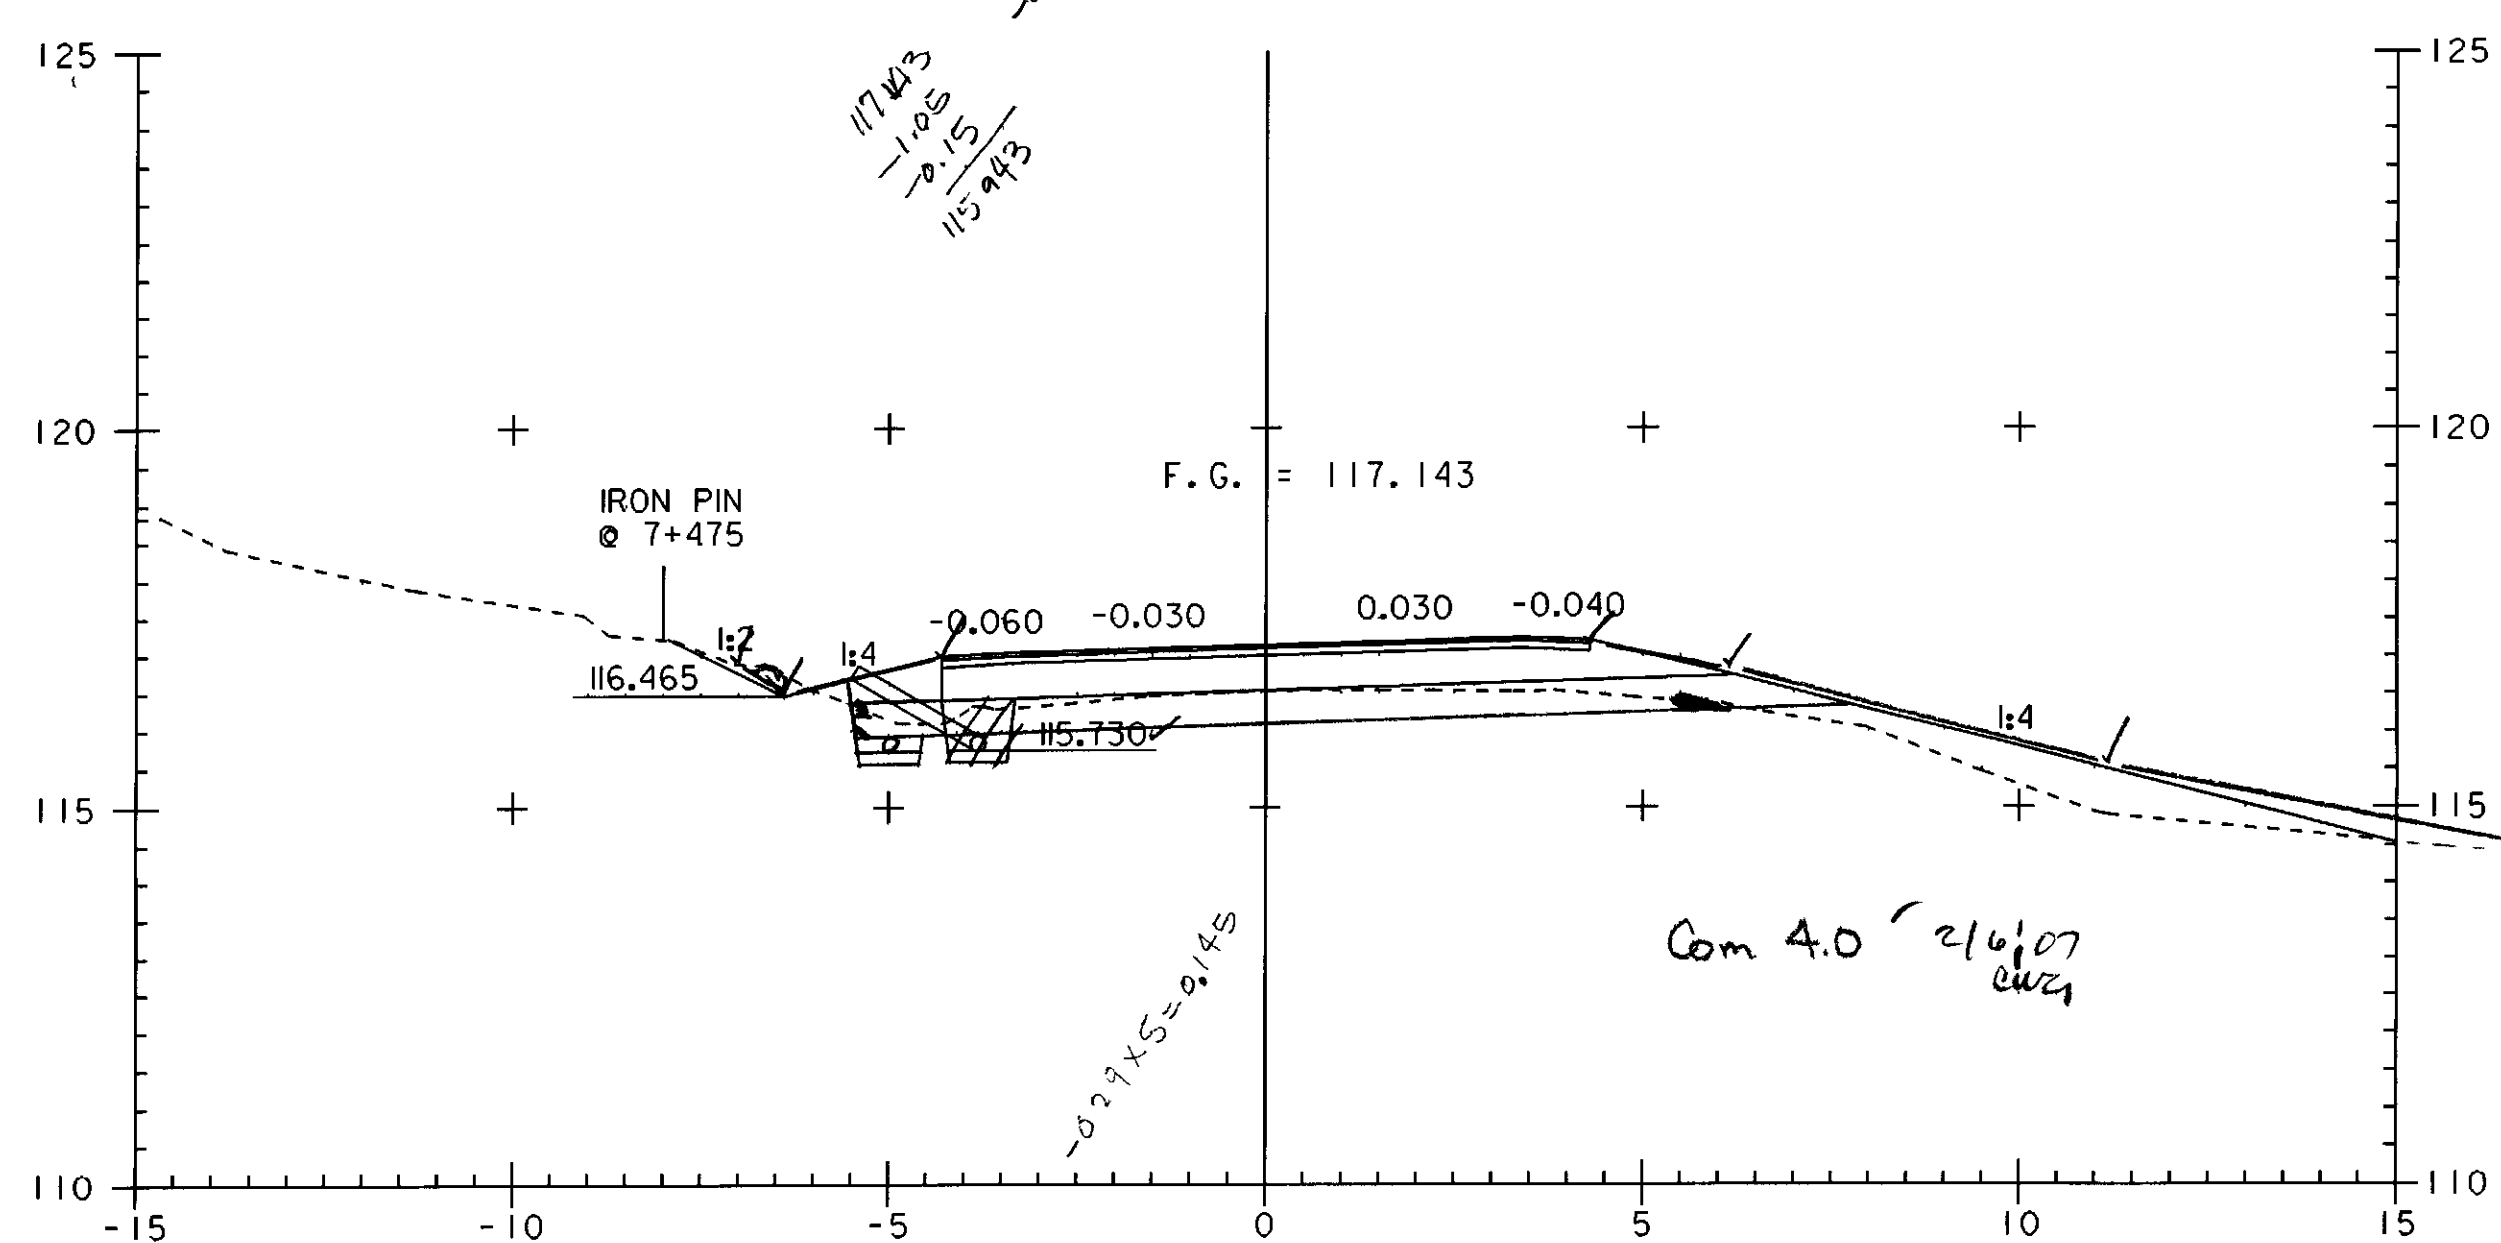


7+480

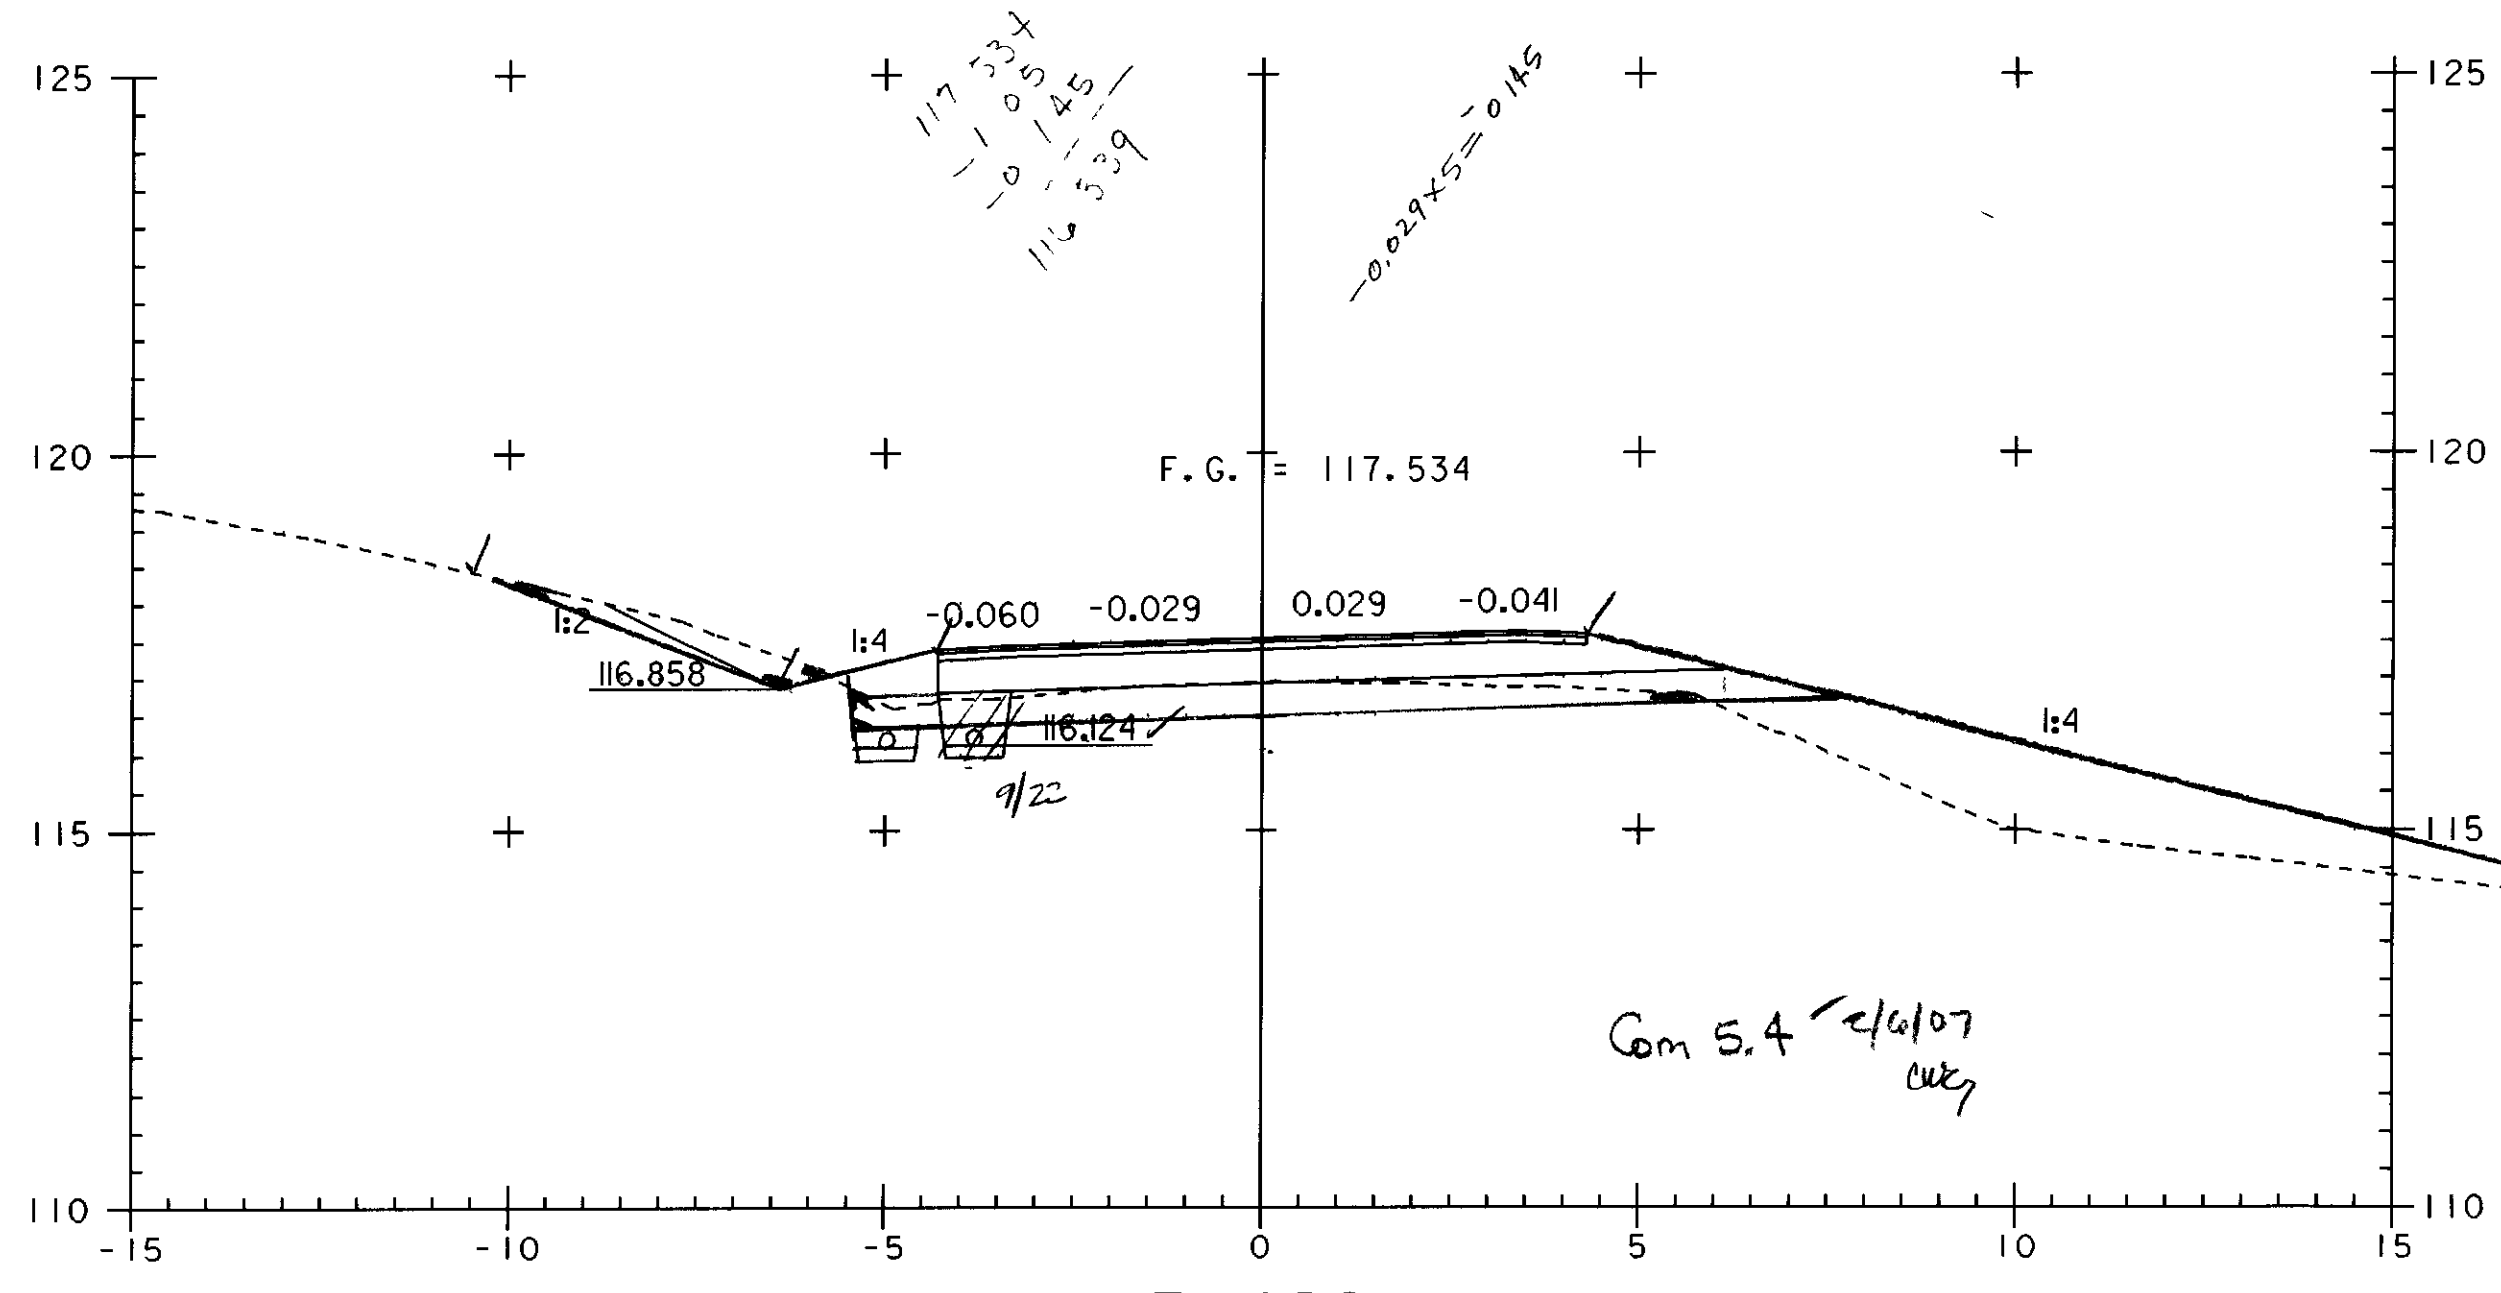


7+460

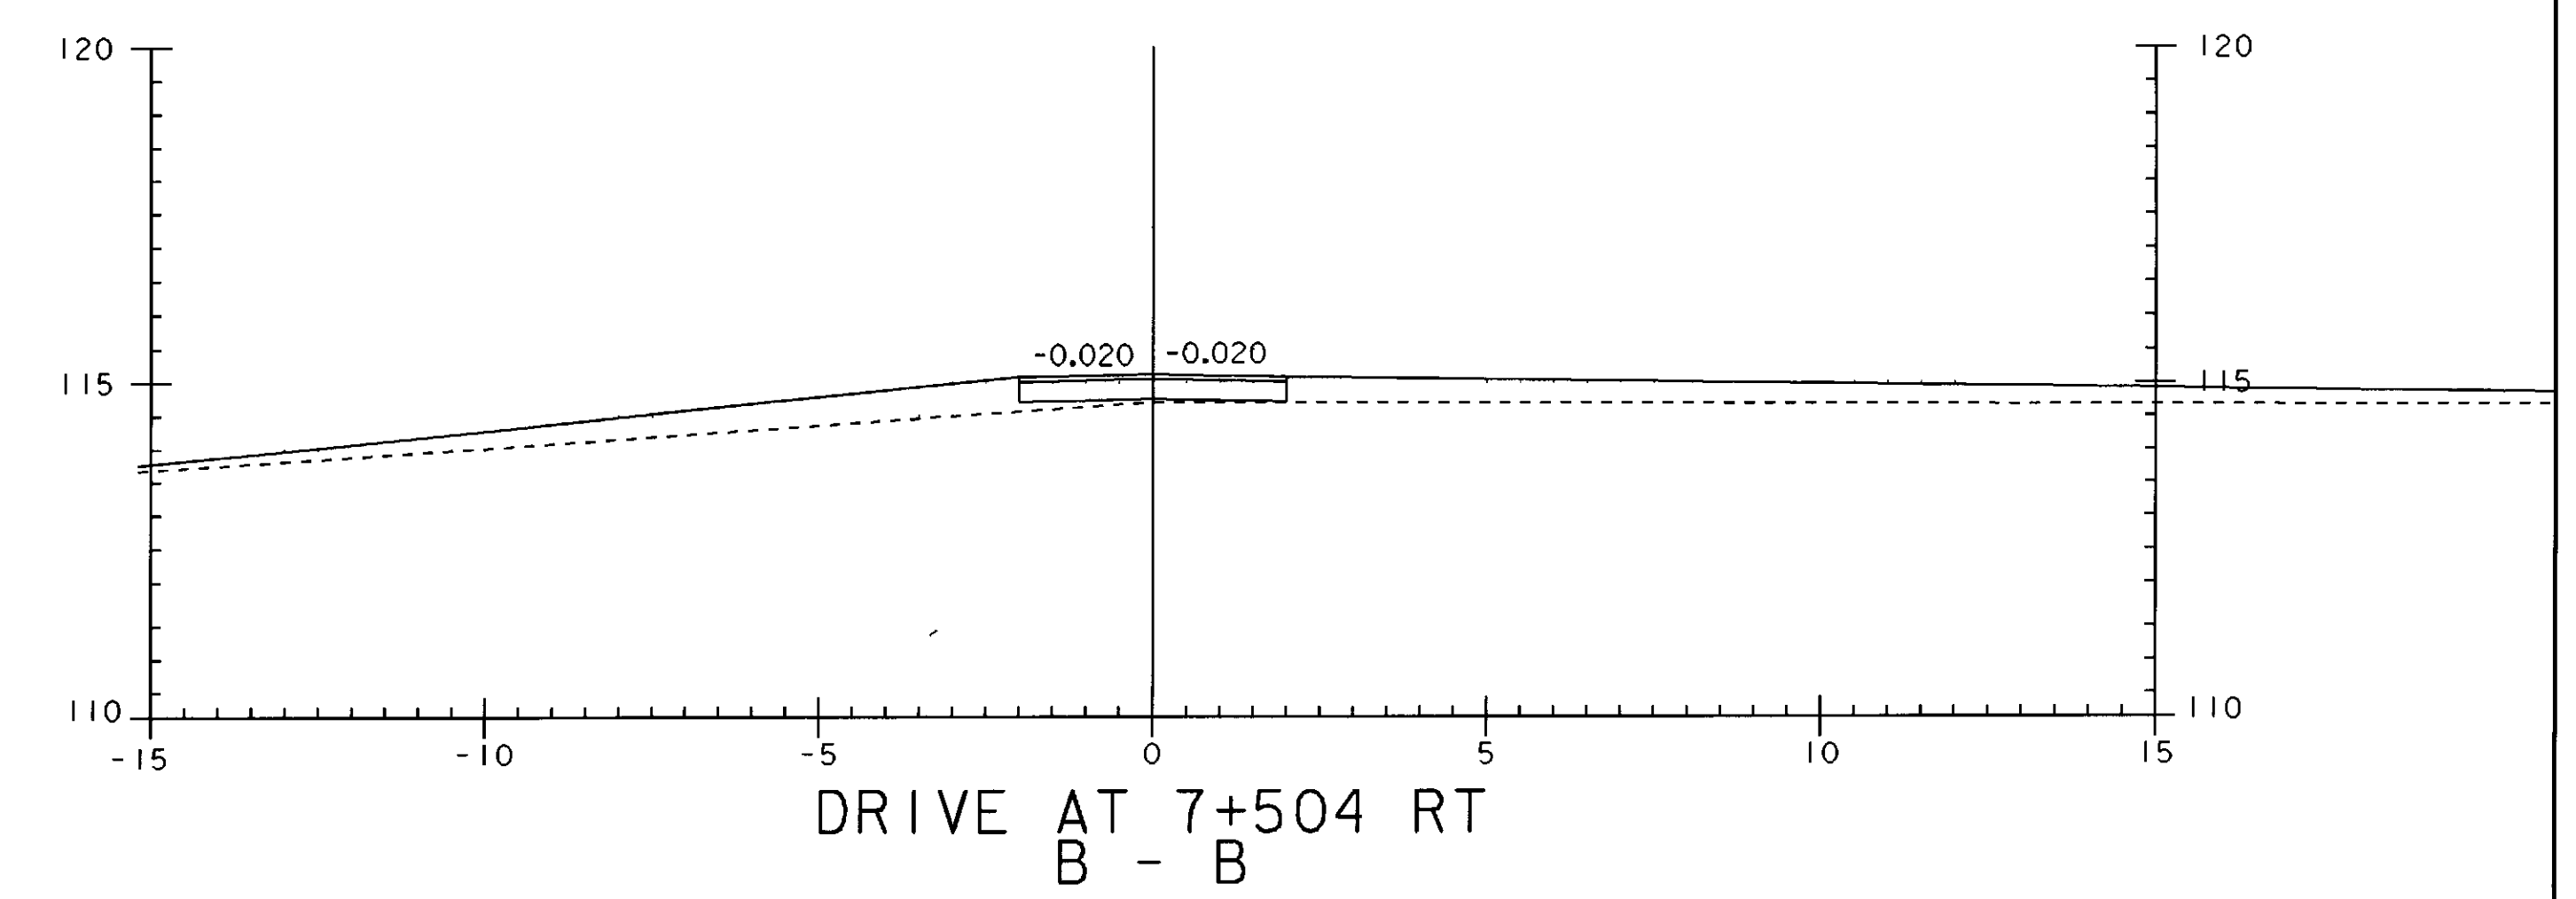

DRIVE AT 7+504 RT
B - B

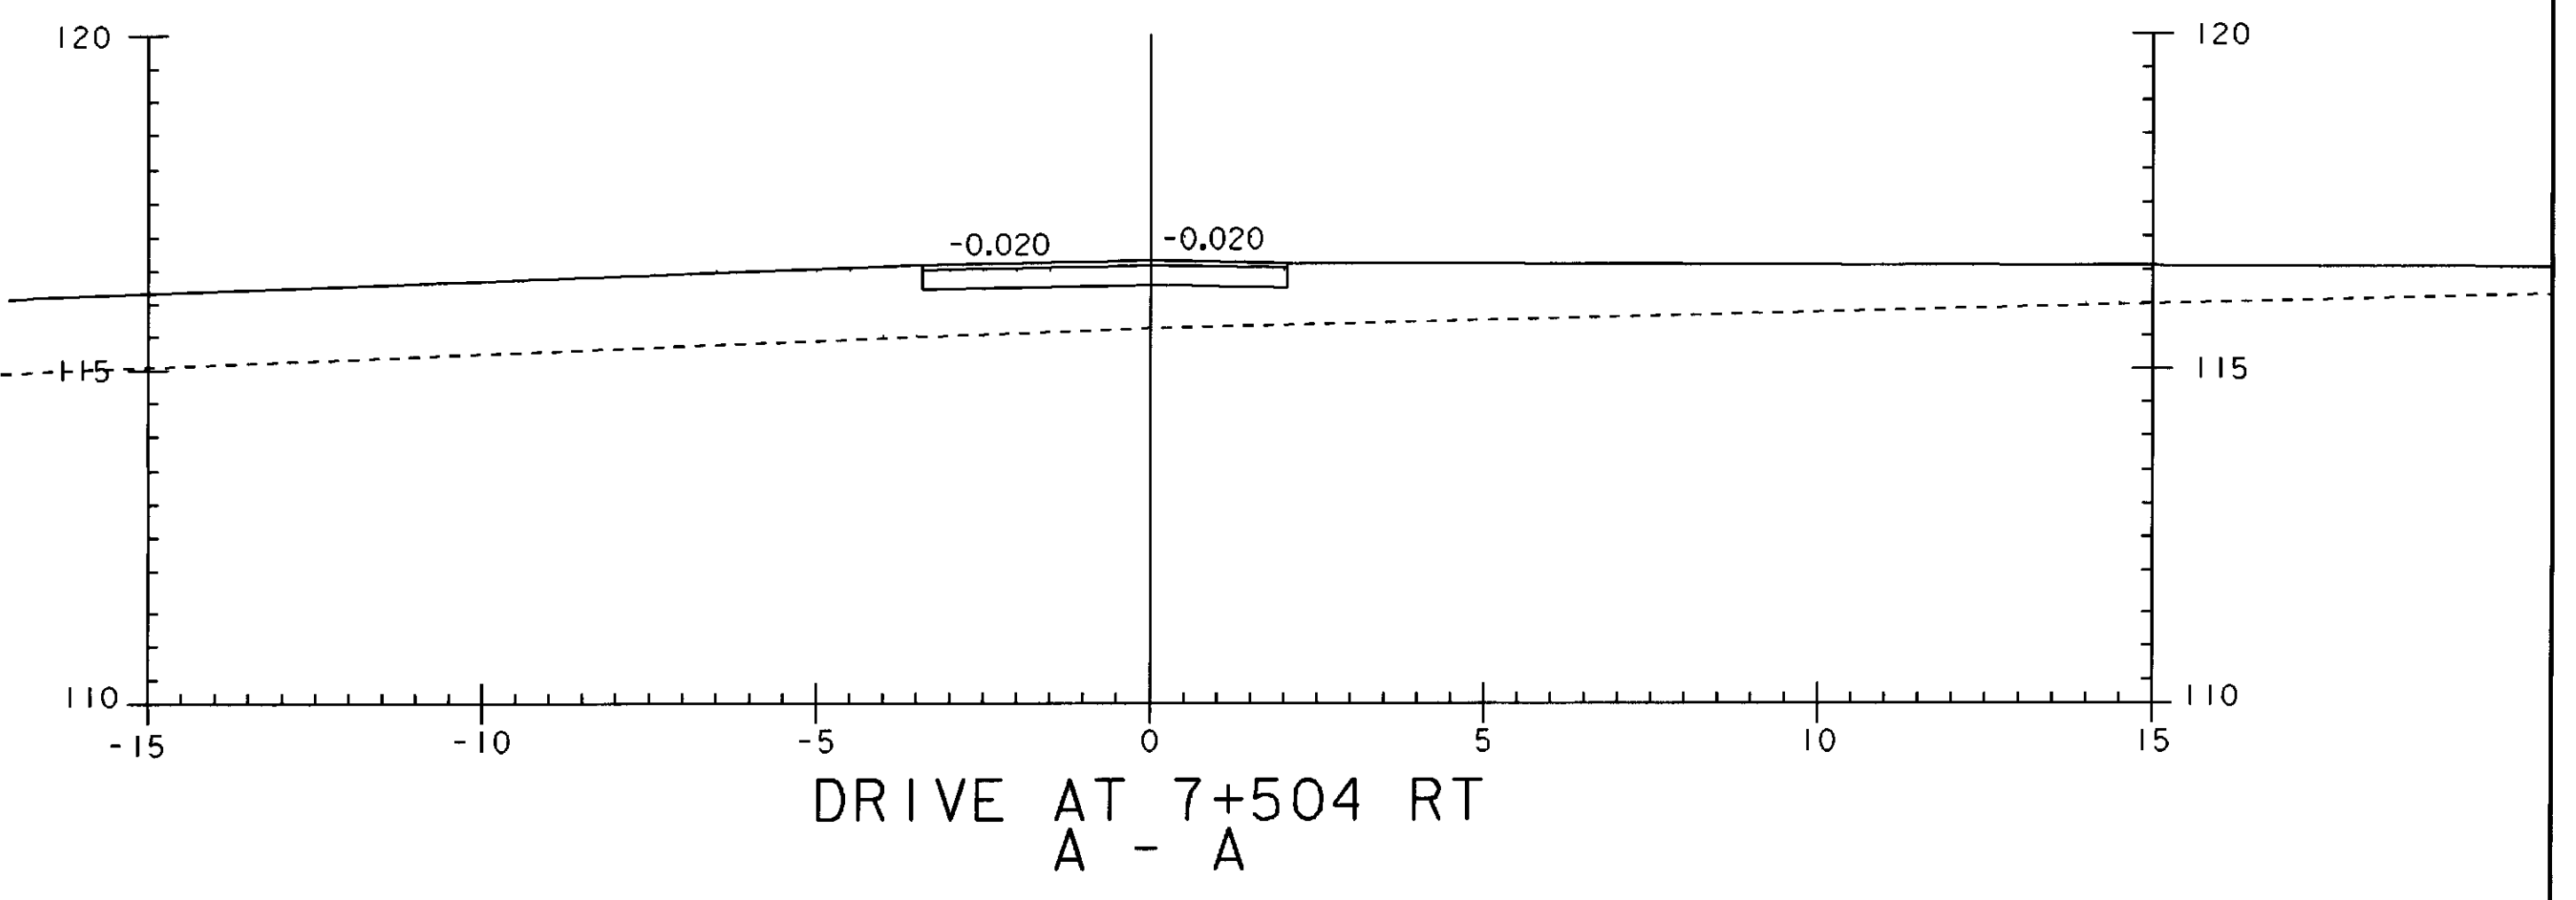

DRIVE AT 7+504 RT
A - A

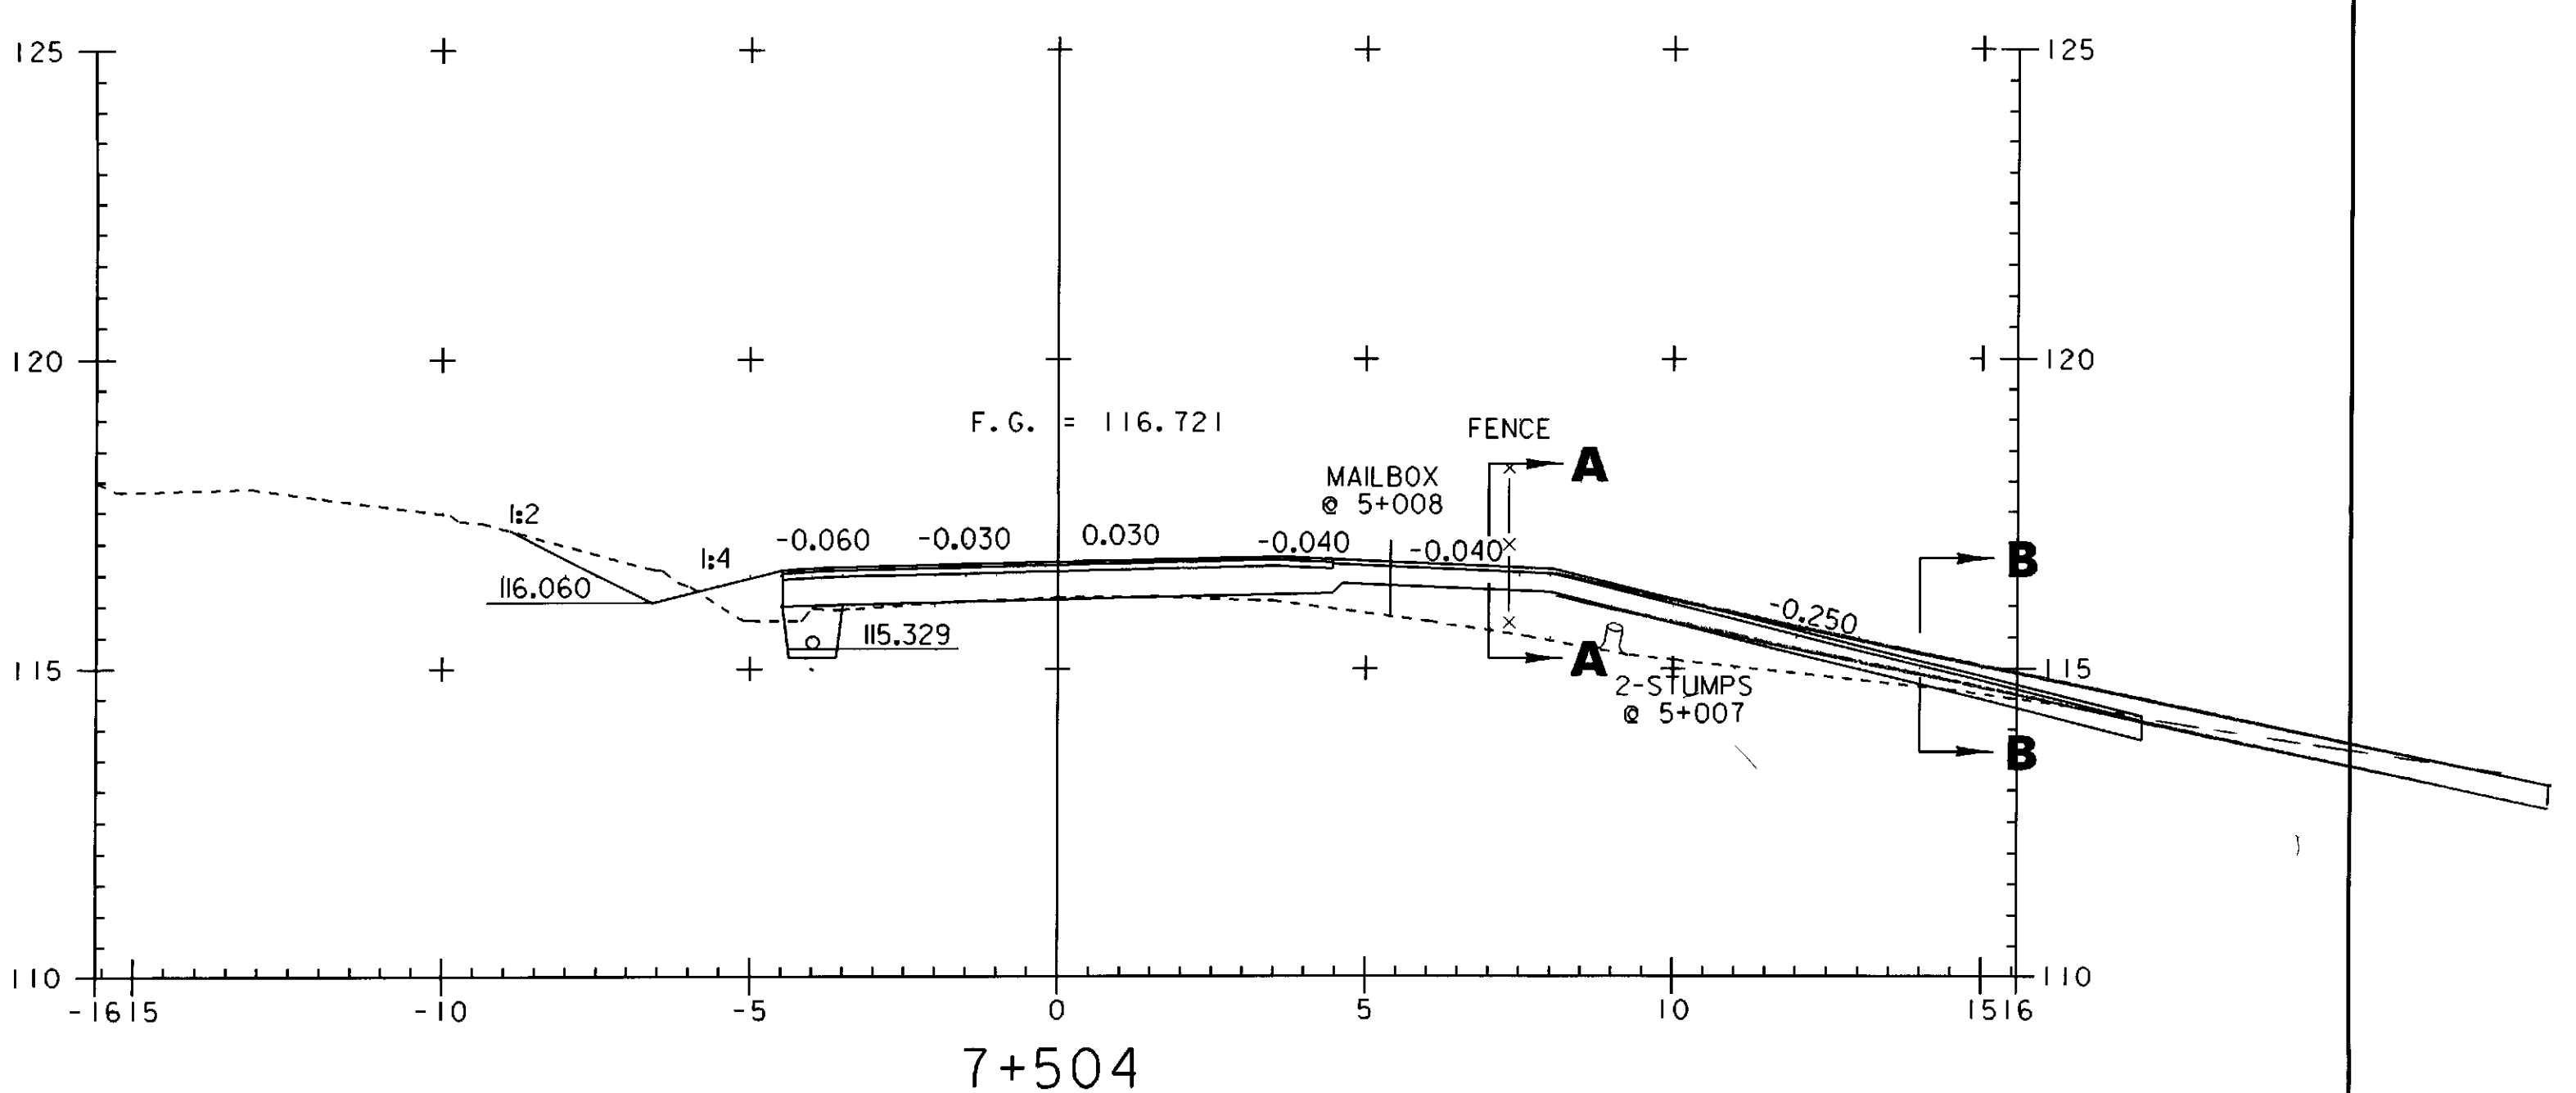

7+504



PROJECT NAME:	HIGHGATE - FRANKLIN
PROJECT NUMBER:	STP RS 0301(I) SA
FILE NAME:	...85c060\design\dc060x09.dgn
PROJECT LEADER:	DELLASANTA
DESIGNED BY:	SQUAD B
IPARM FILE NAME:	dc060x09I4.1
PLOT DATE:	09-MAY-2005
DRAWN BY:	SQUAD B
CHECKED BY:	SQUAD B
SHEET	399 OF 450