




7+660

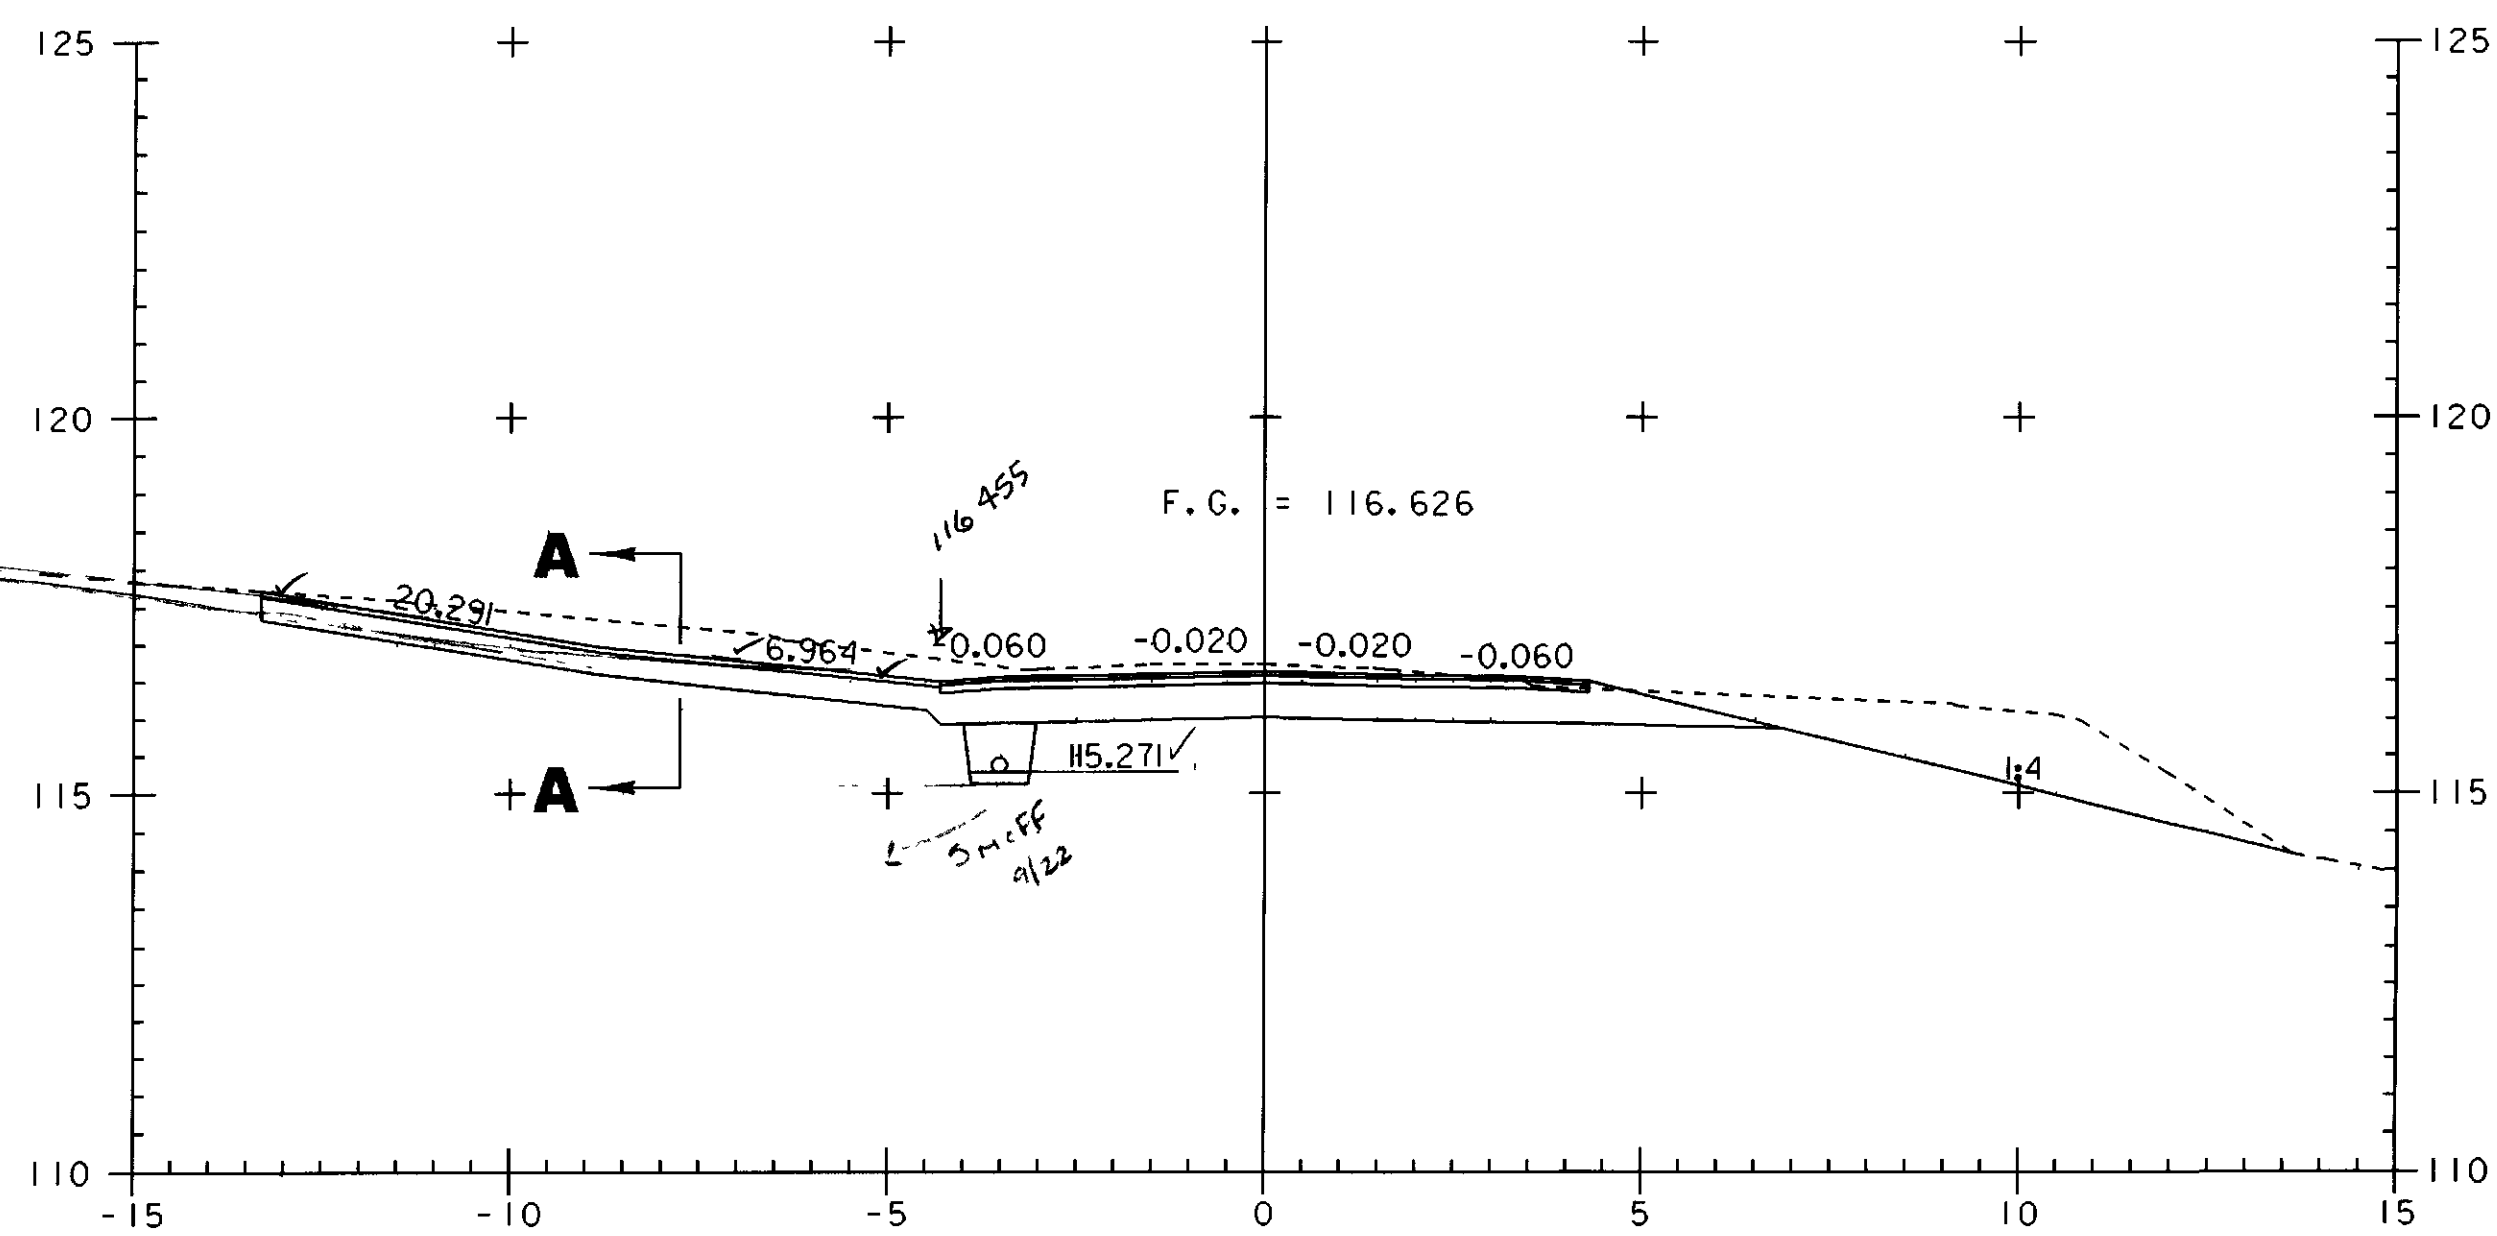

7+653

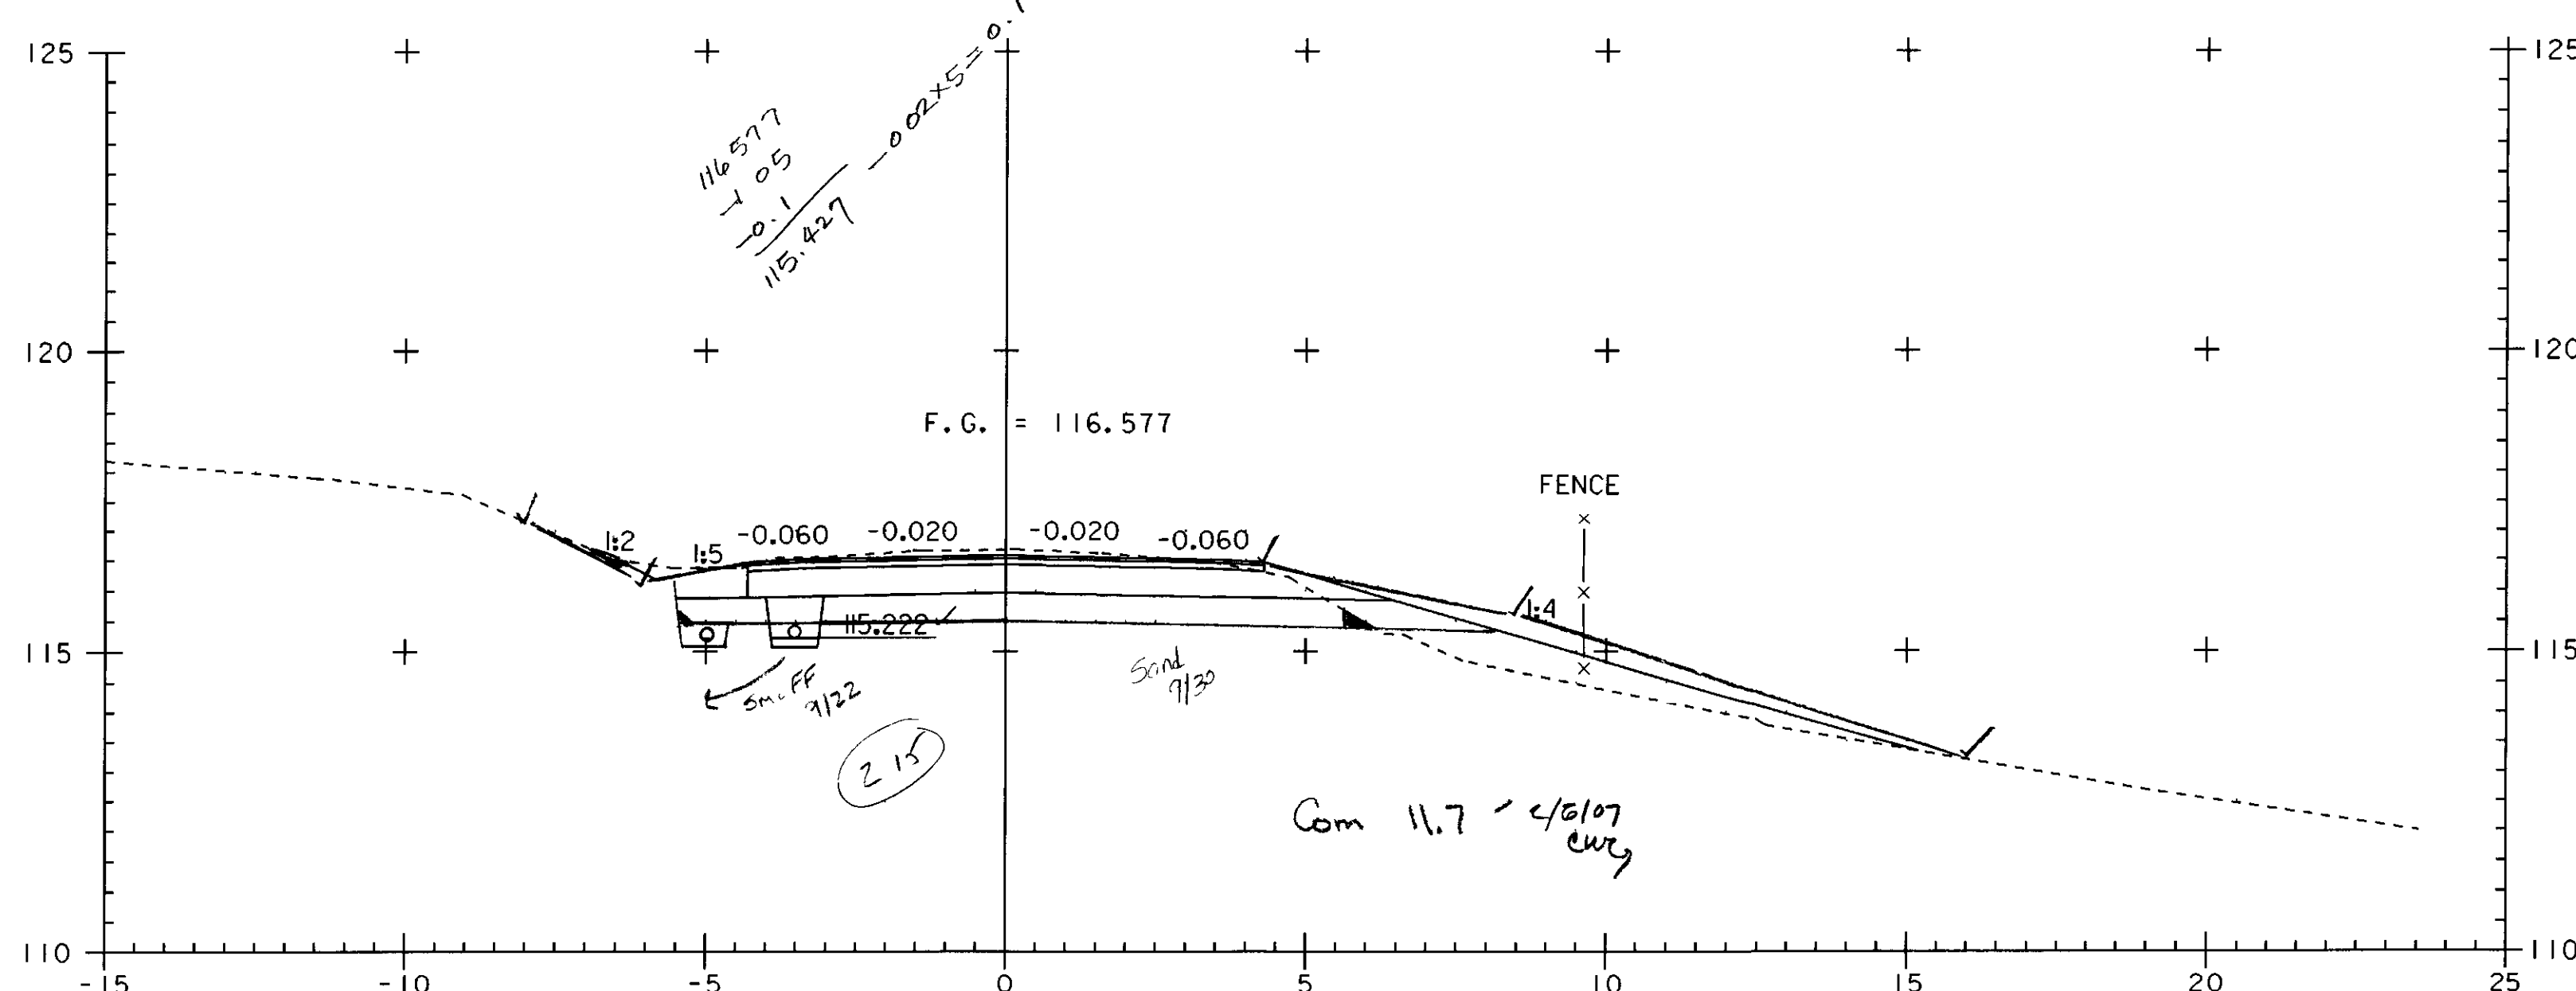

7+640

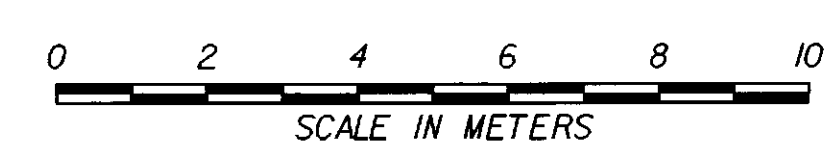

PROJECT NAME:	HIGHGATE - FRANKLIN	PLOT DATE:	09-MAY-2005
PROJECT NUMBER:	STP RS 030(K) SA	DRAWN BY:	SQUAD B
FILE NAME:	...85c060\design\dc060x09.dgn	DESIGNED BY:	SQUAD B
		CHECKED BY:	SQUAD B
		SHEET	403 OF 450