




SECTION A - A

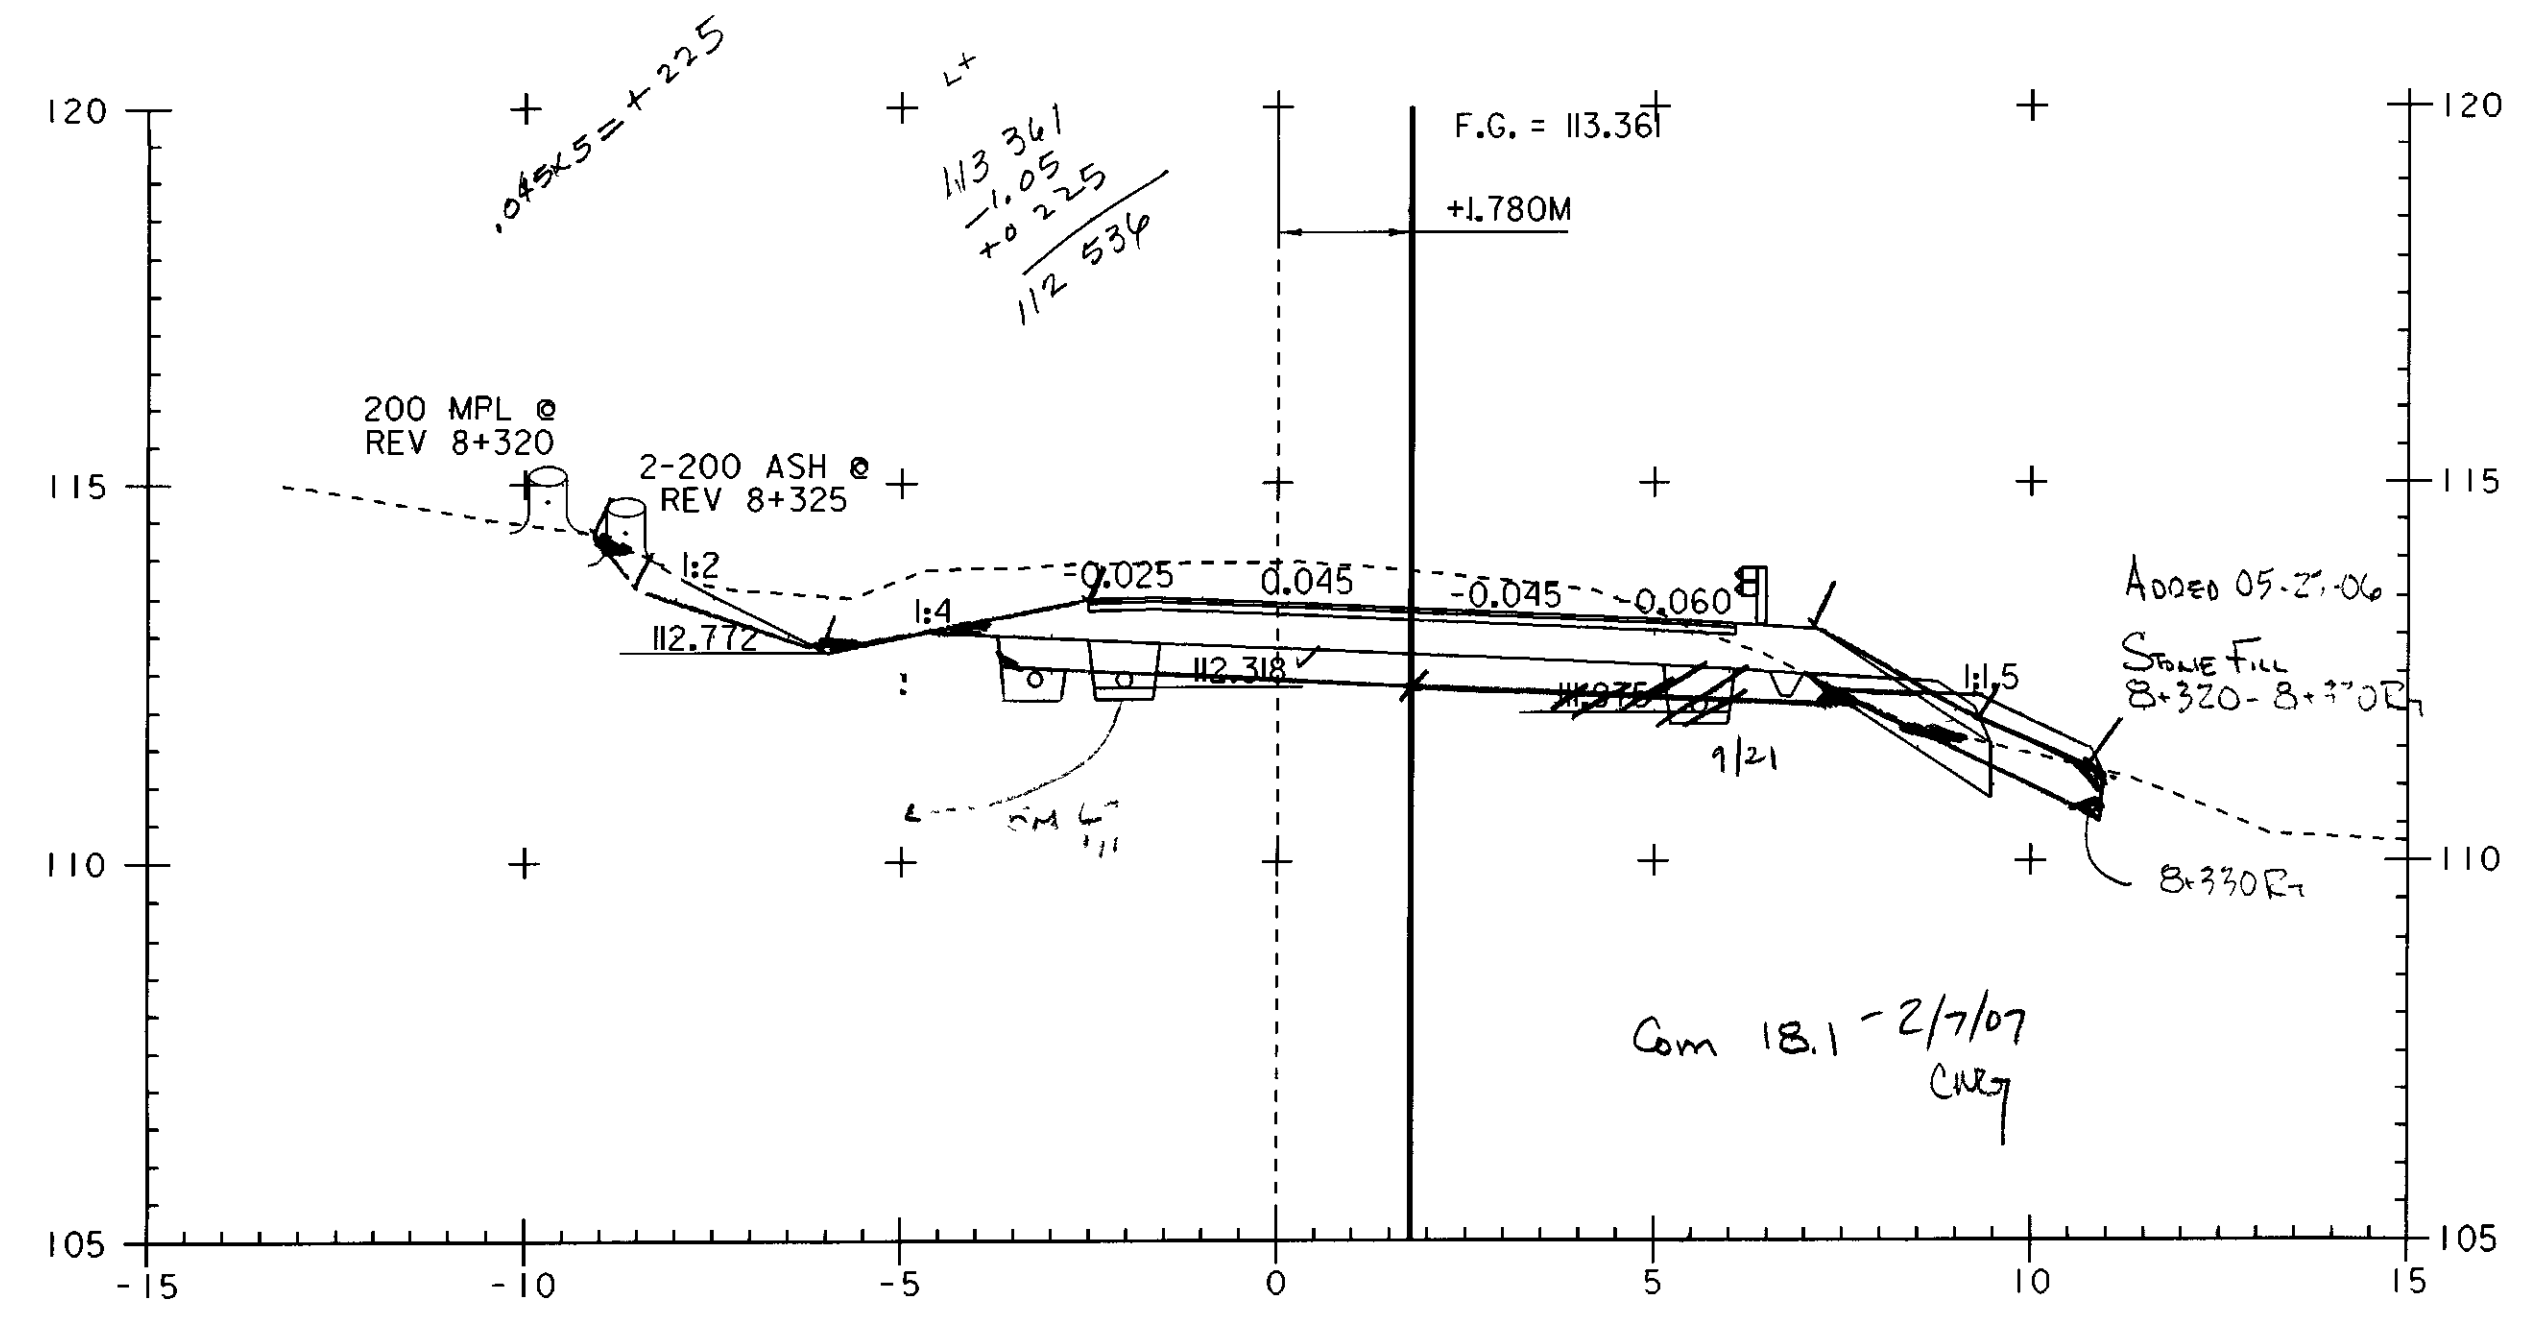


8+320 =
REV 8+319.840

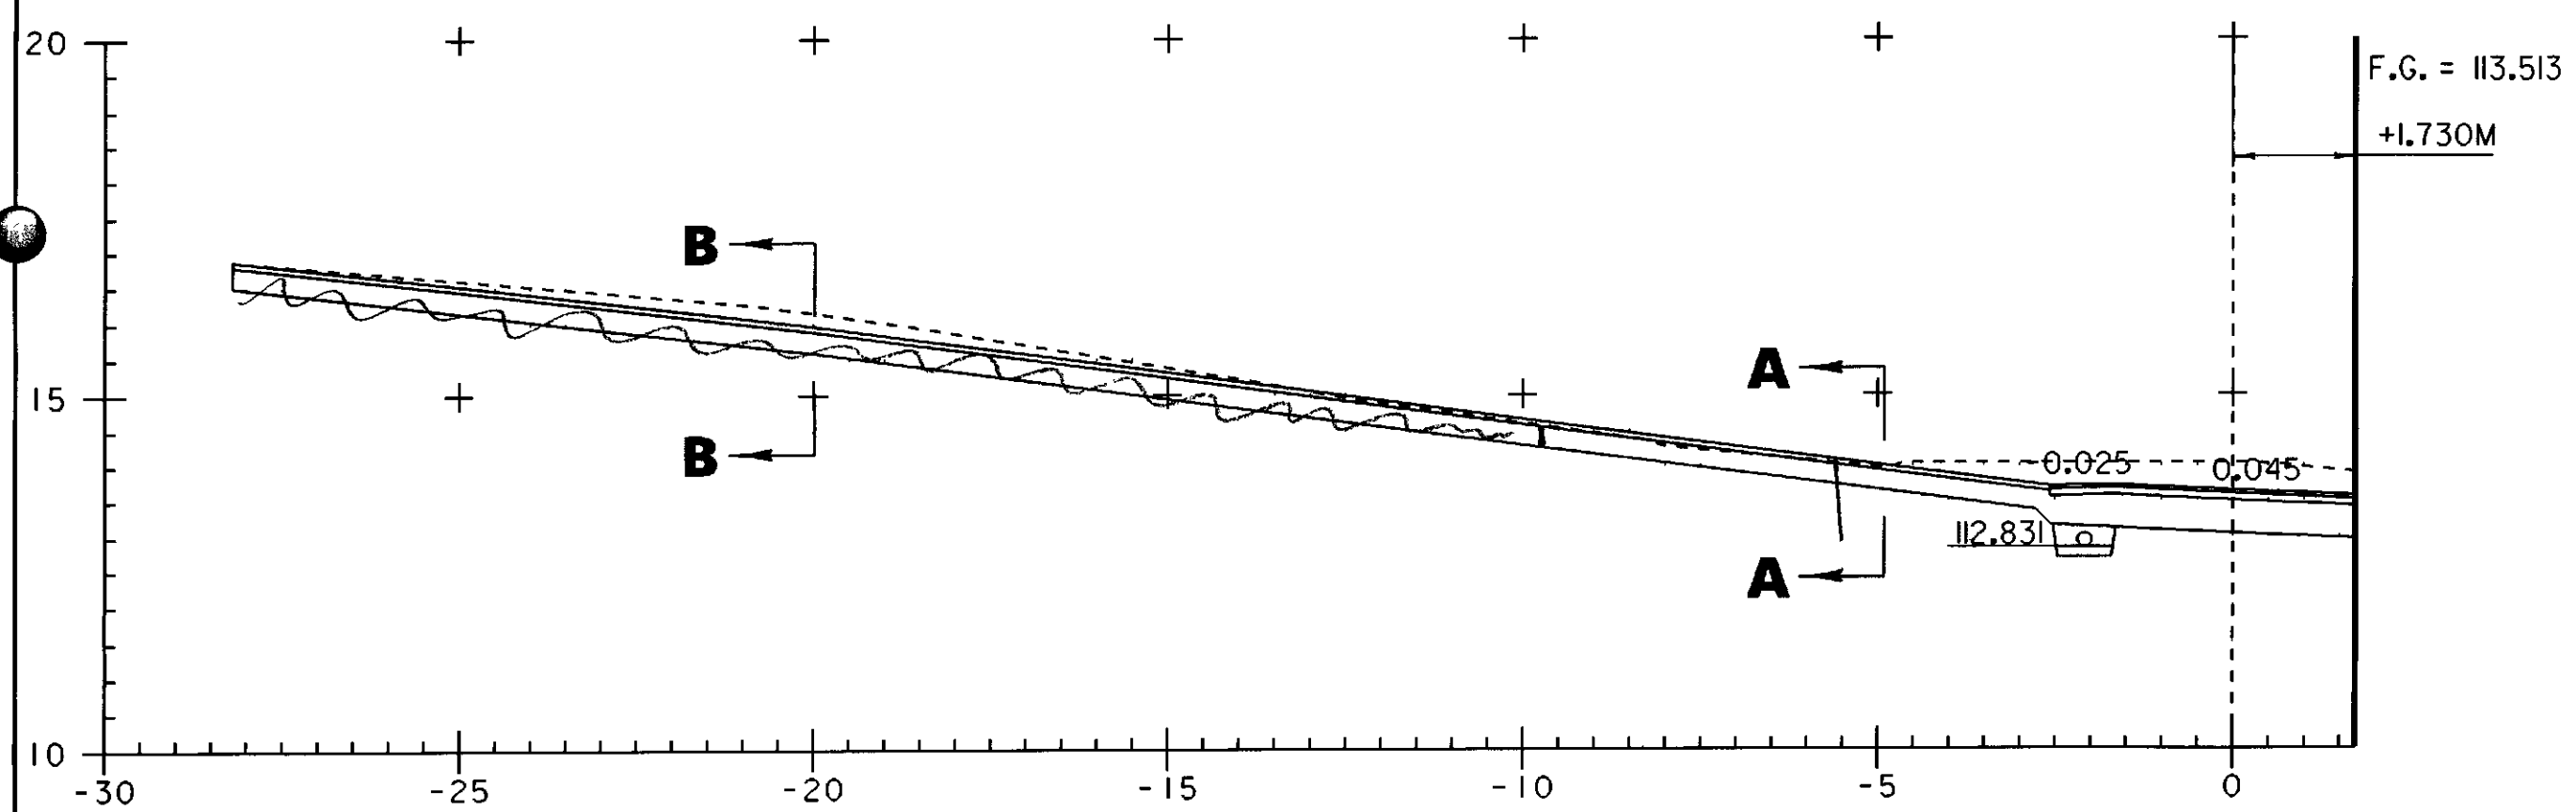

8+314.440 =
REV 8+309.000

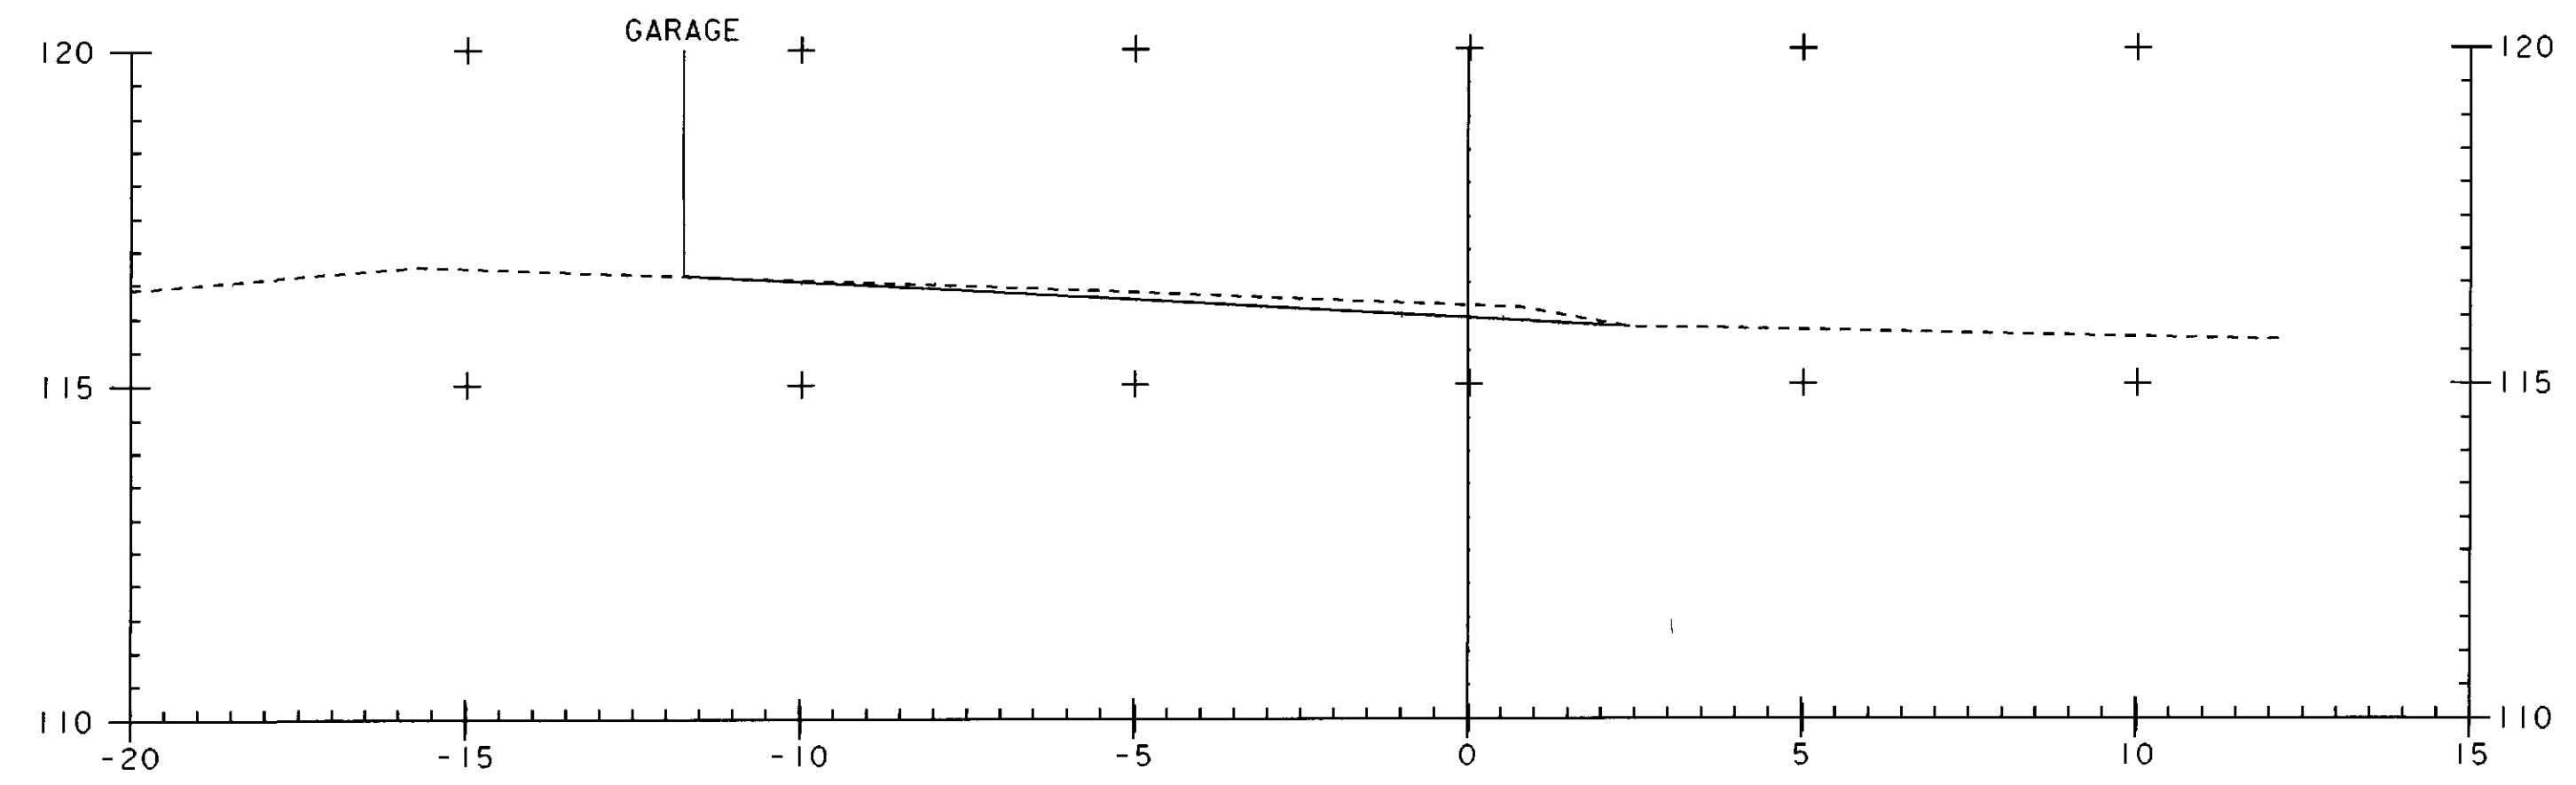

SECTION B - B

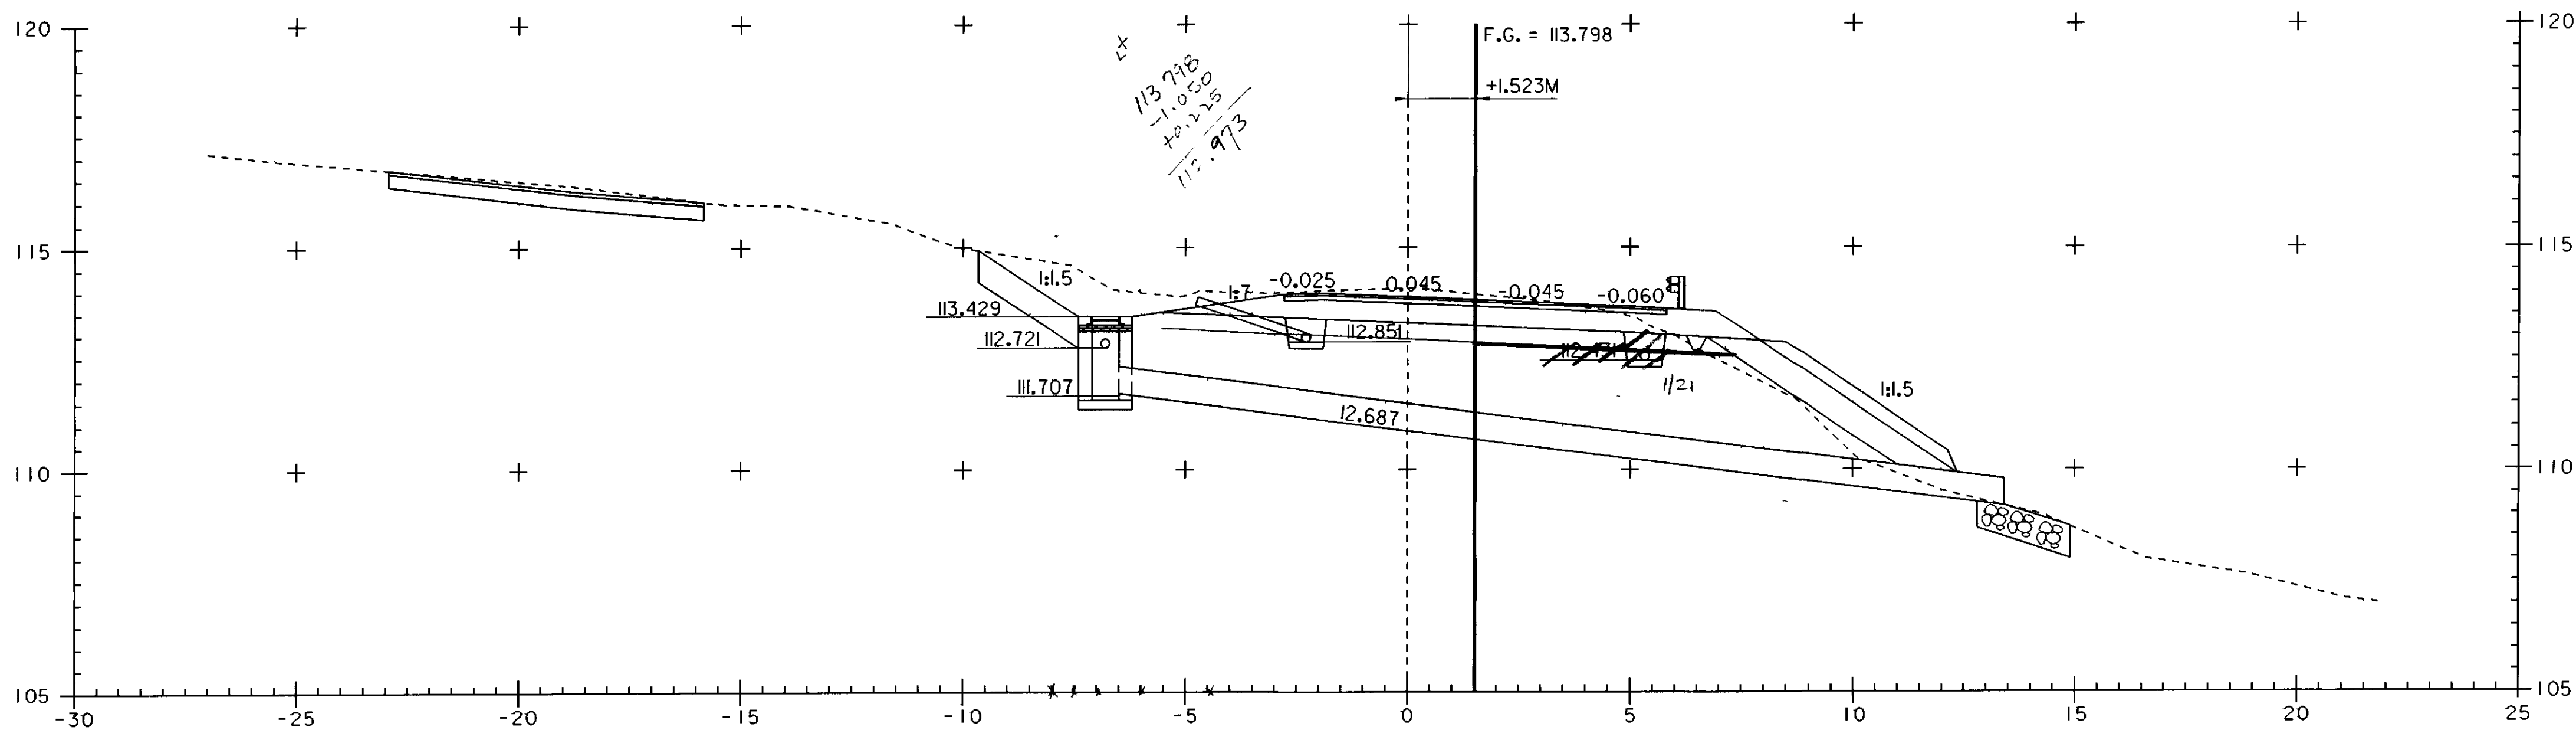

8+303 =
REV 8+303.150



PROJECT NAME:	HIGHGATE - FRANKLIN	FILE NAME:	...85c060\design\dc060x10.dgn	PLOT DATE:	09-MAY-2005
PROJECT NUMBER:	STP RS 030(I) SA	PROJECT LEADER:	DELLASANTA	DRAWN BY:	SQUAD B
		DESIGNED BY:	SQUAD B	CHECKED BY:	SQUAD B
		IPARM FILE NAME:	dc060x10i2.1	SHEET	416 OF 450