




8+352.850 =
REV 8+352.570 LT

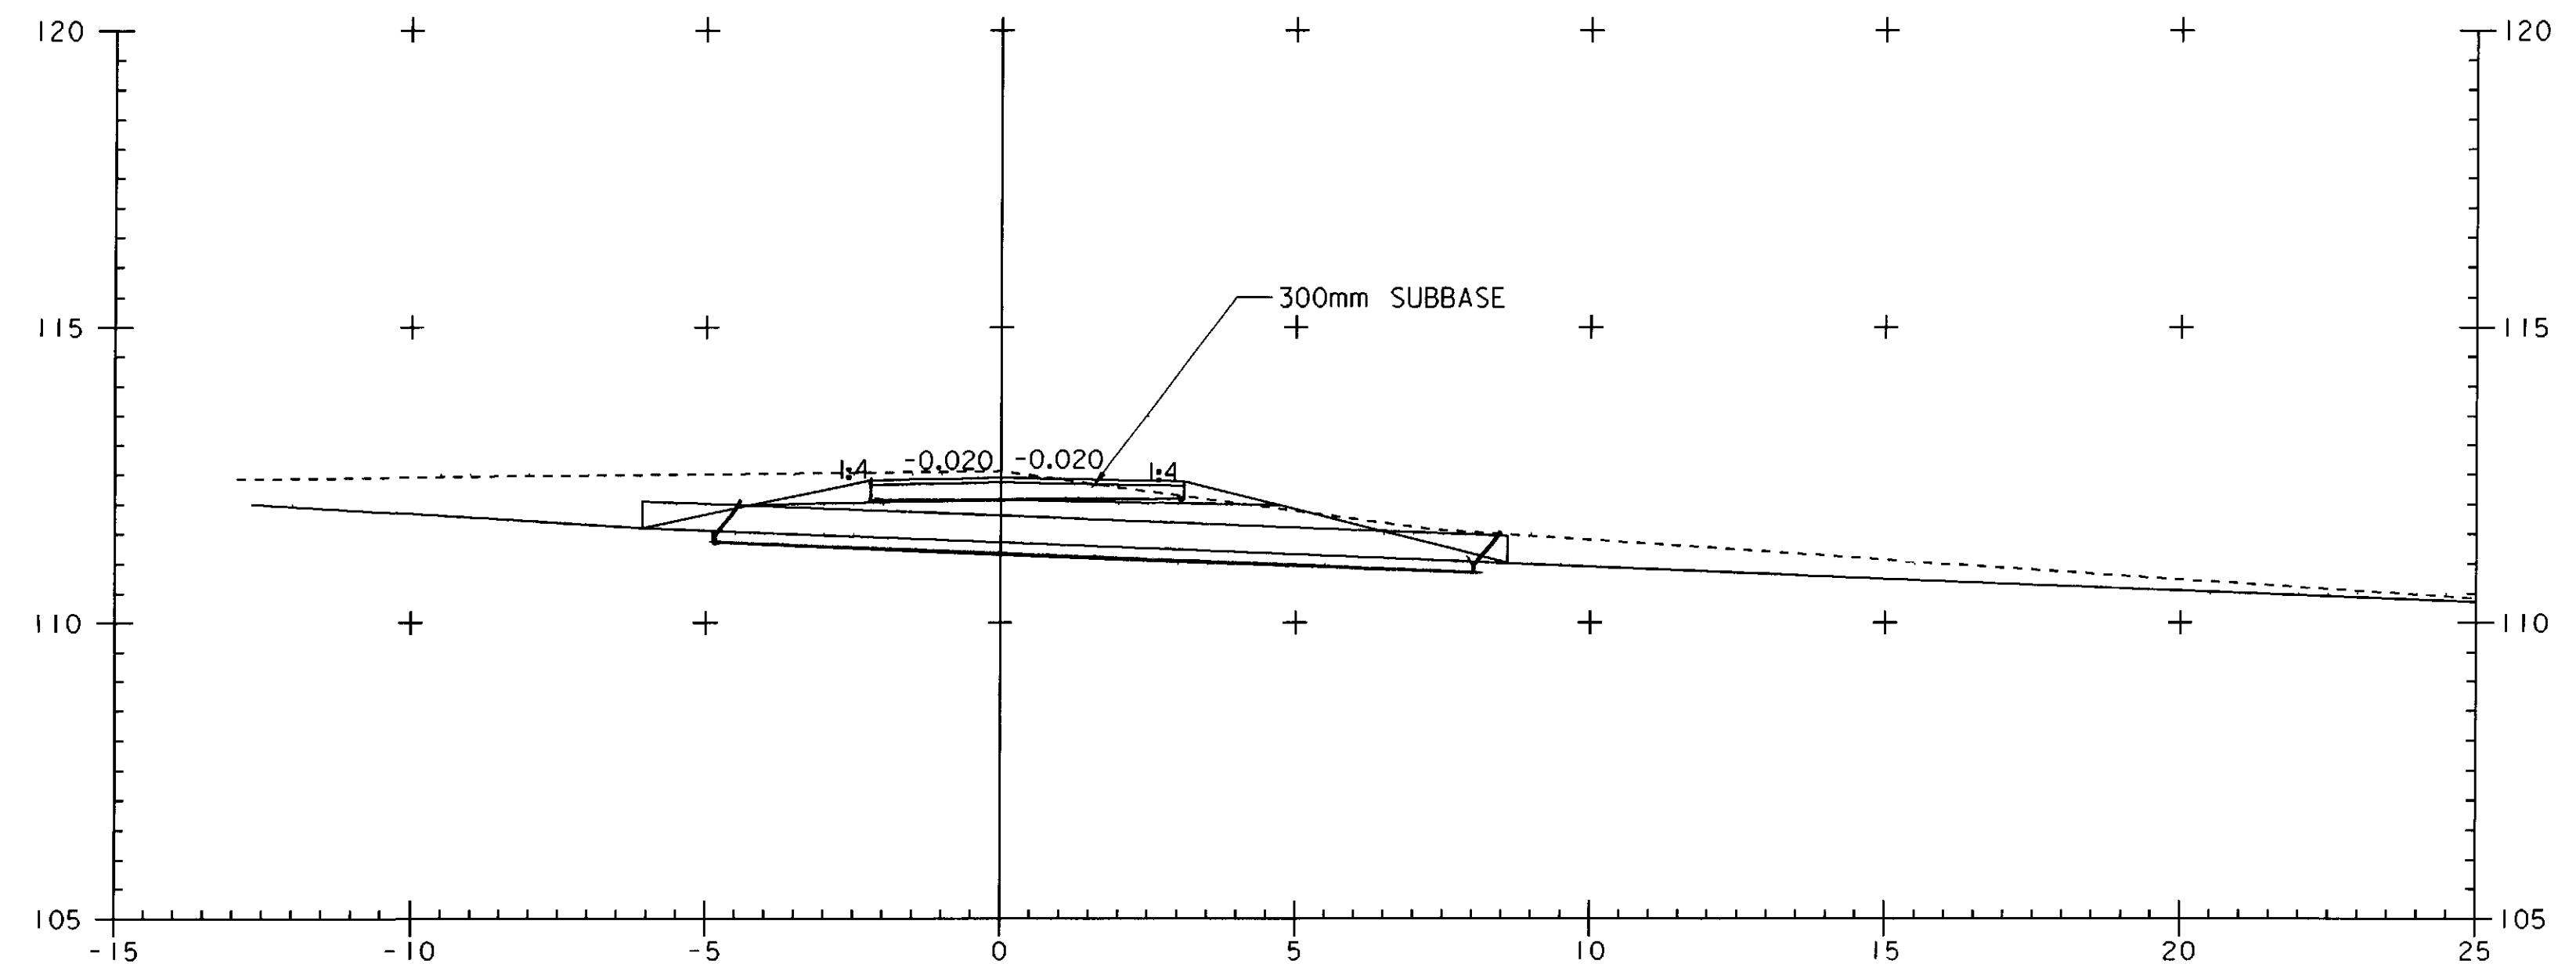

SECTION A - A
REV 8+352.570 LT

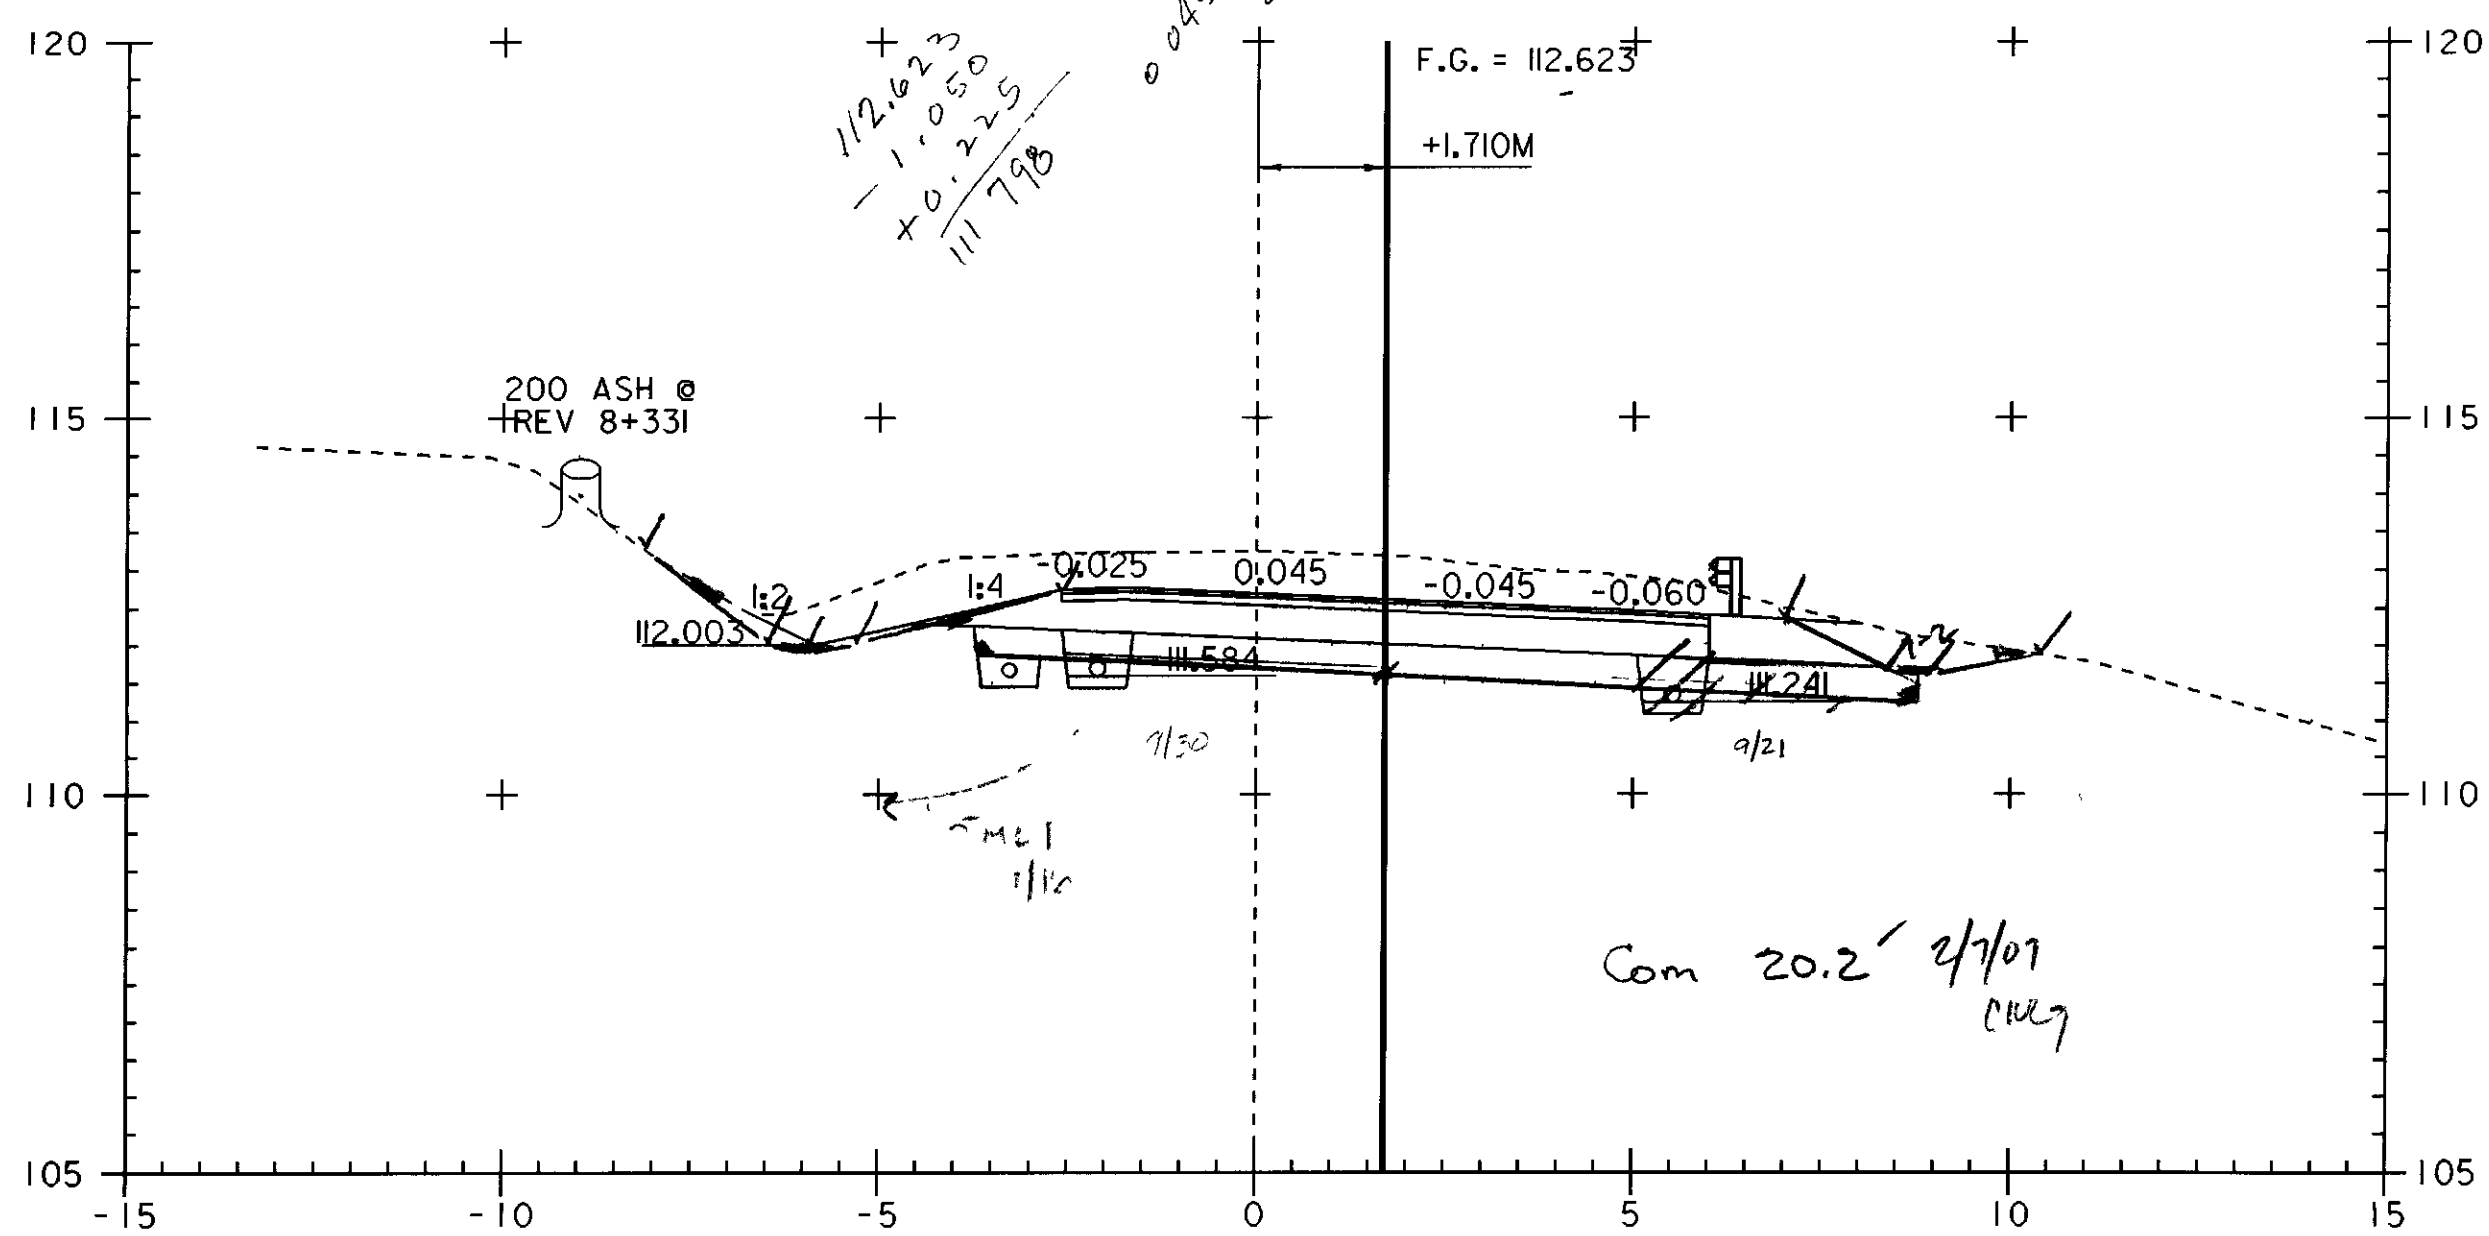

8+340 =
REV 8+339.720

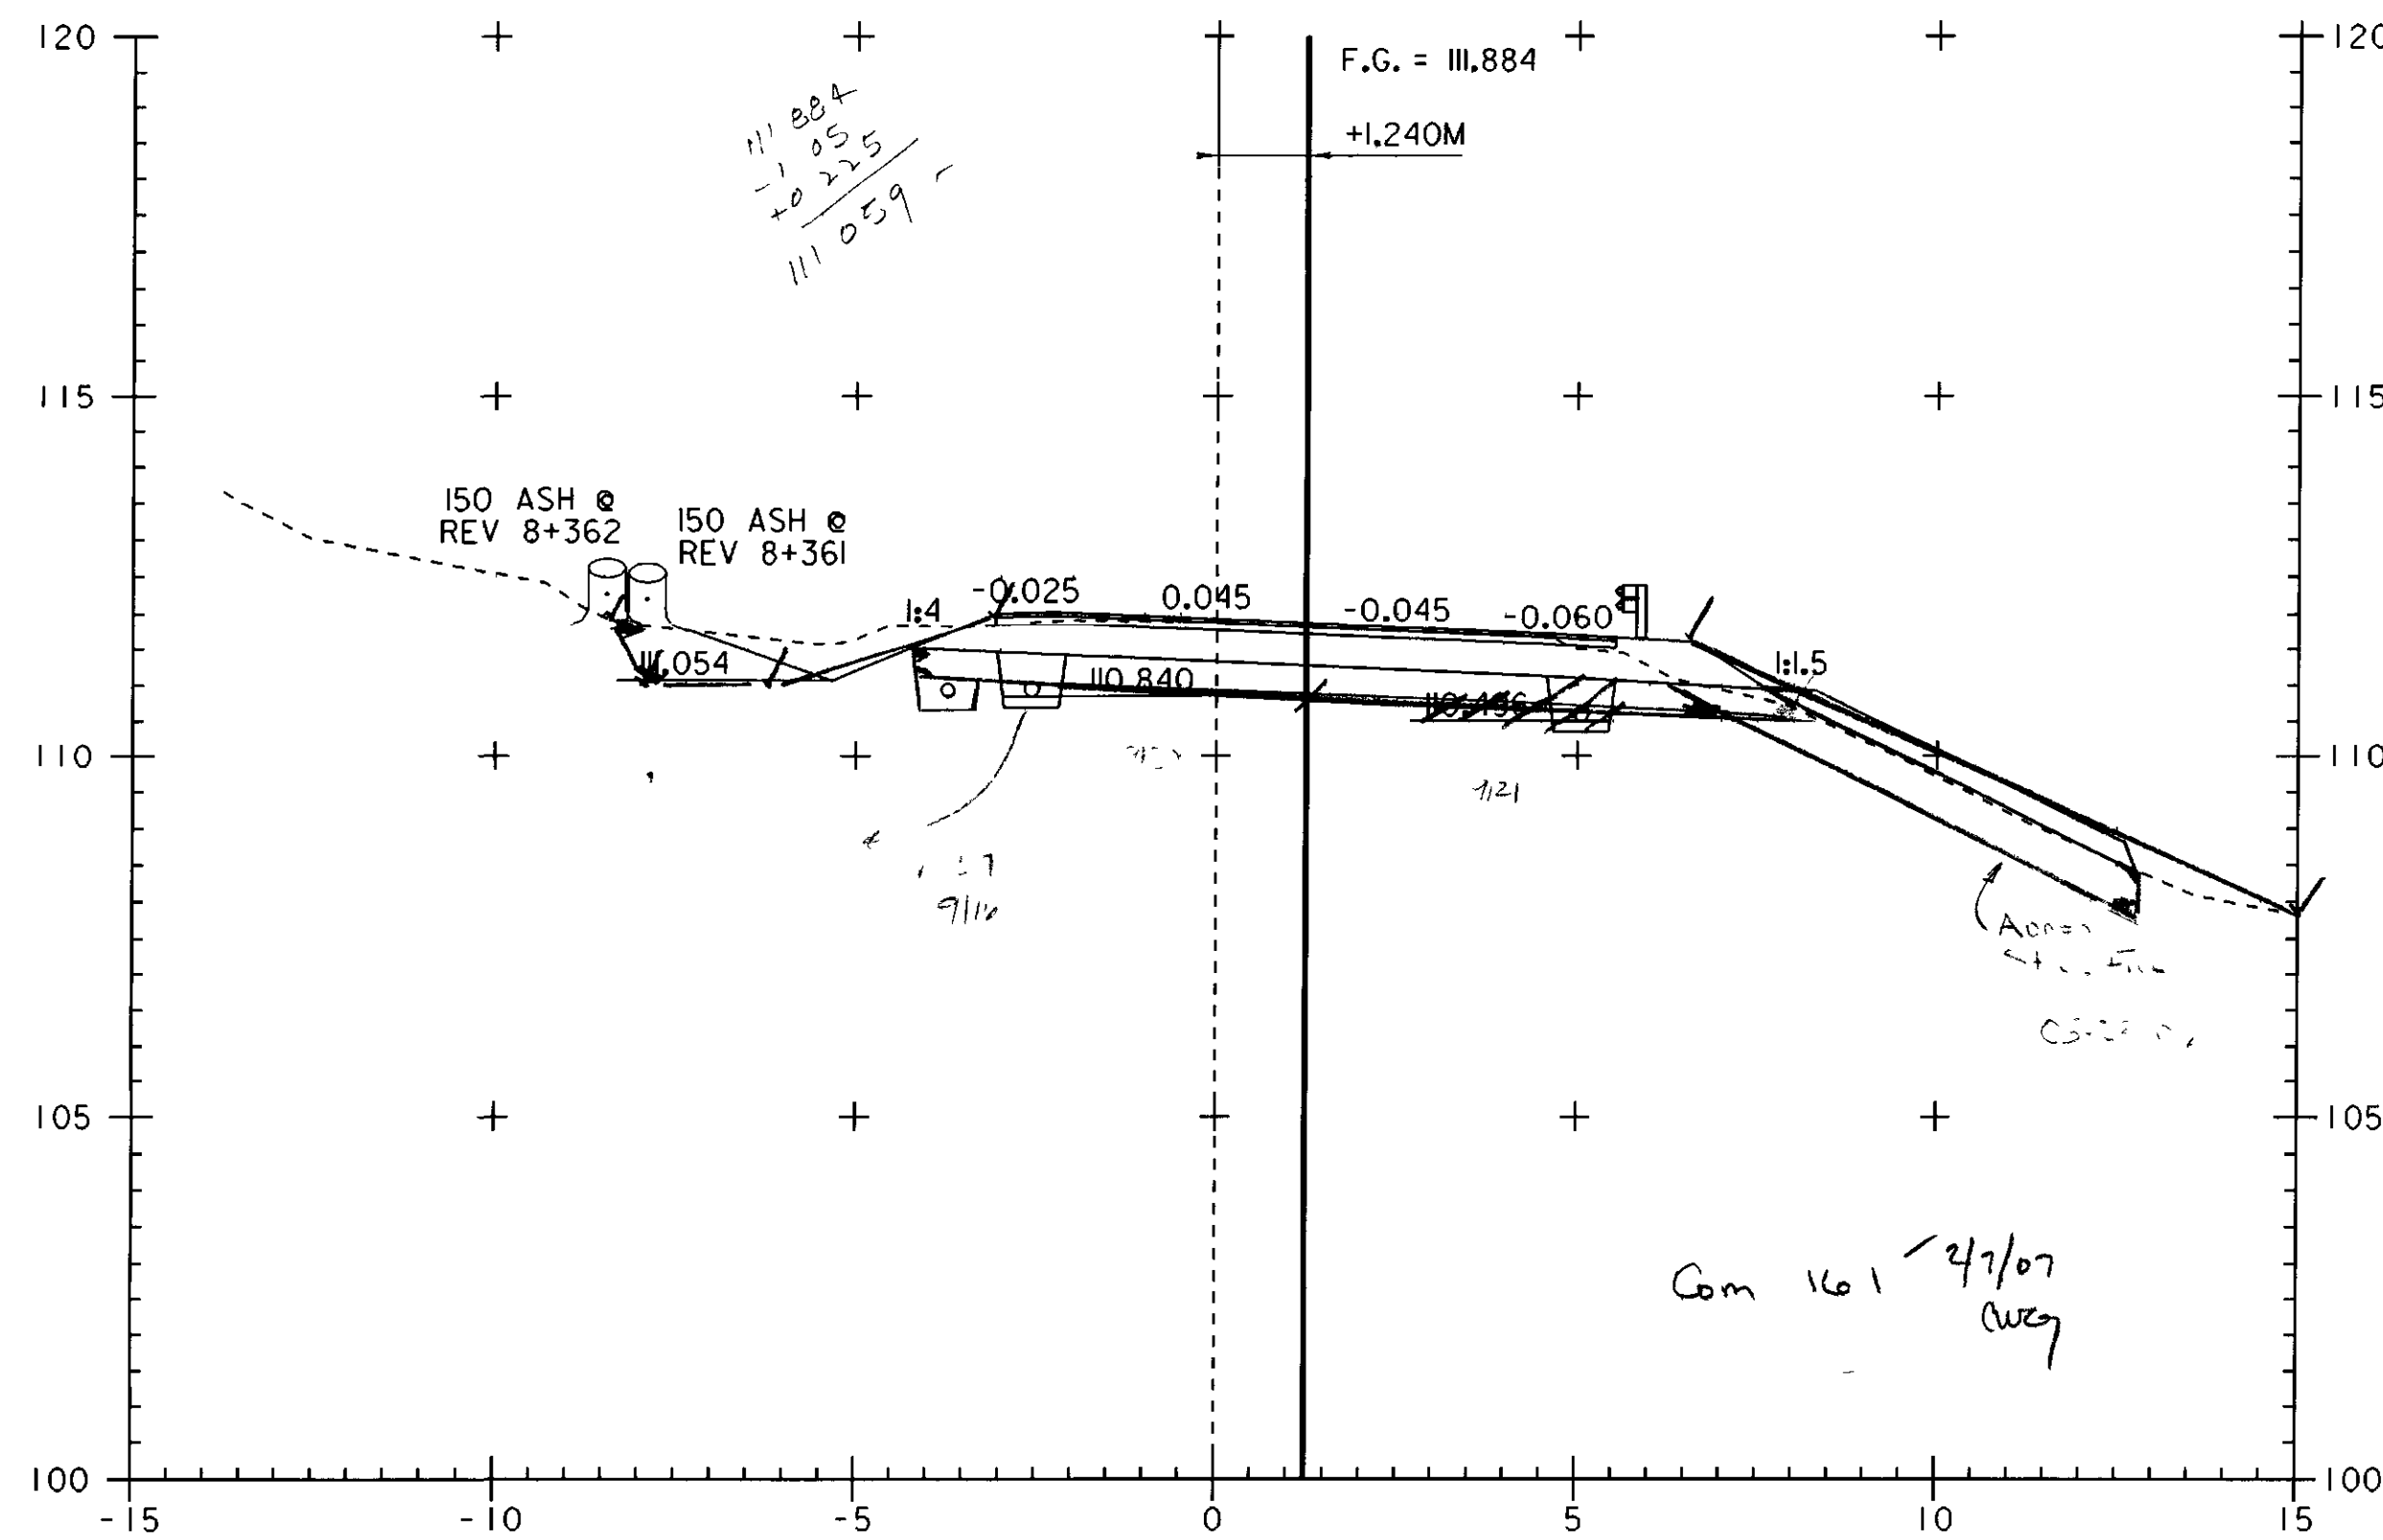

8+360 =
REV 8+359.630



PROJECT NAME:	HIGHGATE - FRANKLIN
PROJECT NUMBER:	STP RS 030(I) SA
FILE NAME:	...85c060\design\dc060x10.dgn
PROJECT LEADER:	DELLASANTA
DESIGNED BY:	SQUAD B
IPARM FILE NAME:	dc060x10i3.i
PLOT DATE:	09-MAY-2005
DRAWN BY:	SQUAD B
CHECKED BY:	SQUAD B
SHEET	417 OF 450