


8+380 =
REV 8+379.590



8+372.000 =
REV 8+371.600

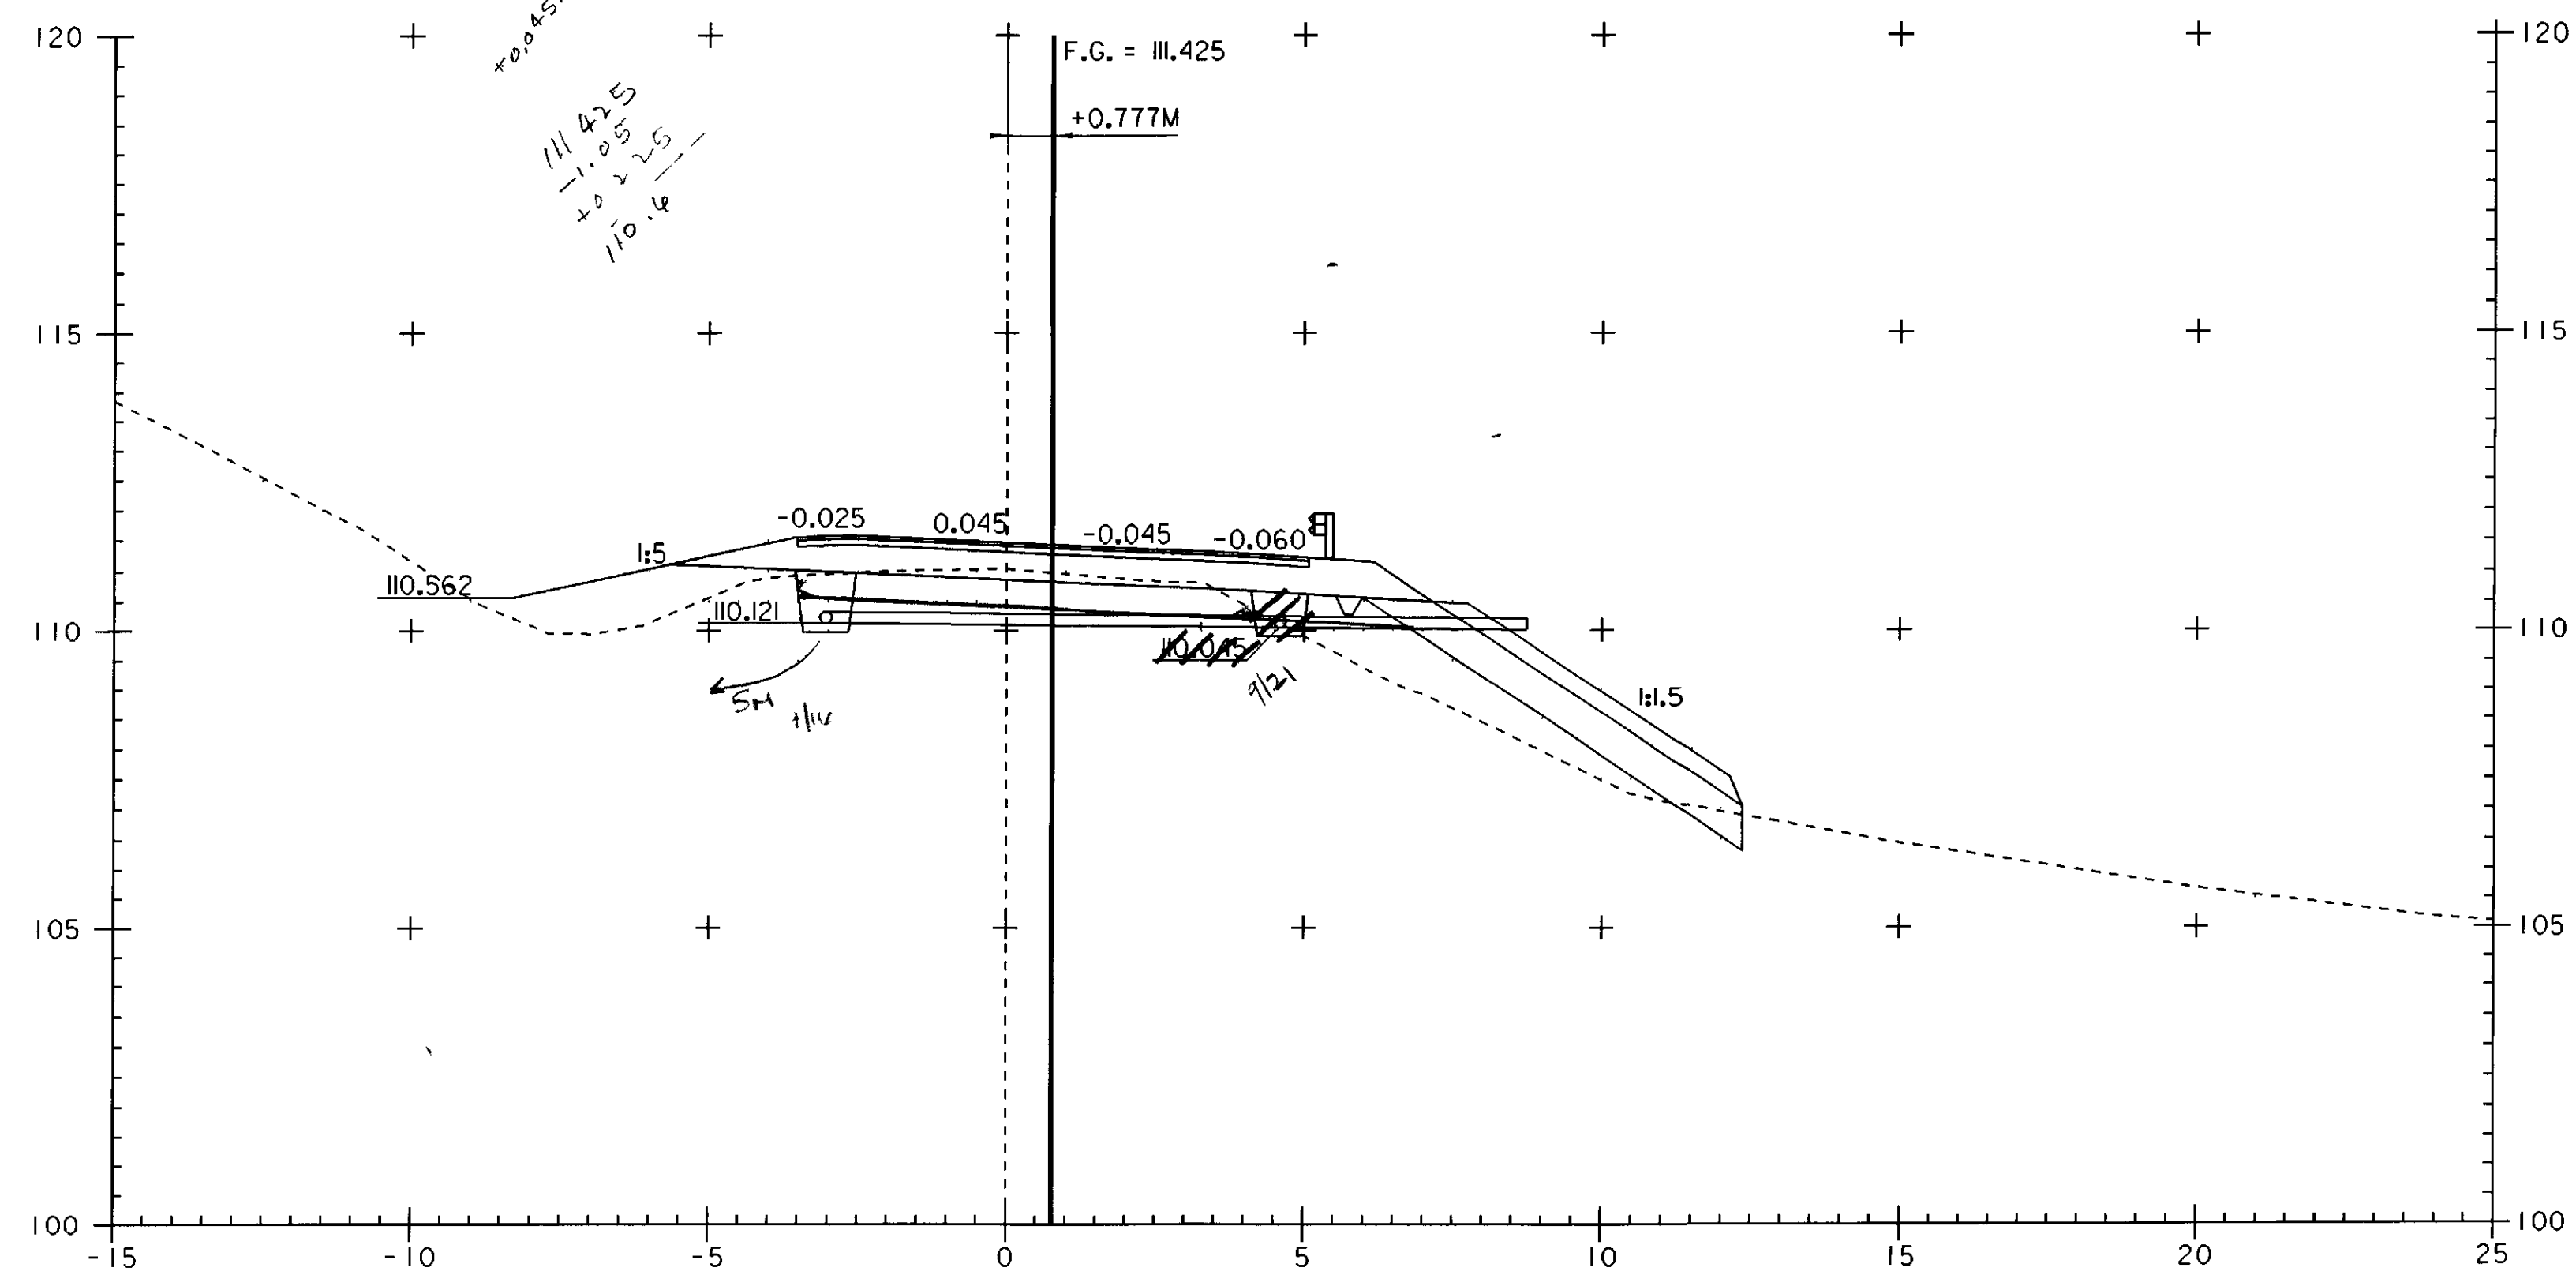

PROJECT NAME: HIGHGATE - FRANKLIN
PROJECT NUMBER: STP RS 030(I) SA

FILE NAME: ...85c060\design\dc060x10.dgn PLOT DATE: 09-MAY-2005
PROJECT LEADER: DELLASANTA DRAWN BY: SQUAD B
DESIGNED BY: SQUAD B CHECKED BY: SQUAD B
IPARM FILE NAME: dc060x10i4.1 SHEET 418 OF 450