



SECTION A - A
8+412 LT

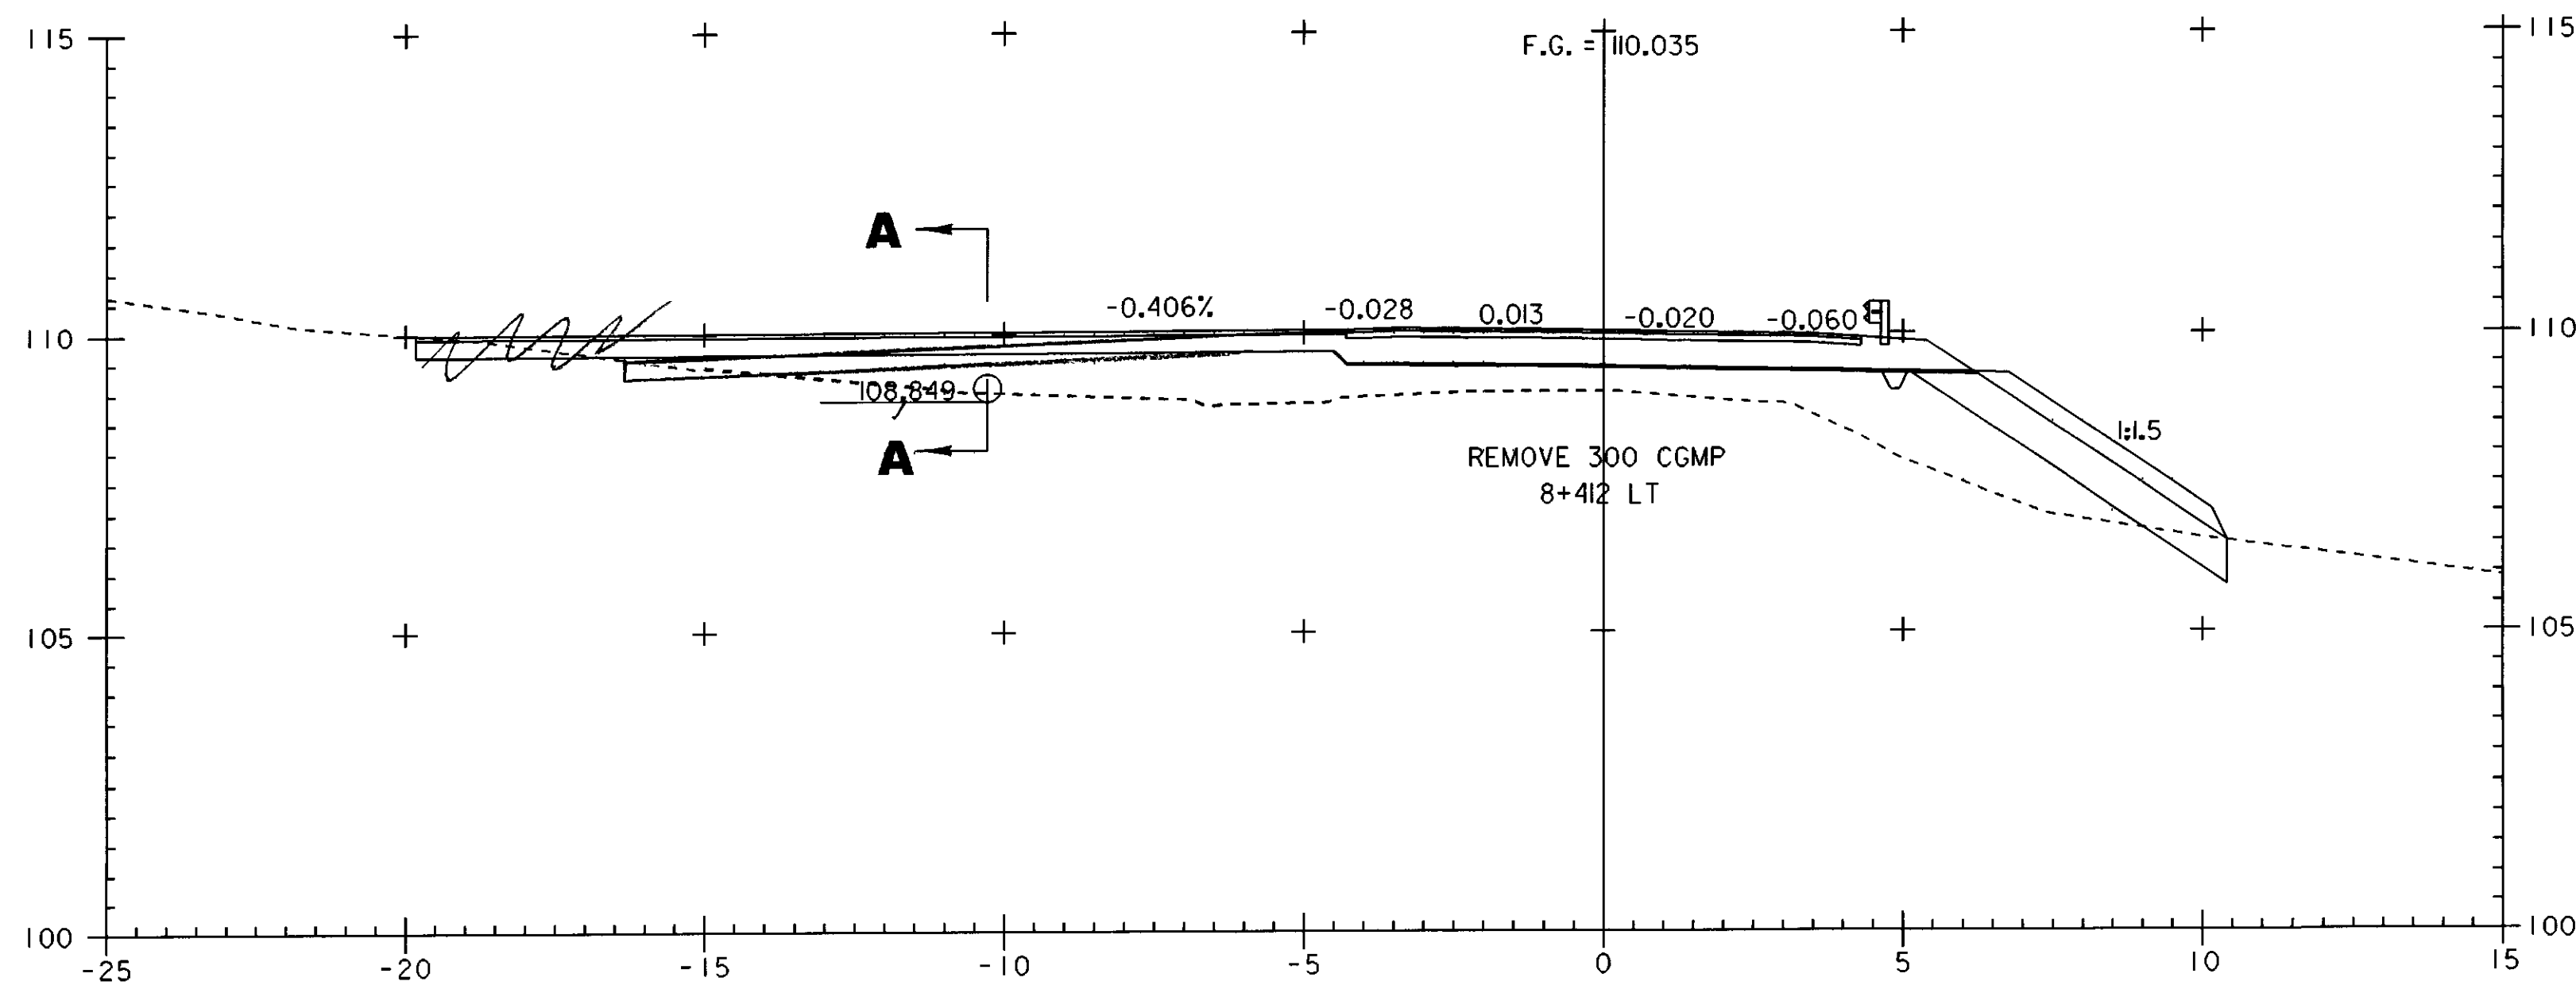

8+412 LT

STA 8+412.800 BEGIN TAPER

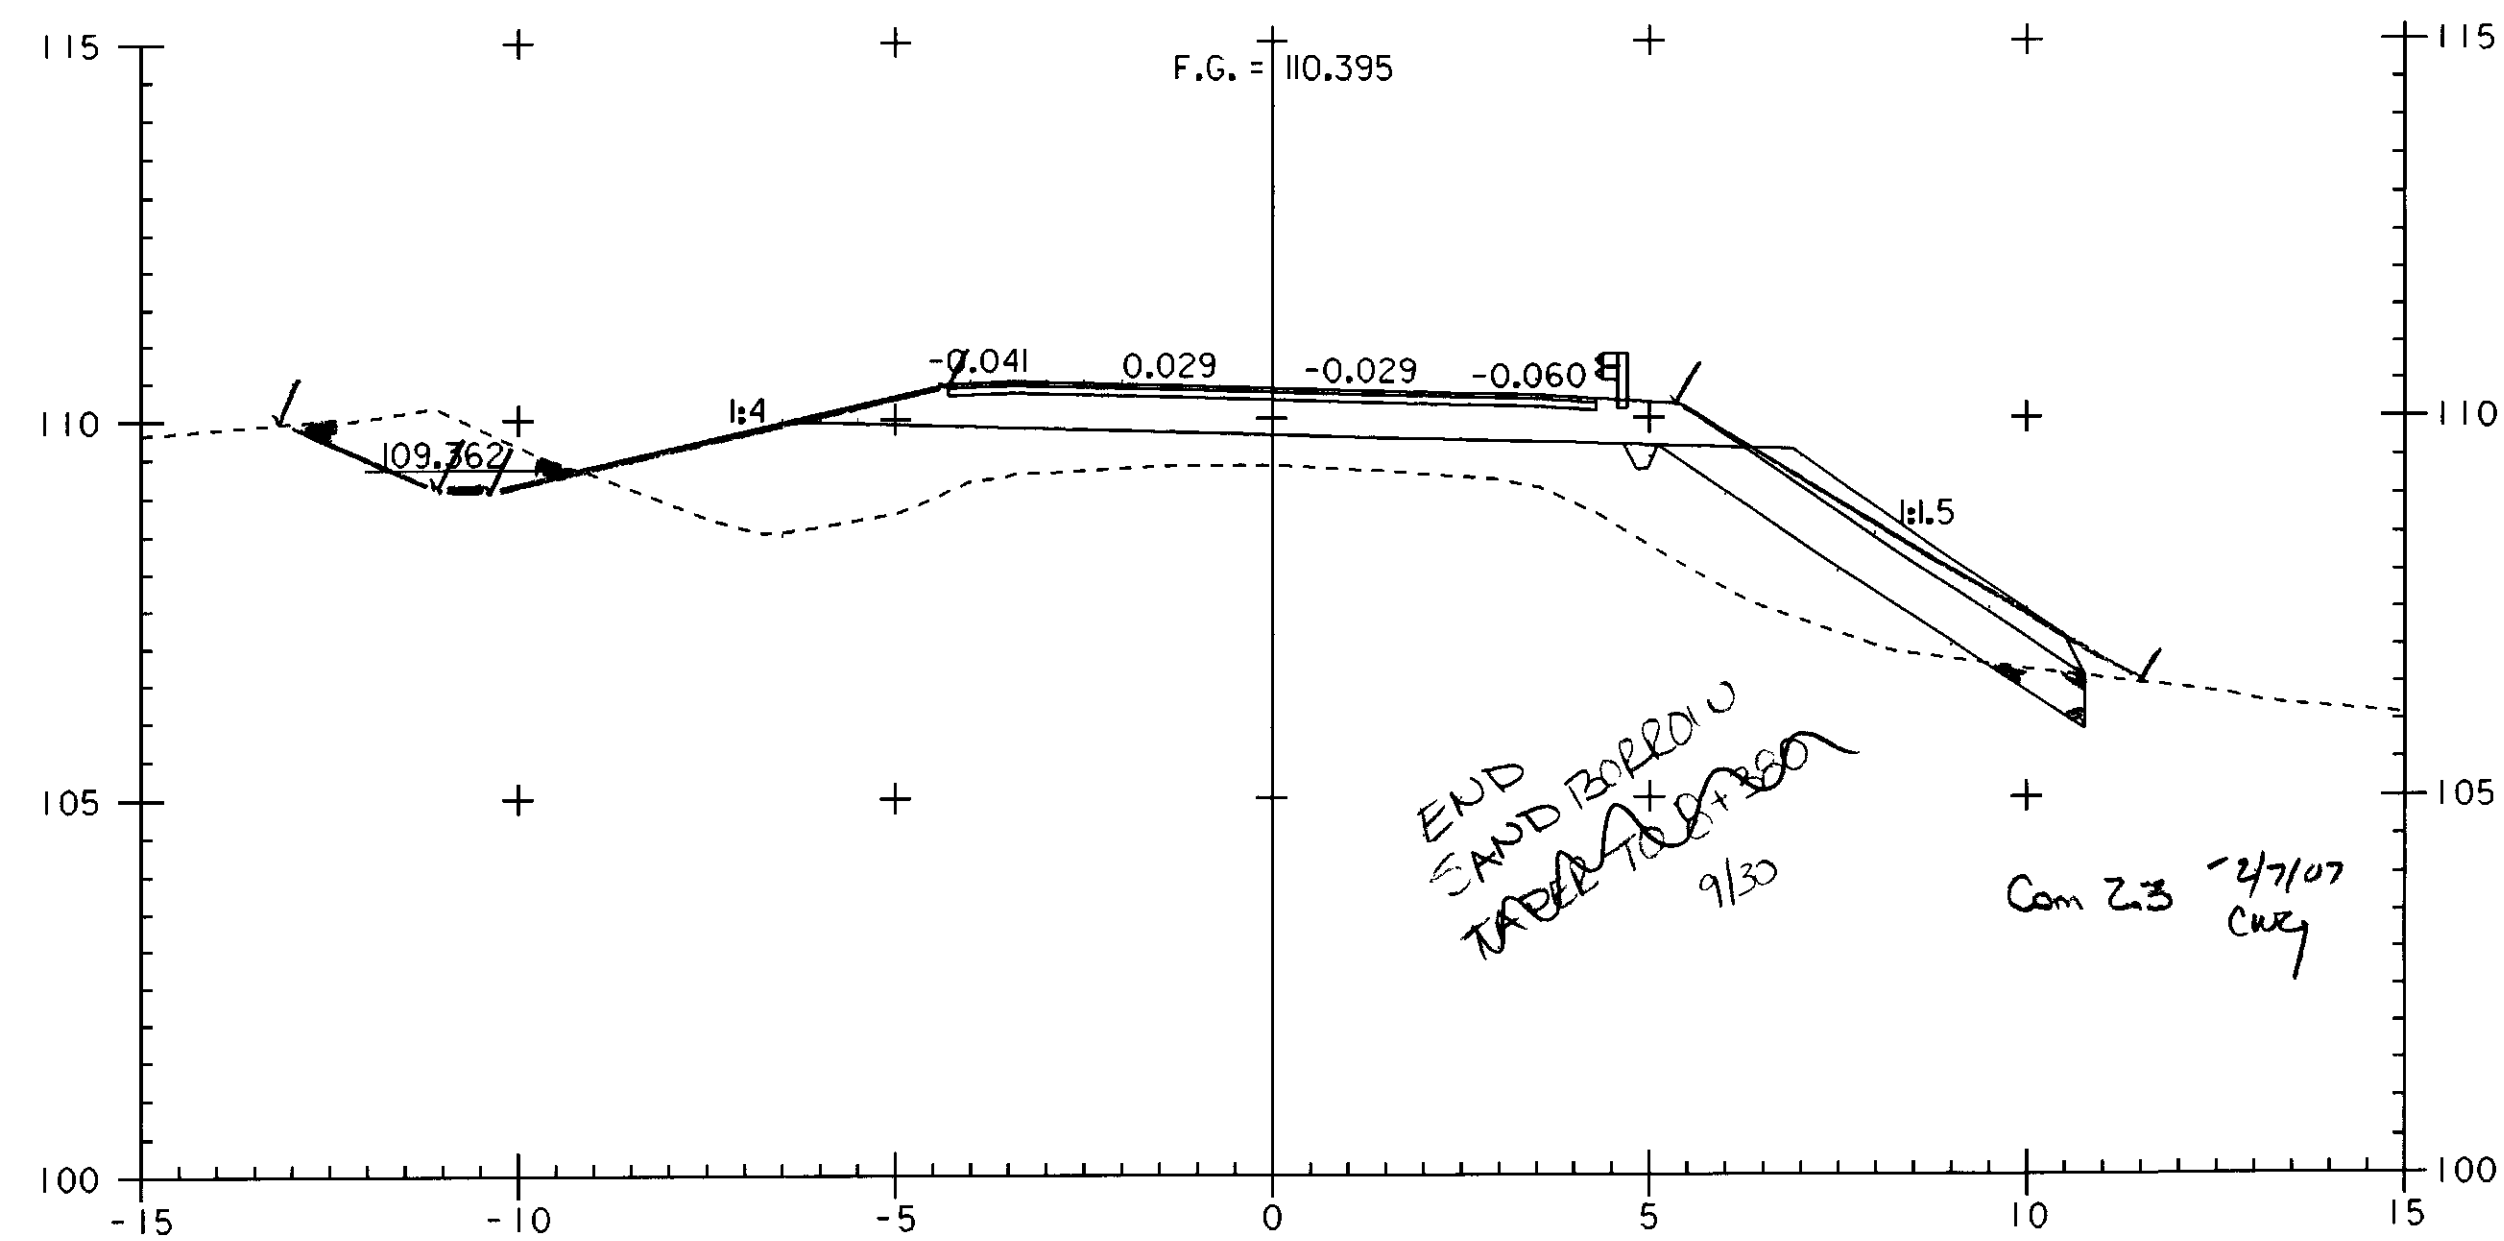

8+400

REV PT Sta 8+398.003 =
STA 8+398.400
EO = +0.397



PROJECT NAME:	HIGHGATE - FRANKLIN
PROJECT NUMBER:	STP RS 030(1) SA
FILE NAME: ...85c060\design\dc060x10.dgn	PLOT DATE: 09-MAY-2005
PROJECT LEADER: DELLASANTA	DRAWN BY: SQUAD B
DESIGNED BY: SQUAD B	CHECKED BY: SQUAD B
IPARM FILE NAME: dc060x1015.1	SHEET 419 OF 450