
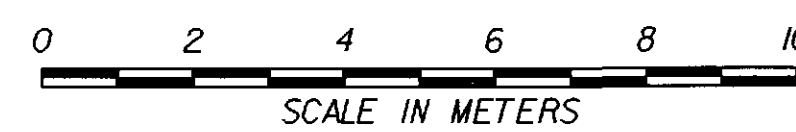
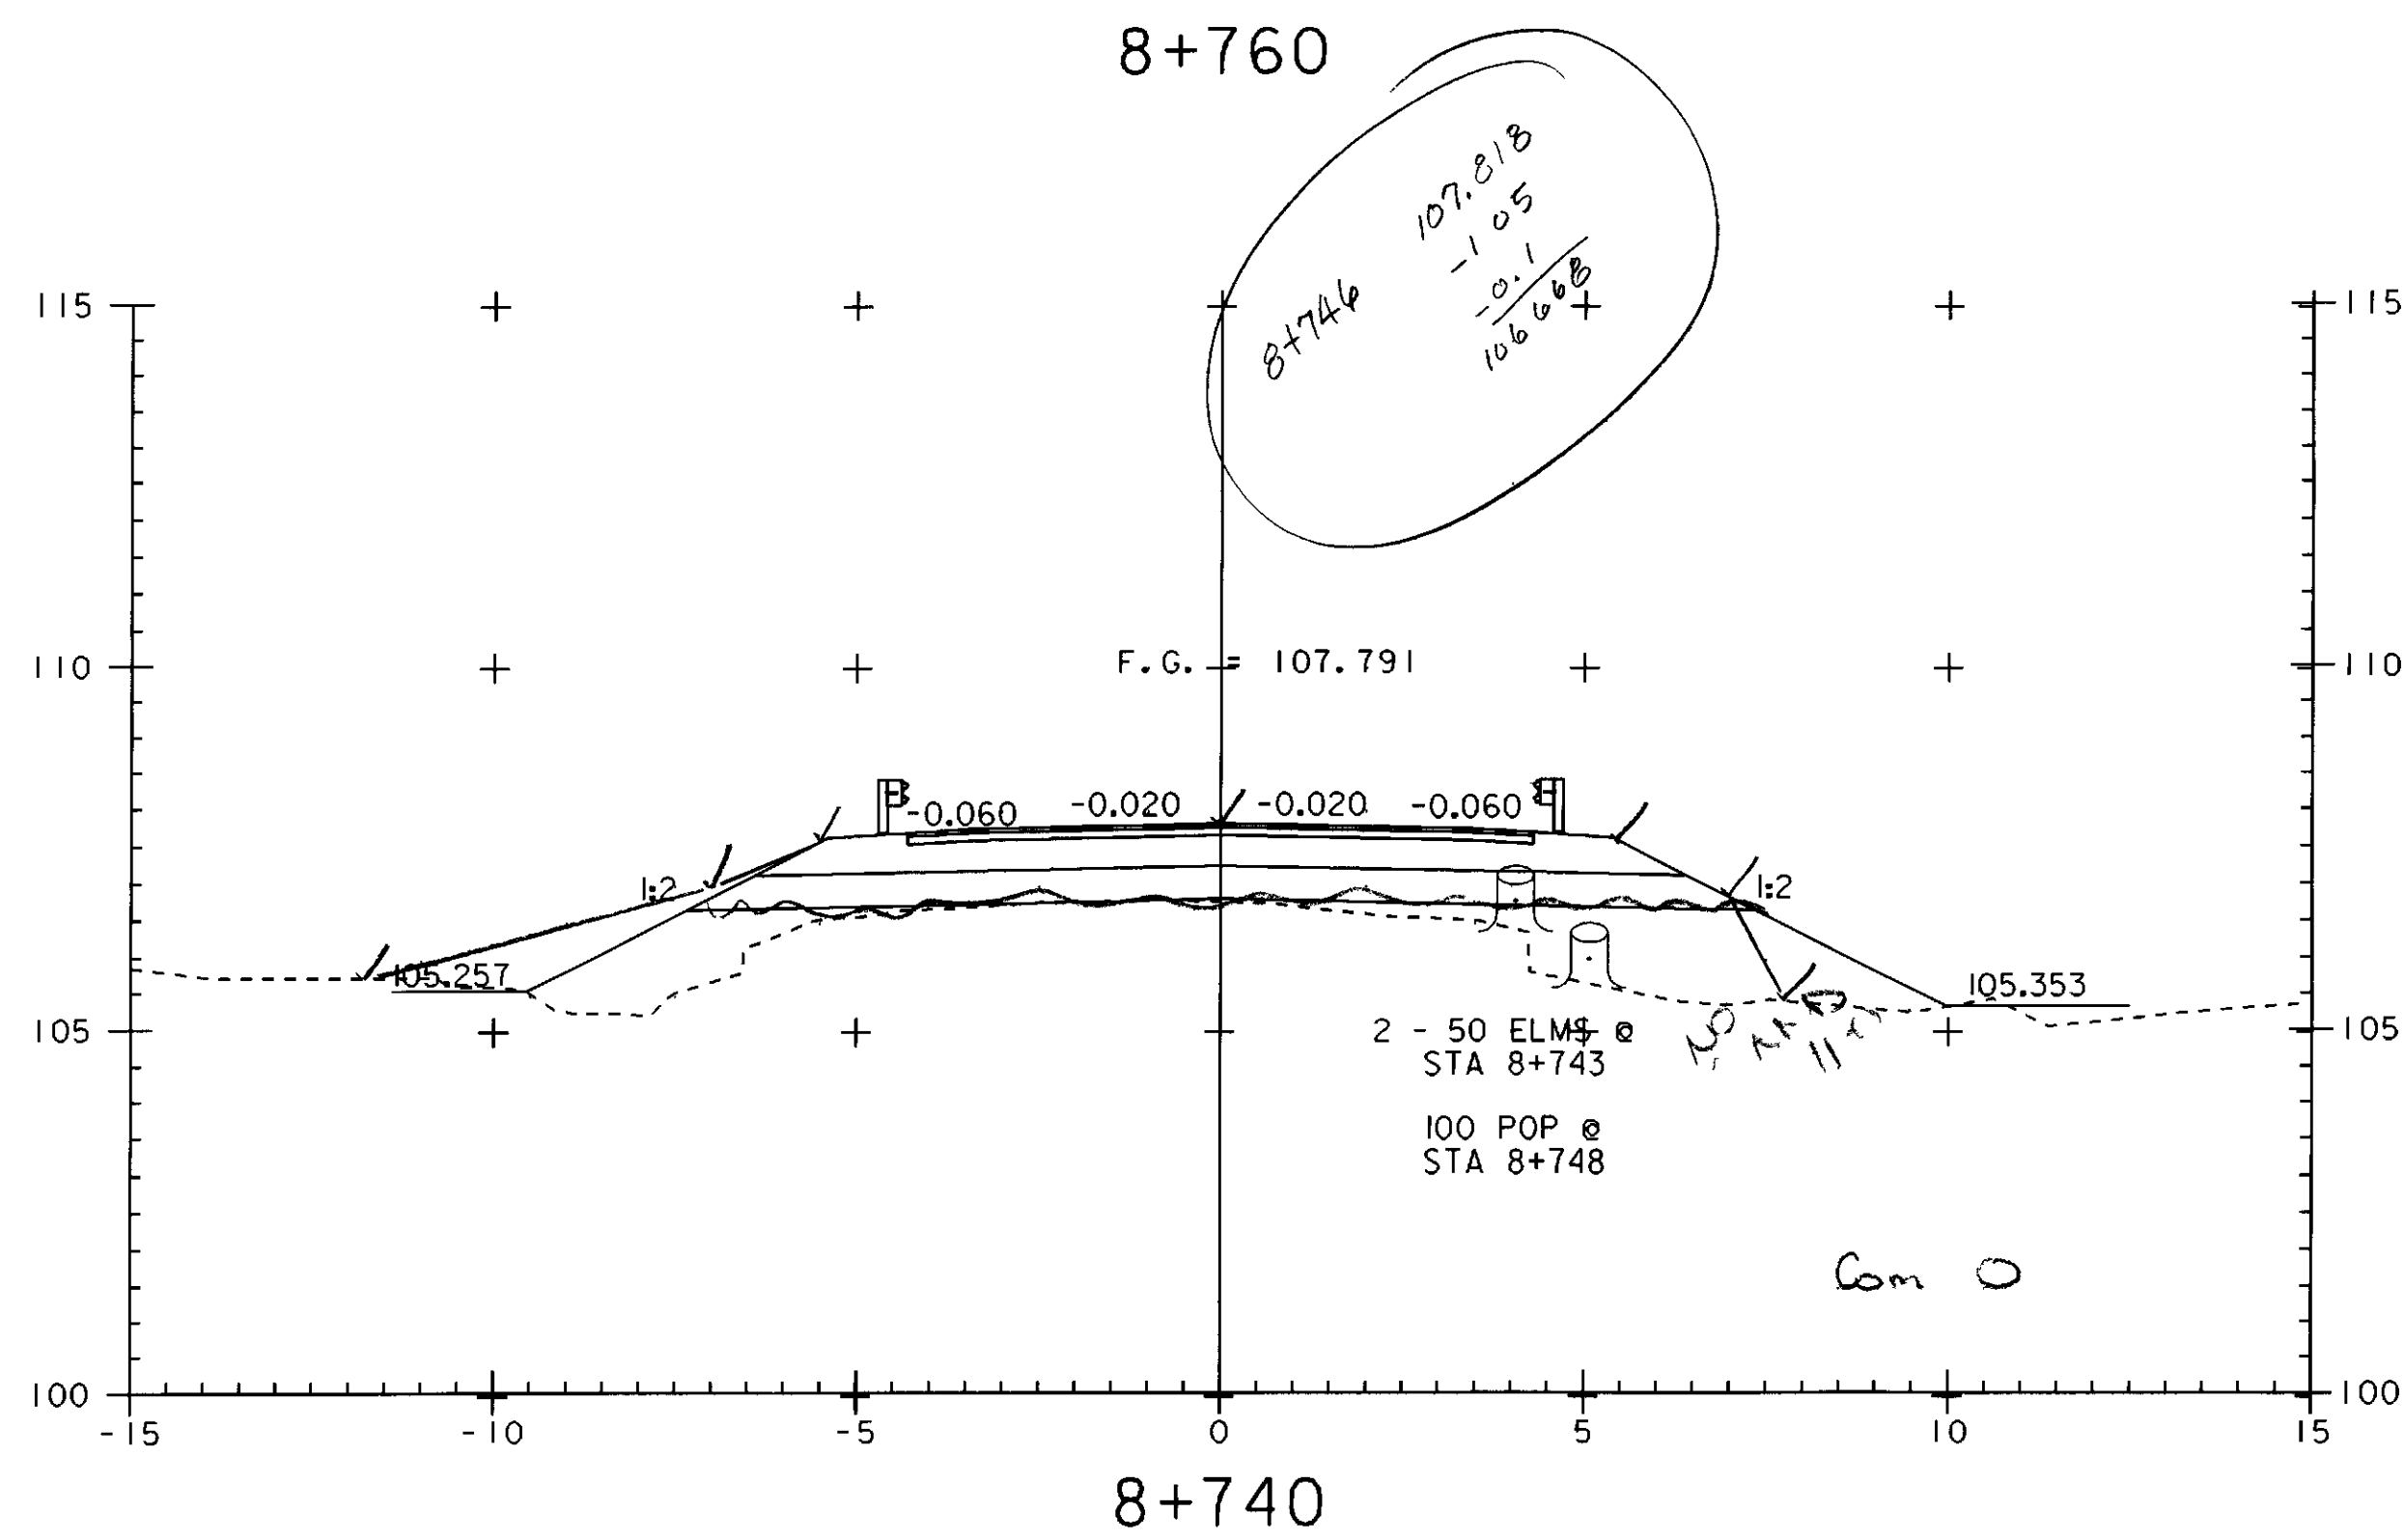


106.1 @ pipe

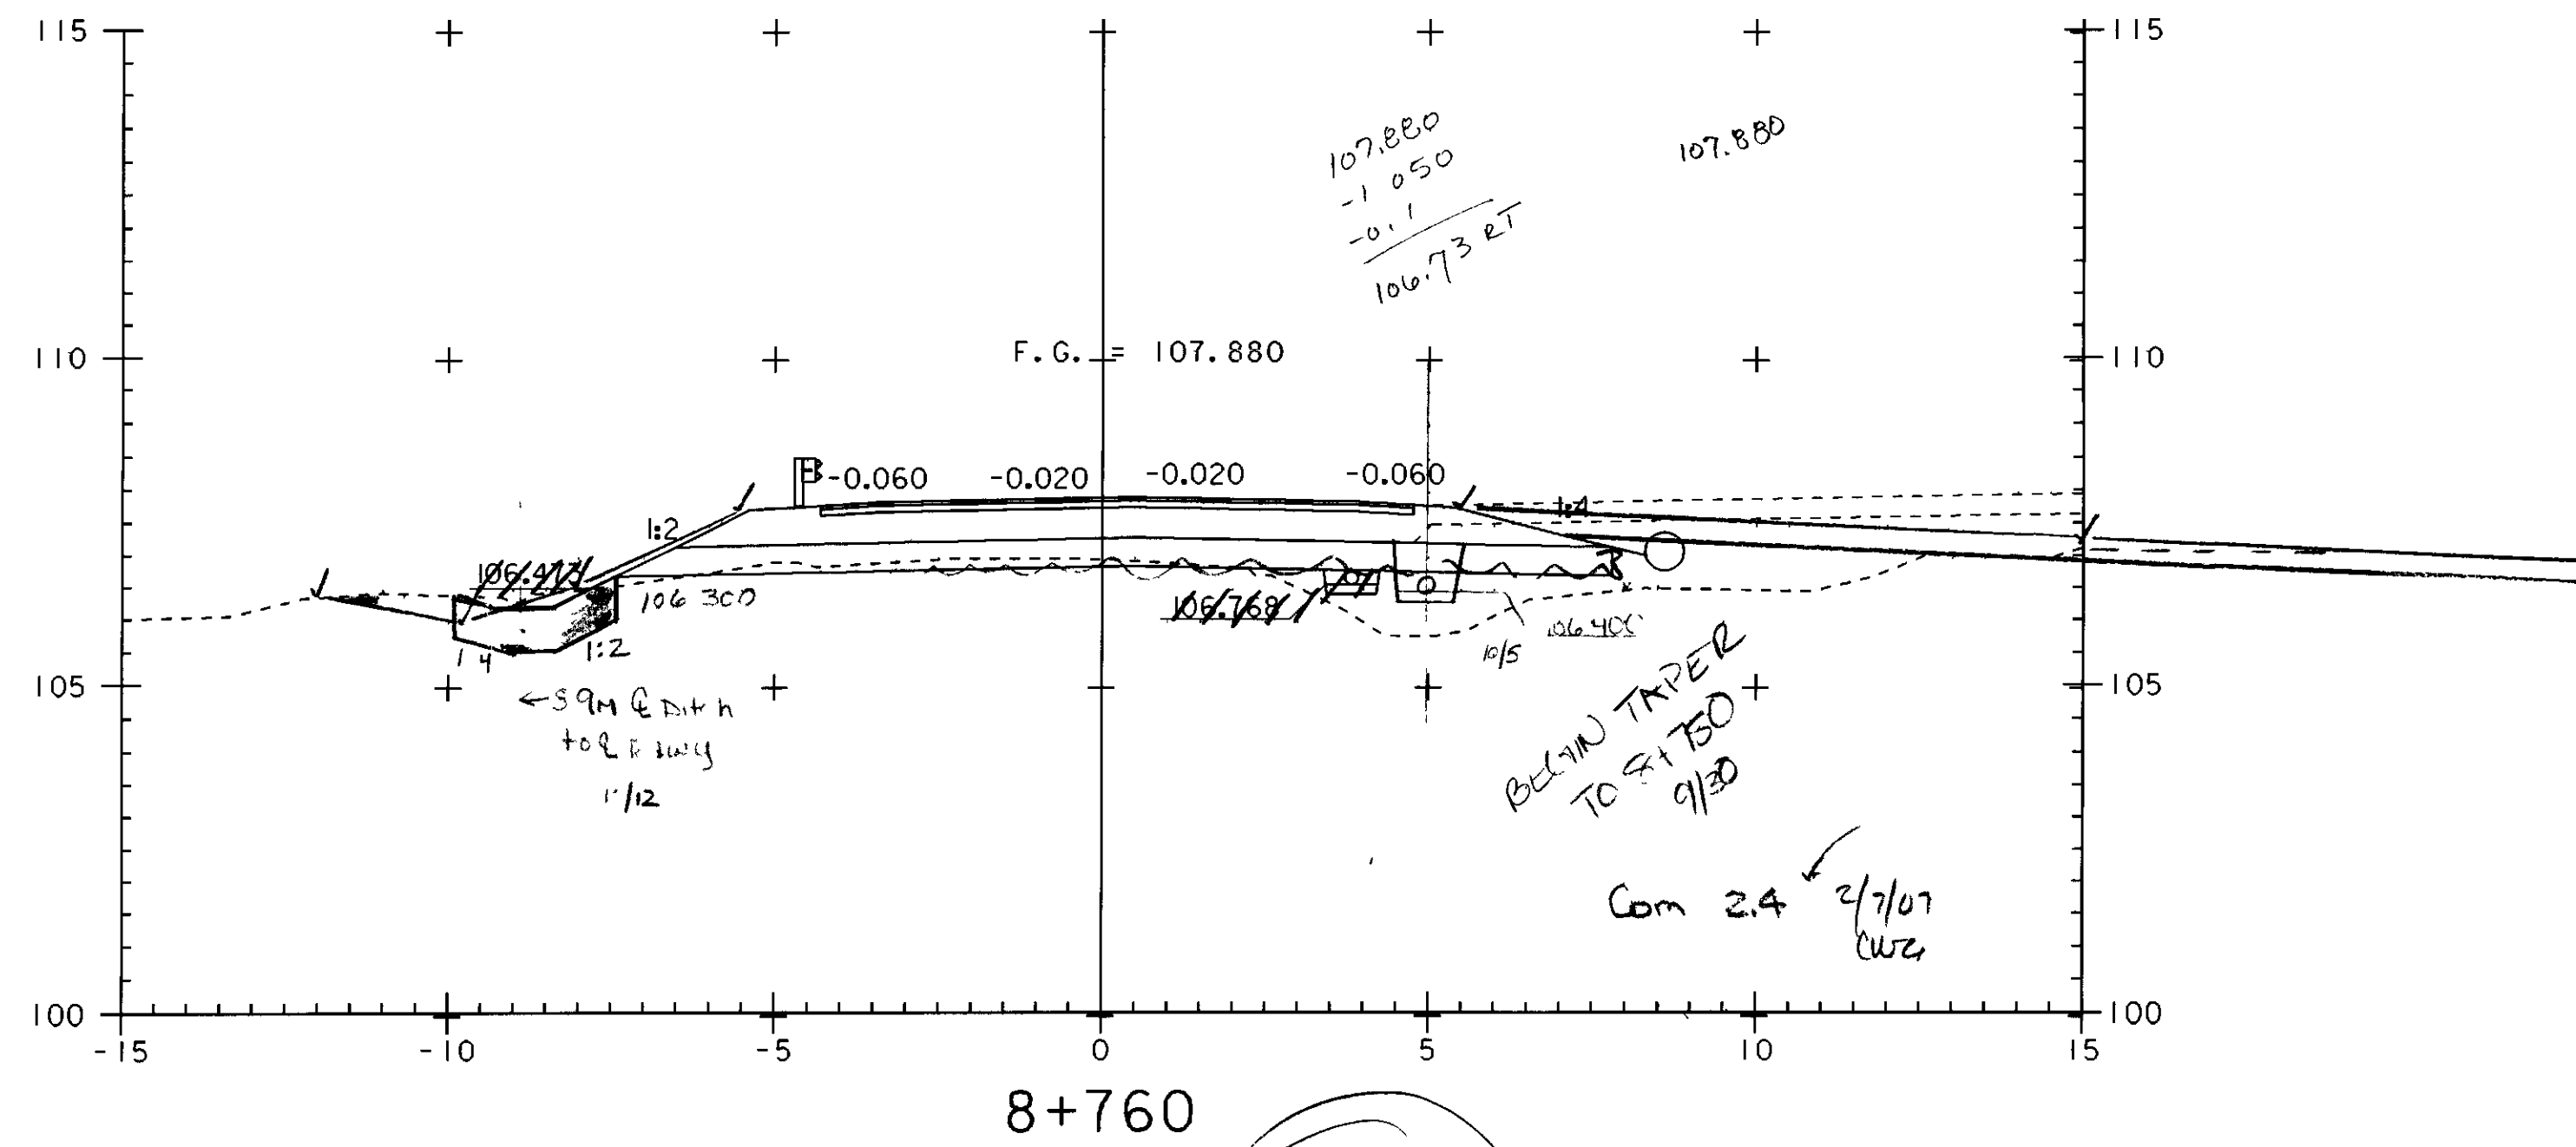

PROJECT NAME:	HIGHGATE - FRANKLIN	PLOT DATE:	09-MAY-2005
PROJECT NUMBER:	STP RS 030(I) SA	DRAWN BY:	SQUAD B
FILE NAME:	...85c060\design\dc060x11.dgn	CHECKED BY:	SQUAD B
PROJECT LEADER:	DELLASANTA	SHEET	426 OF 450
DESIGNED BY:	SQUAD B		
IPARM FILE NAME:	dc060x112.i		