
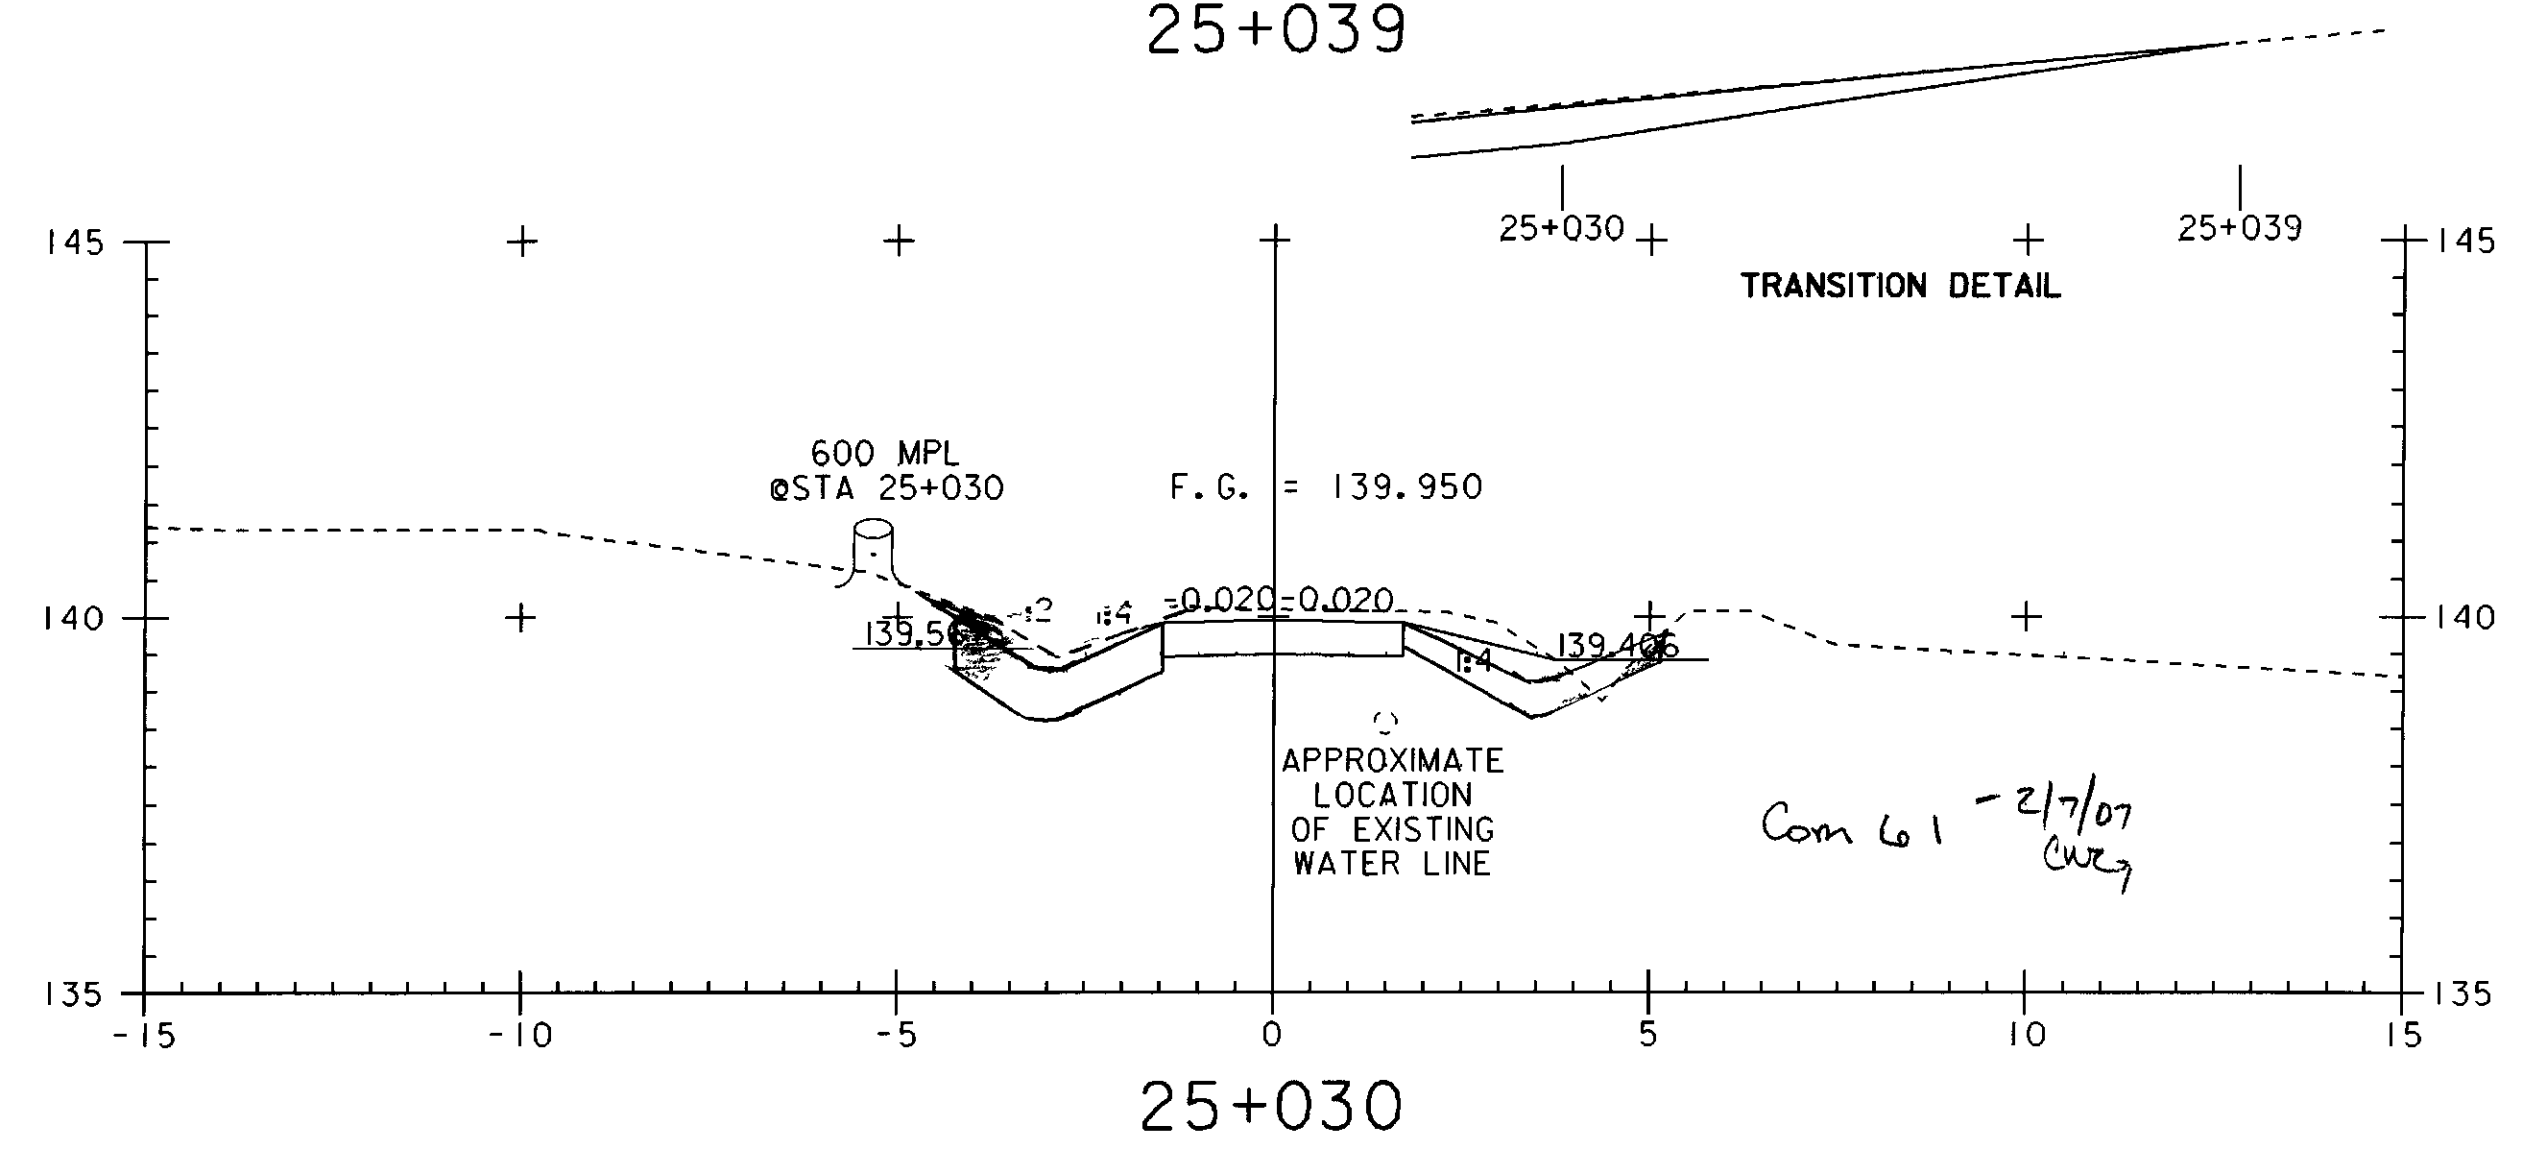
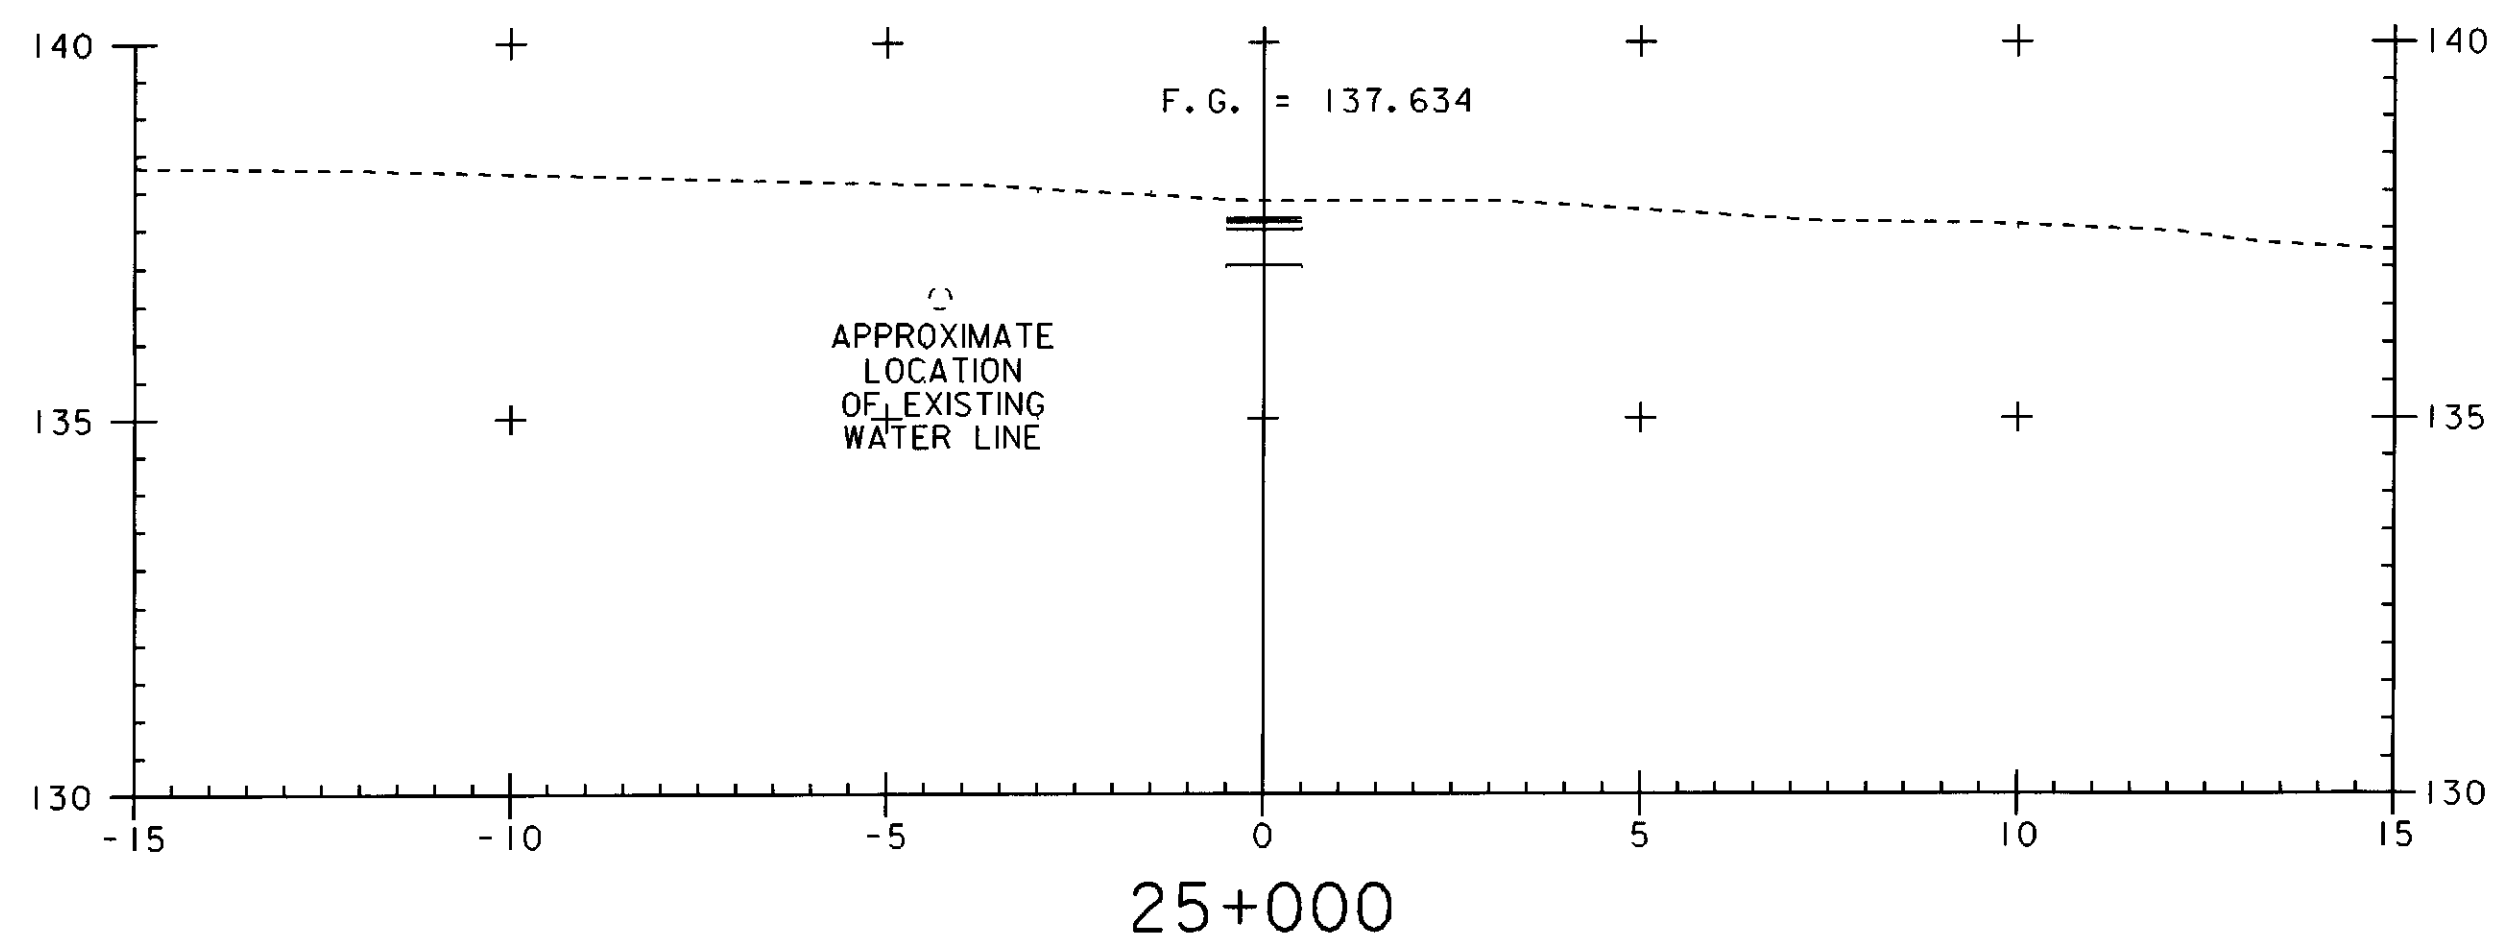
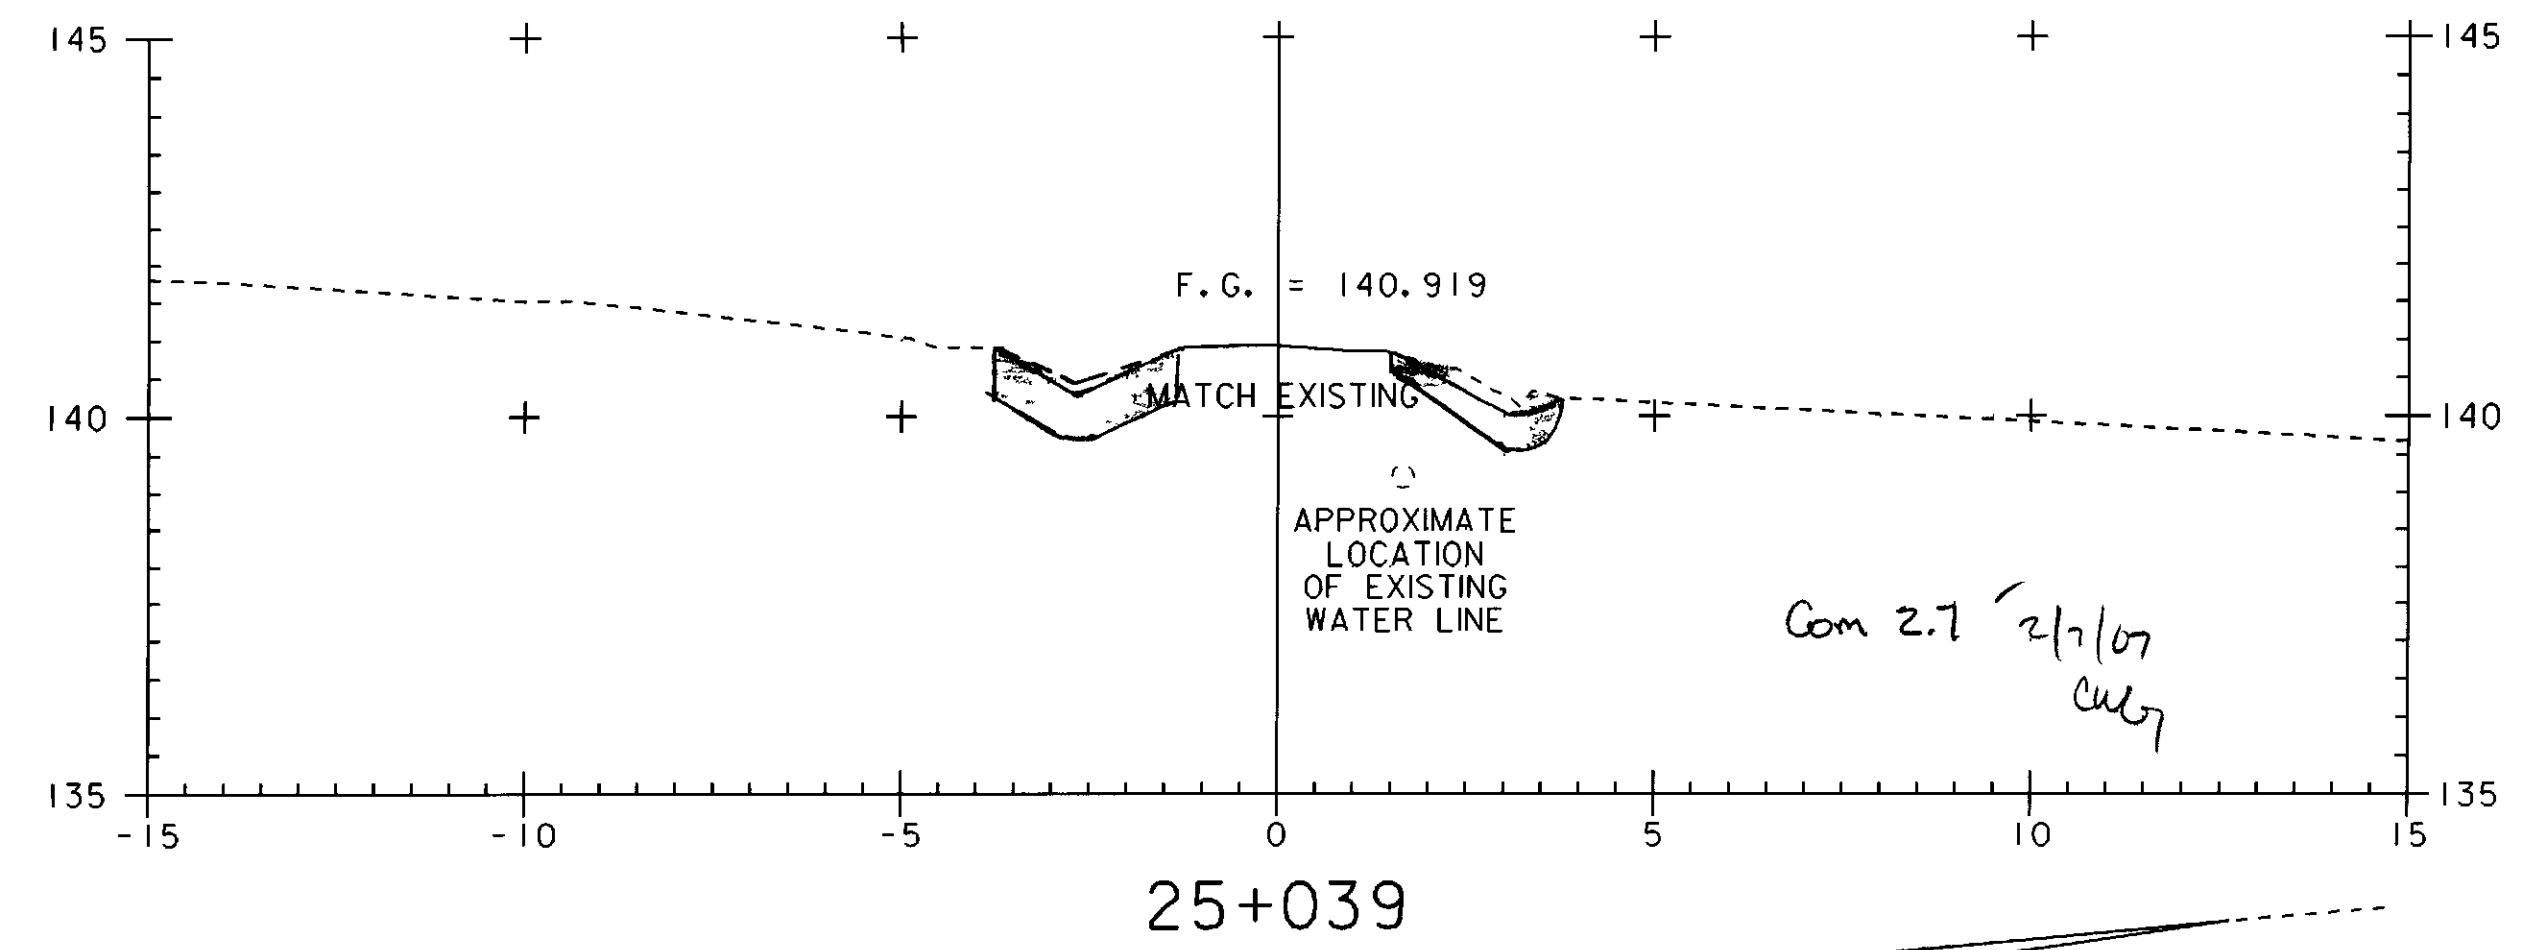
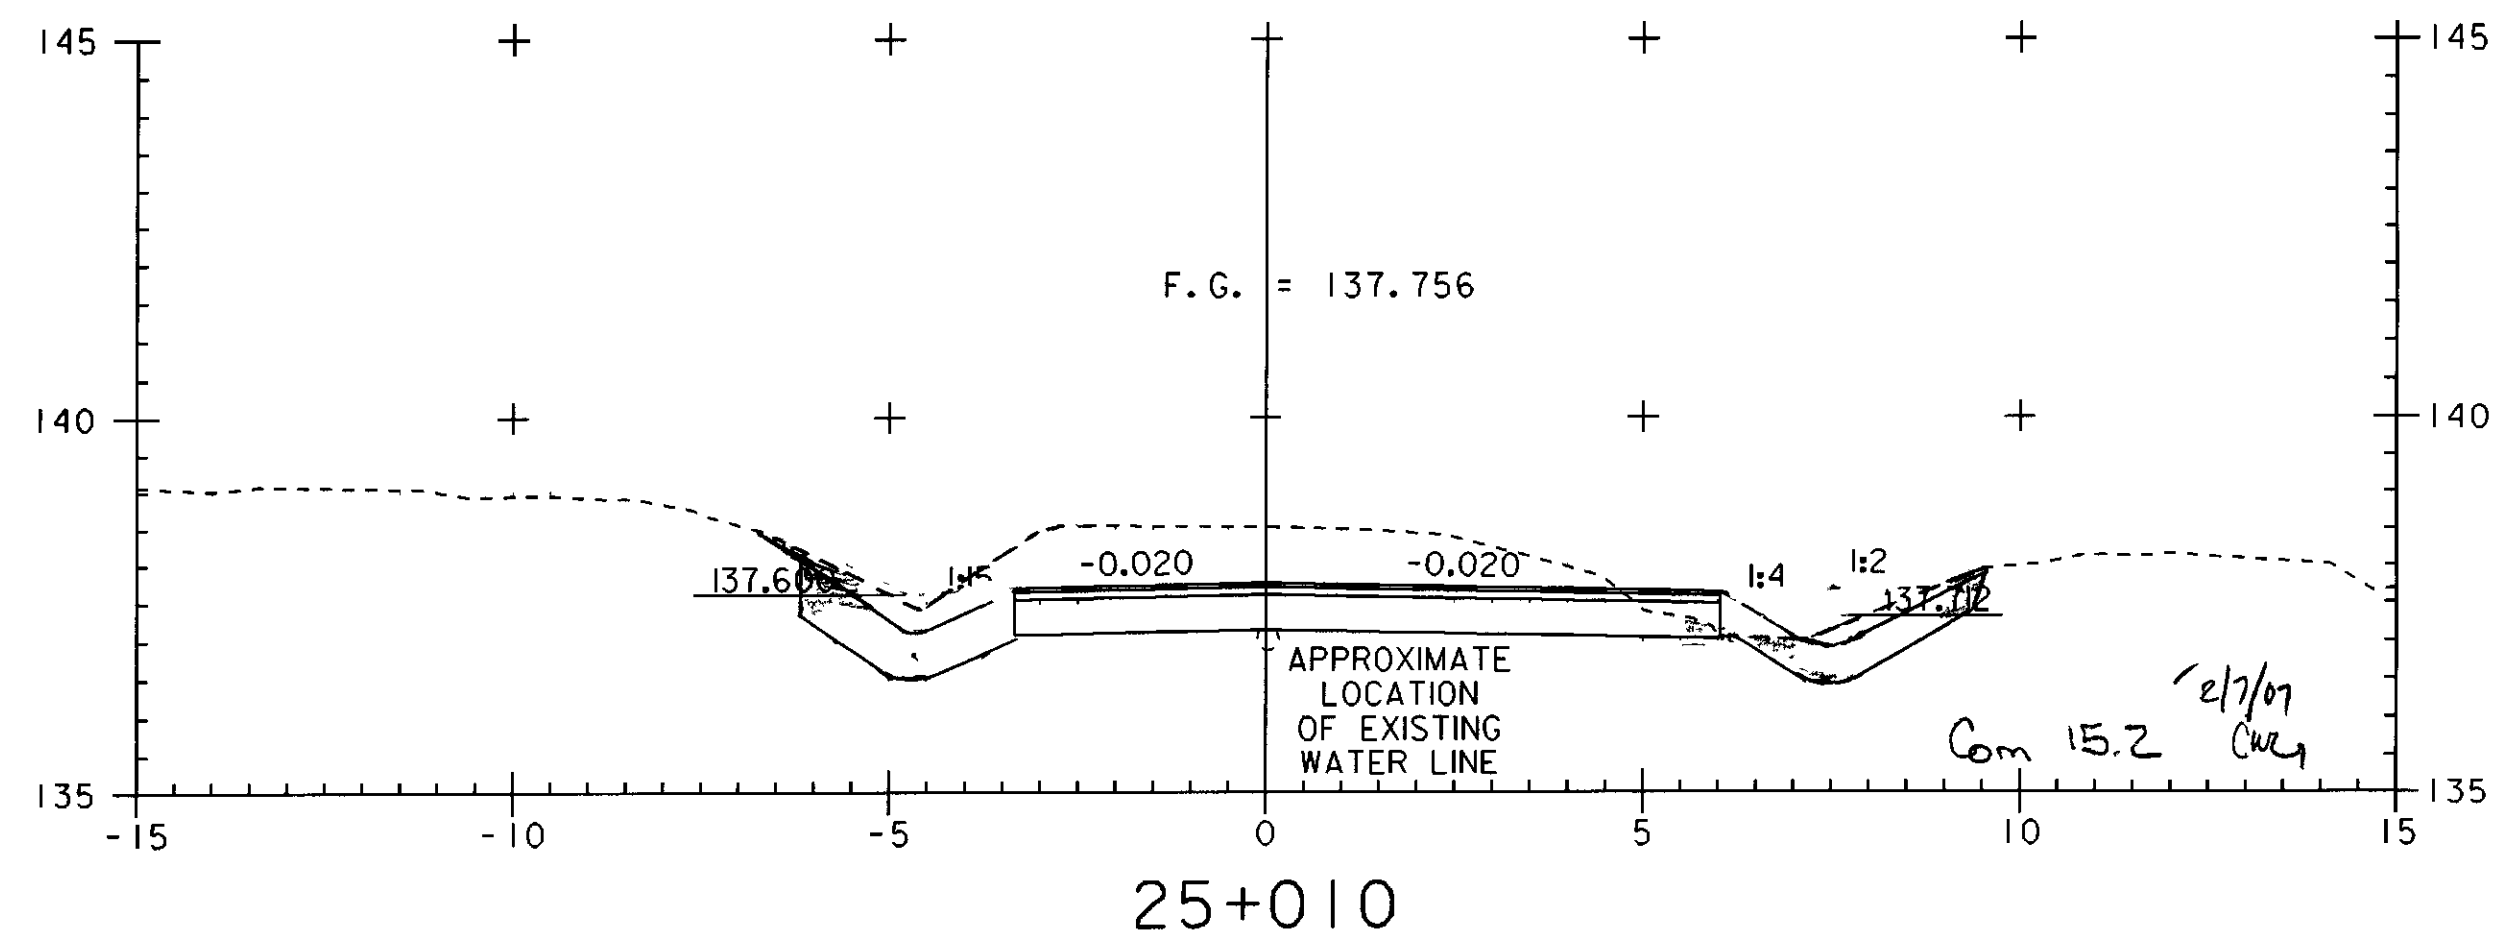
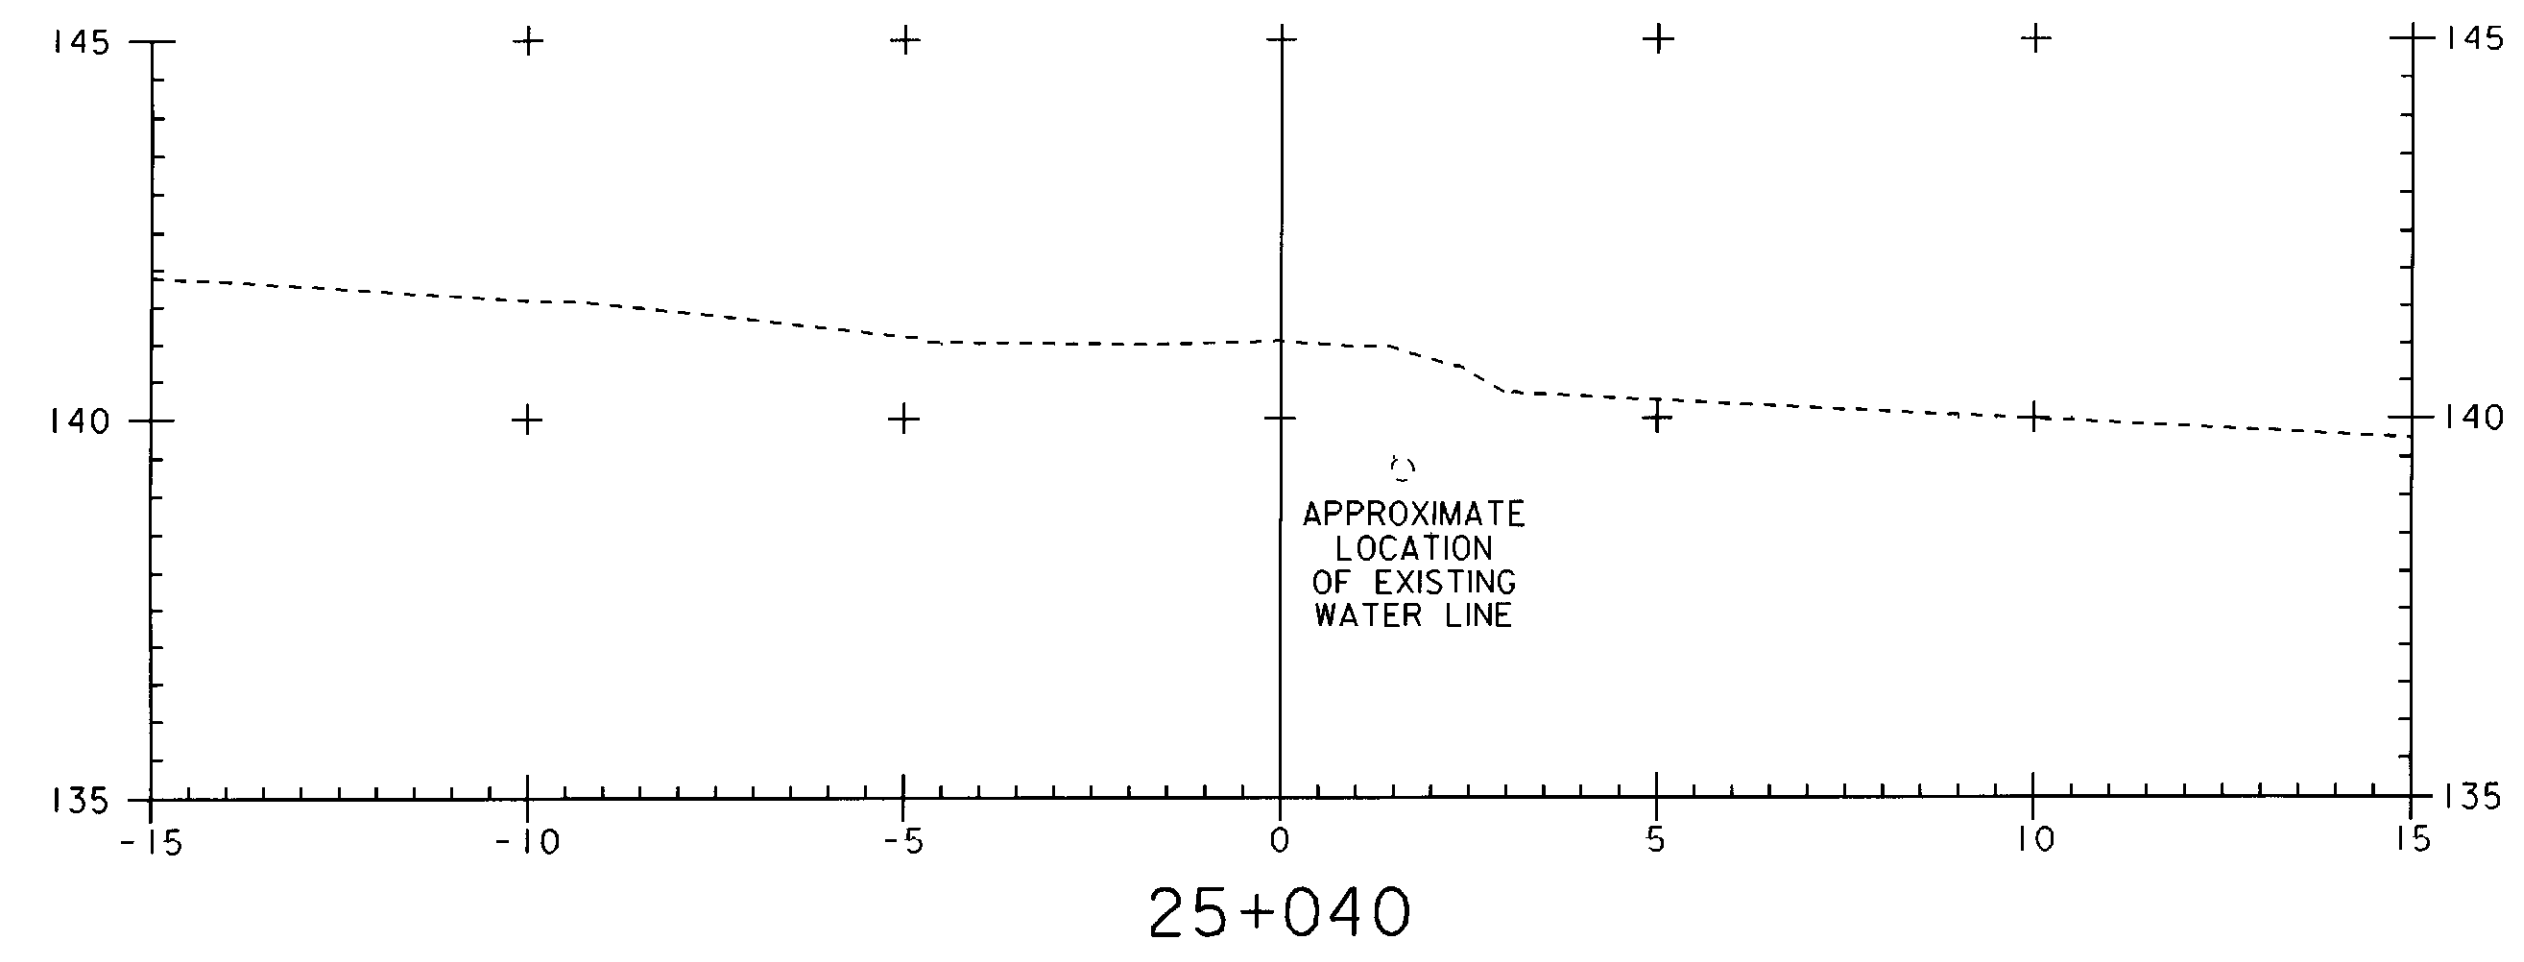


# TH #21 SECTIONS

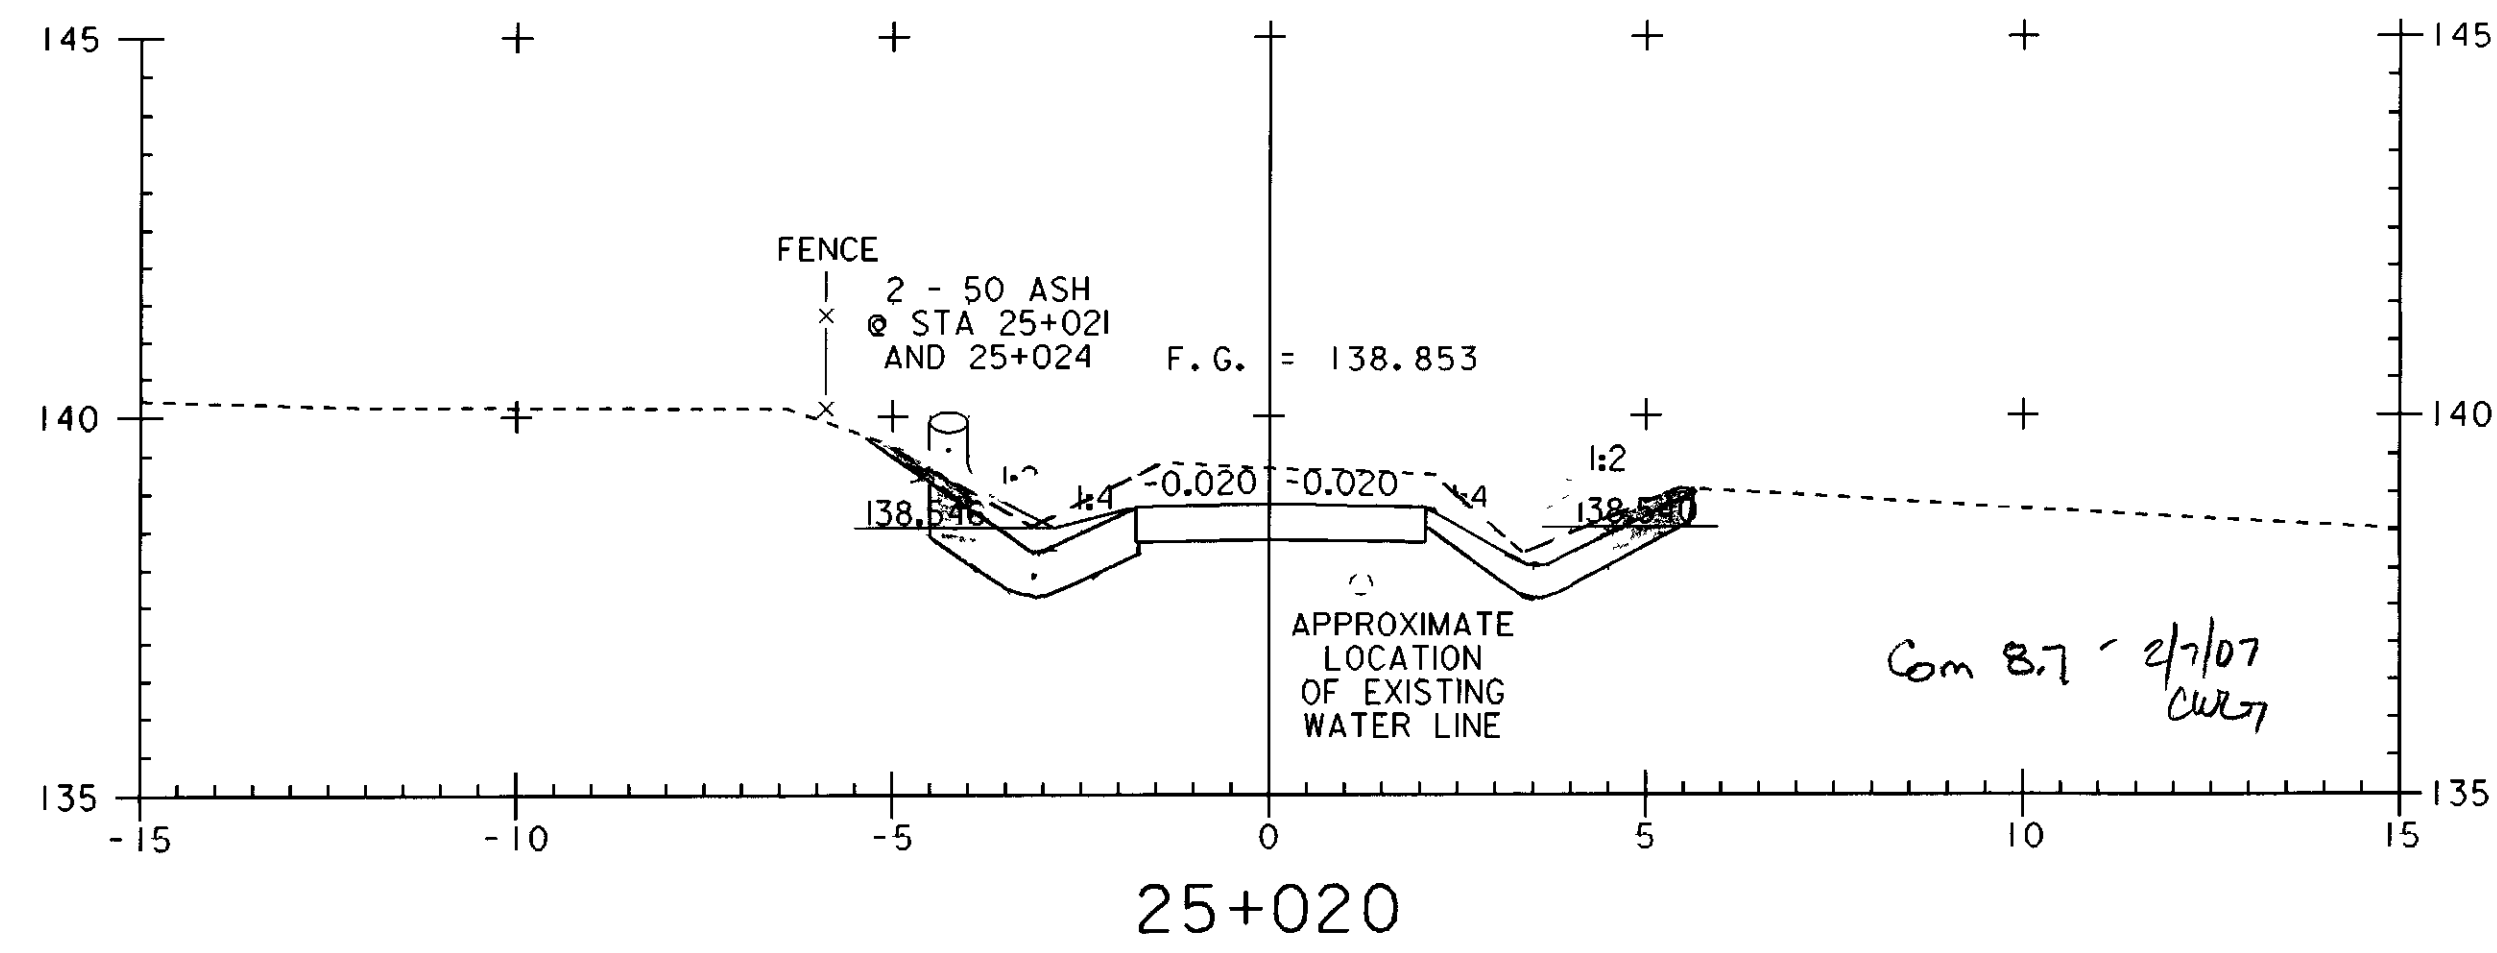

|                  |                               |
|------------------|-------------------------------|
| PROJECT NAME:    | HIGHGATE - FRANKLIN           |
| PROJECT NUMBER:  | STP RS 030(I) SA              |
| FILE NAME:       | ...85c060\design\dc060x11.dgn |
| PROJECT LEADER:  | DELLASANTA                    |
| DESIGNED BY:     | SQUAD B                       |
| IPARM FILE NAME: | dc060x112.1                   |
| PLOT DATE:       | 09-MAY-2005                   |
| DRAWN BY:        | SQUAD B                       |
| CHECKED BY:      | SQUAD B                       |
| SHEET            | 436 OF 450                    |