



135 -25 -20 -15 -10 -5 0 5 10 15 135

ah 14+858

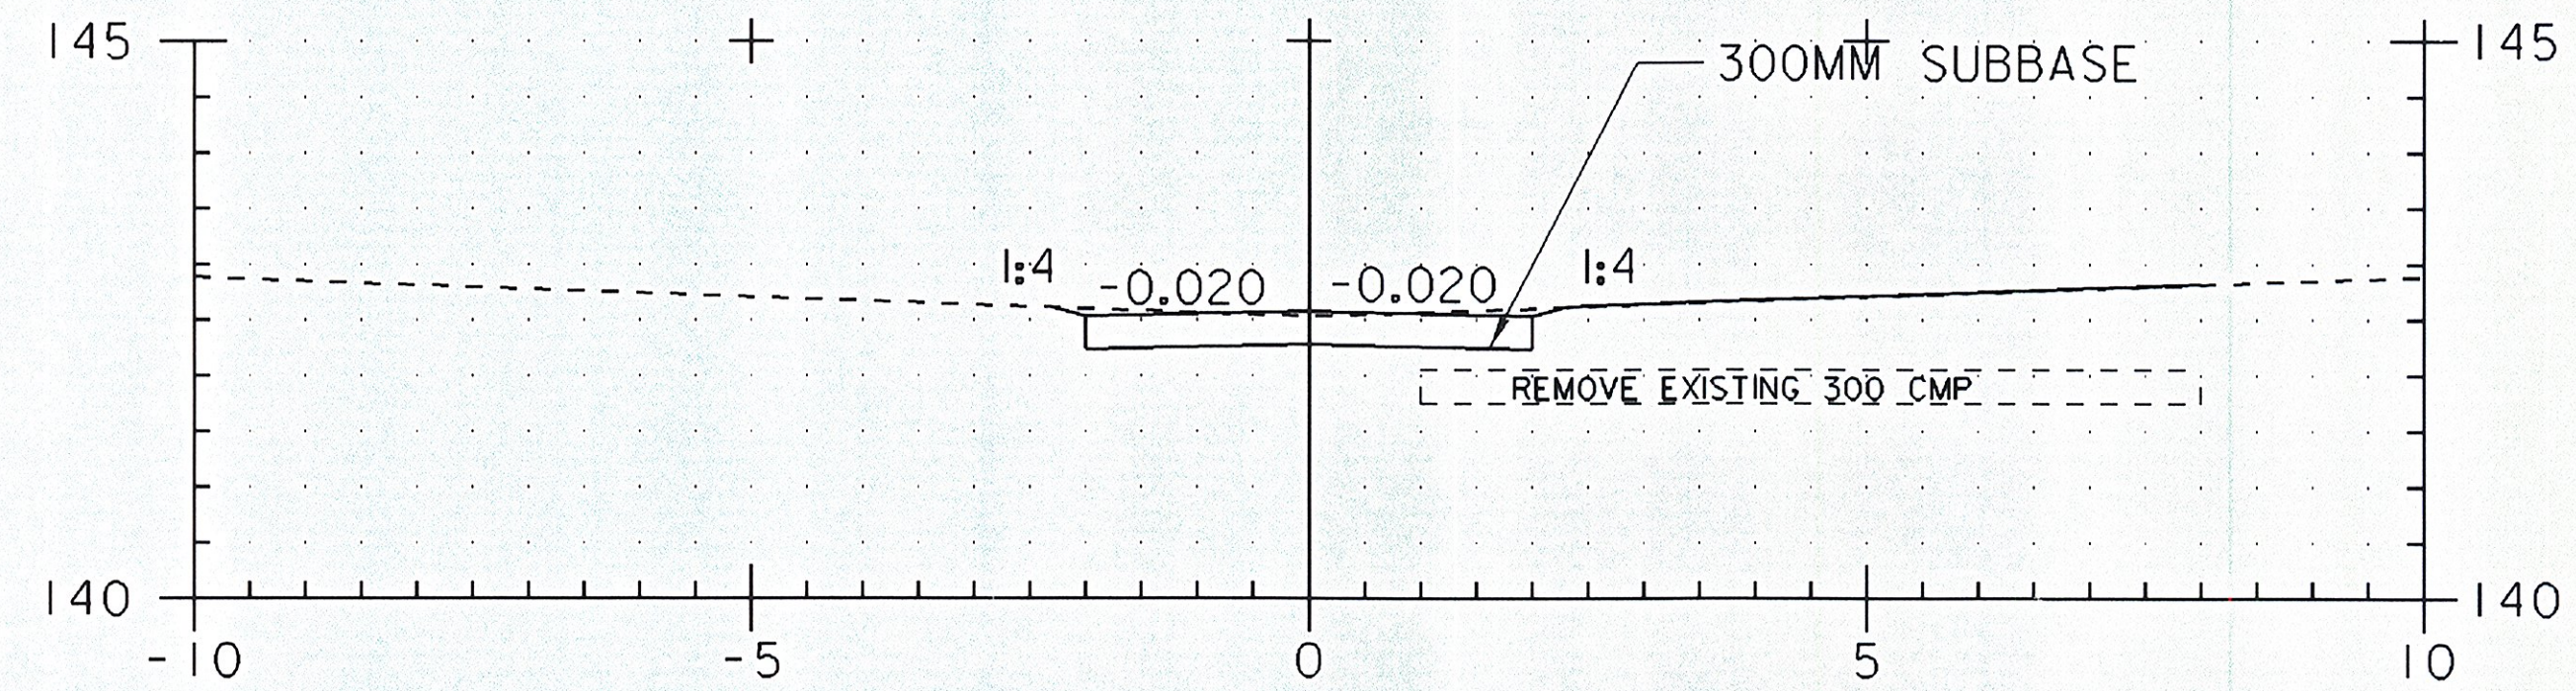

DRIVE AT 14+850 RT
A - A

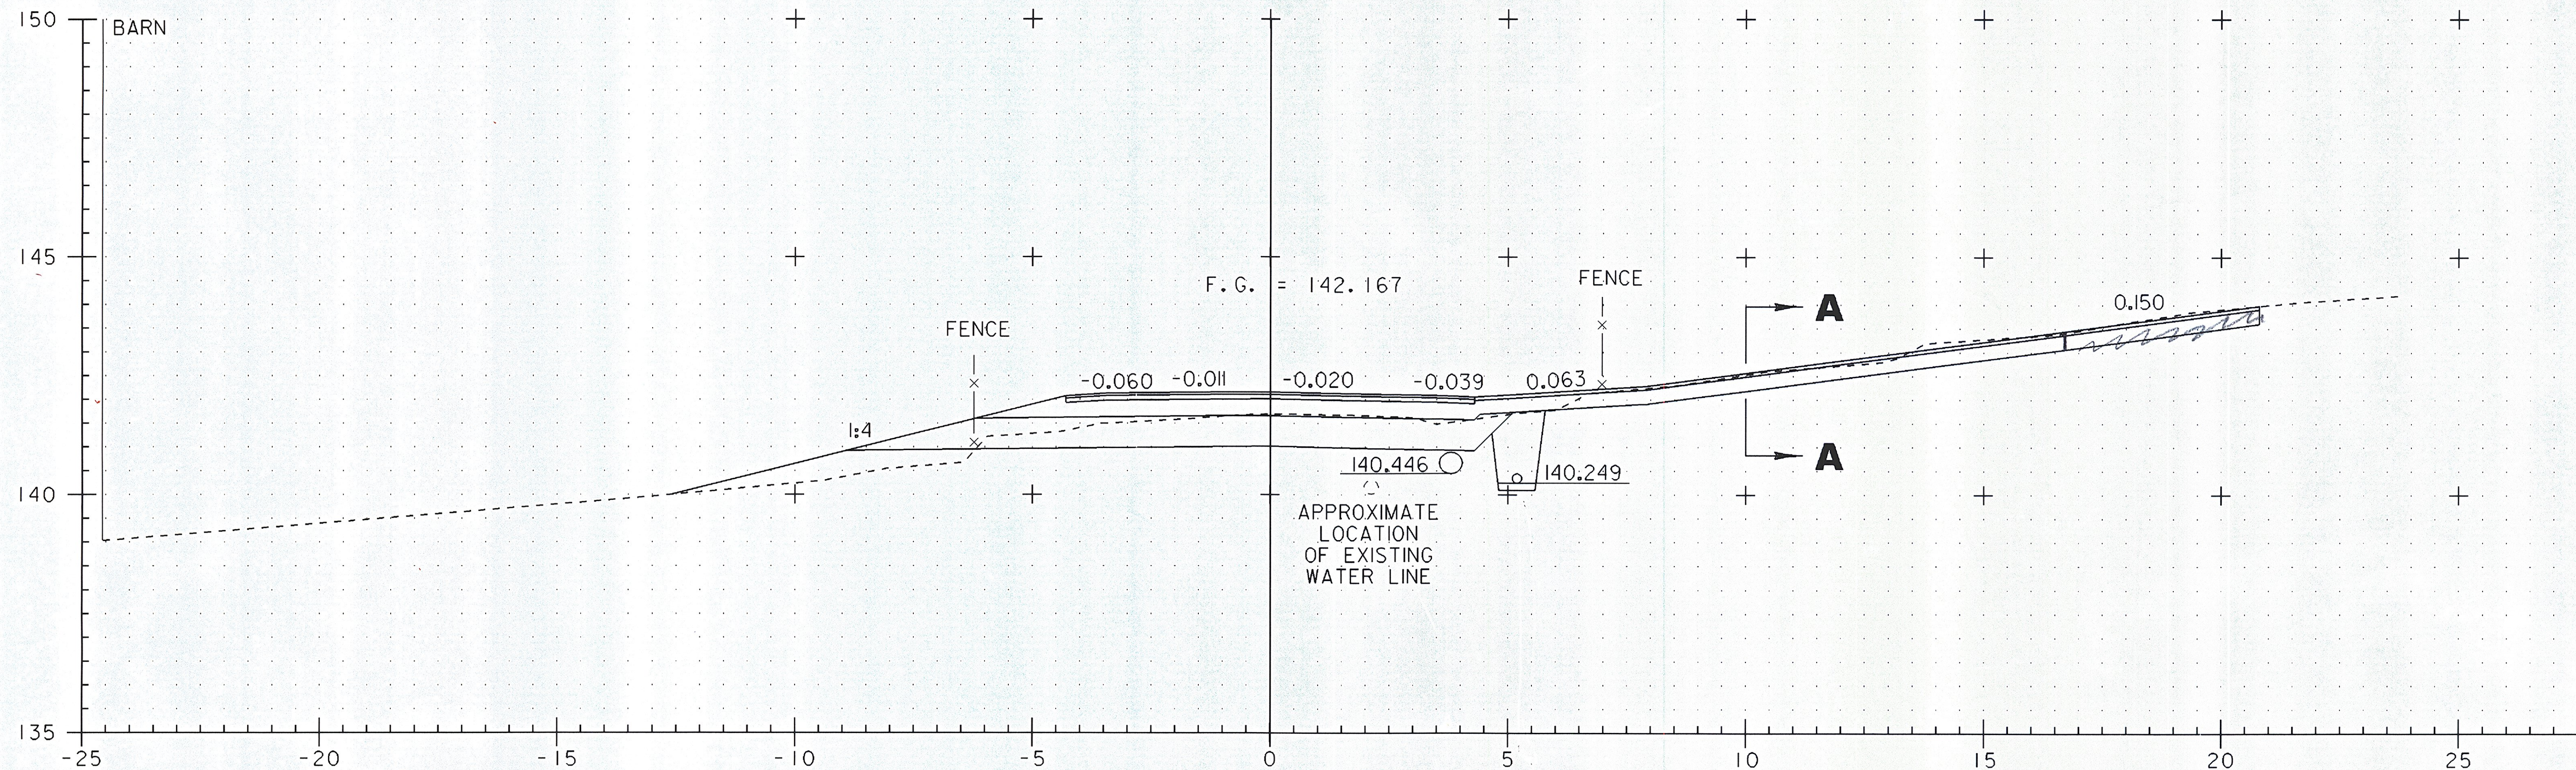

ah 14+850

