




DRIVE AT 14+927 RT
C - C

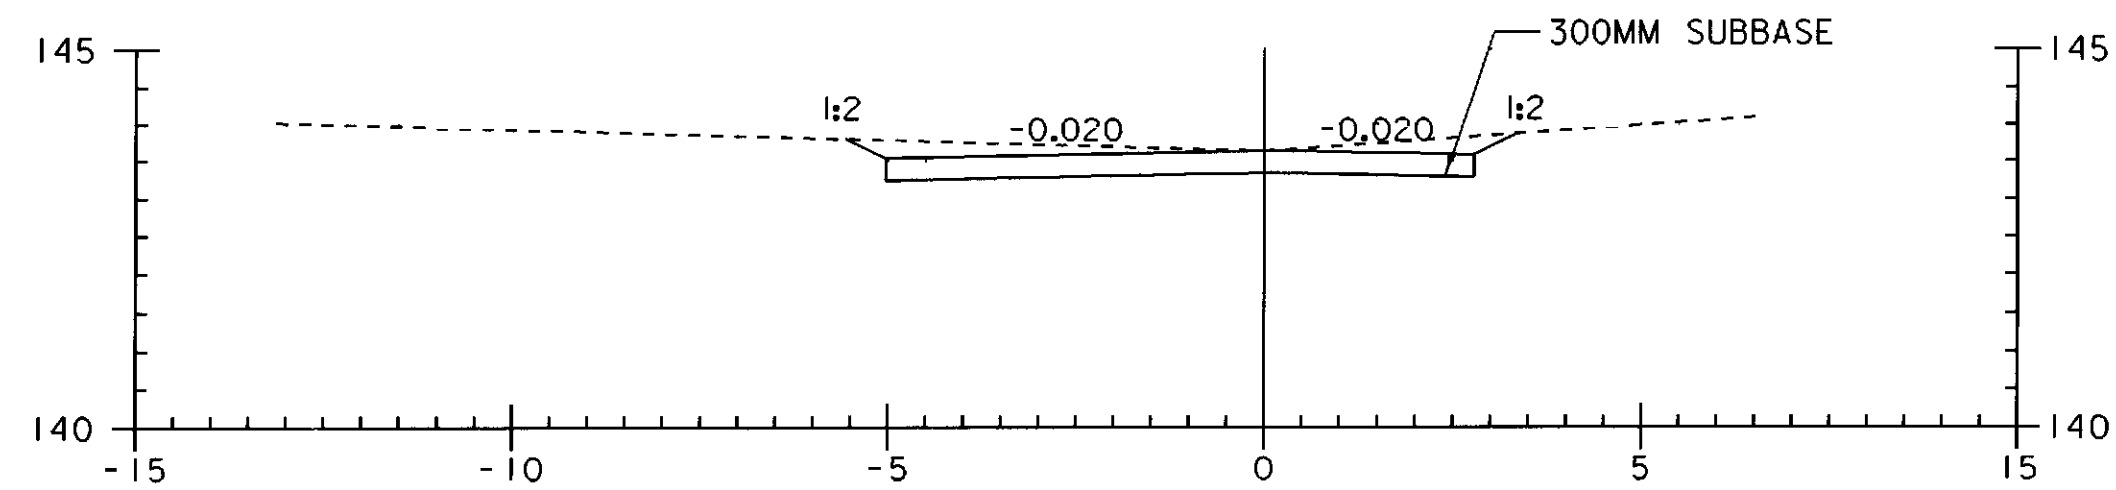


DRIVE AT 14+927 RT
B - B

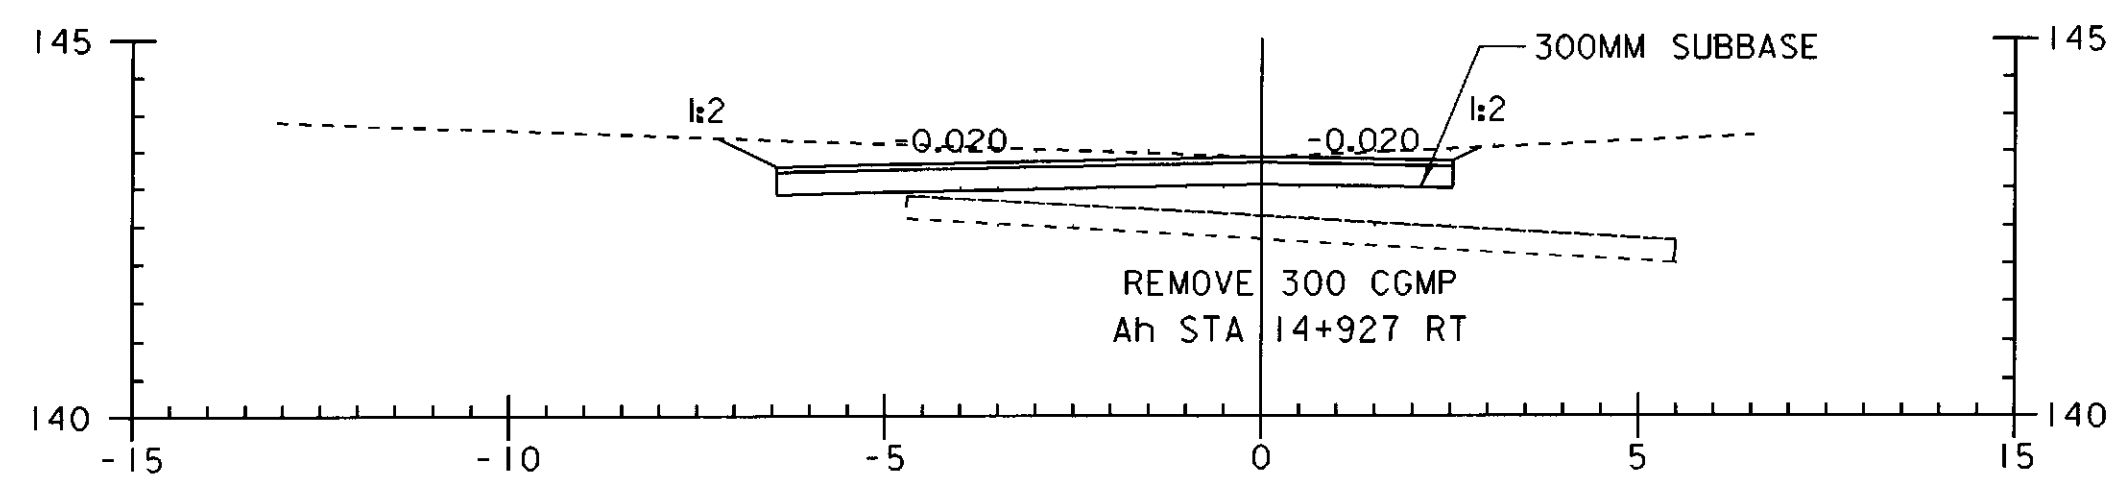


DRIVE AT 14+927 RT
A - A

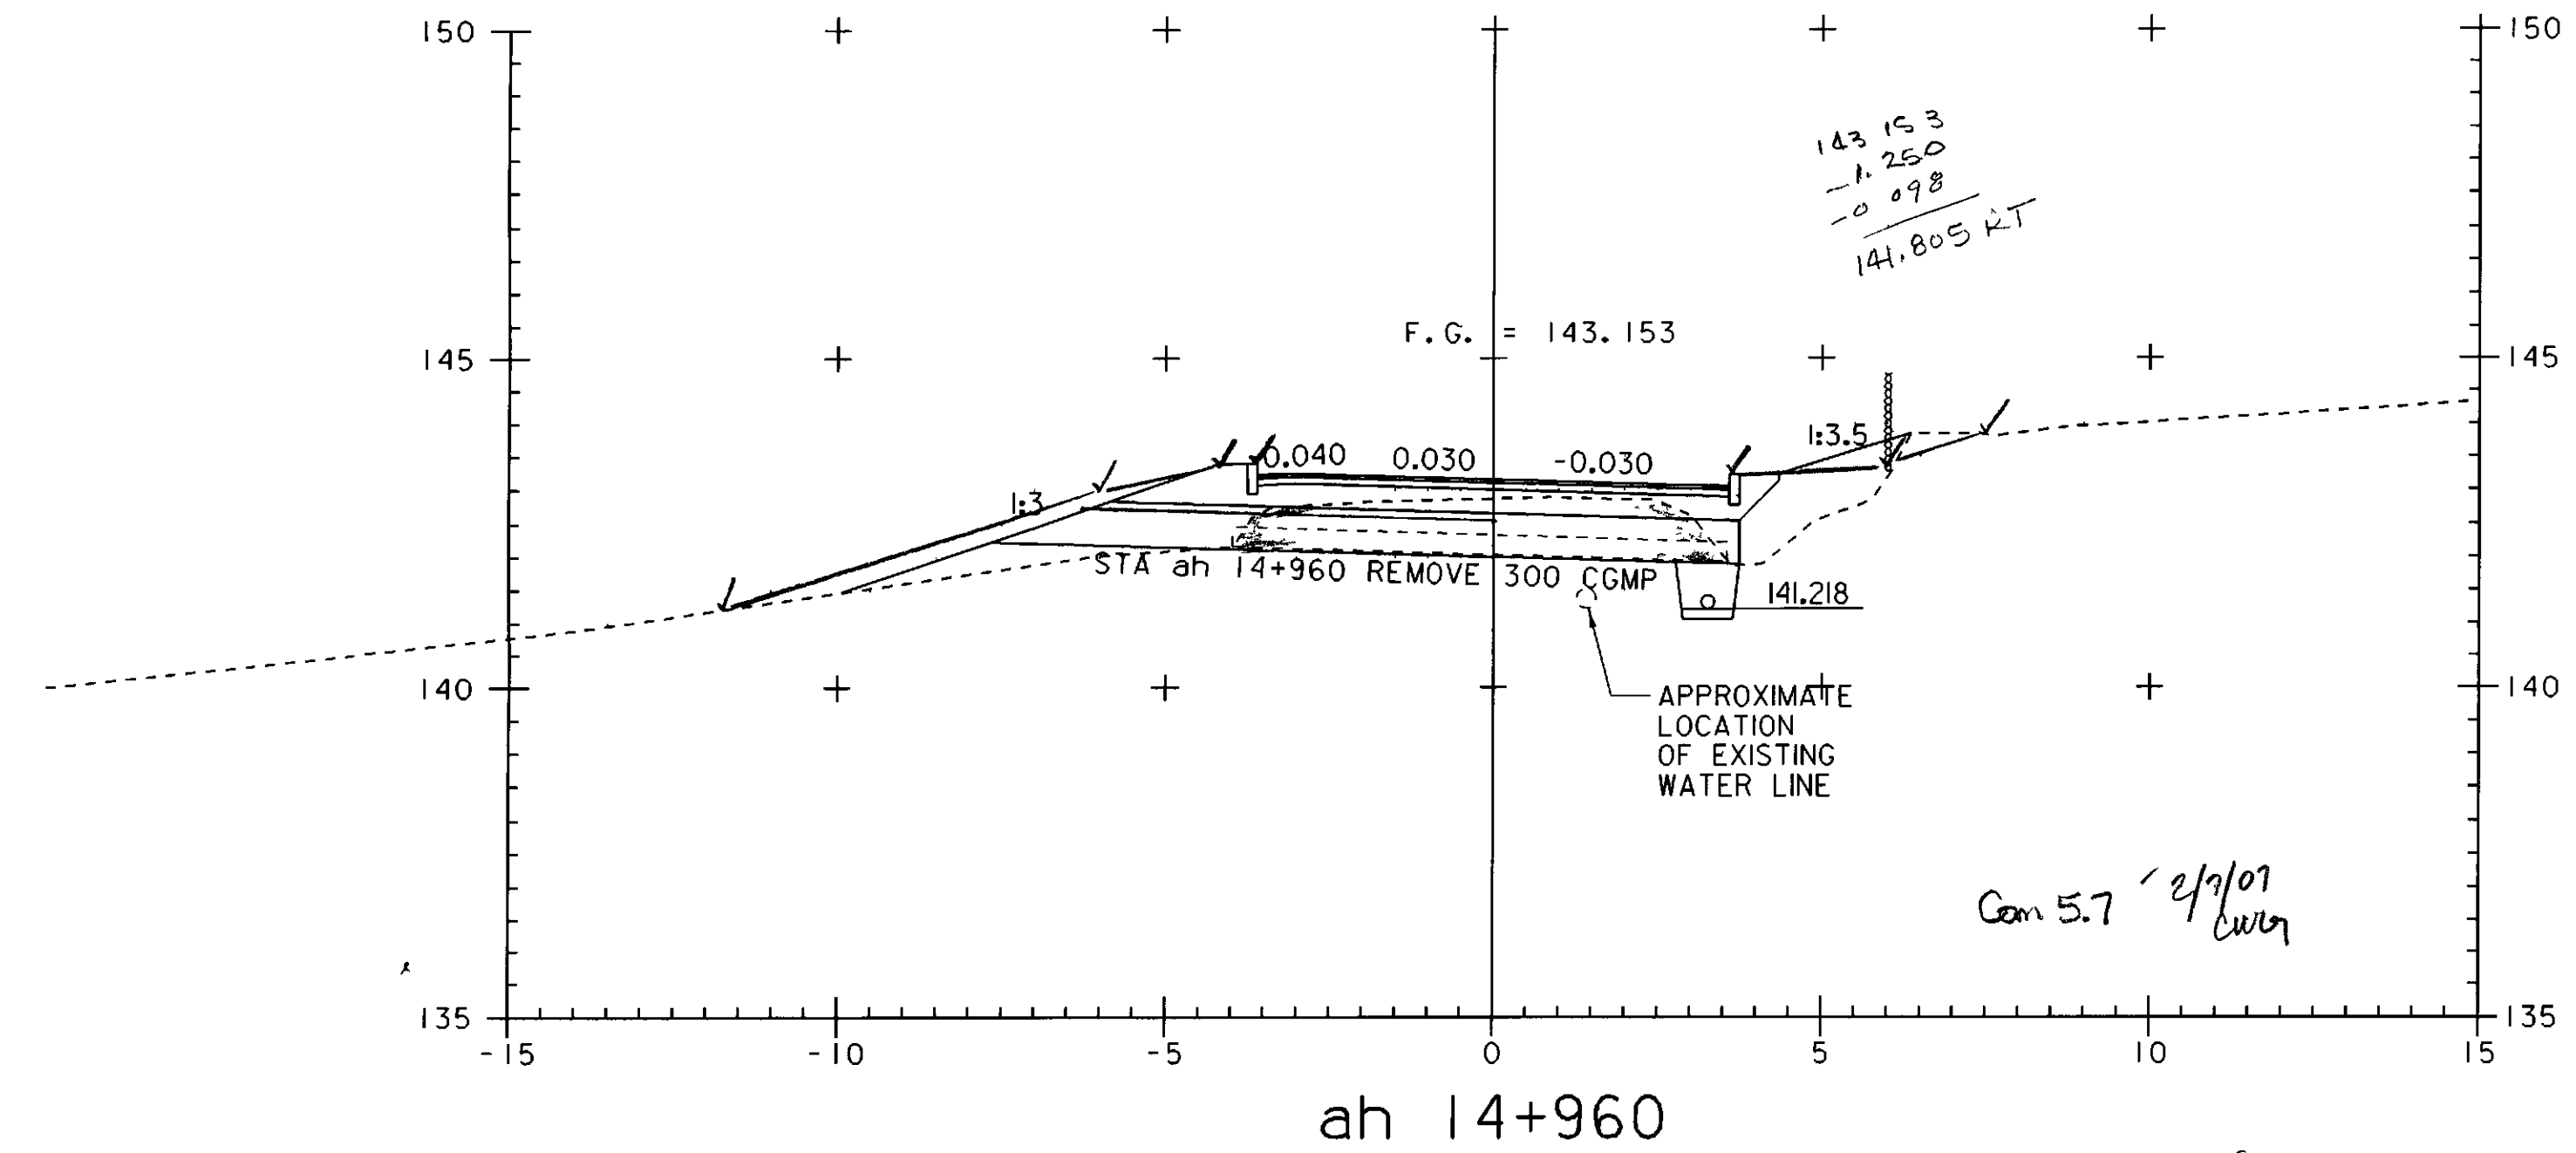


ah 14+960

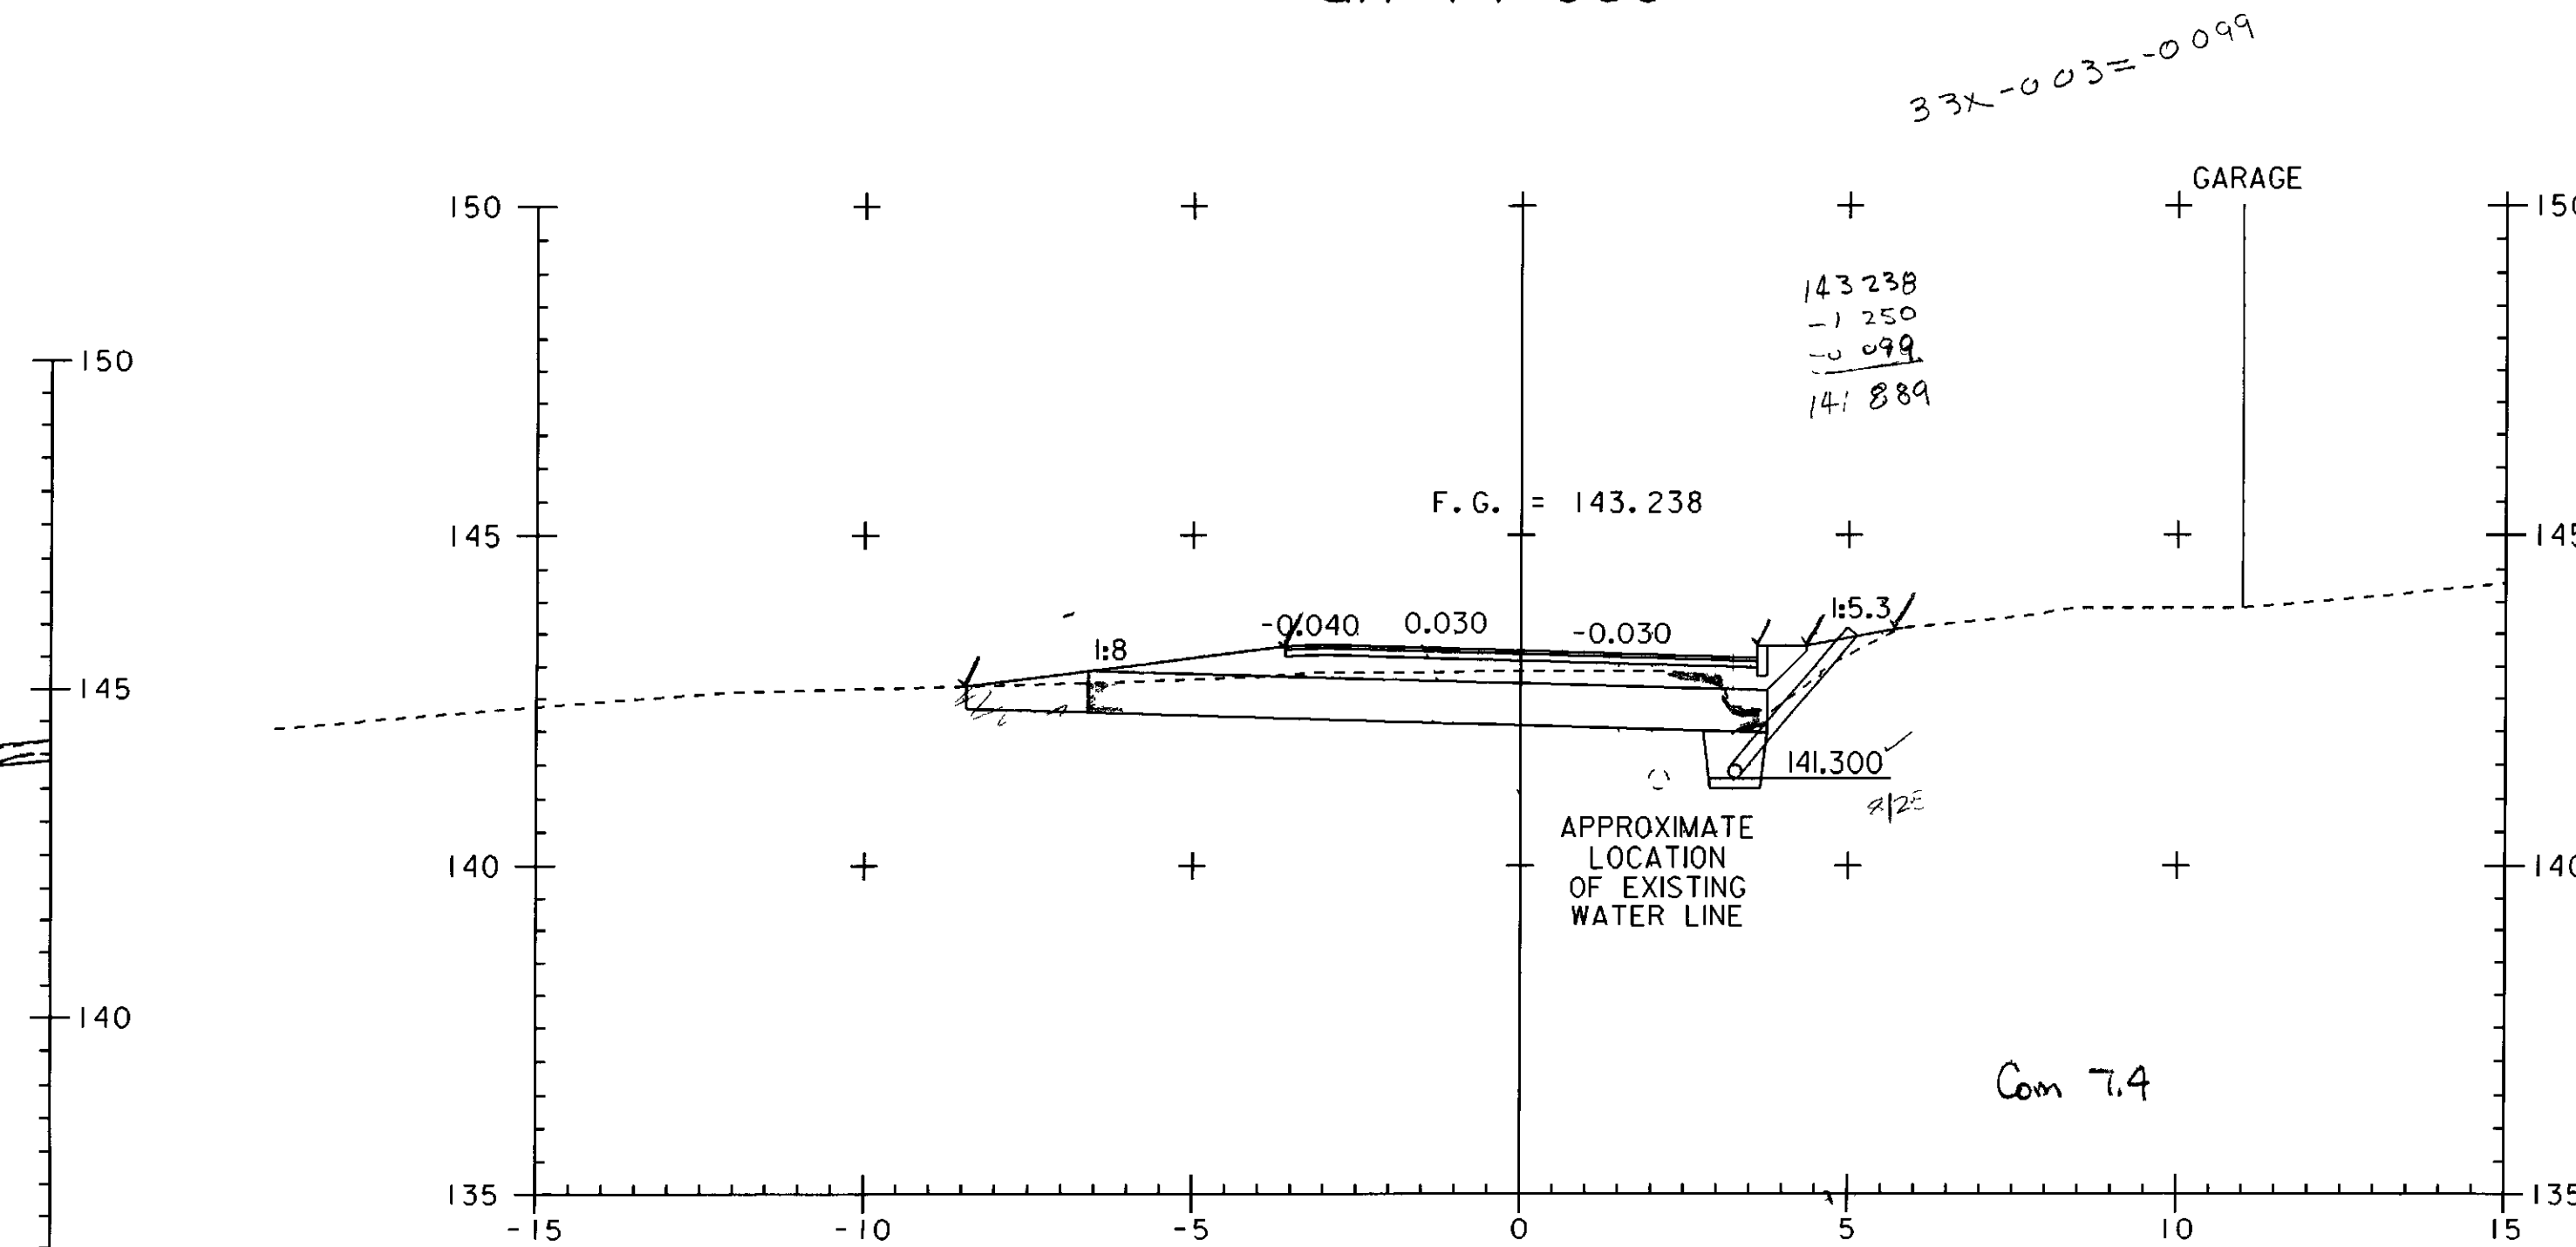

ah 14+940

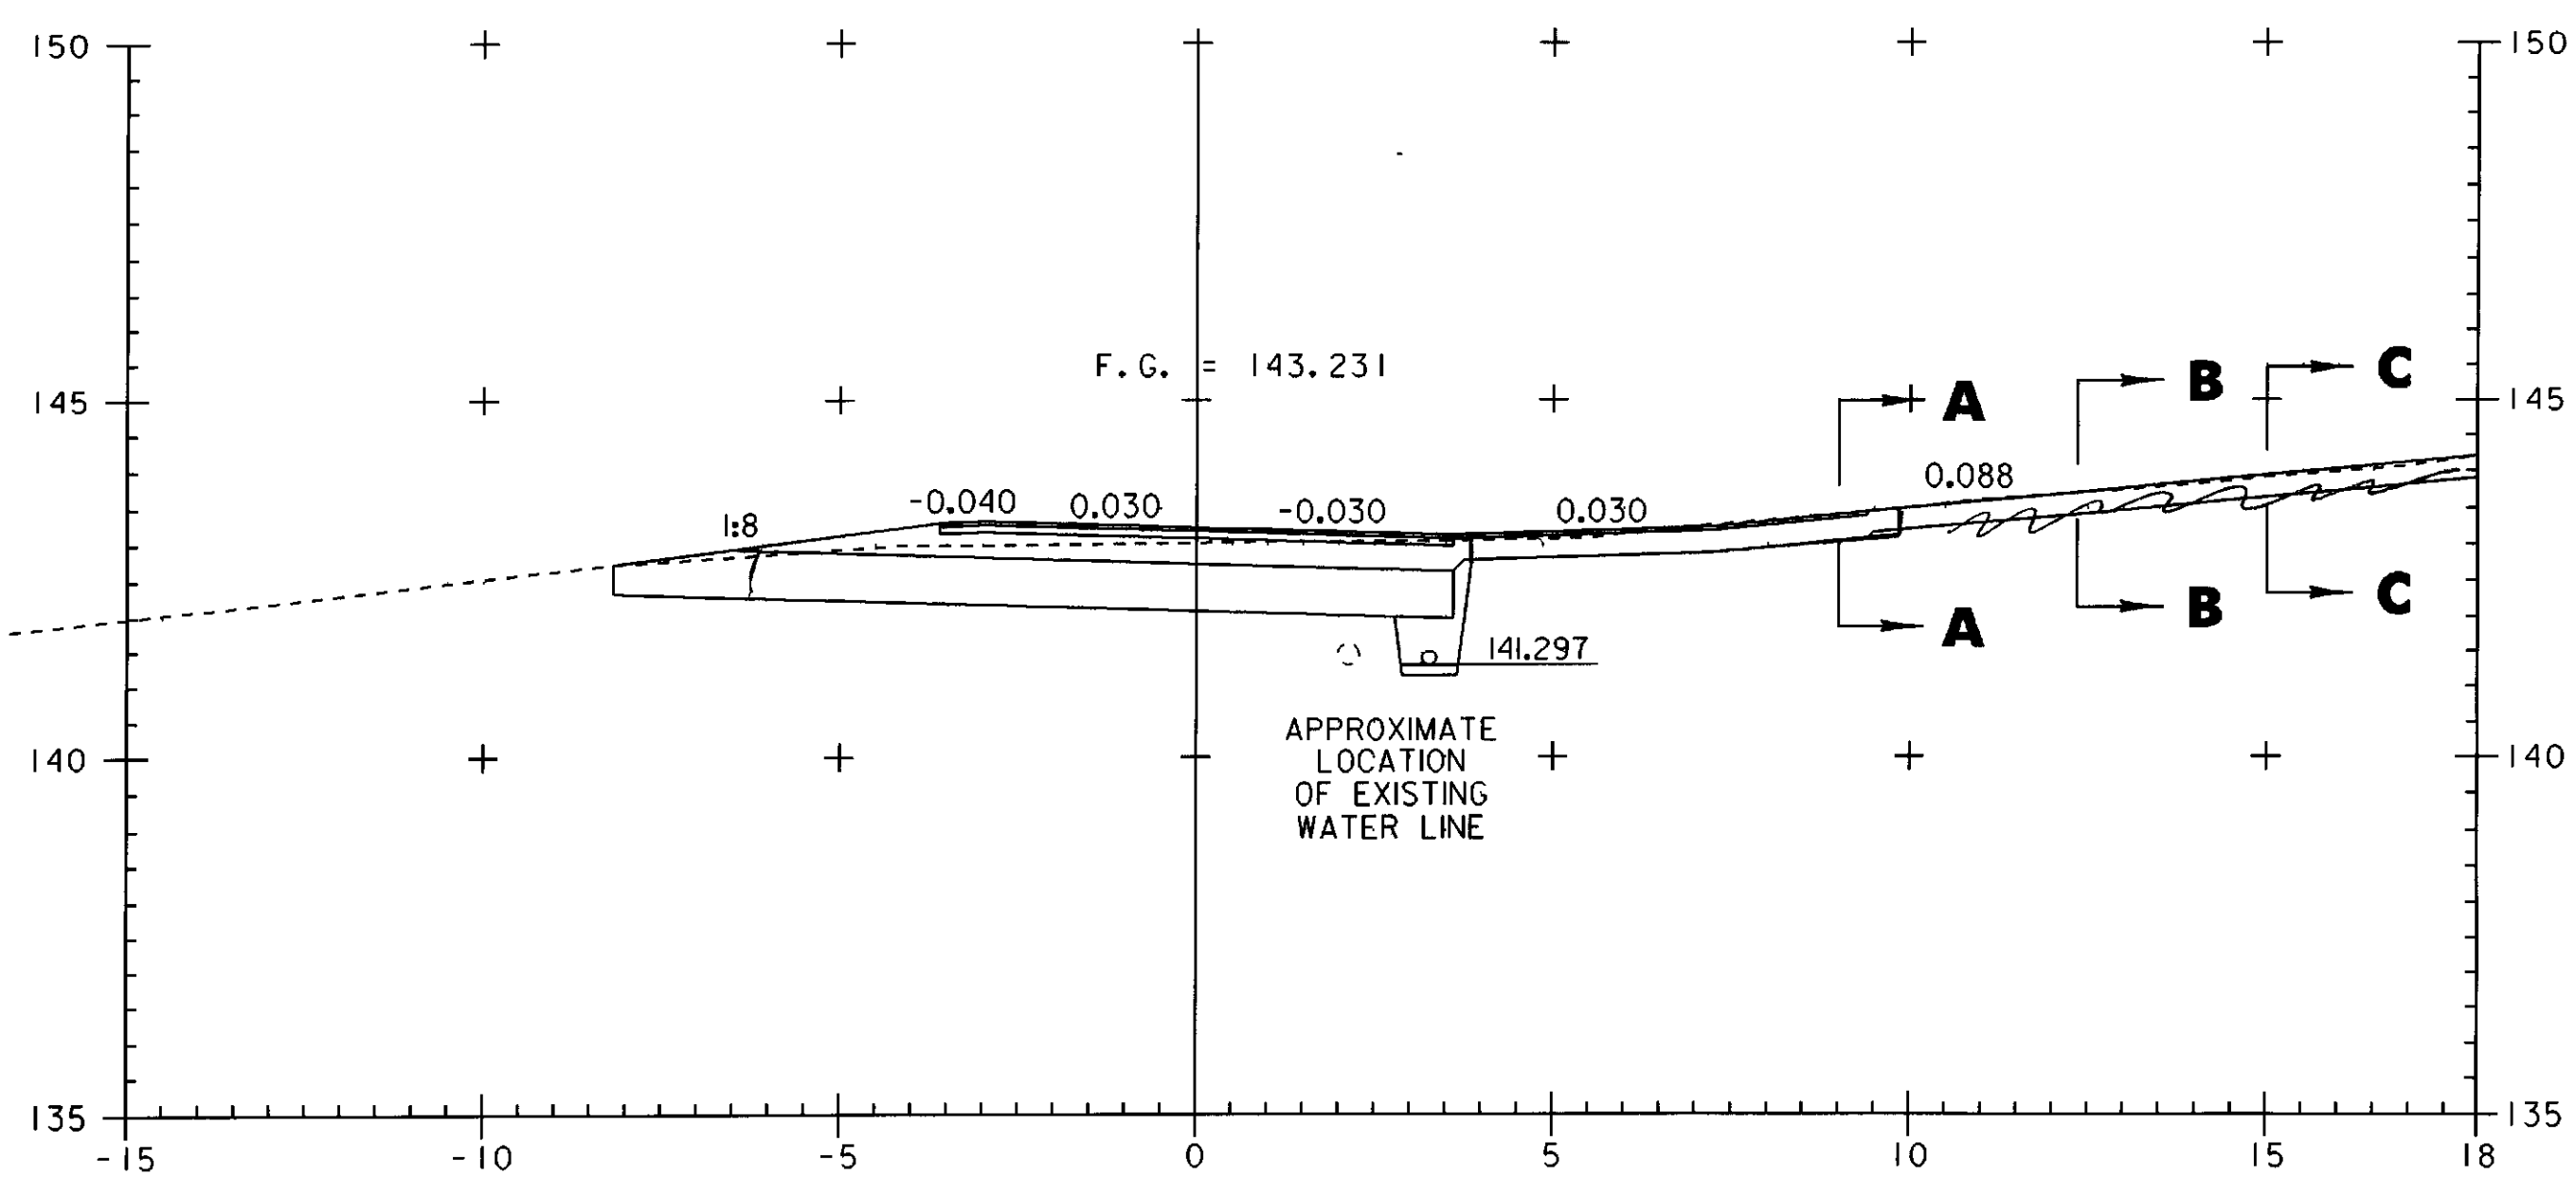

ah 14+927

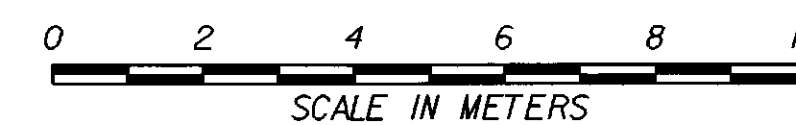

PROJECT NAME:	HIGHGATE - FRANKLIN	PLOT DATE:	09-MAY-2005
PROJECT NUMBER:	STP RS 030(I) SA	DRAWN BY:	SQUAD B
FILE NAME:	...85c060\design\dc060x11.dgn	DESIGNED BY:	SQUAD B
PROJECT LEADER:	DELLASANTA	CHECKED BY:	SQUAD B
IPARM FILE NAME:	dc060x1123.1	SHEET	447 OF 450