


STATION	STRUCTURE DIST	EXCAVATION AREA SM	VOL CM
129+910.2	1.4'	0	7.4
+991.6	0.9'	10.5	10.4
+992.5	2.4'	12.5	36.6
+994.9		18.0	
+994.9	3.1'	10.6	32.9
+998.0	4.2'	10.6	43.5
130+002.2	1.1'	10.1	6.8
+003.3	1.5'	2.1	3.3
+004.8			
+004.8	2.4'	7.2	21.1
+007.2	0.9'	15.4	12.2
+008.1	1.4'	11.8	8.2
+009.5		0	
			<u>188.5cm</u>

STATION	UNCLASSIFIED CHANNEL DIST	EXCAVATION AREA SM	VOL CM
129+986	4.2'	3.0	12.6
+990.2	1.4'	3.0	2.8
+991.6		1.0	
130+008.1	1.4'	1.3	3.0
+009.5	1.5'	3.0	4.5
+011.0		3.0	
			<u>22.9cm</u>

HEADWALL - SHEET # 235	GRANULAR BACKFILL FOR STRUCTURES	ADJUST 1.5 FOR AREA OF PIPE	
129+994.9	3.1'	9.2	35.6cm
+998.0	4.2'	9.2	28.5
130+002.2	1.1'	9.1	38.4
+003.3	1.5'	14.5	13.0
+004.8		14.5	21.8
HEADWALL - SHEET # 235			<u>35.6cm</u>
			<u>172.9cm</u>

STATION	STONE FILL TYPE II DIST	AND GEOTEXTILE UNDER STONE FILL AREA SM	VOL CM	LENGTH (m)	SM
129+986	4.2'	3.0	12.6	6.4	26.9
+990.2	1.4'	3.0	4.3	5.6	8.4
+991.6	1.1'	1.8	2.8	3.0	4.7
+992.7					
130+007	1.1'	1.8	2.8	3.0	4.7
+008.1	1.4'	3.2	4.3	5.6	8.4
+009.5	1.5'	3.0	4.5	6.4	9.6
+011.0		3.0		6.4	
			<u>31.3cm</u>		

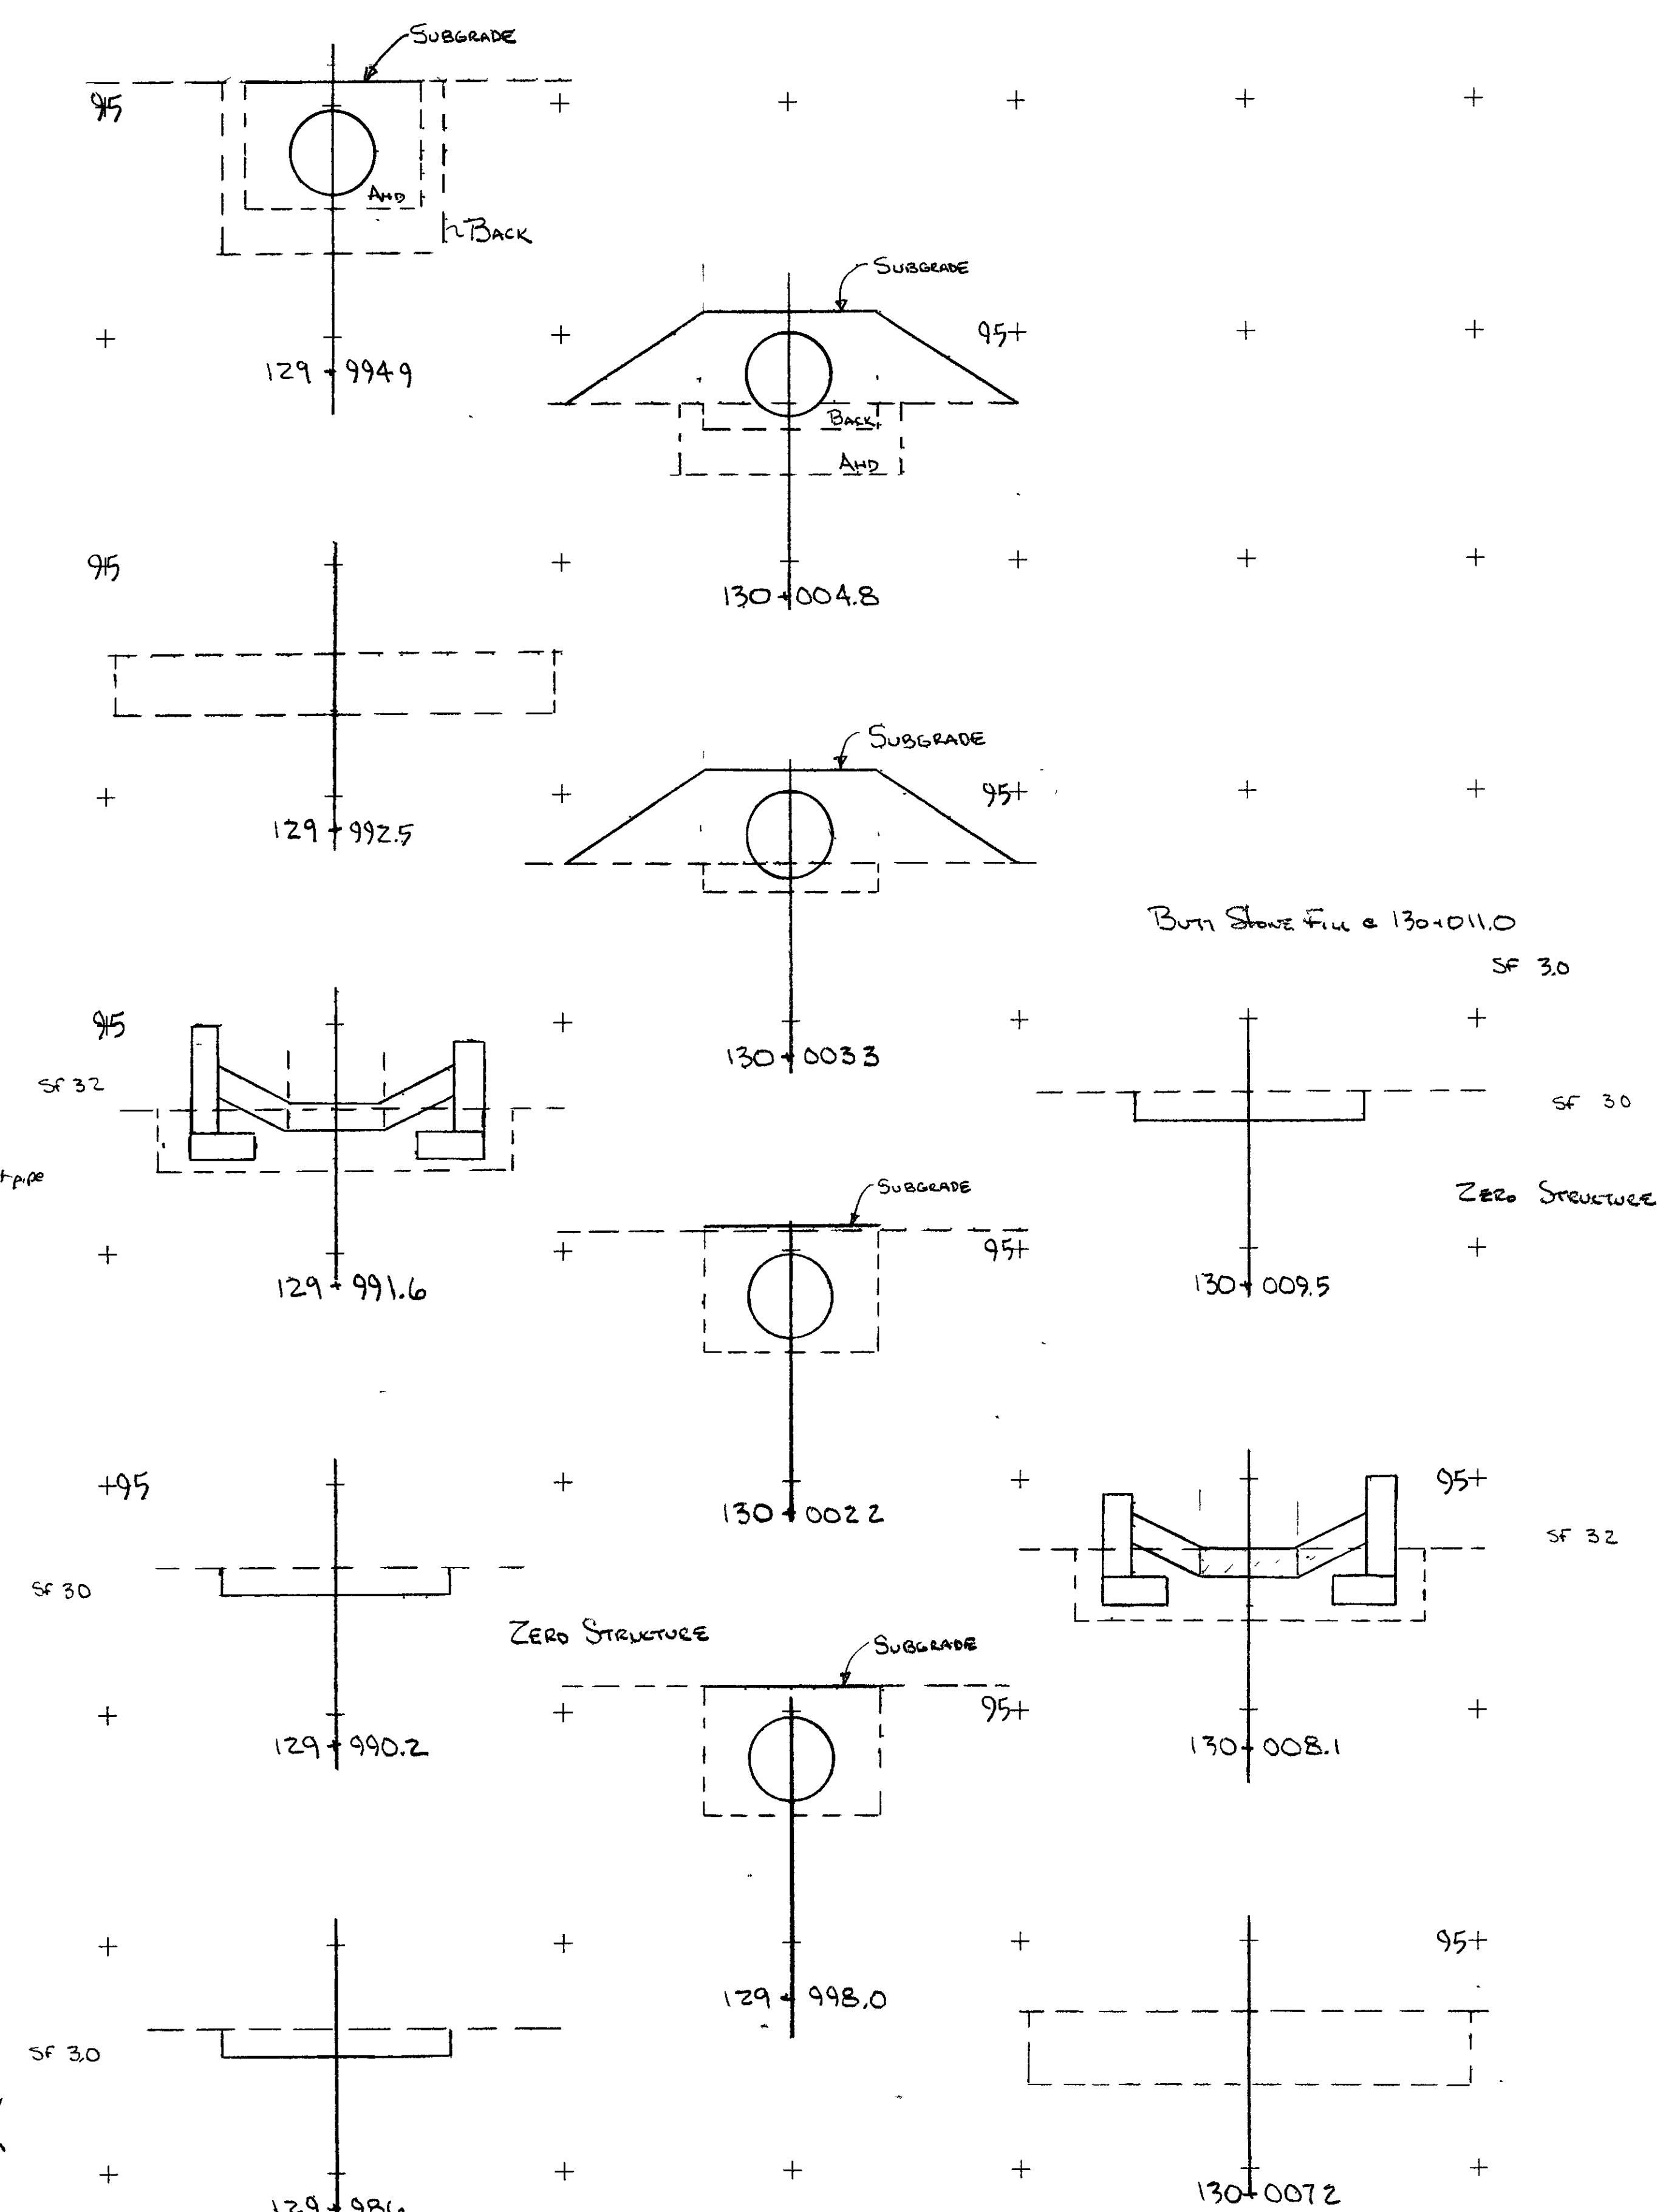

WRF 01-18-06
SWS 1-29-7

PROJECT: HIGHGATE-FRANKLIN	PROJECT NO: STP RS 0301(1)SA
DESIGN FILE NAME:	PLOT DATE: 01-MAY-1996
IPARM FILE NAME:	
6-189,250 - CROSS SECTIONS & QUANTITIES	
SHEET: 21-A OF	