

TRENCH EARTH

DI 0-1.5m

$4.5m \times 1.5m = 6.8cm$

DI OVER 1.5m

$4.5m \times 1.5m (ave Depth) \times 2.0 \times 1.5 = 3.0cm$

CULVERT

0-1.5m

$\left[\frac{17.4}{1.5m \times 11.6} + \left(\frac{1.58}{2} \times 1.4 \right) + \left(\frac{1.43}{2} \times 2.0 \right) \right] \times 17.2m = 35.1cm$

OVER 1.5m

$\left(\frac{0.0 \times 0.5}{2} \times 1.1 \right) + \left(\frac{5.46}{2} \times 1.84 \right) + \left(\frac{0.9}{2} \times 1.8 \right) \times 17.2 = 11.4cm \times 1.5 = 17.1cm$

Stone fill = Outlet

$\left(\frac{0.9 \times 0.4}{2} \right) \times 3.5m \times 2.5m = 6.6cm$
 $68.6cm$

GRANULAR BACKFILL STRUCTURES

DI

$3.0m \text{ per vertical meter} \times 1.7m = 5.1cm$

CULVERT

UNDERCUT

$15.2m \times 1.72m \times 0.3m = 7.8cm$



PIPE

$15.2m (ave) \times 1.72m \times 0.72m = 18.8cm$
 $31.7cm$

EARTH BORROW

$13.3m (ave L) \times 1.72m \times 0.5m (FIELD MEAS) = 11.4cm \times 1.15 = 13.1cm$

WBF SWB
 12-14-06 1-22-7
 T. B. 2A, Pg 66

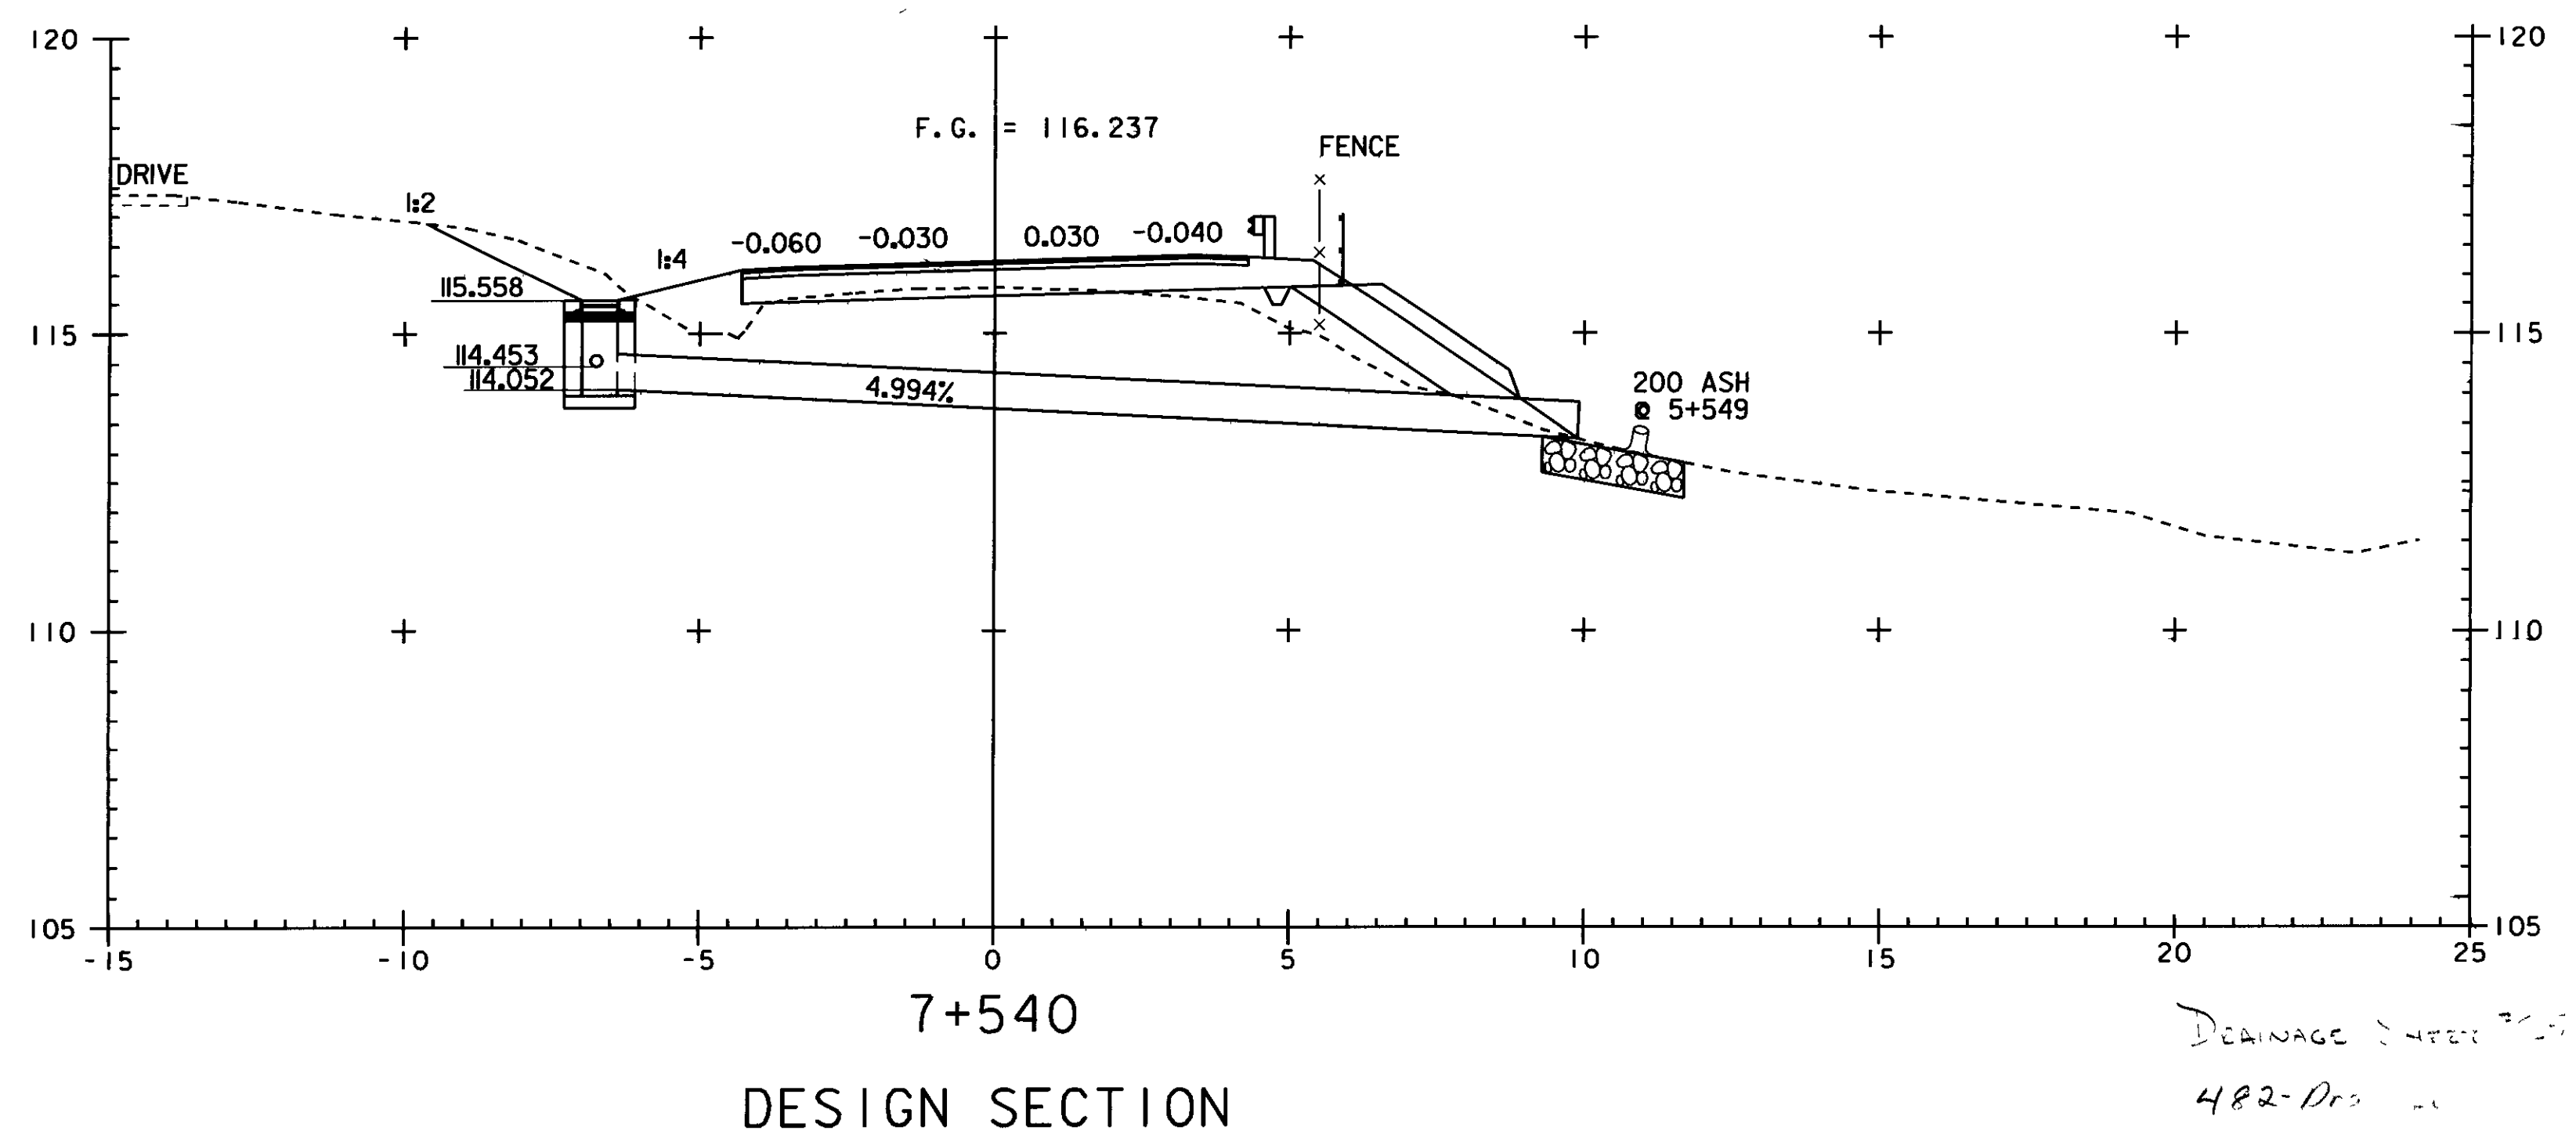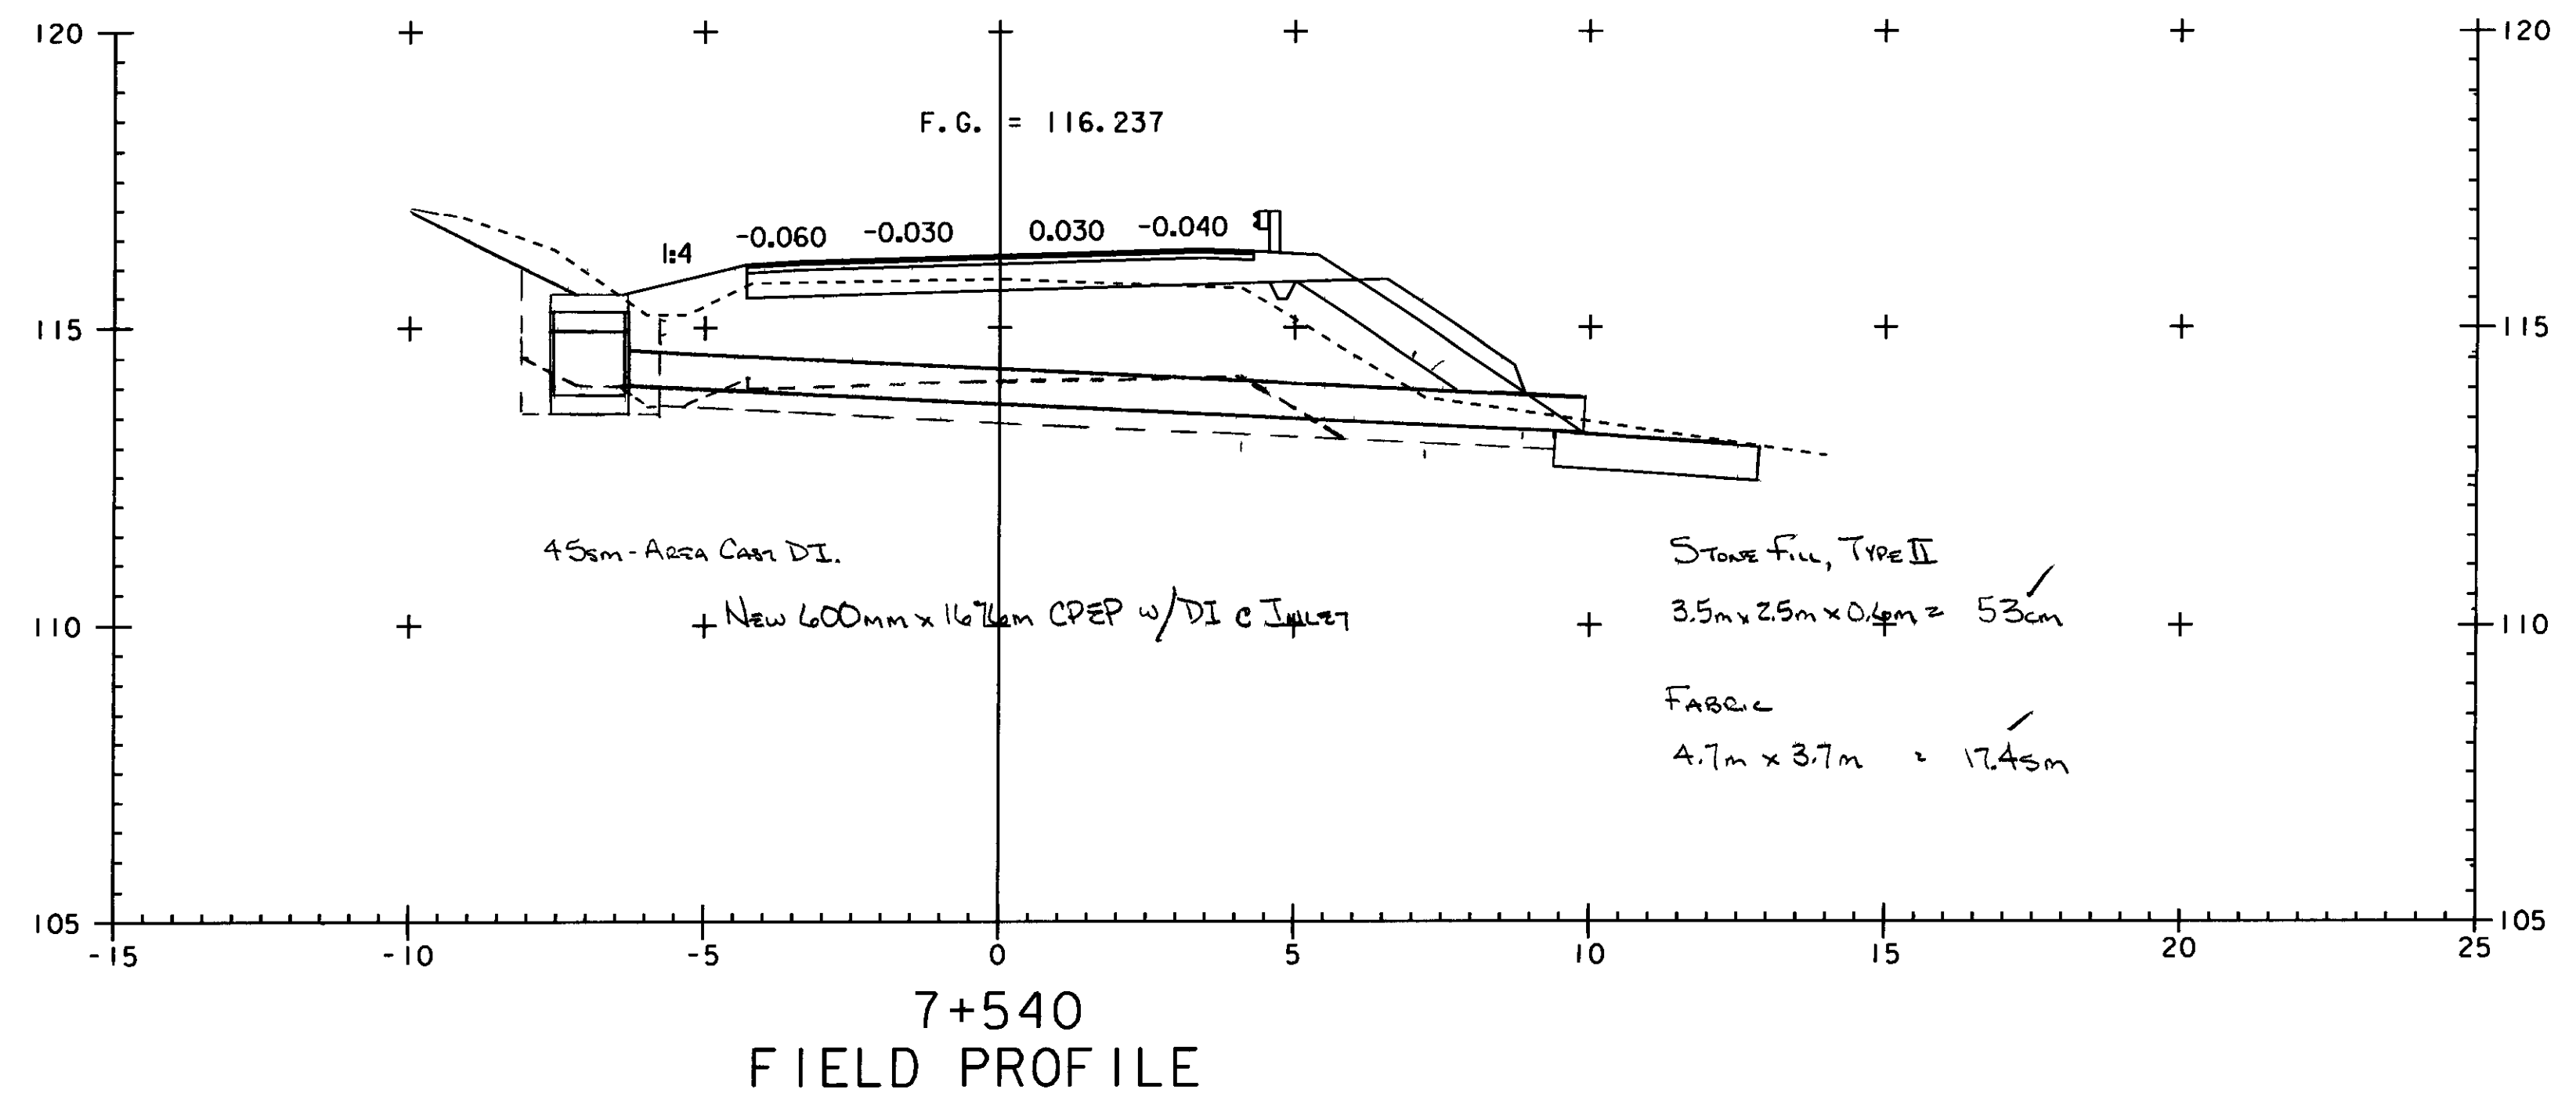

Drainage Inter 7+549
 482-Des