

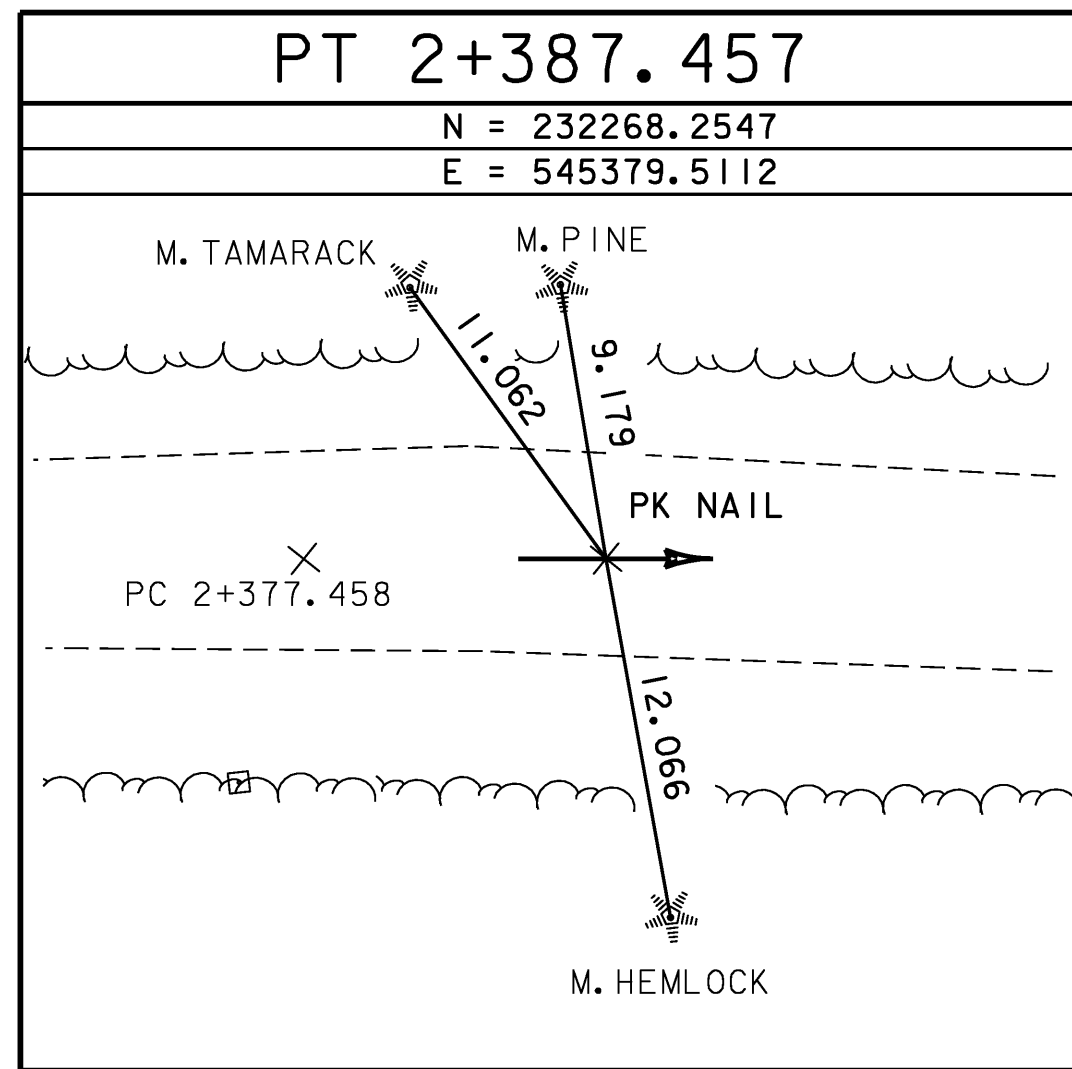
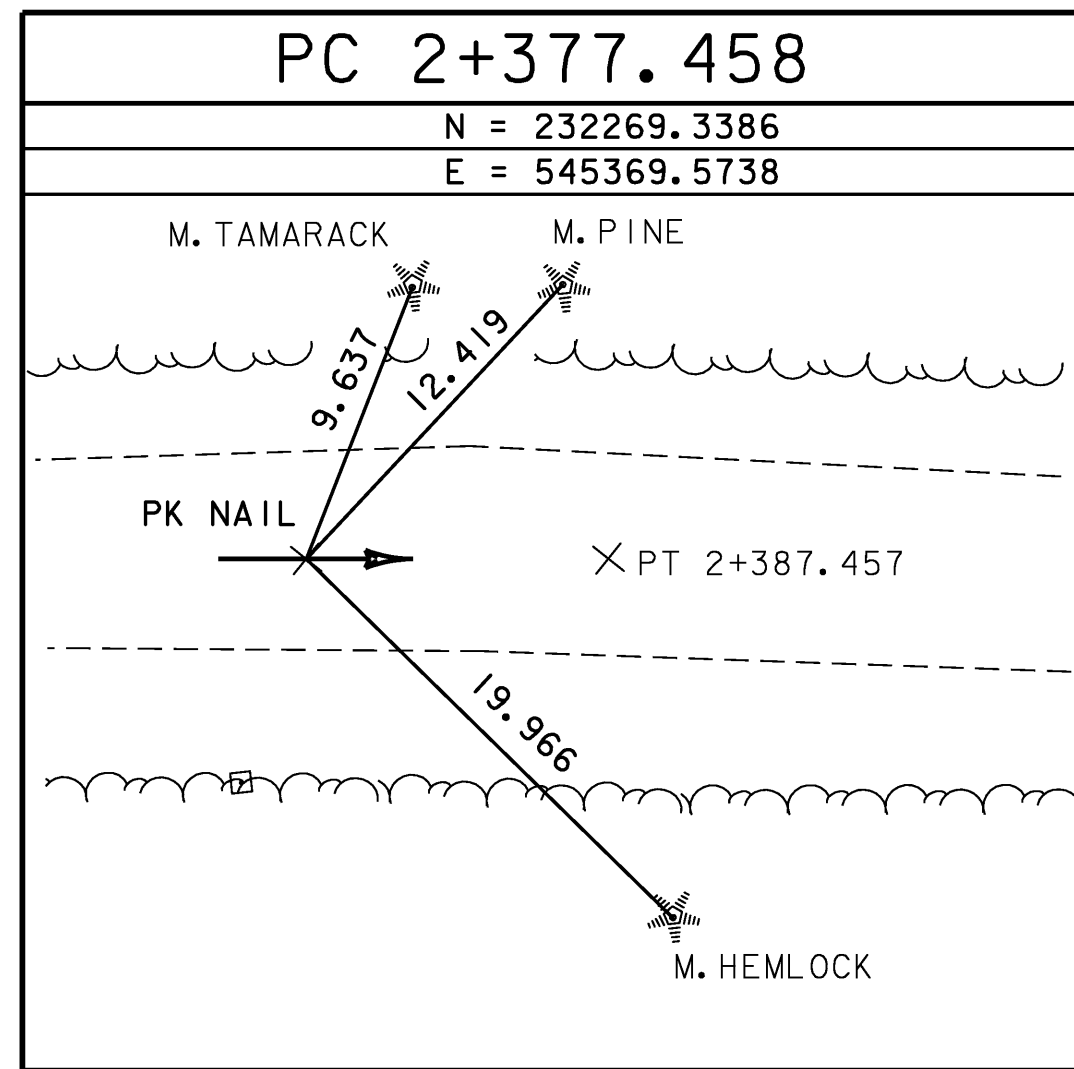
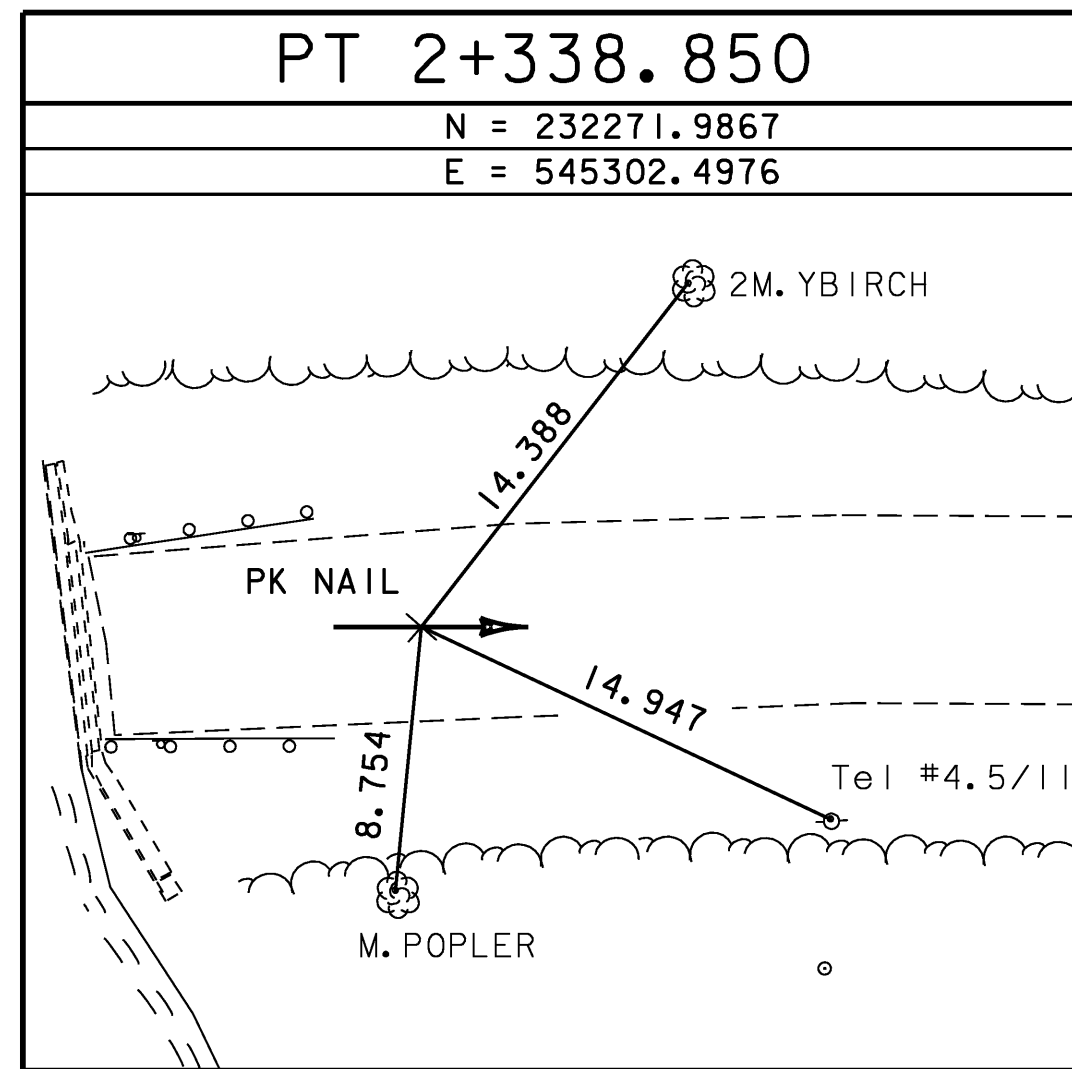


ALIGNMENT TIES

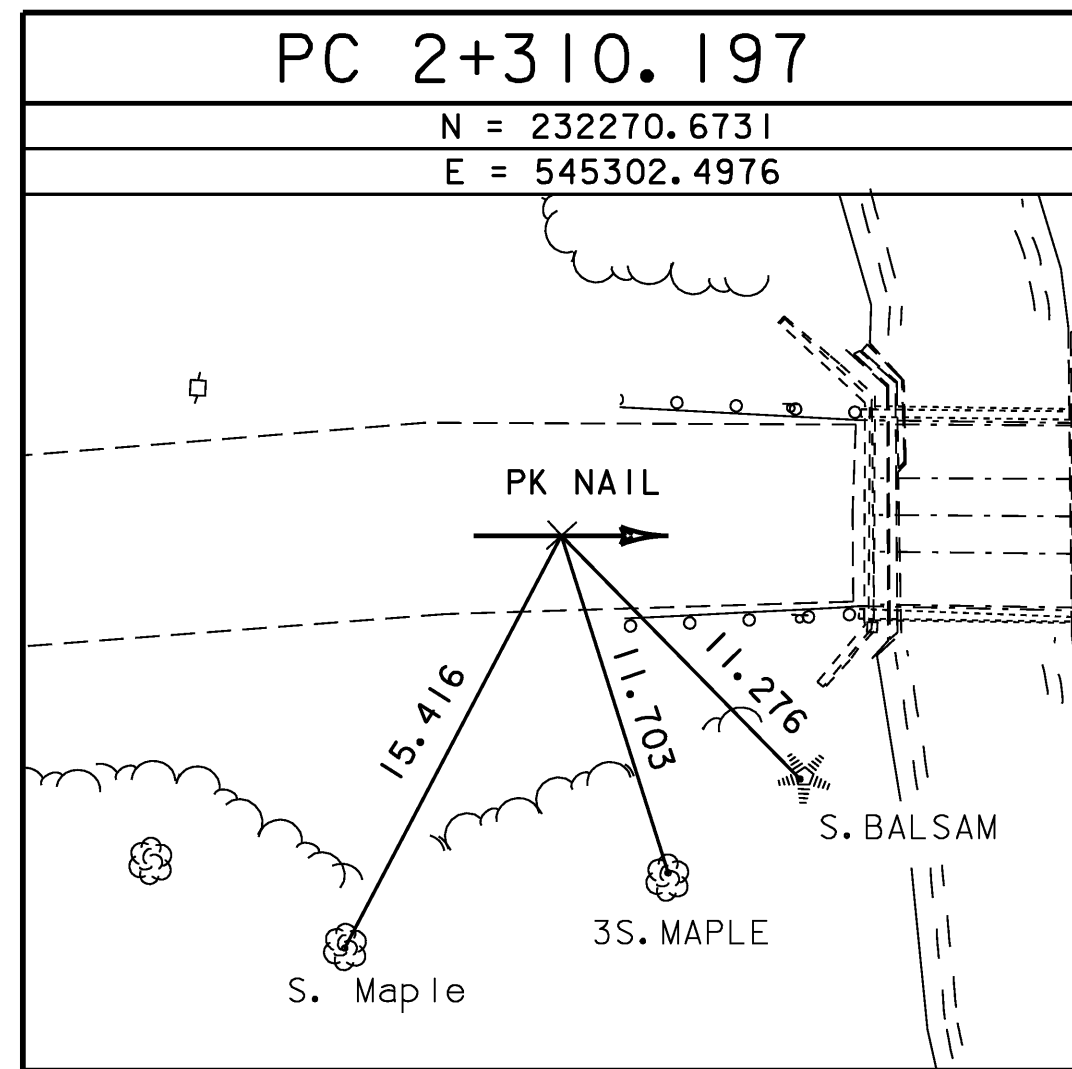

* ALIGNMENT STAKED ON FEBRUARY 7, 2002 BY R. GILMAN, P. WINTERS & D. BREER

ALIGNMENT TIES

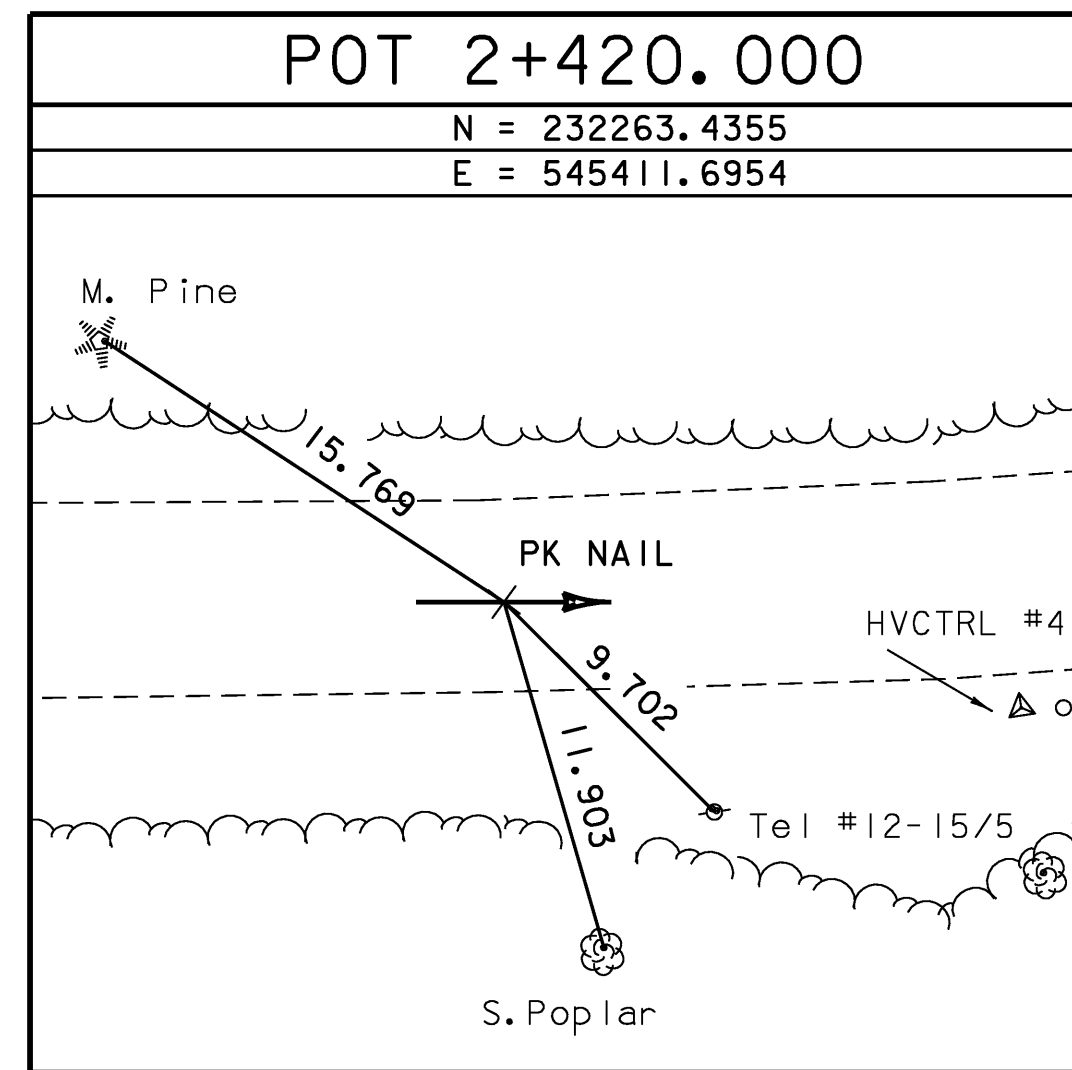

DATUM	
VERTICAL	NAVD 88
HORIZONTAL	NAD 83(92)
ADJUSTMENT	unknown

PROJECT NAME:	BURKE
PROJECT NUMBER:	BRZ 1447(15)
FILE NAME:	87e043/survey/xe043t1.dgn
PROJECT LEADER:	C. P. WILLIAMS
DESIGNED BY:	K. M. HIGGINS
ALIGNMENT TIES	
PLOT DATE:	10-MAR-2008
DRAWN BY:	J. HULETT & R. B.
CHECKED BY:	
SHEET	10 OF 81